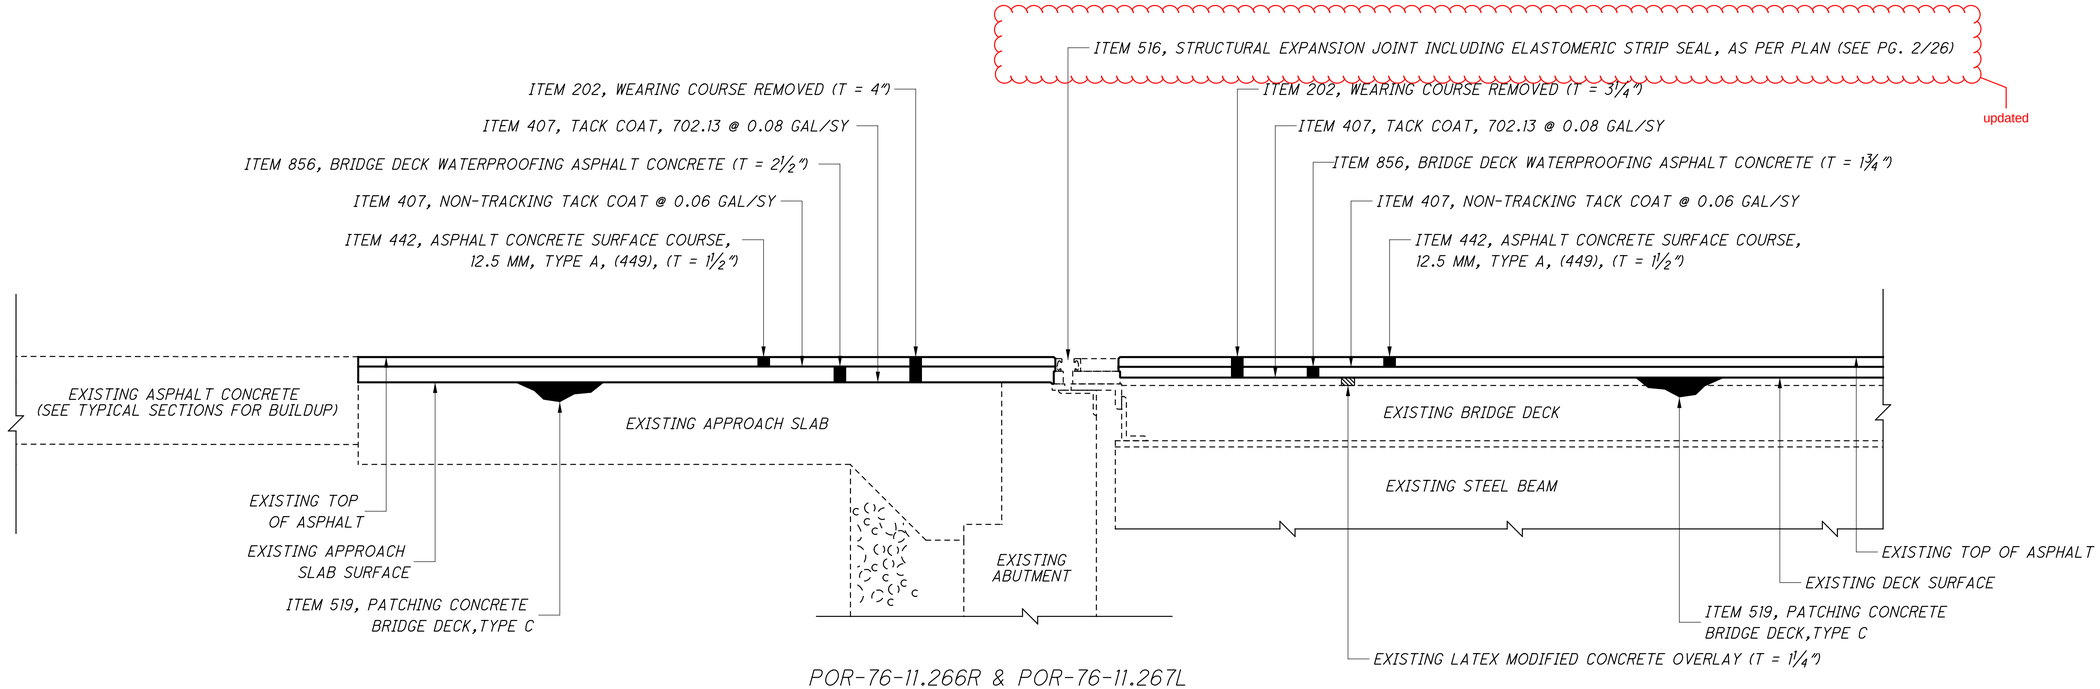

POR-76-11.266R & POR-76-11.267L

APPROACH SHOWN, TRAILING SIMILAR

BRIDGE NUMBER	BRIDGE DECK												APPROACH SLABS												
	LENGTH (BRIDGE LIMITS)	BRIDGE WIDTH	DECK AREA	202 WEARING COURSE REMOVED (T = 3.25")	407 TACK COAT, 702.13 @ 0.08 GAL/SY	407 NON-TRACKING TACK COAT @ 0.06 GAL/SAY	442 ASPHALT CONCRETE SURFACE COURSE, 12.5 MM, TYPE A (449) (T = 1.50")	856 BRIDGE DECK WATERPROOFING ASPHALT CONCRETE (T = 1.75")		519 PATCHING CONCRETE BRIDGE DECK - TYPE C			LENGTH (APPROACH SLABS)	APPROACH SLAB WIDTH	APPROACH SLAB AREA	APPROACH (FORWARD / REAR)	202 WEARING COURSE REMOVED (T = 4")	407 TACK COAT, 702.13 @ 0.08 GAL/SY	407 NON-TRACKING TACK COAT @ 0.06 GAL/SAY	442 ASPHALT CONCRETE SURFACE COURSE, 12.5 MM, TYPE A (449) (T = 1.50")	856 BRIDGE DECK WATERPROOFING ASPHALT CONCRETE (T = 2.50")	516 STRUCTURAL EXPANSION JOINT INCLUDING ELASTOMERIC STRIP SEAL, AS PER PLAN		519 PATCHING CONCRETE BRIDGE DECK - TYPE C	
	FT	FT	SQ YD	SY	GAL	GAL	CY	CY		SY			FT	FT	SQ YD		SY	GAL	GAL	CY	CY	FT		SY	
POR-76-11.266R	128.67	41.00	586.16	586.16	46.89	35.17	24.42	28.49		3			25.00	41.00	113.89	REAR	113.89	9.11	6.83	4.75	7.91	44		1	
													25.00	41.00	113.89	FWD	113.89	9.11	6.83	4.75	7.91	44		1	
POR-76-11.267L	128.67	41.00	586.16	586.16	46.89	35.17	24.42	28.49		3			25.00	41.00	113.89	REAR	113.89	9.11	6.83	4.75	7.91	44		1	
													25.00	41.00	113.89	FWD	113.89	9.11	6.83	4.75	7.91	44		1	

updated

SUPERSTRUCTURE DETAILS
POR-76-11.266R & POR-76-11.267L
OVER BARREL RUN

SFN VARIOUS

DESIGN AGENCY

DESIGNER	CHECKER
JF	MJA

REVIEWER TJP 04-04-25

PROJECT ID 112778

SUBSET 18 TOTAL 26

SHEET P.40 TOTAL 48

POR-76-9.73

MODEL: Sheet 2 PAPERSIZE: 34x22 (in.) DATE: 7/28/2025 TIME: 7:34:43 AM PLTDRV: OHDOT_PDF.pltcfg PENTBL: OHDOT_Pen.tbl USER: Mark.Andrasik@dot.ohio.gov WORKSPACE: OHDOTCEv02 WORKSET: 112778 PRODUCT: OpenRoadsDesigner 24.00.00.205
pw:\\ohiodot-pw.bentley.com:ohiodot-pw-02\Documents\01 Active Projects\District 04\Portage\112778\400-Engineering\Roadway\Sheets\112778_SD001.dgn