

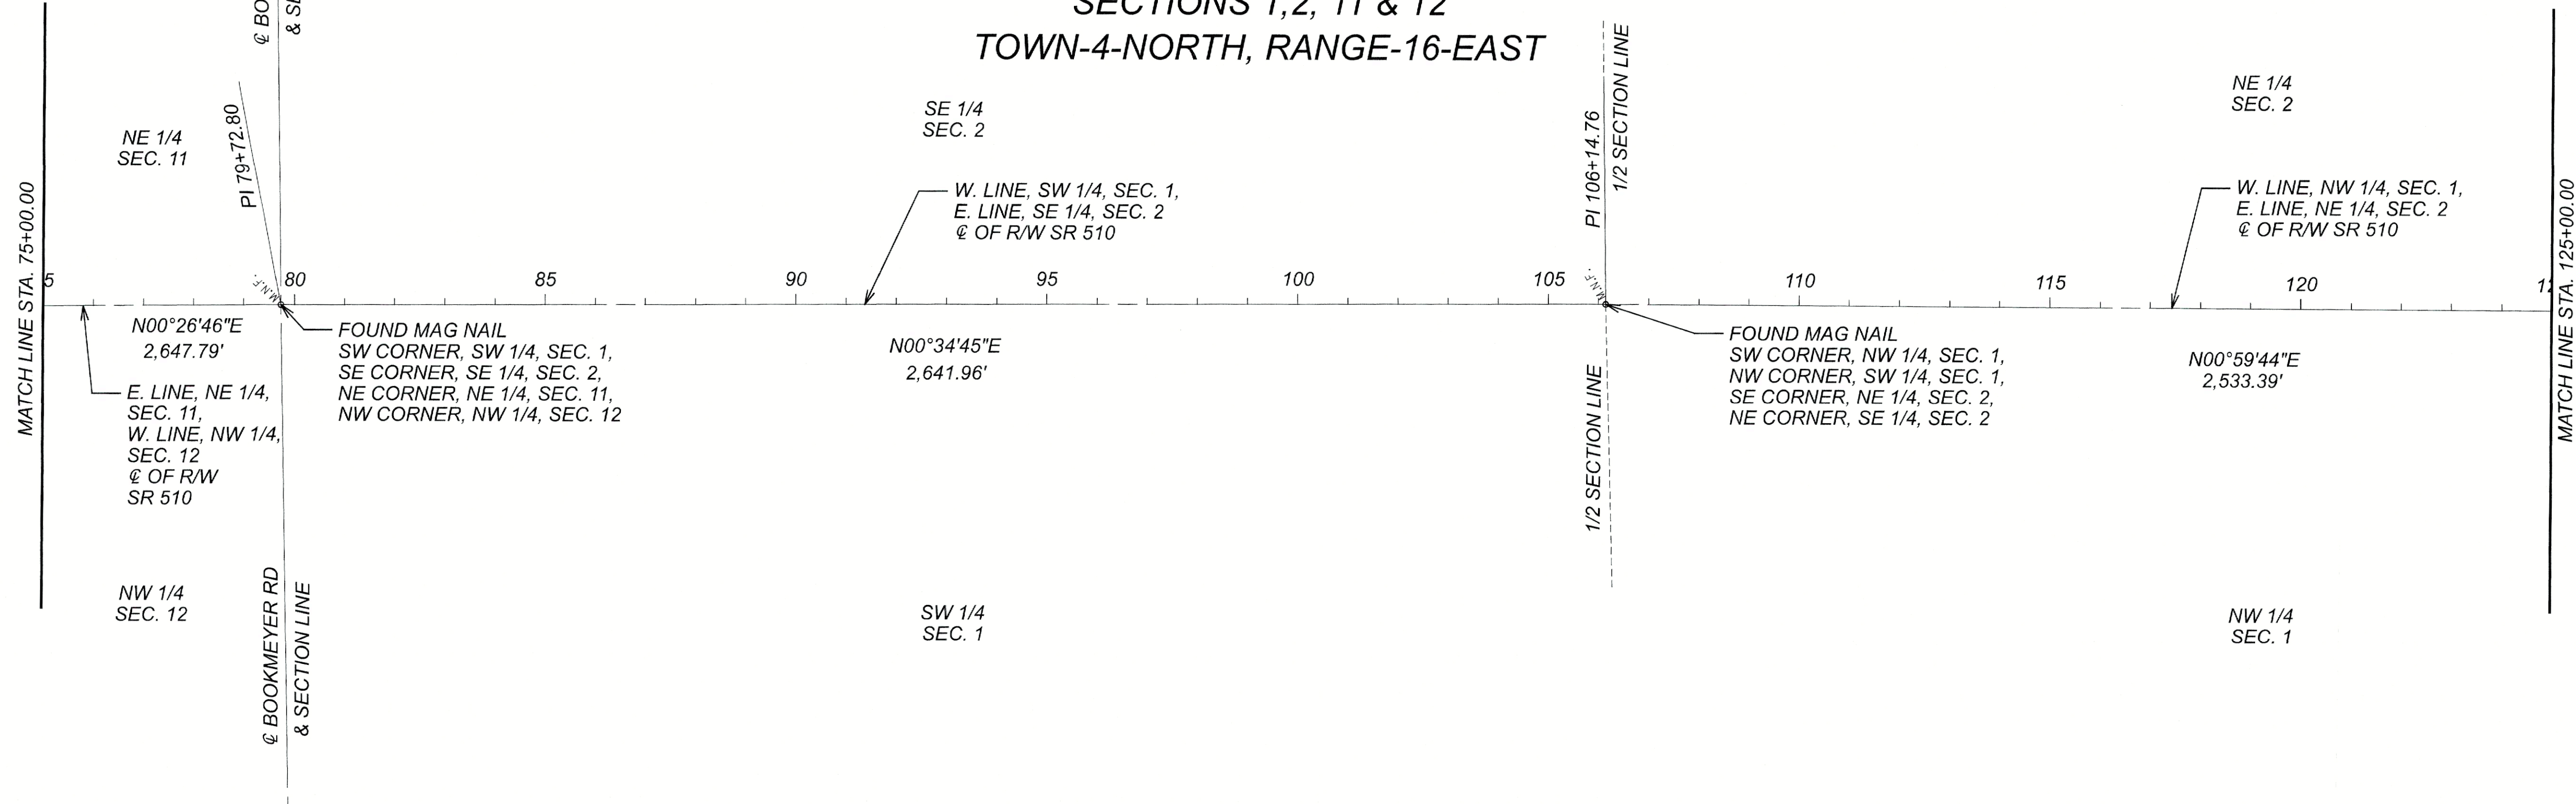


CENTERLINE PLAT (PAGE 2 OF 4)
SAN-510-0.83
SANDUSKY COUNTY
GREEN CREEK TOWNSHIP
SECTIONS 1, 2, 11 & 12
TOWN-4-NORTH, RANGE-16-EAST

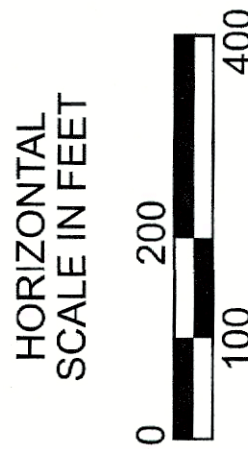

SANDUSKY COUNTY
GREEN CREEK TOWNSHIP
SECTIONS 1 & 2
TOWN-4-NORTH, RANGE-16-EAST

SANDUSKY COUNTY
RILEY TOWNSHIP
SECTIONS 35 & 36
TOWN-5-NORTH, RANGE-16-EAST

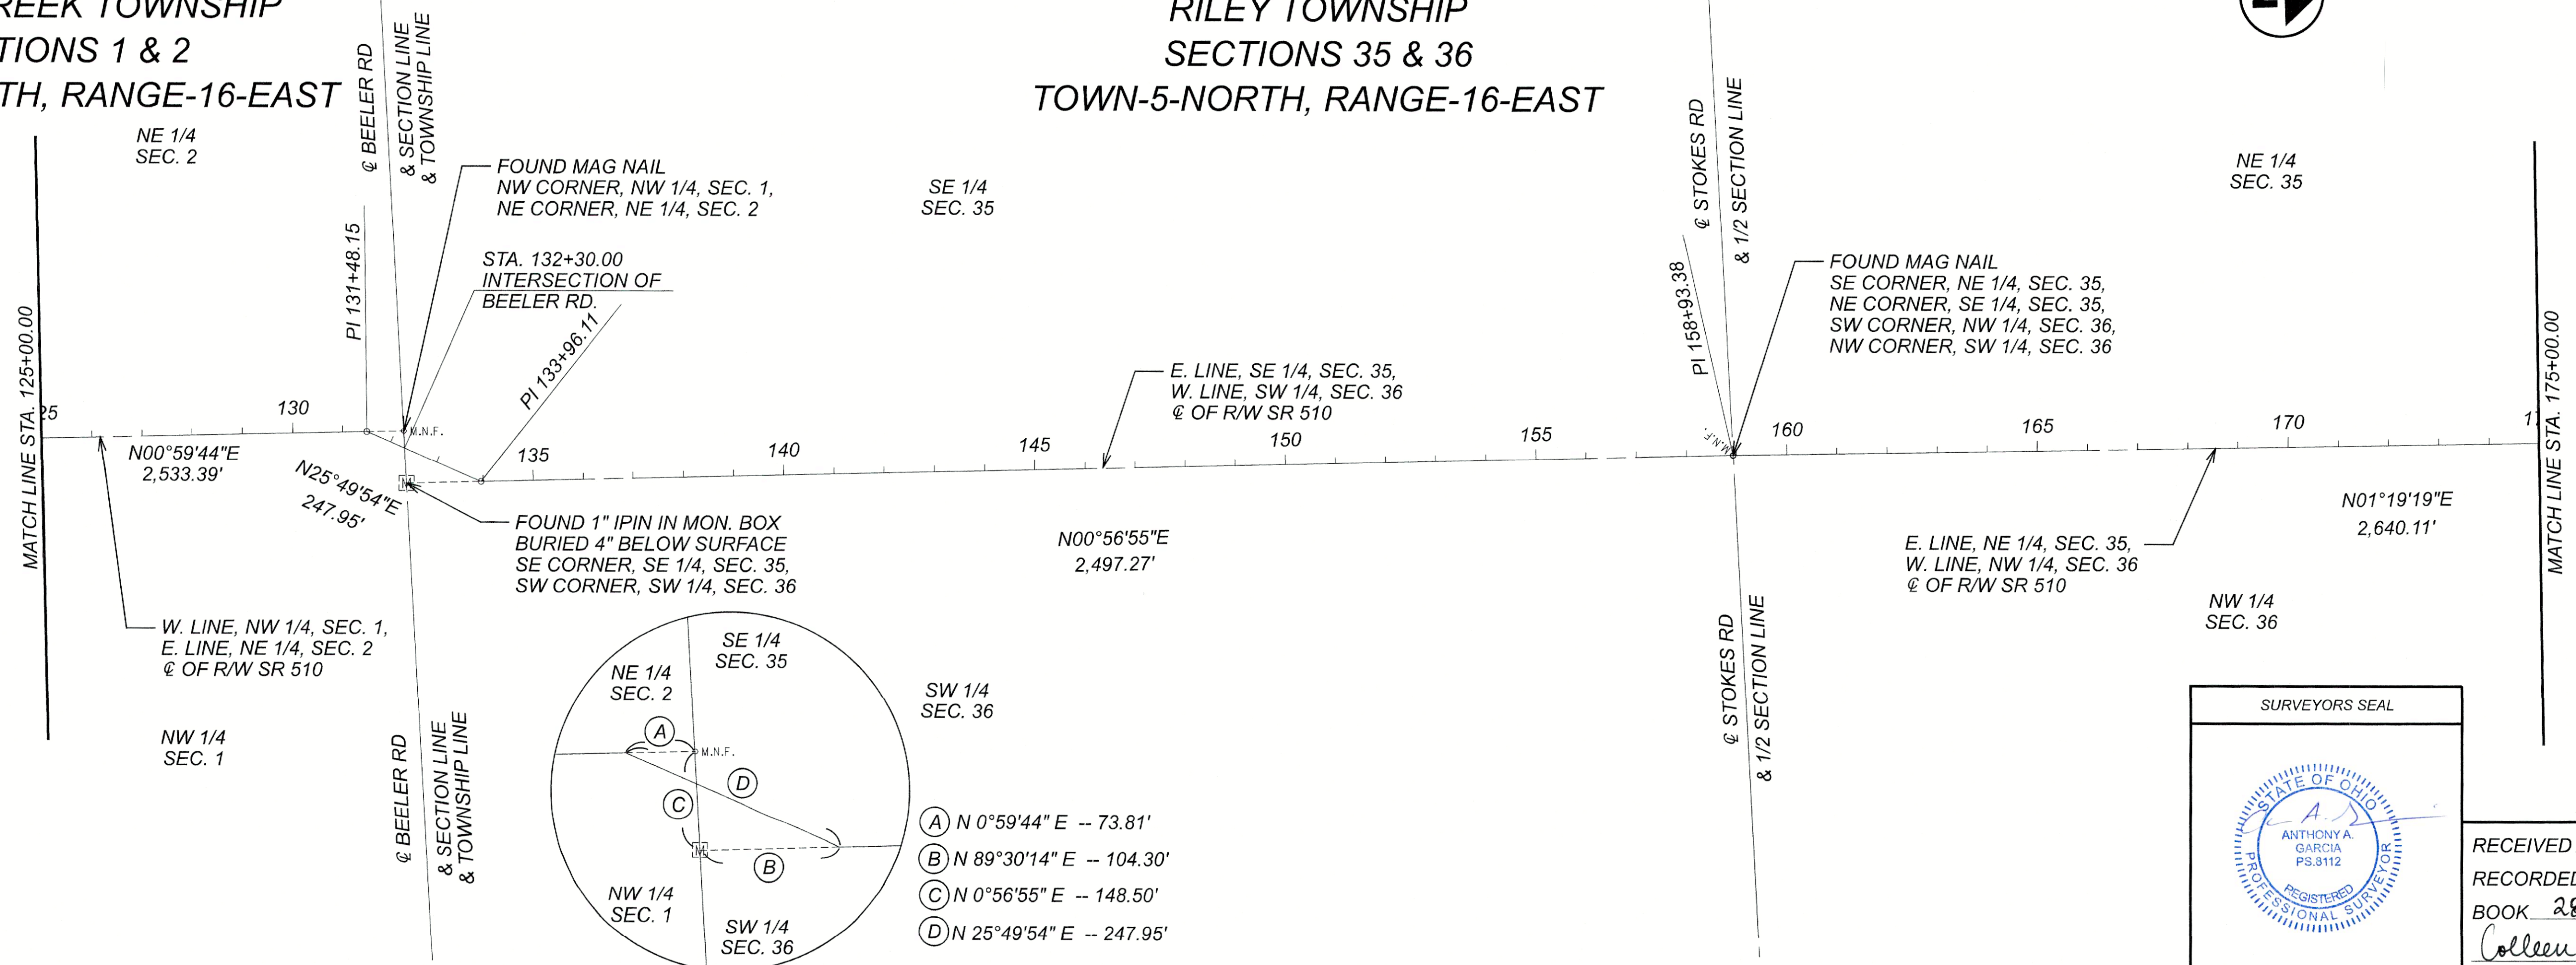

SURVEYORS SEAL

RECEIVED April 26, 2023
RECORDED April 26, 2023
BOOK 280 PAGE 906
Colleen Carmack
COUNTY RECORDER

CENTERLINE PLAT
SAN-510-0.83

DESIGN AGENCY	JAS
DESIGNER	JAS
REVIEWER	AAG
PROJECT ID	94332
SHEET	2
TOTAL	4