O.D.O.T. DISTRICT 2 SURVEY OFFICE (USE ONLY)

PERSONNEL

NOTES LEU JAM
H.C. LEU JAM
R.C. AUBLE JAB

DWG BY GARRETT

REFERENCE NO. 27 A


DATE ~~6/17/19~~ 8/20/25
WEATHER CLOUDY ✓
TEMP. 63° ✓

PID 77825

SHEET 1 OF 18

ROUTE US 6
COUNTY SANDUSKY
TOWNSHIP SANDUSKY
SECTION 25
T 5 N R 15 E

TYPE MONUMENT MONBOX W/ 1" IPIN ✓
ON SURFACE - ~~BELOW~~ ON ✓
OFFSET ℄ PAVEMENT ON ✓ LT : RT
- TO - EDGE PAVEMENT
STATION: 983+26.5

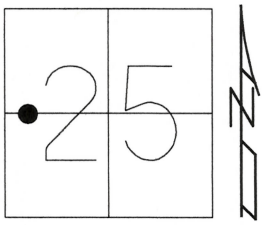


HORZ.DATUM: NAD83 (2011) GEOID: 2012A
GRID: NORTHING: 618098.707 EASTING: 1807119.409

NOTE: PI FROM SAN-6-18.33-1990 PLANS

RECORD:
FD MONBOX
6/10/08, DH
FD MONBOX
REF27
11/15/19, JLL
FD MONBOX W/ 1" IPIN
8/20/25, JAM
REF27A

DIST, 27A-28= 5.18'

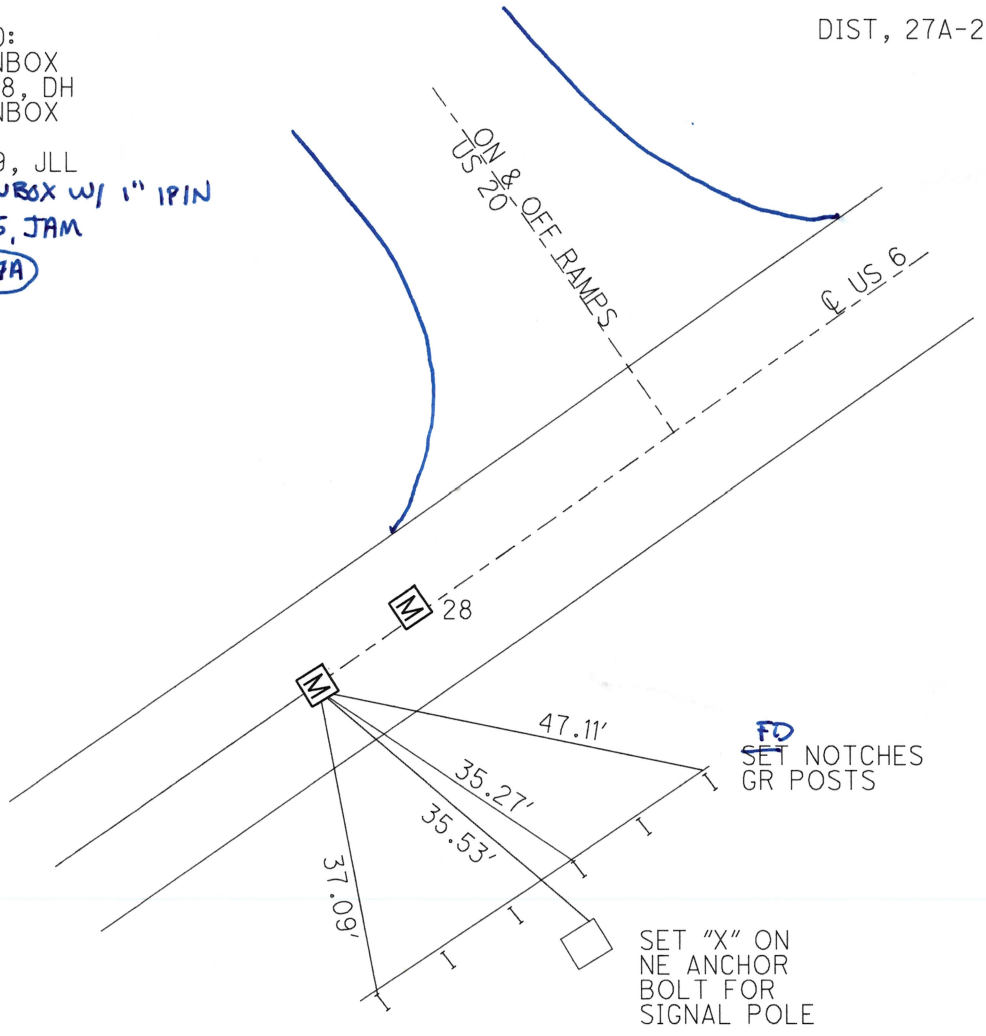

* NEEDS LID

O.D.O.T. DISTRICT 2 SURVEY OFFICE (USE ONLY)

PERSONNEL

NOTES LEU JAM
H.C. LEU JAM
R.C. AUBLE JAB

DWG BY GARRETT


REFERENCE NO. 28

DATE ~~6/17/19~~ 8/20/25
WEATHER CLOUDY ✓
TEMP. 63° ✓

PID 77825

SHEET 2 OF 18

ROUTE US 6
COUNTY SANDUSKY
TOWNSHIP SANDUSKY
SECTION 25
T 5 N R 15 E

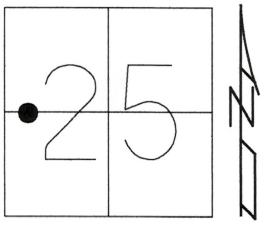

TYPE MONUMENT MONBOX W/ 1" IPIN ✓
ON SURFACE - ~~BELOW~~ ON ✓
OFFSET ℄ PAVEMENT 2.6' ✓ LT : ~~RT~~
- TO - EDGE PAVEMENT
STATION: 983+31.04


HORZ.DATUM: NAD83 (2011) GEOID: 2012A
GRID: NORTHING: 618098.396 EASTING: 1807119.567

NOTE: ~~POT~~ POINT ON SEC LINE FROM SAN-6-18.33-1990 PLANS

RECORD:
FD MON BOX
6/10/08, DH
FD MONBOX
REF28
11/15/19, JLL

FD MONBOX W/ 1"IPIN
8/20/25, JAM
REF 28

DIST, 27A-28= 5.18'

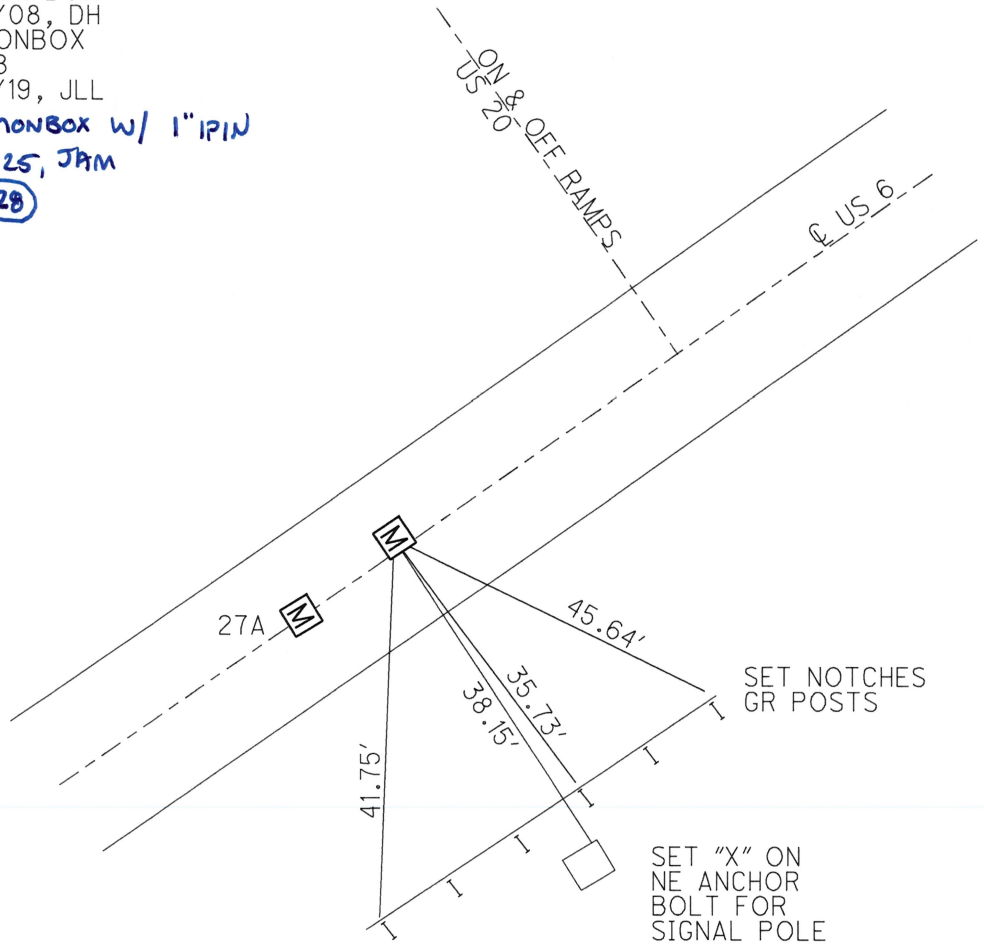

* NEEDS LID

O.D.O.T. DISTRICT 2 SURVEY OFFICE (USE ONLY)

PERSONNEL

NOTES LEU JAM
H.C. LEU JAM
R.C. MILLER JAB

DWG BY GARRETT

REFERENCE NO. 28 AA


DATE ~~5/14/19~~ 8/20/25
WEATHER ~~SUNNY~~ CLOUDY
TEMP. ~~53°~~ 63°

PID 77825

SHEET 3 OF 18


ROUTE US 6
COUNTY SANDUSKY
TOWNSHIP SANDUSKY
SECTION 25
T 5 N R 15 E

TYPE MONUMENT MONBOX W/ 1" IPIN ✓
ON SURFACE - ~~BELOW~~ ON ✓
OFFSET ℄ PAVEMENT ON ✓ LT : RT
- TO - EDGE PAVEMENT
STATION: 992+00

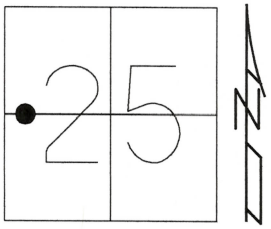

HORZ.DATUM: NAD83 (2011)
GEOID: 2012A
GRID: NORTHING: 618616.178
EASTING: 1807817.373

RECORD:
FD MONBOX
11/15/19, JLL
CKSTA992
5/27/2020
FD MONBOX W/ 1"IPIN
DOWN 1'
8/20/25, JAM
REF2BAA

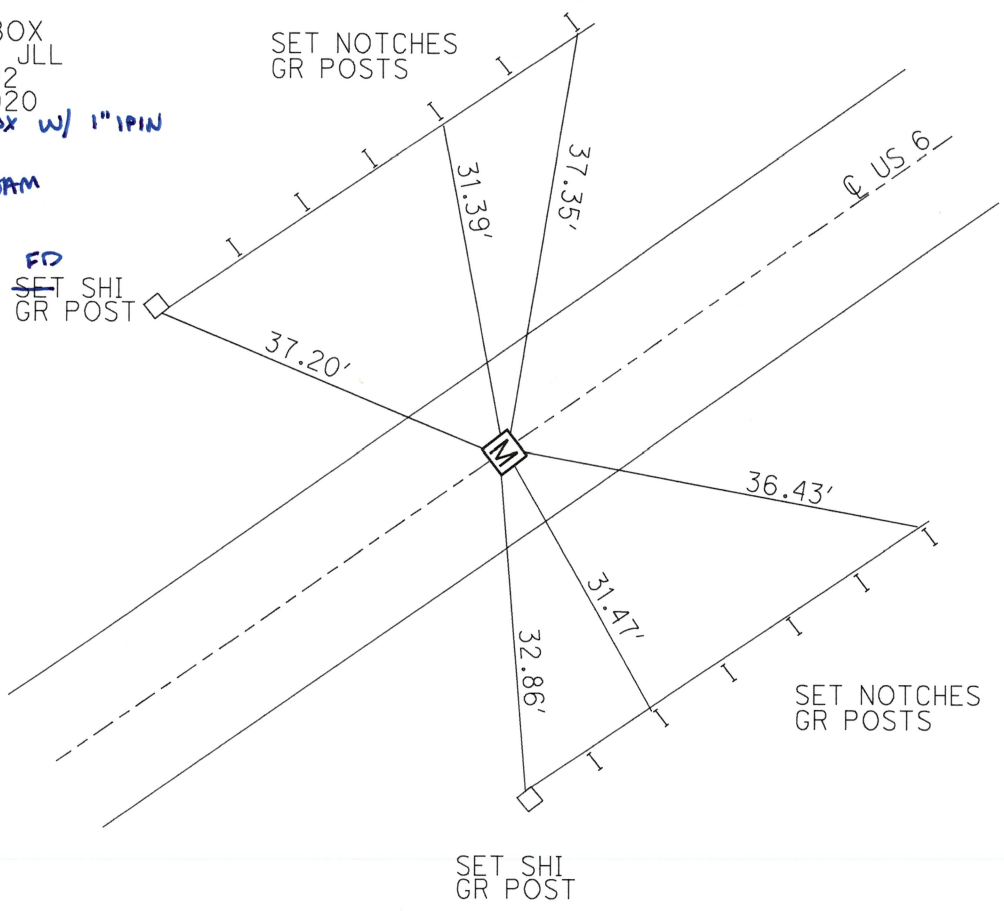

* LOOK ON THE BACK FOR REF28 AB

O.D.O.T. DISTRICT 2 SURVEY OFFICE

PERSONNEL


NOTES HOMAN JAM
H.C. HOMAN JAM
R.C. ROUSOS JAB

REFERENCE NO. 28-A

DATE ~~8/06/09~~ 8/20/25
WEATHER ~~SUNNY~~ CLOUDY
TEMP. ~~70°~~ 63°

SHEET 3 OF 17
ROUTE US 6
COUNTY SANDUSKY
TOWNSHIP SANDUSKY
SECTION 25
T 5 N R 15 E

TYPE MONUMENT MON.BOX W/ 1" IPIN
ON SURFACE - ~~BELOW~~ ON
~~LEFT~~ - ℄ PAV'T - ~~RIGHT~~ ON
____ TO ____ EDGE PAVEMENT
S.L.M. 999+66.74
GPS Northing: 619074.832 Easting: 1808431.725

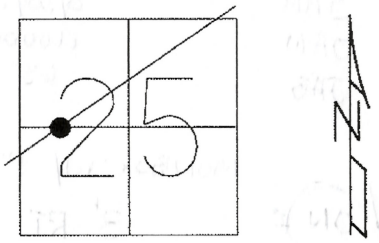


NOTE: PI FROM PLANS SAN-6-18.33-1990.

NOTE: 9/03/91
PREVIOUS MONUMENTS:
P.K. & WASHER
"+" IN CONC. PAV'T

P.I. 35+73
ON N-S 1/4 SEC. LINE

RESET P.K. &WASHER
9/03/91

FD MON BOX
ON CORPLINE
6/10/08 DH
FD MONBOX W/ 1" IPIN
DOWN .7'
8/20/25. JAM

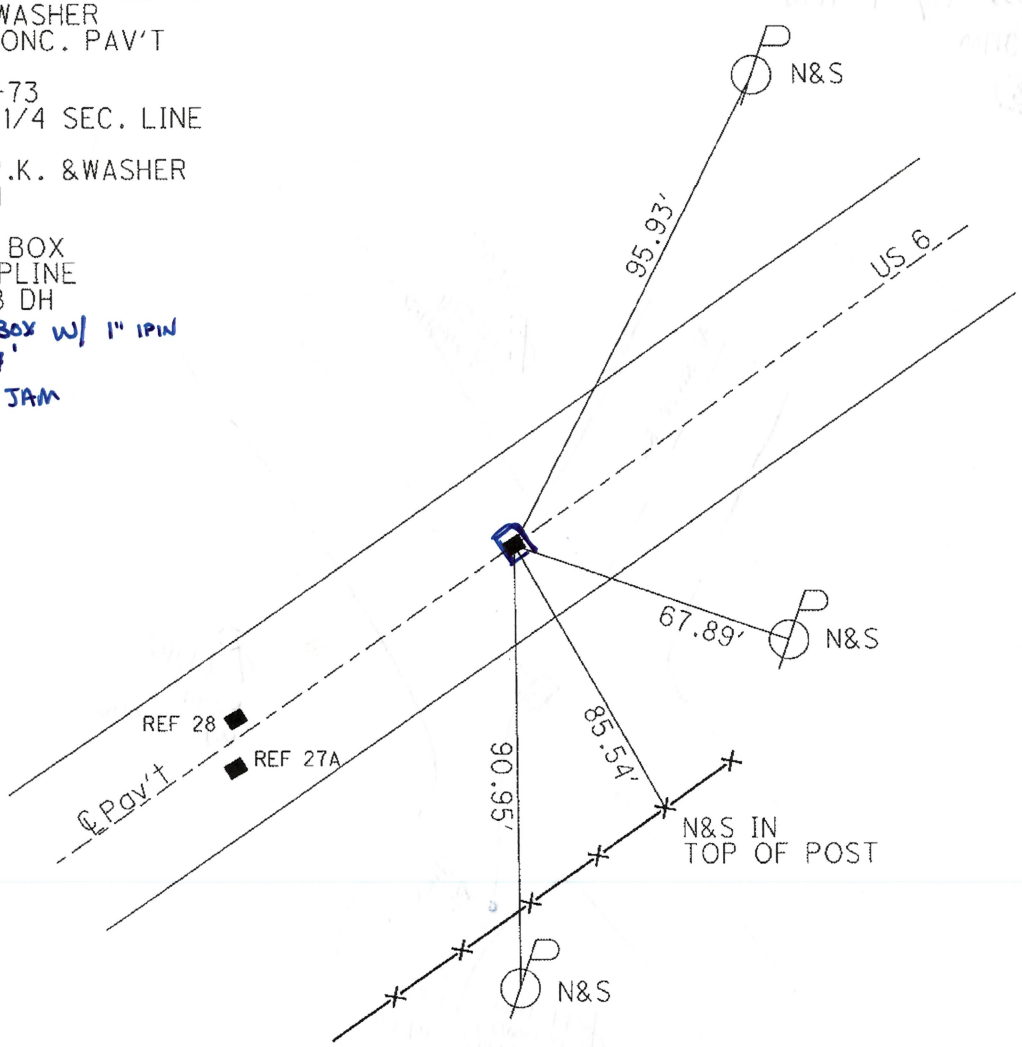

O.D.O.T. DISTRICT 2 SURVEY OFFICE

PERSONNEL

NOTES HOMAN ~~JAM~~
H.C. HOMAN ~~JAM~~
R.C. ROUSOS ~~JAB~~


REFERENCE NO. 28-B

DATE ~~8/06/09~~ 8/20/25
WEATHER ~~SUNNY~~ CLOUDY
TEMP. ~~70°~~ 63

SHEET 4 OF 17

ROUTE US 6
COUNTY SANDUSKY
TOWNSHIP SANDUSKY
SECTION 25
T 5 N R 15 E

TYPE MONUMENT ~~P.K.~~ MAG/WASHER
~~ON SURFACE~~ - ~~BELOW~~ ~~3"~~
~~LEFT~~ - ℄ PAV'T - RIGHT 1.5' ✓
____ TO ____ EDGE PAVEMENT
S.L.M. 1016+09.50
GPS Northing: 620056.653 Easting: 1809748.783

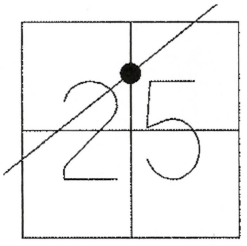


NOTE: 9/03/91
PREVIOUS MONUMENTS:
P.K. & WASHER
MINE SPIKE

P.I. 52+05
ON N-S 1/2 SEC. LINE
RECORD = 00°13' RT.

RESET P.K. &WASHER
STA. 1024+42
9/03/91

SET MAG & WASHER
10/29/09 DH
FD MAG/WASHER
8/20/25, JAM
REF 28B ✓

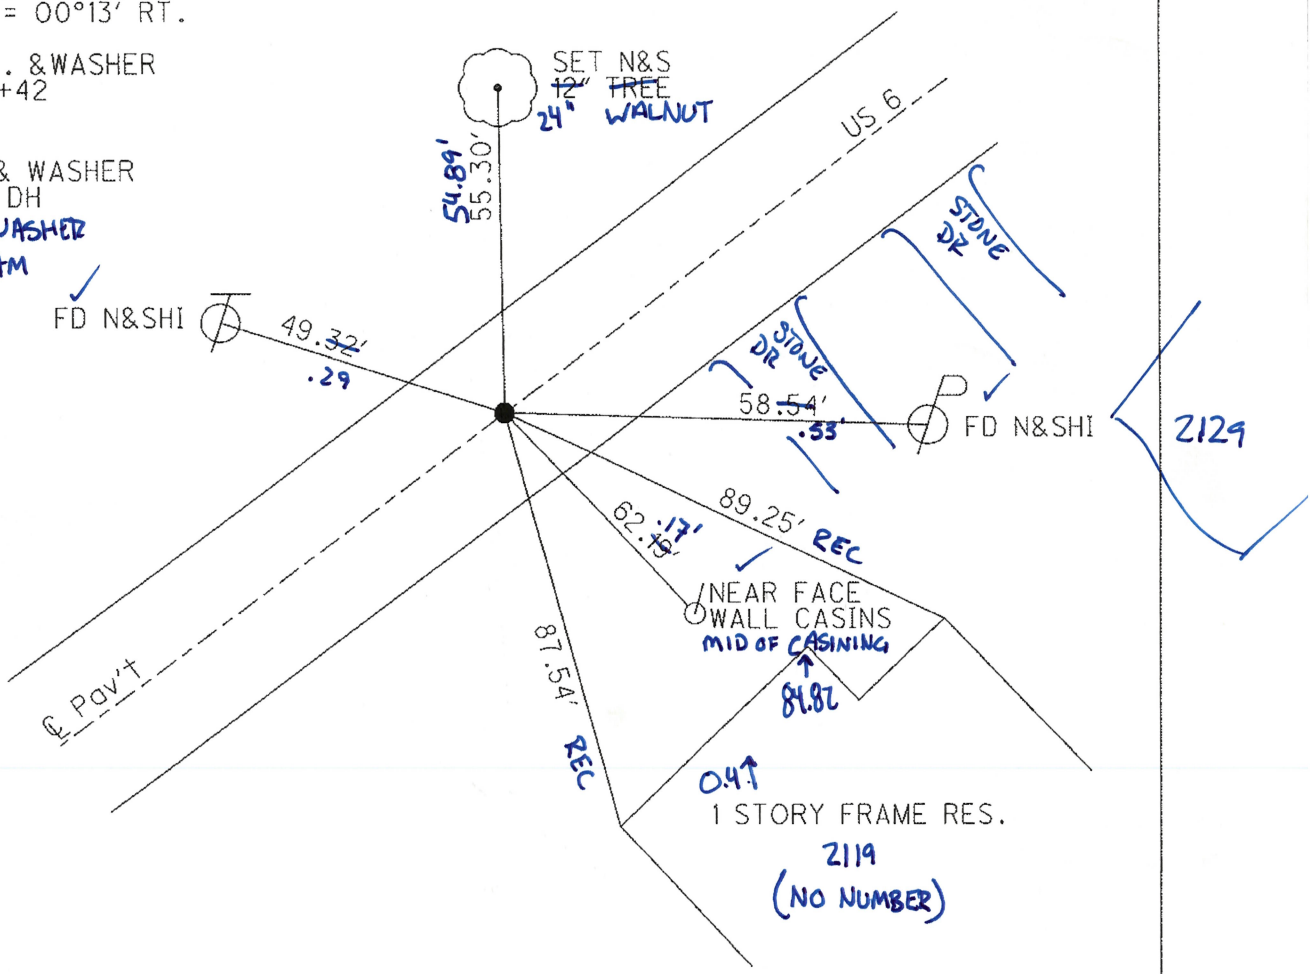

O.D.O.T. DISTRICT 2 SURVEY OFFICE

PERSONNEL

NOTES HOMAN ~~JAM~~ JAM
H.C. HOMAN ~~JAM~~ JAM
R.C. ROUSOS ~~JAB~~ JAB


REFERENCE NO. 29

DATE ~~8/06/09~~ 8/20/25
WEATHER ~~SUNNY~~ CLOUDY
TEMP. ~~75°~~ 60

SHEET 5 OF 17

ROUTE US 6
COUNTY SANDUSKY
TOWNSHIP SANDUSKY, RILEY
SECTION 24 & 19
T 5 N R 15&16 E


TYPE MONUMENT ~~P.K.~~ MAG & WASHER
ON SURFACE - ~~BELOW~~ ON ✓
~~LEFT~~ - ℄ PAV'T - RIGHT 2.0' ✓
____ TO ____ EDGE PAVEMENT
S.L.M. 1408+81.24
GPS Northing: 621997.326 Easting: 1812382.826

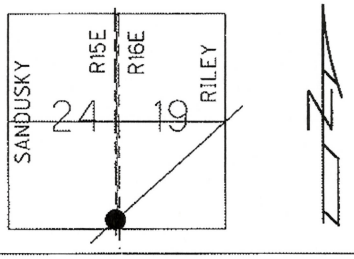

NOTE: 9/03/91
PREVIOUS MONUMENTS:
SMALL SPIKE & WASHER
P.K. & WASHER
P.I. 84+68.10

FD P.K.'S & WASHERS
6/10/09 DH

SET MAG & WASHER
STA.=1048+81.24
10/29/09 DH
PD MAG/WASHER
8/20/25, JAM
REF29

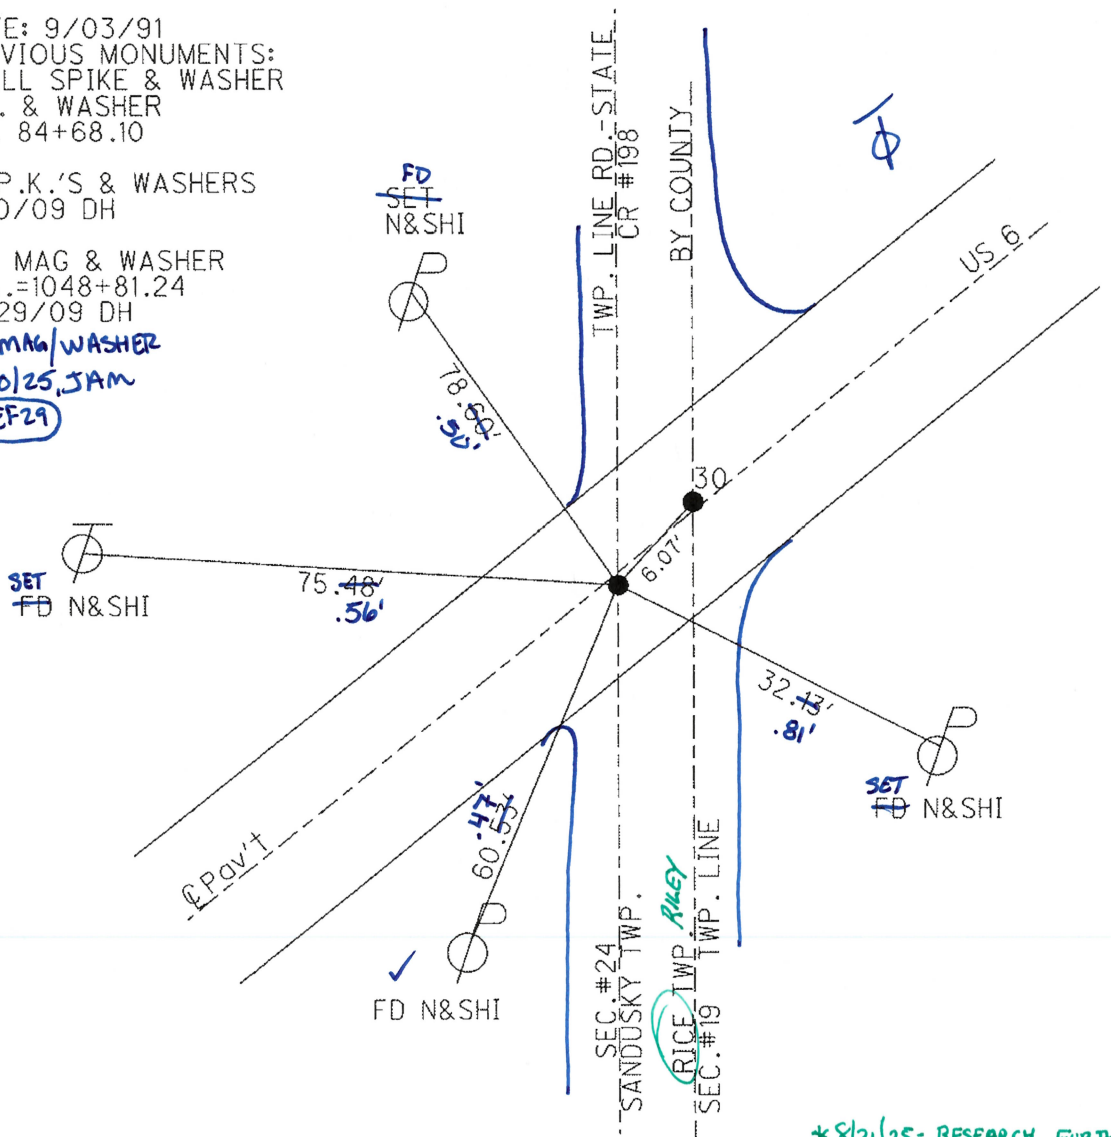

* 8/21/25 - RESEARCH FURTHER W/ COUNTY - JAB

O.D.O.T. DISTRICT 2 SURVEY OFFICE

PERSONNEL

NOTES HOMAN JAM
H.C. HOMAN JAM
R.C. ROUSOS JAB


REFERENCE NO. 30

DATE ~~8/06/09~~ 8/20/25
WEATHER ~~SUNNY~~ CLOUDY
TEMP. ~~75°~~ 60

SHEET 6 OF 17

ROUTE US 6
COUNTY SANDUSKY
TOWNSHIP SANDUSKY, RILEY
SECTION 24 & 19
T 5 N R 15&16 E


TYPE MONUMENT MAG ~~P.K.~~ & WASHER
ON SURFACE - ~~BELOW~~ ON ✓
~~LEFT~~ - ℄ PAV'T - RIGHT A= 2.0' -STATE ✓
____ TO ____ EDGE PAVEMENT
S.L.M. 1048+86.97
GPS Northing: 622002.101 Easting: 1812386.537

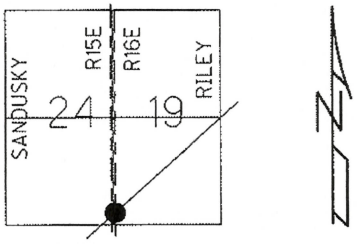

NOTE: 9/03/91
PREVIOUS MONUMENTS:
SMALL SPIKE & WASHER
P.K. & WASHER
P.I. 84+68.10

FD P.K.'S & WASHERS
6/10/09 DH

SET MAG & WASHER
FD MAG/WASHER
8/20/25, JAM
REF30

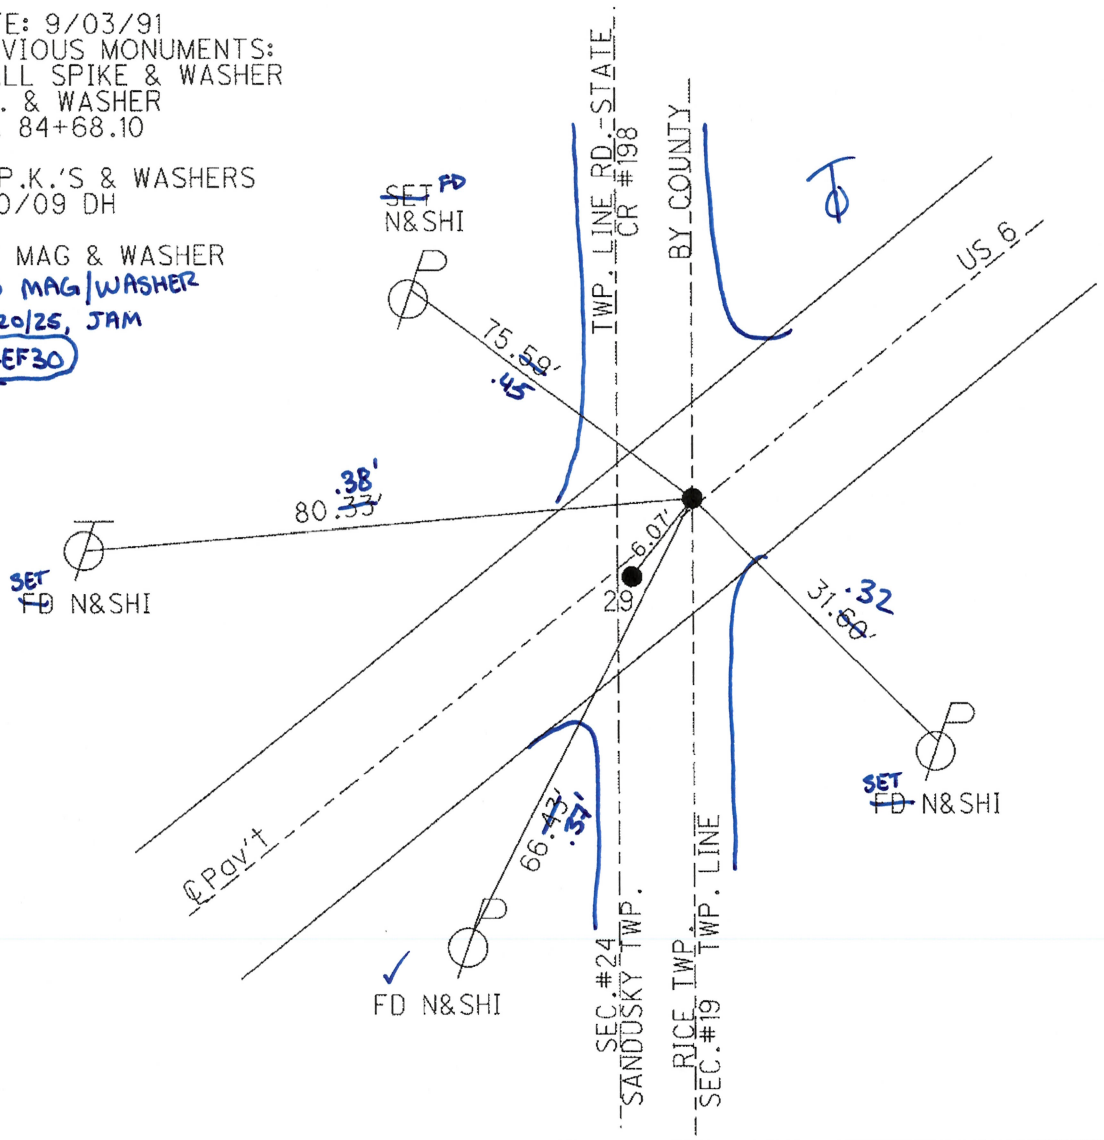

O.D.O.T. DISTRICT 2 SURVEY OFFICE

PERSONNEL


NOTES HOMAN JAM
H.C. HOMAN JAM
R.C. ROUSOS JAB

REFERENCE NO. 30-A

DATE ~~8/06/09~~ 8/20/25
WEATHER ~~SUNNY~~ CLOUDY
TEMP. ~~80°~~ 60°

SHEET 7 OF 17

ROUTE US 6
COUNTY SANDUSKY
TOWNSHIP RILEY
SECTION 19
T 5 N R 16 E

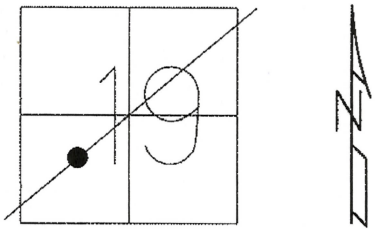


TYPE MONUMENT ~~P.K.~~ MAG & WASHER
~~ON SURFACE - BELOW~~ ~~3"~~ ON
~~LEFT~~ - ~~℄ PAV'T~~ - RIGHT 3.5' ✓
TO EDGE PAVEMENT
S.L.M. 1071+25.60
GPS Northing: 623321.623 Easting: 1814194.937

NOTE: 9/03/91
P.I. WAS CHANGED IN THE FIELD. DOES NOT CONFORM WITH 1926 PLAN, JACK CRONIN 1975

PREVIOUS MONUMENTS:
SMALL SPIKE & WASHER
P.K. & WASHER
RECORD P.I. 107+12.4

FD P.K. & WASHER, 3" DOWN 6/10/09 DH

SET MAG & WASHER 10/29/09 DH
FD MAG/W
REF30A
8/20/25, JAM

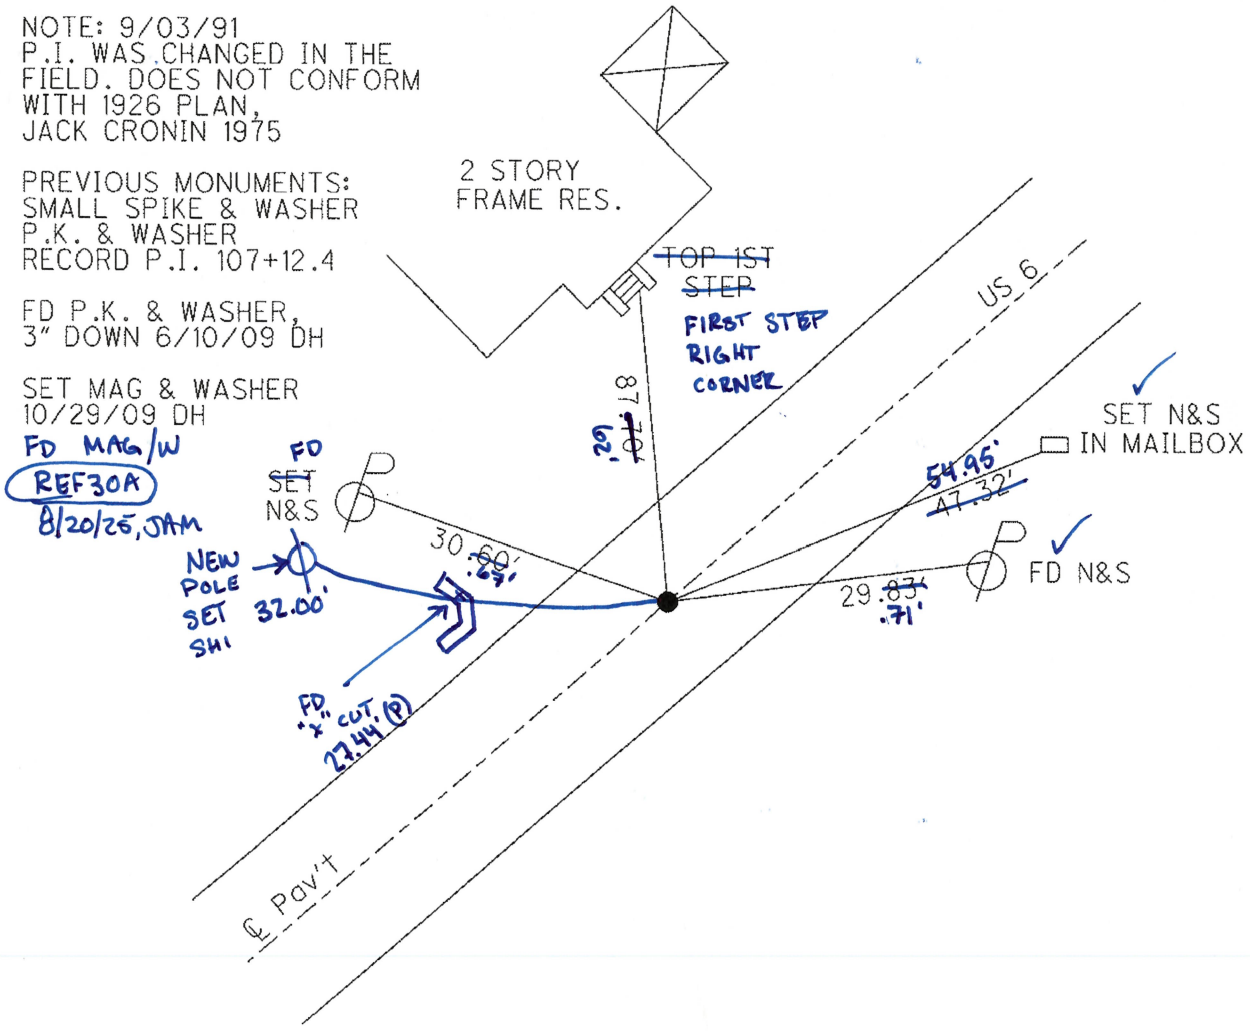

O.D.O.T. DISTRICT 2 SURVEY OFFICE


PERSONNEL

NOTES HOMAN ~~JAM~~
H.C. HOMAN ~~JAM~~
R.C. ROUSOS ~~JAB~~

REFERENCE NO. 30-B
DATE ~~8/06/09~~ 8/20/25
WEATHER ~~SUNNY~~ CLOUDY
TEMP. ~~80°~~ 60°

SHEET 8 OF 17
ROUTE US 6
COUNTY SANDUSKY
TOWNSHIP RILEY
SECTION 19
T 5 N R 16 E


TYPE MONUMENT ~~P.K.~~ MAG & WASHER
~~ON SURFACE~~ - BELOW ~~3"~~ ON
~~LEFT~~ - ℄ PAV'T - RIGHT 2.5'
TO EDGE PAVEMENT
S.L.M. 1086+30.81
GPS Northing: 624241.837 Easting: 1815386.030

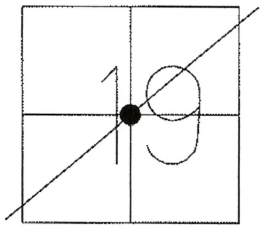

NOTE: 9/03/91
P.I. WAS CHANGED IN THE
FIELD. DOES NOT CONFORM
WITH 1926 PLAN, STA. 122+17.4
JACK CRONIN 1975
SEE SAN-6-20.91 PLANS
PREVIOUS MONUMENTS:
SMALL MINE SPIKE
P.K. & WASHER
RECORD P.I. 122+17.4

FD P.K. 3" DOWN
6/10/09 DH

SET MAG & WASHER
10/29/09 DH
FD MAG/WASHER
8/20/25, JAM
REF30B

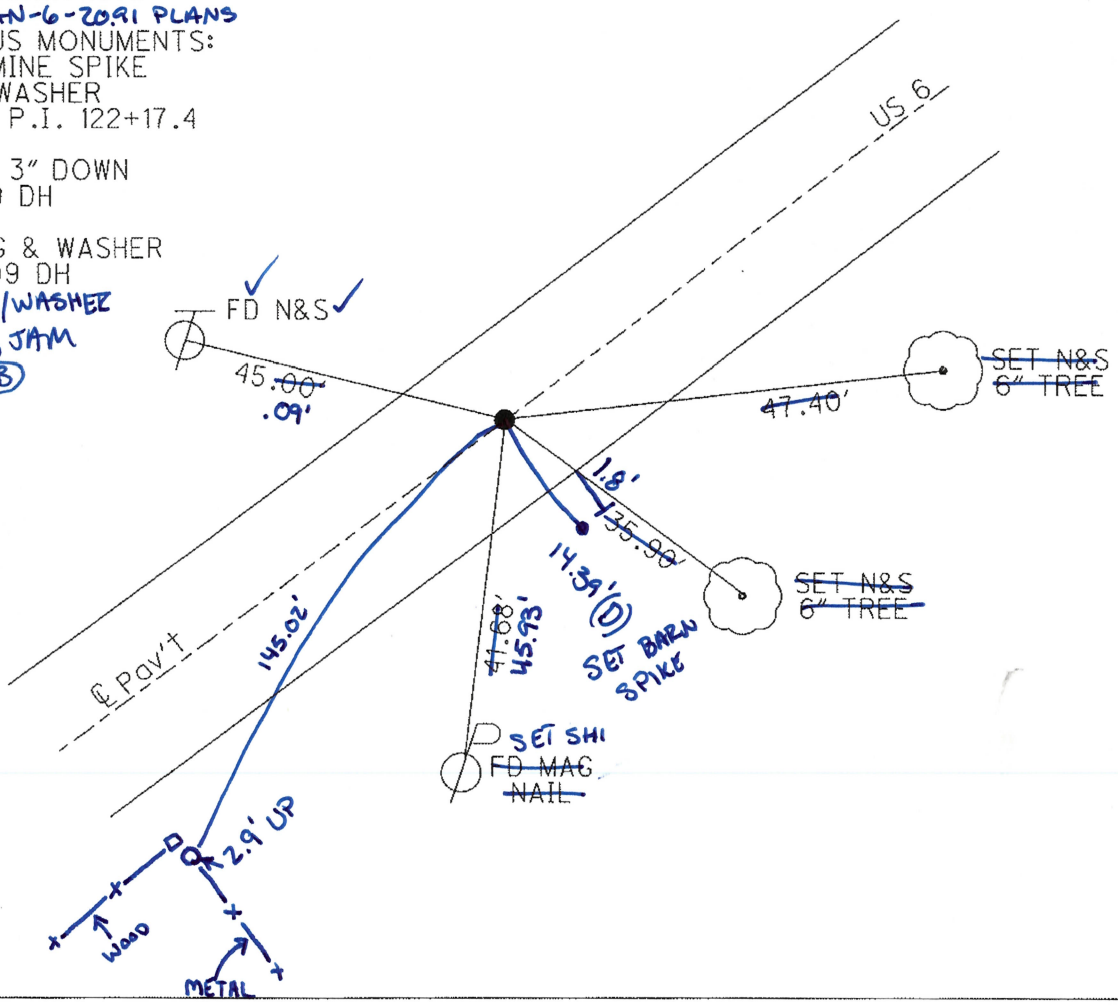


O.D.O.T. DISTRICT 2 SURVEY OFFICE

PERSONNEL

NOTES HOMAN JAM
H.C. HOMAN JAM
R.C. ROUSOS JAB

REFERENCE NO. 30-C
DATE ~~8/18/09~~ 8/20/25
WEATHER CLOUDY ✓
TEMP. ~~75°~~ 60°

SHEET 9 OF 17
ROUTE US 6
COUNTY SANDUSKY
TOWNSHIP RILEY
SECTION 19 & 20
T 5 N R 16 E

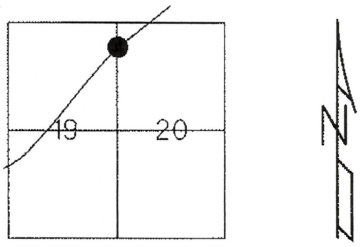


TYPE MONUMENT MAG ~~P.K.~~ & WASHER
ON SURFACE - ~~BELOW~~ ON ✓
~~LEFT~~ - ℄ PAV'T - RIGHT 2' ✓
____ TO ____ EDGE PAVEMENT
S.L.M. 1123+67.22
GPS Northing: 626496.265 Easting: 1818365.650

NOTE: 9/03/91
OLD PI STA. 159+54.15
SEE SAN-6-20.91 PLANS
PREVIOUS MONUMENTS:
SMALL MINE SPIKE
P.K. & WASHER

FD P.K. SHANK,
6/10/08 DH

SET MAG & WASHER
10/29/09 DH
FD MAG/W
REF 30C
8/20/25, JAM

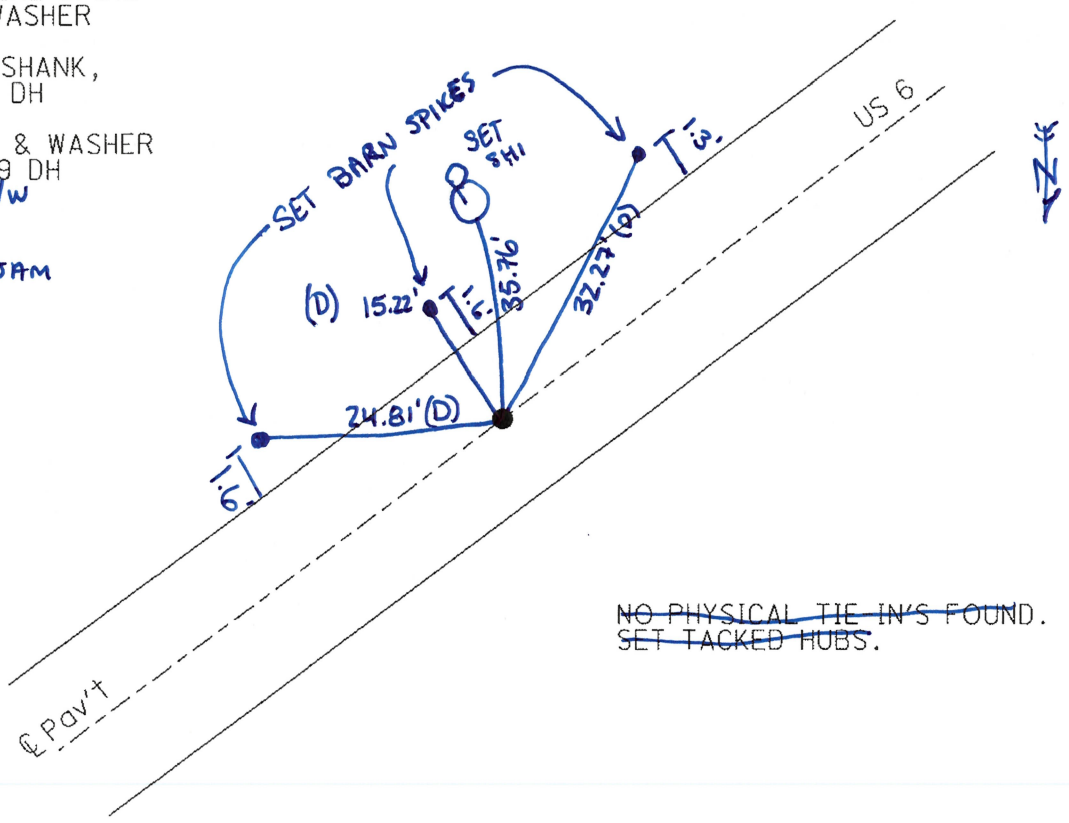

~~NO PHYSICAL TIE-IN'S FOUND.~~
~~SET TACKED HUBS.~~

FLIP OVER! BARN SPIKES ARE ON THE SOUTH SIDE

O.D.O.T. DISTRICT 2 SURVEY OFFICE

PERSONNEL

NOTES HOMAN ~~JAM~~
H.C. HOMAN ~~JAM~~
R.C. ROUSOS ~~JAB~~


REFERENCE NO. 31

DATE ~~8/06/09~~ 8/20/25
WEATHER ~~SUNNY~~ CLOUDY
TEMP. ~~80°~~ 60°

SHEET 10 OF 17

ROUTE US 6
COUNTY SANDUSKY
TOWNSHIP RILEY
SECTION 17
T 5 N R 16 E

TYPE MONUMENT P.K. SHANK
~~ON SURFACE~~ - ~~BELOW~~ ~~ON~~ 0.5'
~~LEFT~~ - ℄ PAV'T - ~~RIGHT~~ ~~1.0' RT~~ ON
TO EDGE PAVEMENT
S.L.M. 1144+66.78
GPS Northing: 627742.125 Easting: 1820055.762

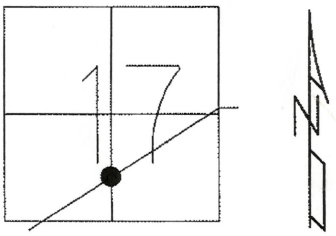


NOTE: 9/13/91
PREVIOUS MONUMENT:
R.R. SPIKE

FD P.K. SHANK,
6/10/08 DH

SET MAG & WASHER
10/29/09 DH

FD R.~~SPK~~ DOWN 0.5'
REF 31
8/20/25, JAM

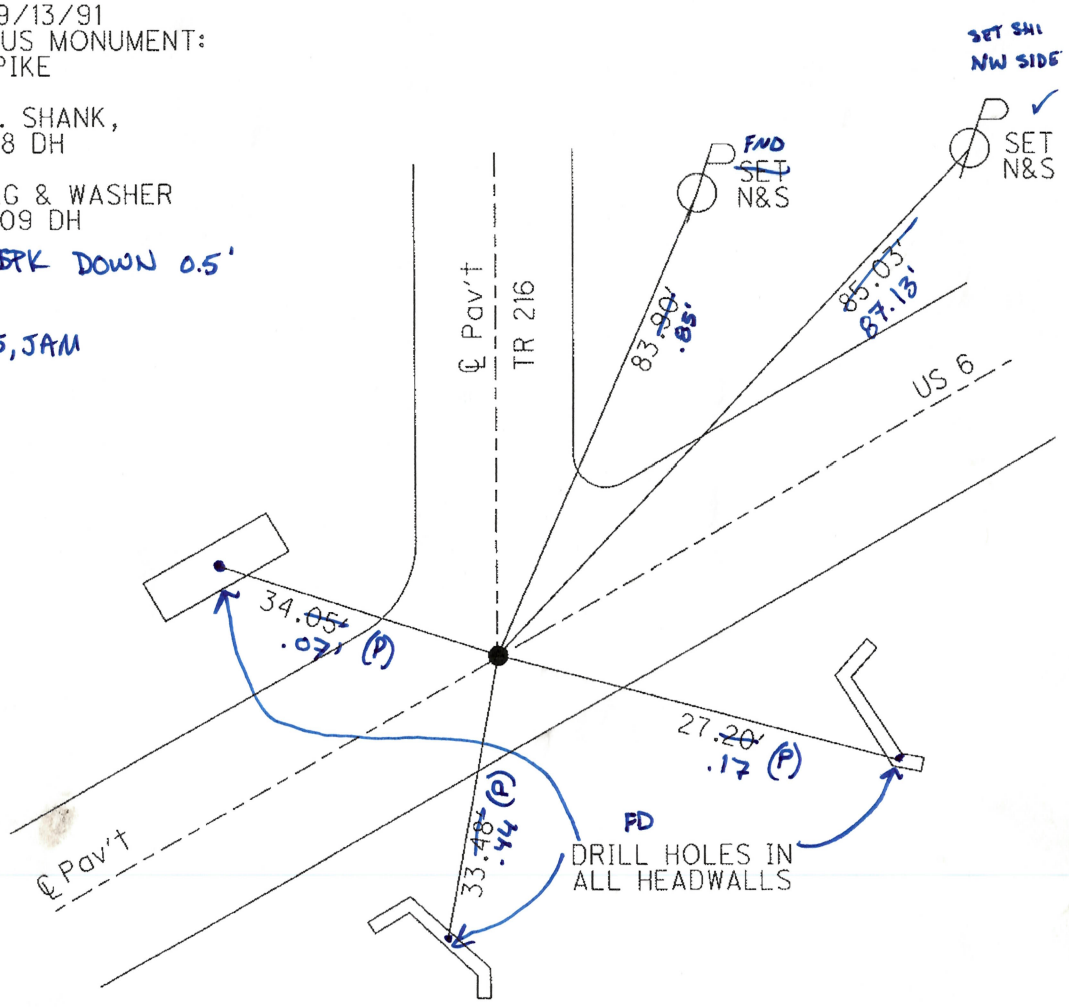

*PLUMBED TO RSPK IN HOLE

O.D.O.T. DISTRICT 2 SURVEY OFFICE

PERSONNEL


NOTES HOMAN TDN
H.C. HOMAN JAM
R.C. ROUSOS JAB
LSPC

REFERENCE NO. 32

DATE 8/19/25 ~~8/18/09~~
WEATHER CLOUDY/CALM
TEMP. 69° ~~75°~~

SHEET 11 OF 17
ROUTE US 6
COUNTY SANDUSKY
TOWNSHIP RILEY
SECTION 17
T 5 N R 16 E

TYPE MONUMENT ~~P.K.~~ MAG & WASHER
ON SURFACE - ~~BELOW~~ ON
~~LEFT~~ - ℄ ~~PAV~~'T - (RIGHT) 1.5'
____ TO ____ EDGE PAVEMENT
S.L.M.
GPS Northing: 628390.855 Easting: 1820937.530

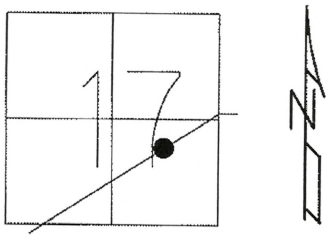


NOTE: 9/13/91
PREVIOUS MONUMENTS:
R.R. SPIKE

FD R.R.SPIKE
6/10/08 DH

RESET MAG& WASHER
10/29/09 DH

FND MAG/W
REF32
8/19/25, JAM

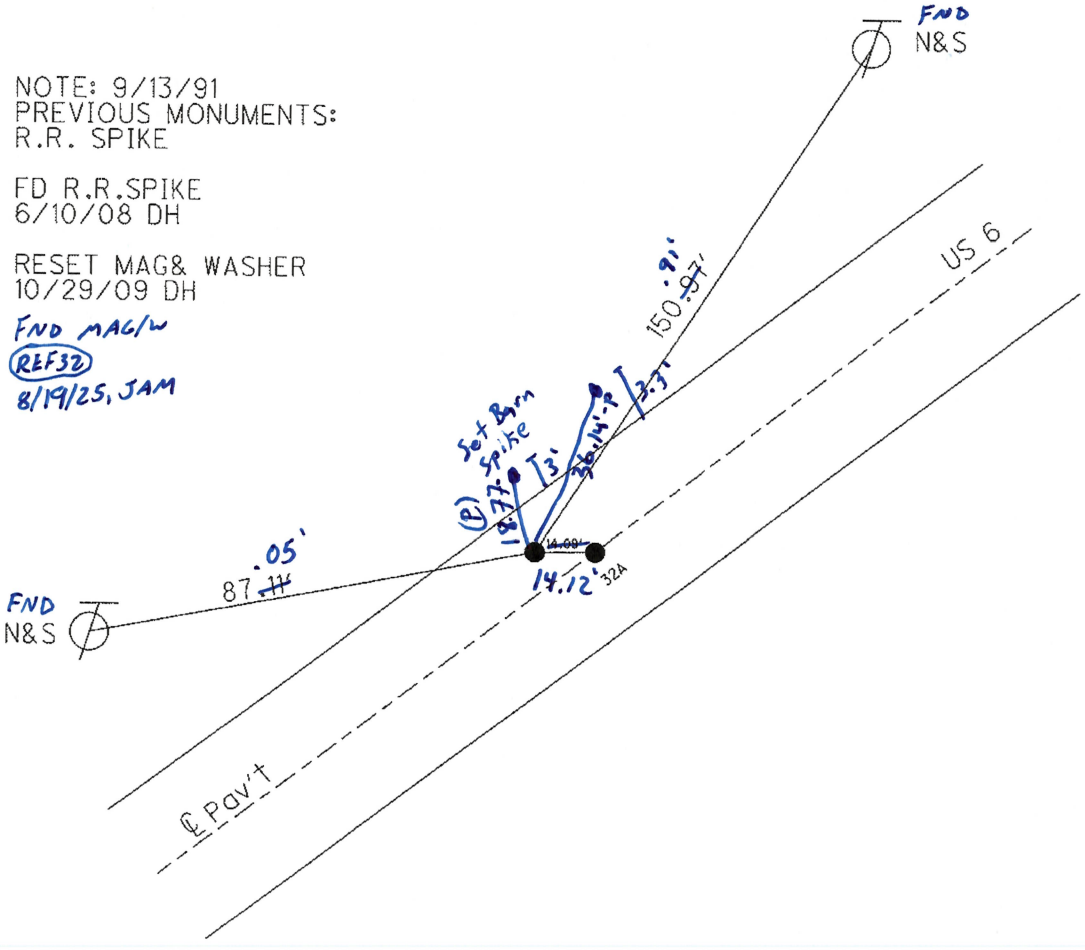

O.D.O.T. DISTRICT 2 SURVEY OFFICE


PERSONNEL

NOTES HOMAN TON
H.C. HOMAN JAM
R.C. ROUSOS JAB
LSPL

REFERENCE NO. 32A
DATE ~~8/18/09~~ 8/19/25
WEATHER CLOUDY/CALM
TEMP. ~~75°~~ 69°

SHEET 12 OF 17
ROUTE US 6
COUNTY SANDUSKY
TOWNSHIP RILEY
SECTION 17
T 5 N R 16 E


TYPE MONUMENT ~~P.K.~~ MAG & WASHER
ON SURFACE - ~~BELOW~~ ON
~~LEFT~~ - ℄ PAV'T - ~~RIGHT~~ 0.5' LT
____ TO ____ EDGE PAVEMENT
S.L.M. 1155+75.39
GPS Northing: 628397.241 Easting: 1820950.124

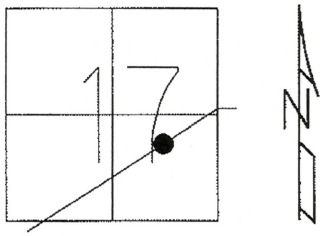

NOTE: 9/13/91
PREVIOUS MONUMENTS:
R.R. SPIKES
P.I. OLD STA.1163+96

FD R.R.SPIKE
6/10/08 DH

RESET MAG & WASHER
10/29/09 DH
FND MAG/W
REF32A
8/19/25. TON

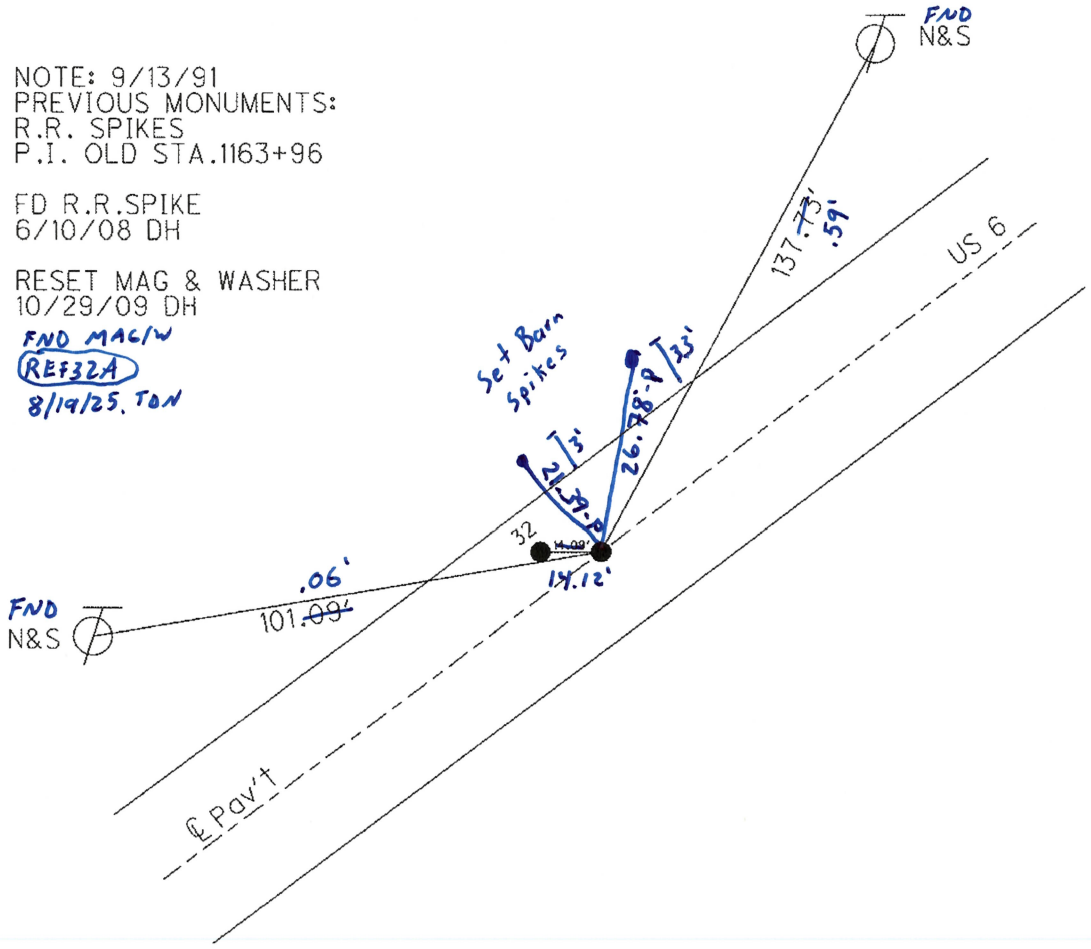

O.D.O.T. DISTRICT 2 SURVEY OFFICE

PERSONNEL


NOTES ~~HOMAN~~ JAM
H.C. ~~HOMAN~~ JAM
R.C. ~~ROUSOS~~ JAB


REFERENCE NO. 33

DATE 8/18/09 8/20/25
WEATHER CLOUDY ✓
TEMP. 75° 68

SHEET 13 OF 17
ROUTE US 6
COUNTY SANDUSKY
TOWNSHIP RILEY
SECTION 17
T 5 N R 16 E

TYPE MONUMENT 1" IRON ROD ✓
~~ON SURFACE~~ - BELOW DOWN 3"
~~LEFT - ℄ PAV'T - RIGHT~~
8'± TO WEST EDGE PAVEMENT OF TR222
S.L.M. 1177+73.50
GPS Northing: 629673.848 Easting: 1822739.560

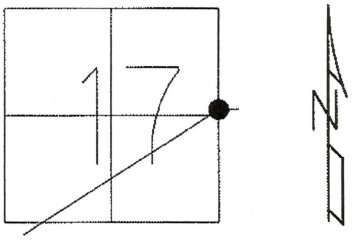

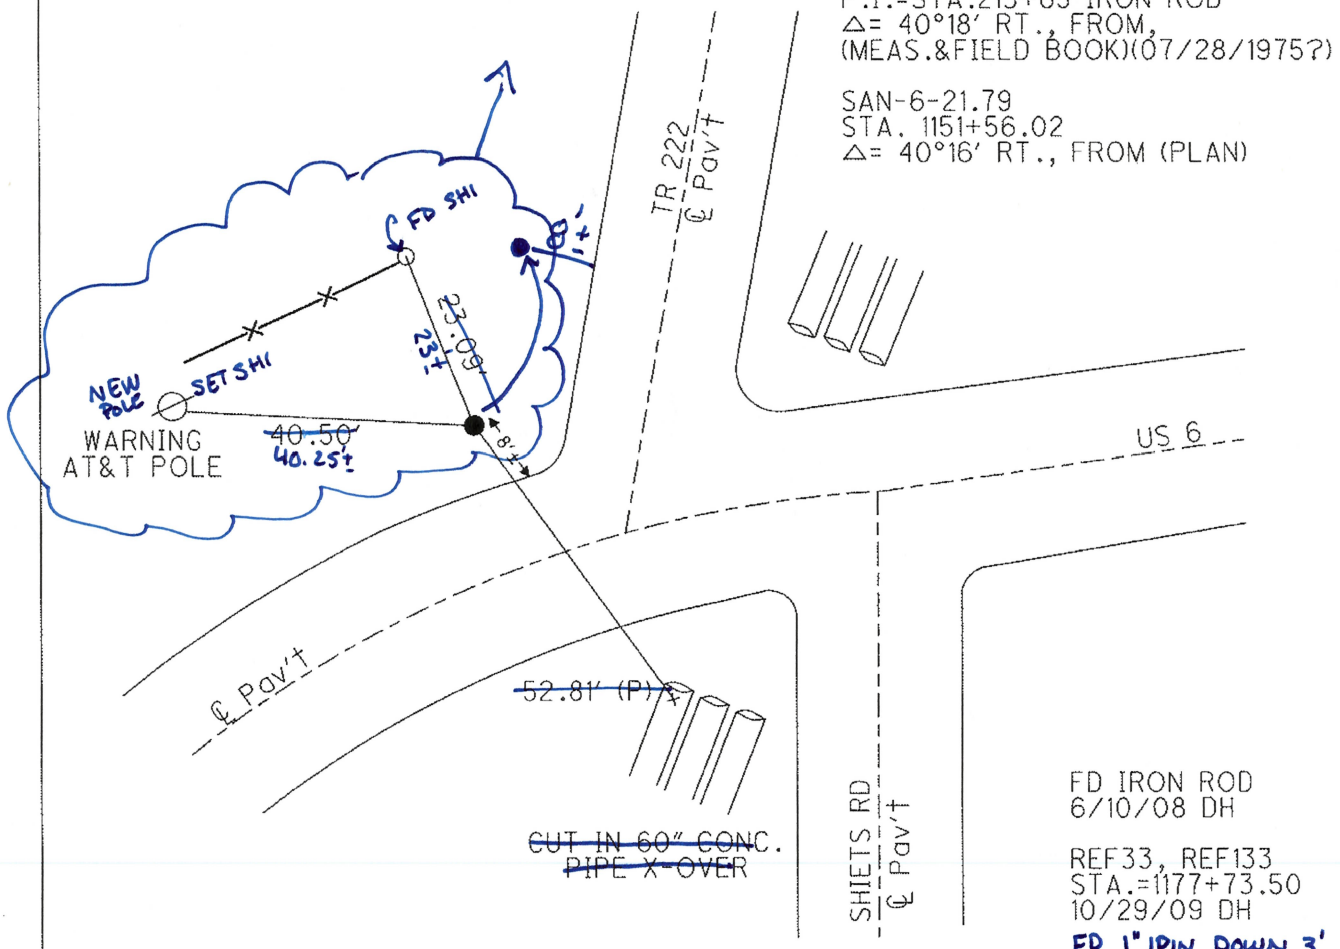

O.D.O.T. DISTRICT 2 SURVEY OFFICE


PERSONNEL

NOTES HOMAN TDN
H.C. HOMAN JAM
R.C. ROUSOS JAB

REFERENCE NO. 34

DATE 8/19/25 ~~8/18/09~~ ✓
WEATHER CLOUDY/CALM
TEMP. 69° ~~75°~~

SHEET 14 OF 17
ROUTE 6
COUNTY SANDUSKY
TOWNSHIP RILEY
SECTION 16
T 5 N R 16 E

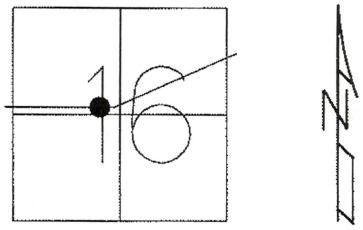

TYPE MONUMENT ~~P.K.~~ MAG & WASHER ✓
ON SURFACE - ~~BELOW~~ ON ✓
~~LEFT~~ - ~~℄ PAV'T~~ - RIGHT ~~+~~ ON
____ TO ____ EDGE PAVEMENT
S.L.M. 1194+29.39
GPS Northing: 629535.246 Easting: 1824389.514


NOTE: 9/13/91
PLAN P.I. OF R/W
△=12° 55' LT
STA. 230+08.12

SAN-6-21.59
STA. 1167+86.50,
FROM (RECORD)

PREVIOUS MONUMENTS:
P.K. & WASHER, SMALL SPIKE

FD P.K. & WASHER
6/10/08 DH

SET MAG & WASHER
10/29/09 DH

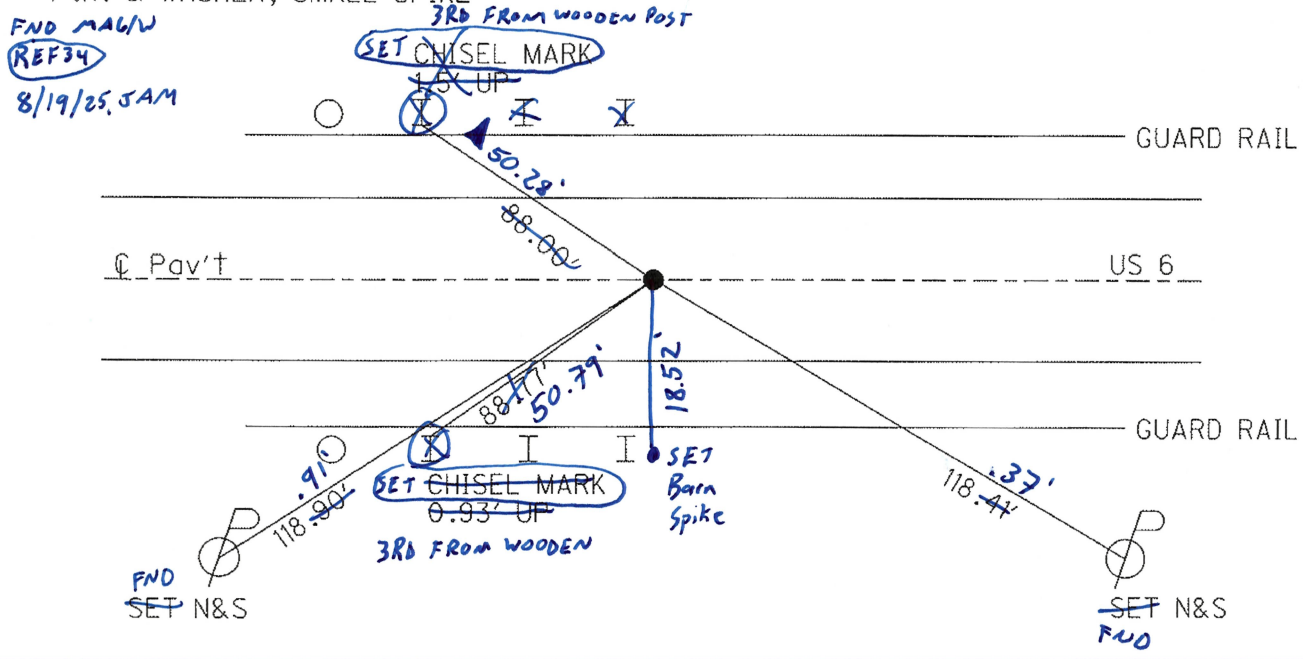

O.D.O.T. DISTRICT 2 SURVEY OFFICE

PERSONNEL

NOTES HOMAN JAM
H.C. HOMAN JAM
R.C. ROUSOS JAB


REFERENCE NO. 35

DATE ~~8/06/09~~ 8/20/25
WEATHER ~~SUNNY~~ CLOUDY
TEMP. ~~80°~~ 63°

SHEET 15 OF 17

ROUTE US 6
COUNTY SANDUSKY
TOWNSHIP RILEY
SECTION 16
T 5 N R 16 E

TYPE MONUMENT 1" IRON ROD ✓
ON SURFACE - ~~BELOW~~ ON
~~LEFT - ℄ PAV'T - RIGHT~~
22' N TO S. EDGE PAVEMENT
S.L.M. 1197+38.92
GPS Northing: 629508.677 Easting: 1824697.823

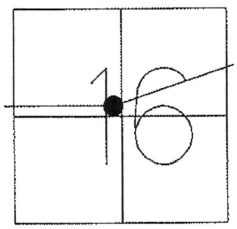




NOTE = PI OF SPIRAL

FD 1" IRON ROD
6/10/08 DH
FD 1" IPIN
REF35
8/20/25, JAM



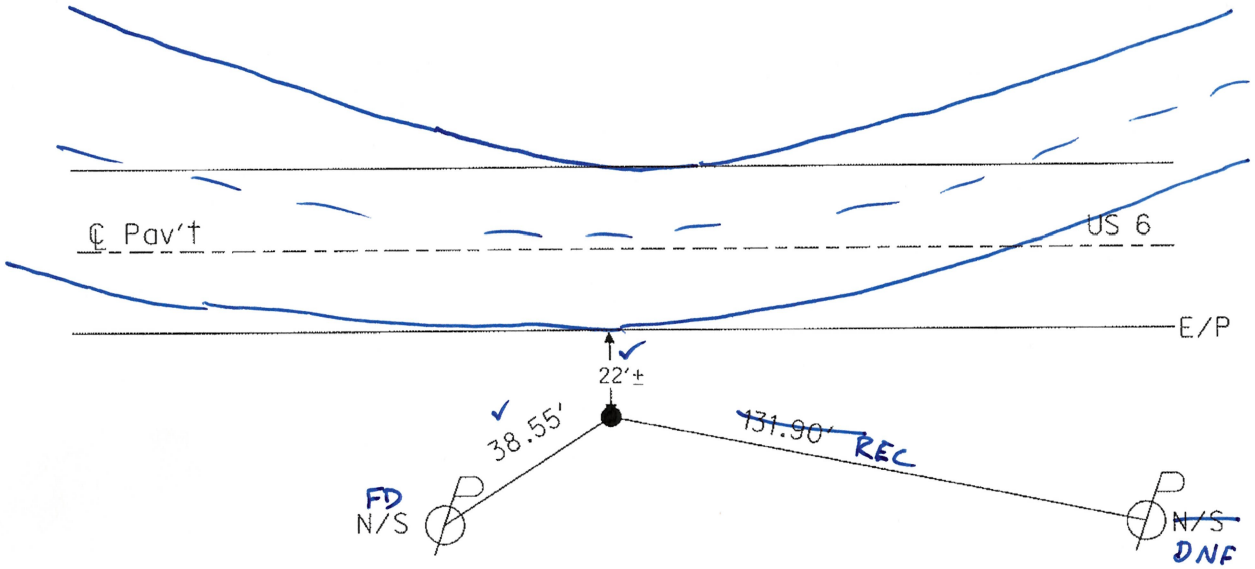

O.D.O.T. DISTRICT 2 SURVEY OFFICE

PERSONNEL


NOTES HOMAN TDN
H.C. HOMAN JAM
R.C. ROUSOS JAB

REFERENCE NO. 36 SHEET 16 OF 17

DATE ~~8/06/09~~ 8/19/25
WEATHER ~~SUNNY~~ CALM/Overcast
TEMP. 69° ~~80°~~

ROUTE US 6
COUNTY SANDUSKY
TOWNSHIP RILEY
SECTION 16
T 5 N R 16 E


TYPE MONUMENT ~~P.K.~~ MAG & WASHER ✓
ON SURFACE - ~~BELOW~~ ON ✓
~~LEFT~~ - ℄ PAV'T - RIGHT 2' RT ✓
____ TO ____ EDGE PAVEMENT
S.L.M. 1200+86.39 → 3264.44
GPS Northing: 629625.737 Easting: 1825024.838

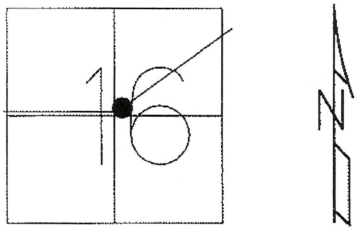

PREVIOUS MONUMENTS:
P.K. & WASHER
SMALL SPIKE

℄ OF RW
P.I.- PLAN
△ = 12° 26' 00" LT.
△ = 12° 26' 22" LT.MEAS.
STA. 236+49

NOTE: 9/13/91
SAN-6-21.59
ERROR IN DATA ON PLAN

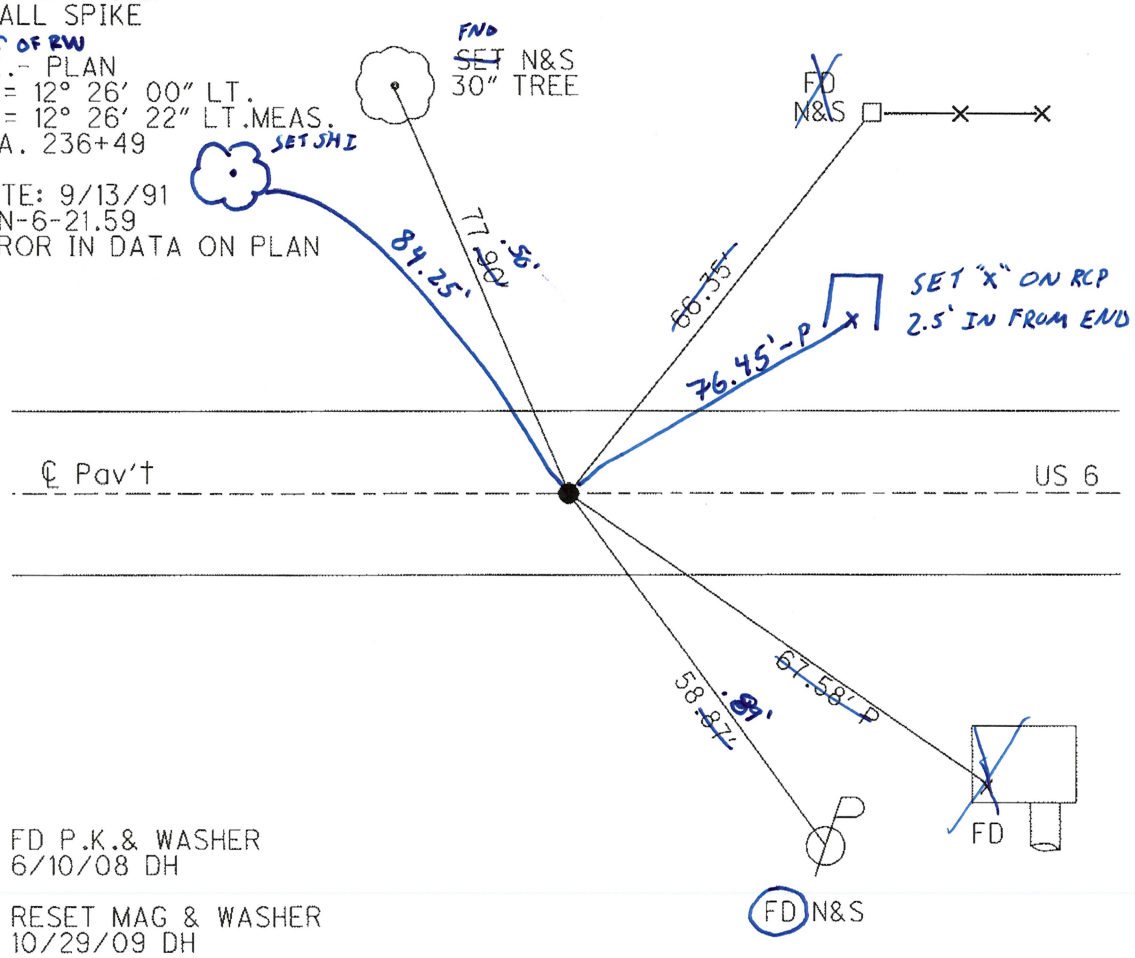

FD P.K.& WASHER
6/10/08 DH

RESET MAG & WASHER
10/29/09 DH

FND MAG/lw
REF36
8/19/25, TDN

O.D.O.T. DISTRICT 2 SURVEY OFFICE (USE ONLY)

PERSONNEL

REFERENCE NO. 36 A

SHEET 18 OF 19


NOTES PRESTON-COLVIN
H.C. NEISE
R.C. BARRIERE

DATE 9-4-24
WEATHER SUNNY
TEMP. 65°

ROUTE US 6
COUNTY SANDUSKY
TOWNSHIP RILEY
SECTION 16
T 5 N R 16 E


DWG BY PRESTON-COLVIN PID PAVING TRAIN

TYPE MONUMENT MAG/WASHER
ON SURFACE - BELOW ON
OFFSET ℄ PAVEMENT ON LT : RT
- TO - EDGE PAVEMENT
STATION: 1233+50.83

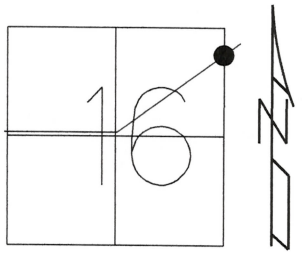

HORZ.DATUM: NAD83 (2011)
GEOID: NAVD88 2018
GRID: NORTHING: 630771.791
EASTING: 1828081.589
LDP: NORTHING: 326954.9
EASTING: 188239.5

RECORD: P.I.
P.K./WASHER
R.R. SPIKE
STA. 1240+88
SET P.K./WASHER
6/9/02, DCH
FD R.R.SPIKE
6/10/08, DCH
FD R.R.SPIKE
4" DOWN
REF37
8/6/09, DCH
FD R.R.SPIKE
W/DIMPLE
4" DOWN
11/22/17, DCH
8/1/18, JLL
SET MAG/WASHER
7/31/19, JLL
FD MAG/WASHER
7/26/21, TDN
2/10/22, JFO
FD MAG/WASHER
REF36A
9-4-24, TDN
FD MAG/WASHER
10-3-24, JAM

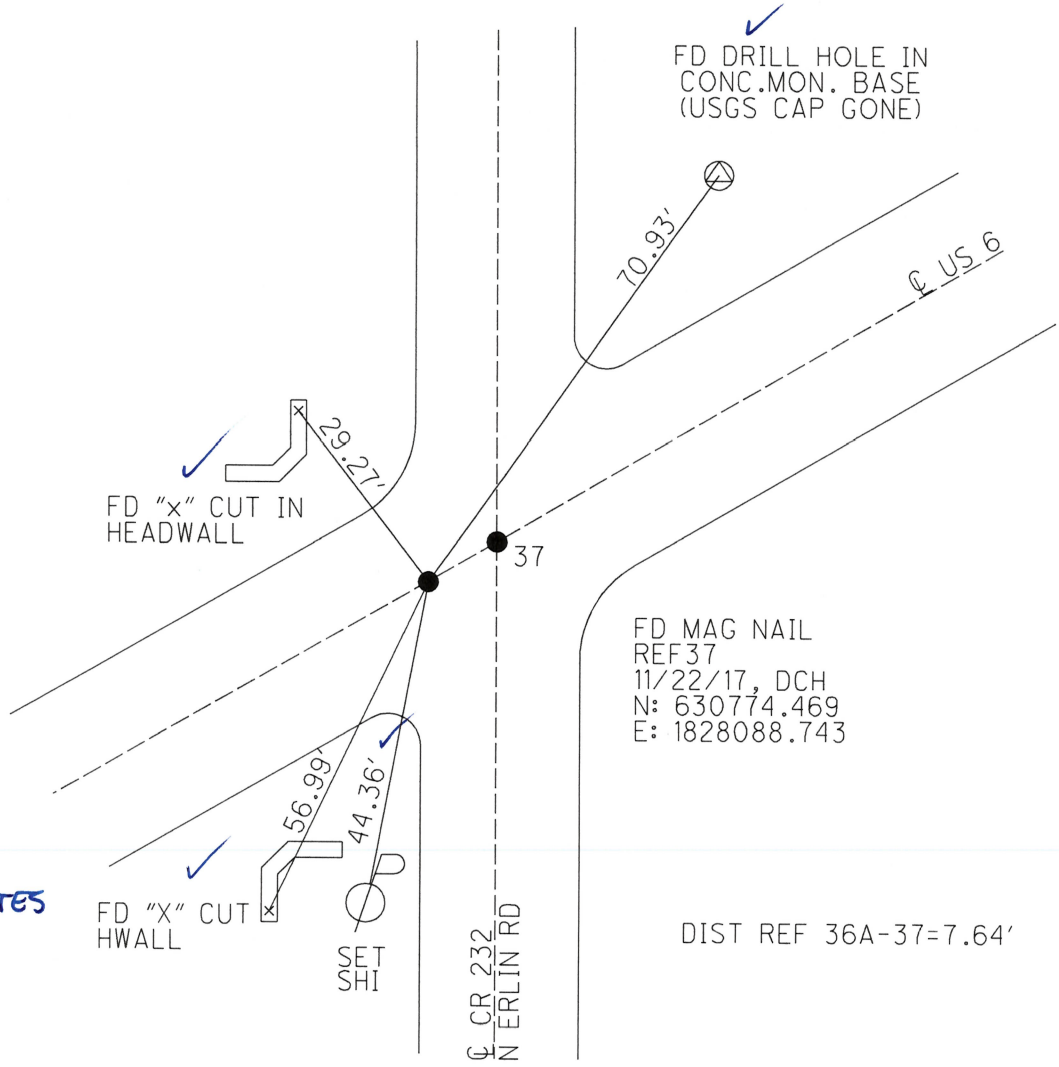

O.D.O.T. DISTRICT 2 SURVEY OFFICE (USE ONLY)

PERSONNEL

REFERENCE NO. 37

SHEET 19 OF 19

NOTES PRESTON-COLVIN
H.C. NEISE
R.C. BARRIERE


DATE 9-4-24
WEATHER SUNNY
TEMP. 65°

ROUTE US 6
COUNTY SANDUSKY
TOWNSHIP RILEY
SECTION 16

DWG BY PRESTON-COLVIN PID PAVING TRAIN


T 5 N R 16 E

TYPE MONUMENT MAG NAIL
ON SURFACE - BELOW ON
OFFSET ℄ PAVEMENT ON LT : RT
- TO - EDGE PAVEMENT
STATION: 1233+58

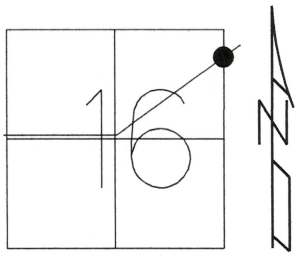

HORZ.DATUM: NAD83 (2011)
GEOID: NAVD88 2018
GRID: NORTHING: 630774.469
EASTING: 1828088.743
LDP: NORTHING: 326957.7
EASTING: 188246.6

RECORD:
FD MAG NAIL
REF37
N: 630774.469
E: 1828088.743
11/22/17, DCH
FD MAG NAIL
7/26/21, TDN
2/10/22, JFO
FD MAG
REF37
9-4-24, TDN
FD MAG ✓
10/3/24, JAM

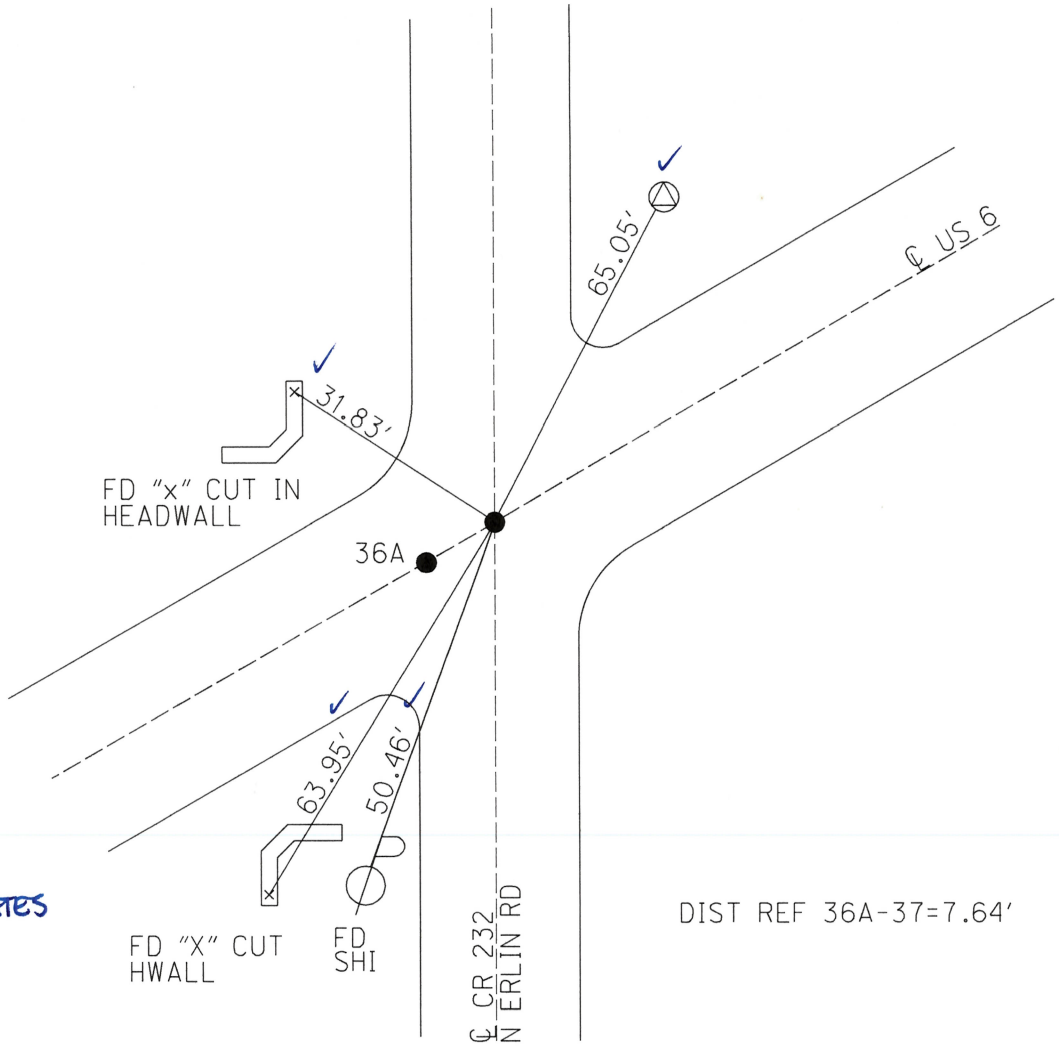

USE COORDINATES FROM 2024

O.D.O.T. DISTRICT 2 SURVEY OFFICE (USE ONLY)

PERSONNEL

REFERENCE NO. 37 A

SHEET 1 OF 34

NOTES PRESTON-COLVIN
H.C. NEISE
R.C. BARRIERE


DATE 9-4-24
WEATHER SUNNY
TEMP. 65°

ROUTE US 6
COUNTY SANDUSKY
TOWNSHIP RILEY
SECTION 15

DWG BY PRESTON-COLVIN PID PAVING TRAIN


T 5 N R 16 E

TYPE MONUMENT MAG/WASHER
ON SURFACE - BELOW ON
OFFSET ℄ PAVEMENT 0.4' LT : ~~RT~~
- TO - EDGE PAVEMENT
STATION: 1233+58

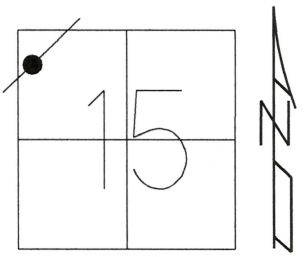

HORZ.DATUM: NAD83 (2011) GEOID: NAVD88 2018
GRID: NORTHING: 630956.552 EASTING: 1828574.771
LDP: NORTHING: 327143.1 EASTING: 188731.5

RECORD: P.I.
OLD STA 5+26.5
P.K./WASHER
SMALL SPIKE
FD P.K./WASHER
3/16/02, DCH
SET P.K./WASHER
6/9/02, DCH
FD P.K./WASHER
REFB37
11/22/17, DCH
8/1/18, JLL
SET MAG/WASHER
7/31/19, JLL
FD MAG/WASHER
7/26/21, TDN
SET MAG/WASHER
1/28/22, TDN
FD MAG/WASHER
REF37A
9-4-24, TDN
FD MAG/WASHER
10-3-24, JAM

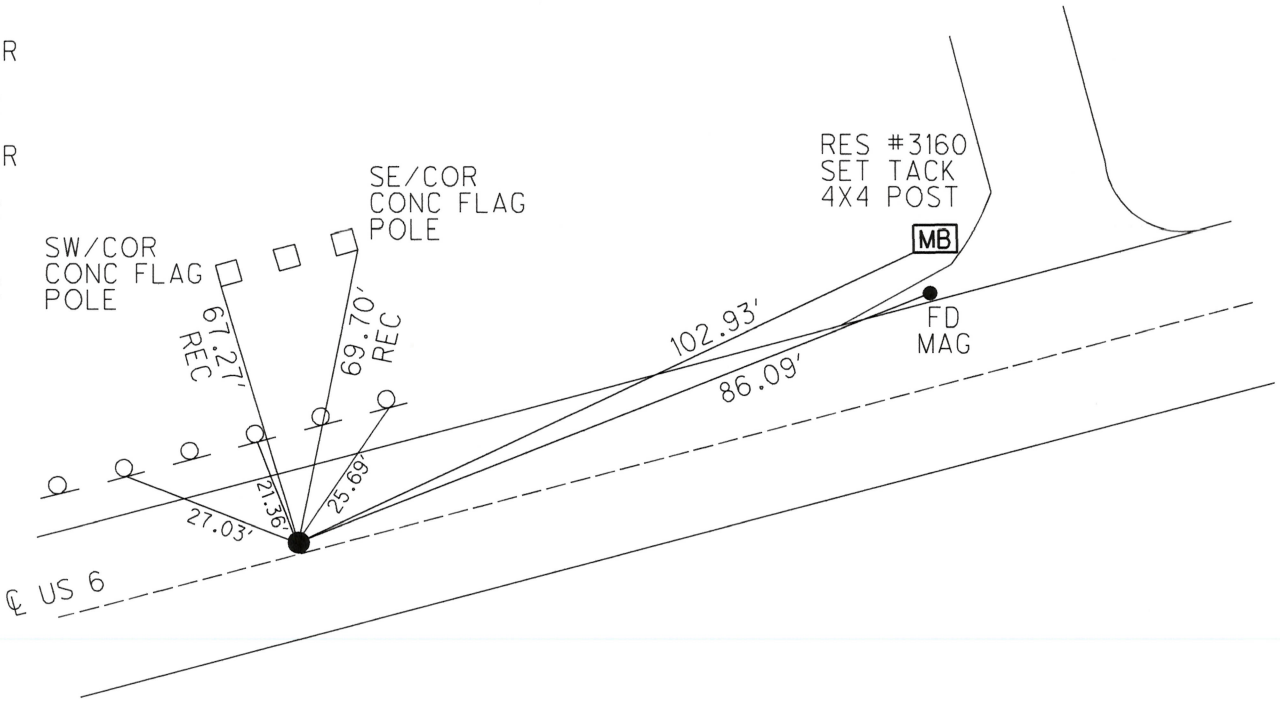

USE COORDINATES FROM 2024