
DETAIL

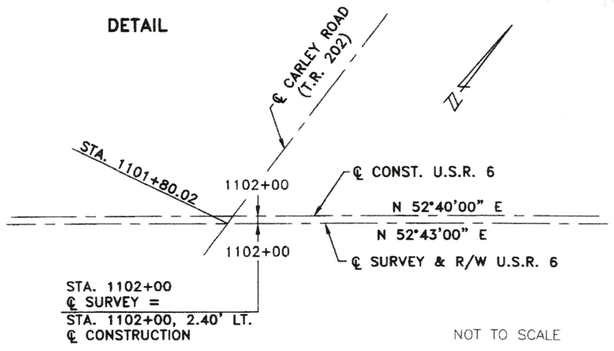

NOTE: THE PROPOSED RIGHT OF WAY SHALL BE REFERENCED FROM THE CENTERLINE OF SURVEY AND RIGHT OF WAY.

NOTE: THE EXISTING R/W WIDTH AND LOCATION WERE DETERMINED USING:

- PROJECT I.C.H. 22 SEC. Y (MARCH 1926), ON FILE AT THE OHIO DEPARTMENT OF TRANSPORTATION DISTRICT 2 OFFICE, BOWLING GREEN, OHIO
- REFERENCE MONUMENTS PROVIDED BY THE OHIO DEPARTMENT OF TRANSPORTATION, DISTRICT 2
- SANDUSKY COUNTY ENGINEER

I HEREBY CERTIFY THAT THIS PLAT IS A TRUE DELINEATION OF A SURVEY MADE FOR THE OHIO DEPARTMENT OF TRANSPORTATION IN 2001 BY PROUDFOOT ASSOCIATES.


THE ESTABLISHMENT OF THE PROPERTY LINES AND EXISTING RIGHT OF WAY LINES SHOWN ON THIS PLAN AS OF THIS DATE WAS PERFORMED BY ME OR UNDER MY DIRECT SUPERVISION.

BY _____
P. E. PROUDFOOT

SURVEYOR NO. 4555 DATE 9-1-03

STATE OF OHIO · PAUL E PROUDFOOT · 4555 · REGISTERED SURVEYOR

SAN-6-20.91/26.69
NE 1/4 SECTION 19
T-5-N, R-16-E
RILEY TOWNSHIP
SANDUSKY COUNTY

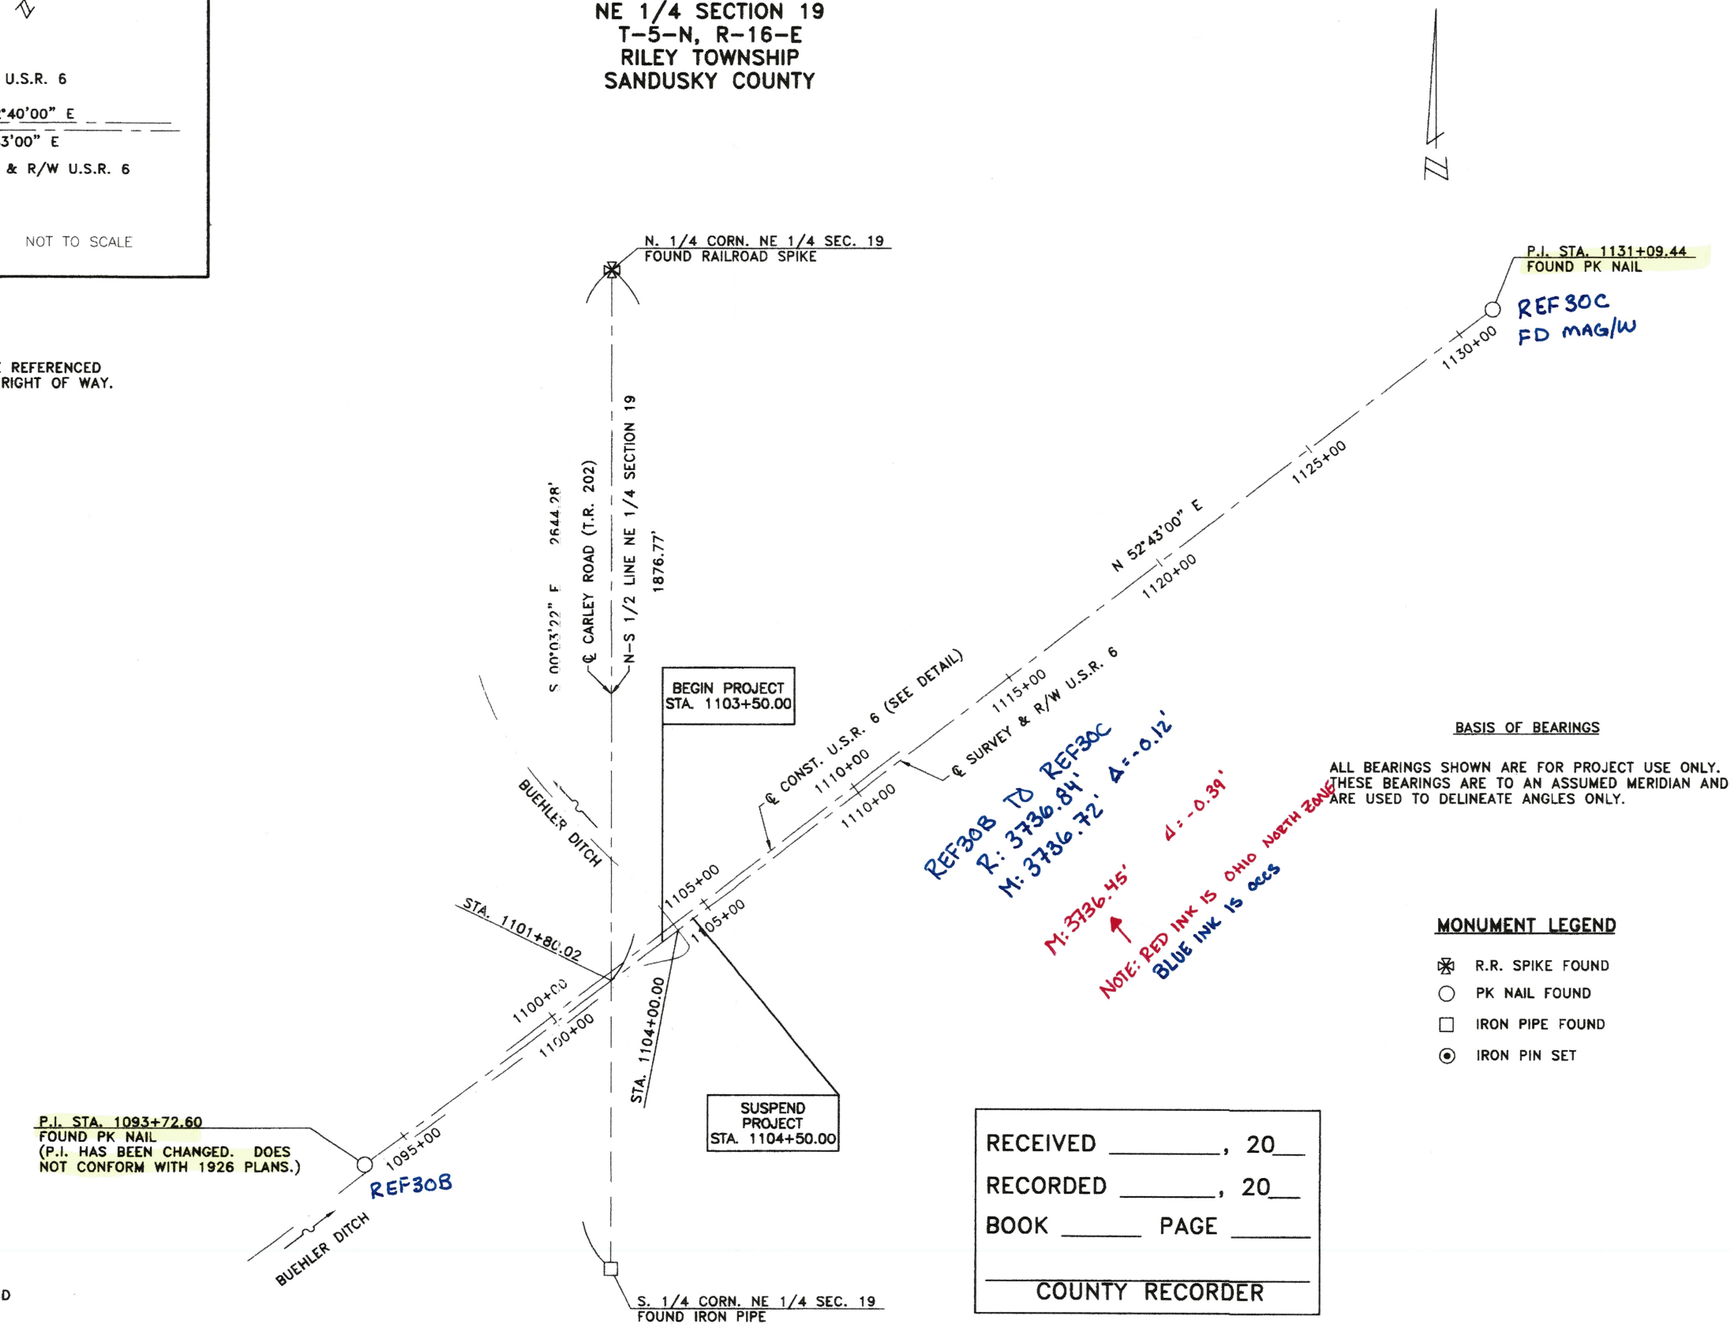

BASIS OF BEARINGS

ALL BEARINGS SHOWN ARE FOR PROJECT USE ONLY. THESE BEARINGS ARE TO AN ASSUMED MERIDIAN AND ARE USED TO DELINEATE ANGLES ONLY.

MONUMENT LEGEND

- R.R. SPIKE FOUND
- PK NAIL FOUND
- IRON PIPE FOUND
- IRON PIN SET

RECEIVED _____, 20__
RECORDED _____, 20__
BOOK _____ PAGE _____
_____
COUNTY RECORDER

PROUDFOOT ASSOCIATES

N

0 100 200 400 HORIZONTAL

PID NO. 22593

R/W DESIGNER RJS
R/W REVIEWER TUY

SAN-6-20.91
CENTERLINE PLAT

SAN-6-20.91/26.69

1/7
41/47