


FOR ANY QUESTIONS PLEASE CONTACT ODOT DISTRICT 2 REAL ESTATE AT 419-353-8131

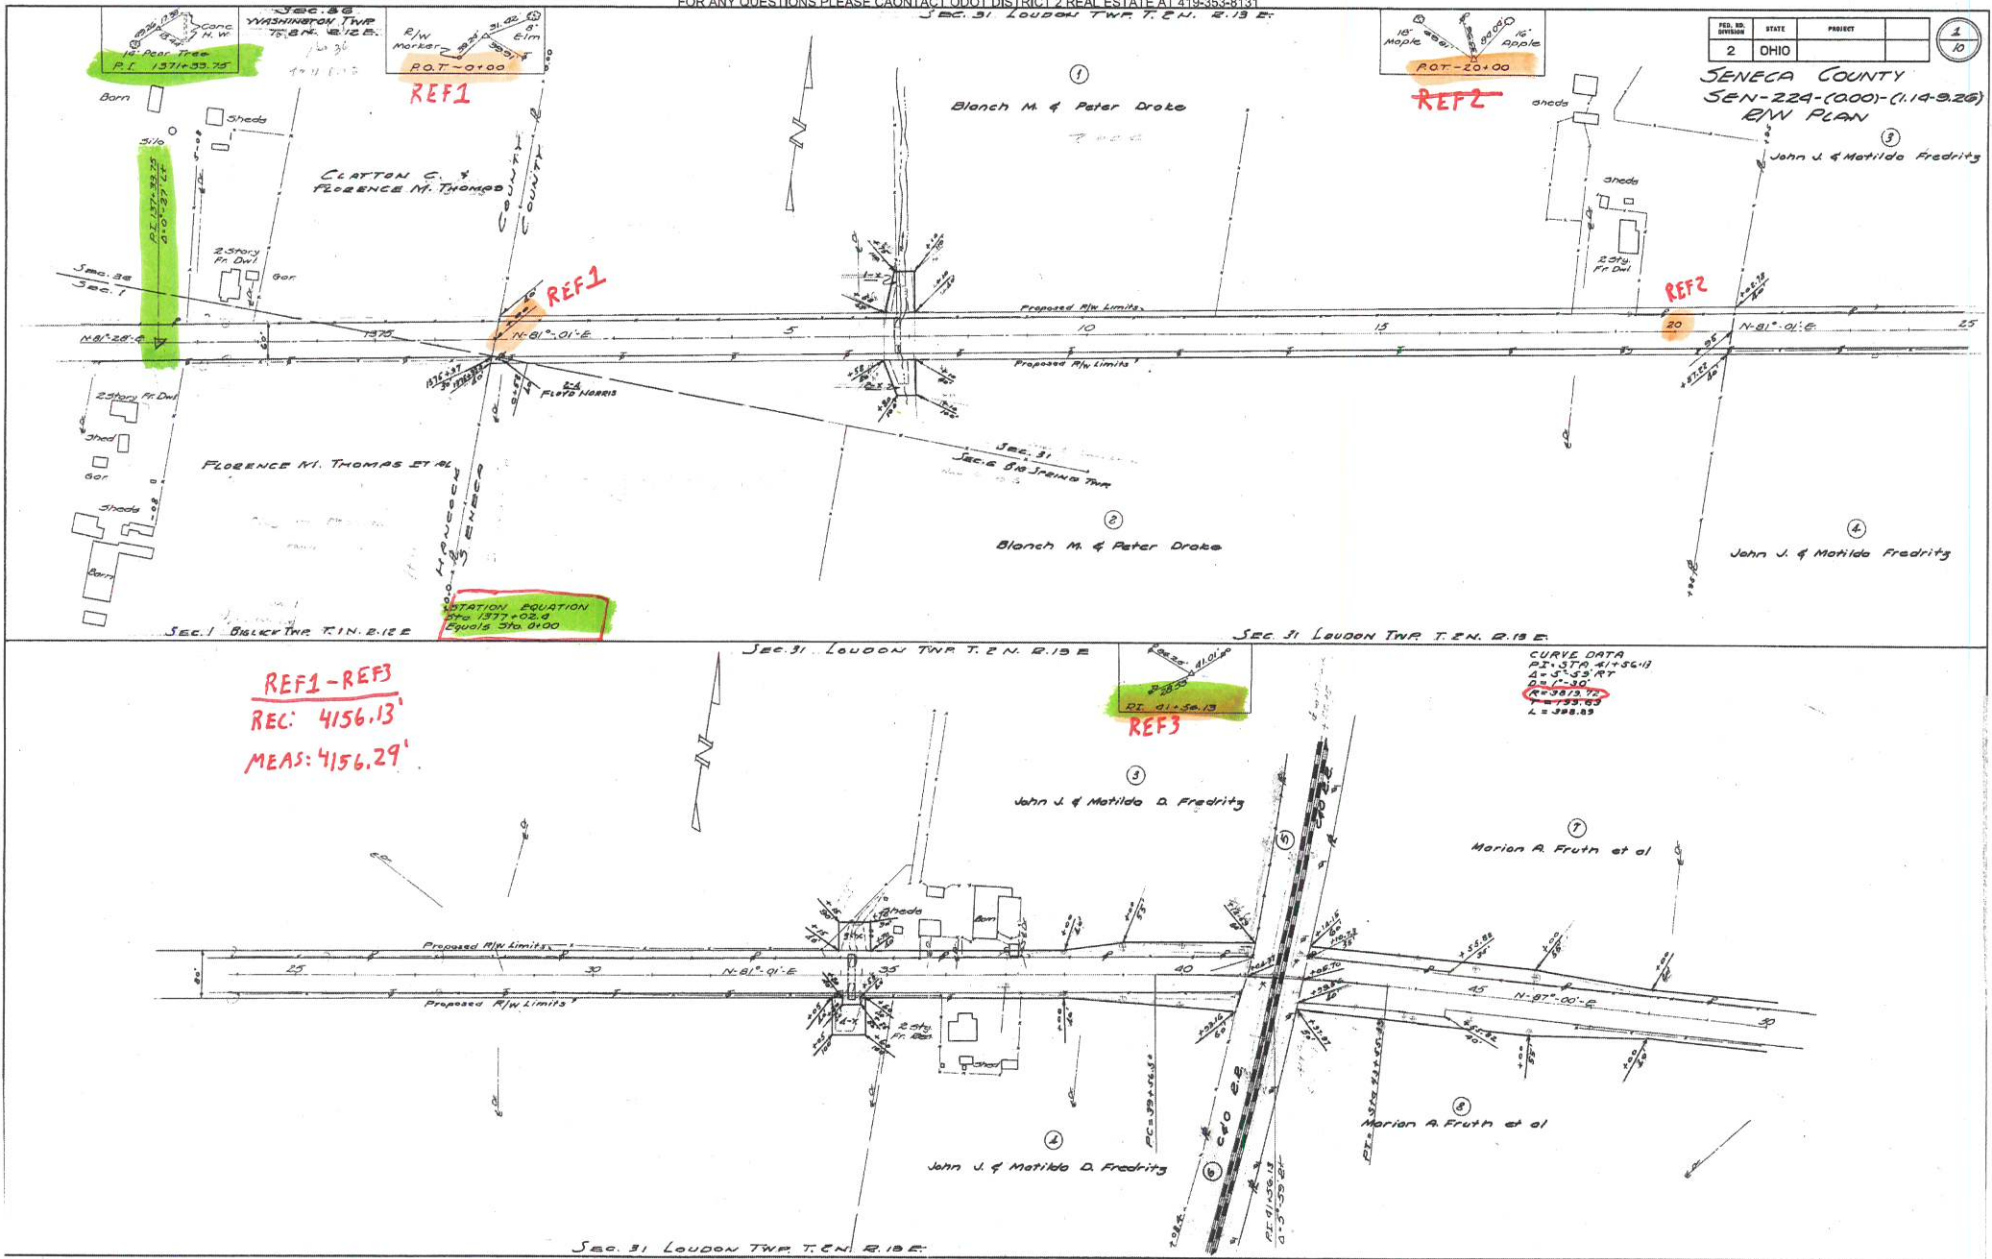


REF14

FOR ANY QUESTIONS PLEASE CONTACT ODOT DISTRICT 2 REAL ESTATE AT 419-353-8131

DIST. NO.	STATE	PROJECT
2	OHIO	



SEN-224-(0.00)-(1.14-9.24)
R/W PLANS

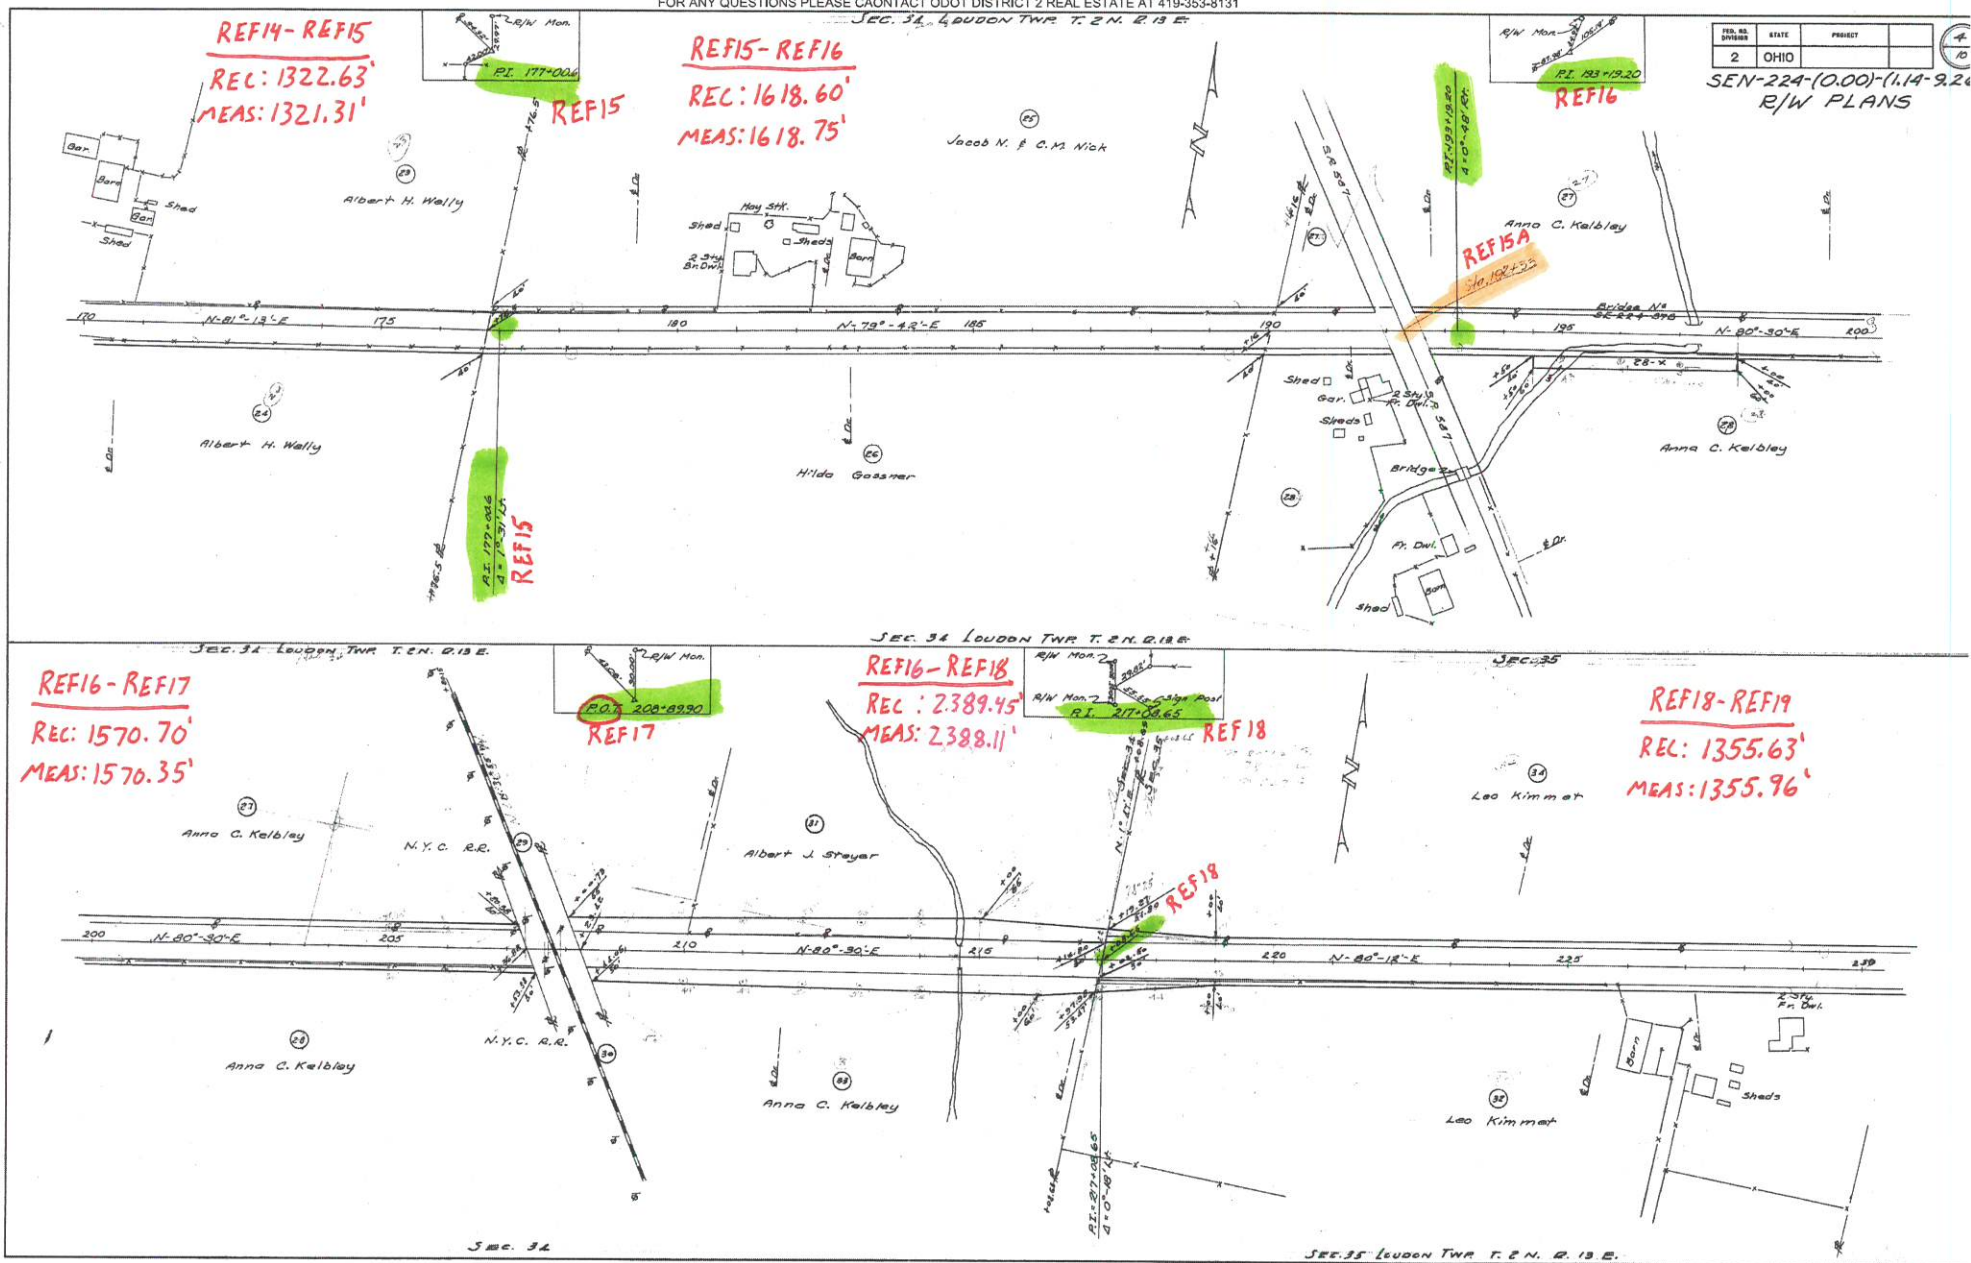

FOR ANY QUESTIONS PLEASE CONTACT ODOT DISTRICT 2 REAL ESTATE AT 419-353-8131

FEEL. NO.	STATE	PROJECT
2	OHIO	

SEN-224-(000)-1.14-9.26
R/W PLANS

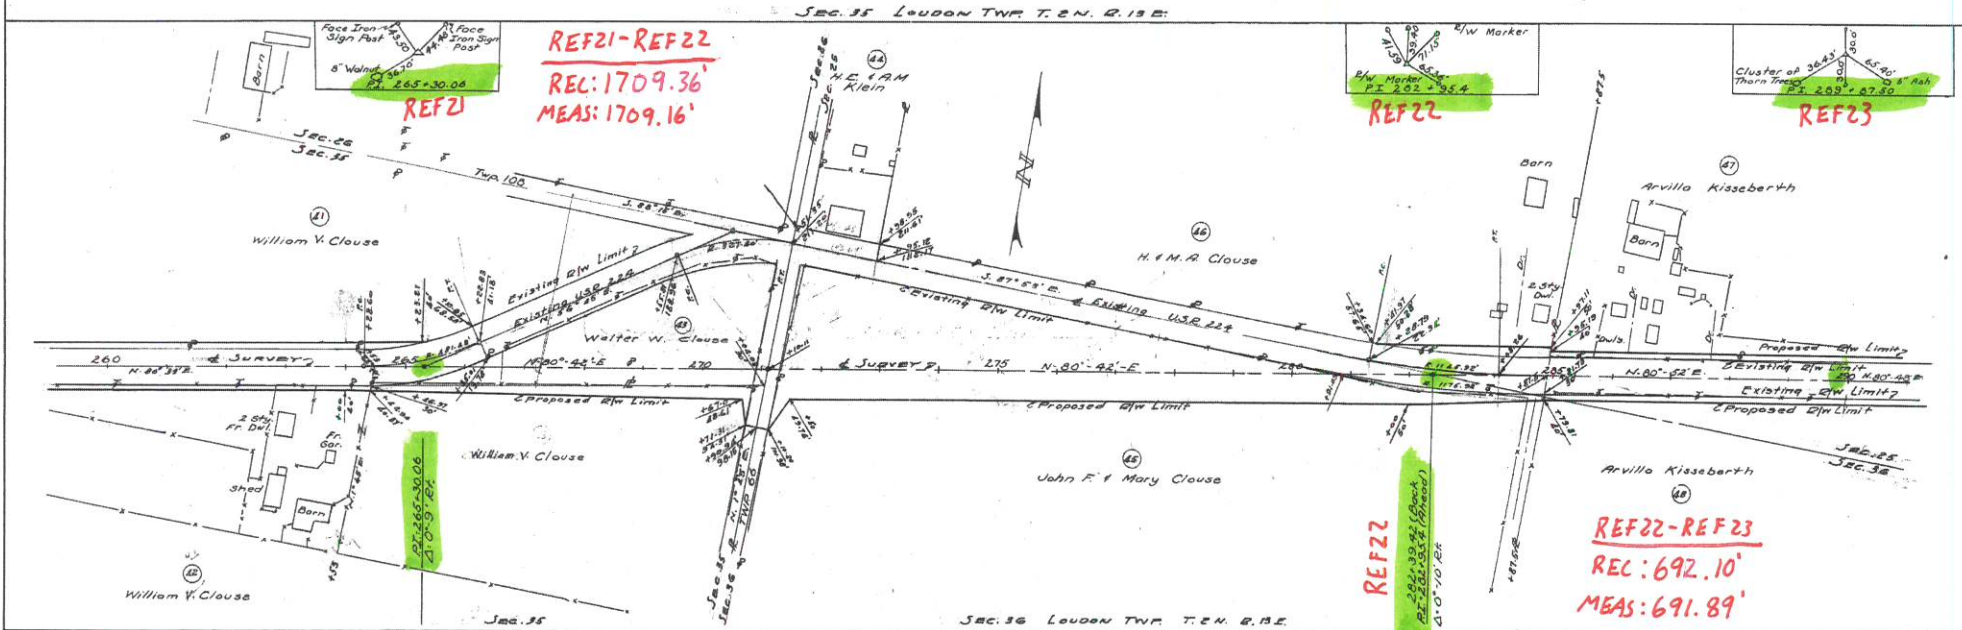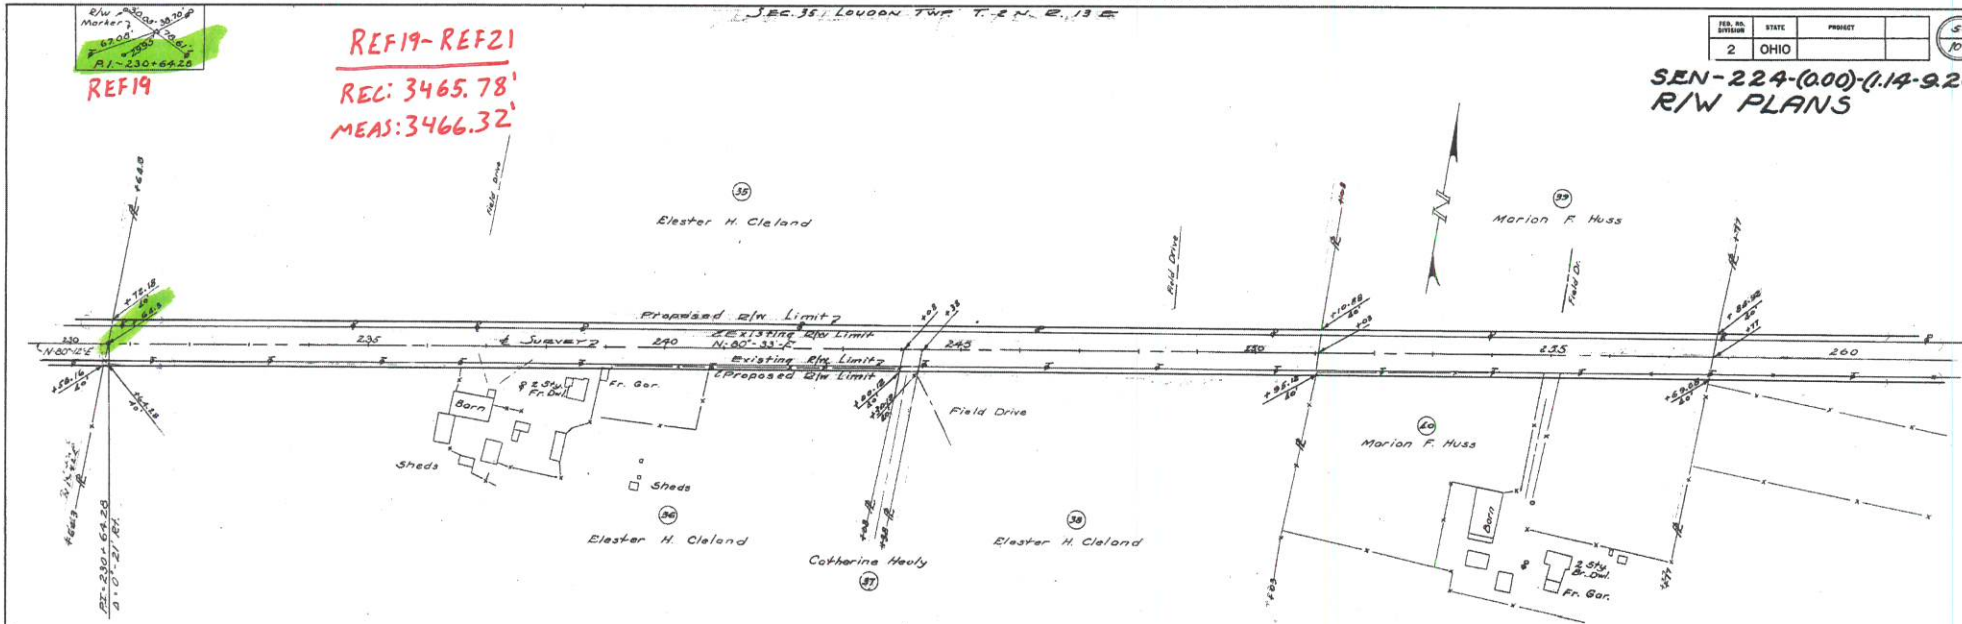

* DID NOT USE
STA. EQ., KEPT
STATIONING THROUGH
TO MATCH SLM

FOR ANY QUESTIONS PLEASE CONTACT ODOT DISTRICT 2 REAL ESTATE AT 419-353-8131

REF23-REF24
REC: 785.90'
MEAS: 785.77'

REF24-REF25
REC: 1891.50'
MEAS: 1891.62'

REF25

SEN-224-(0.00)-(114-92)
R/W PLANS



REF25

REF25-REF26
REC: 1013.00'
MEAS: 1013.12'

REFZ6

No Sheet

REFZSA


REF26

SEC. 30 HOPEWELL TWP. T2N. R. 14E

FOR ANY QUESTIONS PLEASE CONTACT ODOT DISTRICT 2 REAL ESTATE AT 419-353-8131
 SEC. 30 HOPEWELL TWP. T.2N. R.14E.

FED. RD. DISTRICT	STATE	PROJECT	7
2	OHIO		10

SEN-224-(000)-(1.14-9.22)
 R/W PLANS

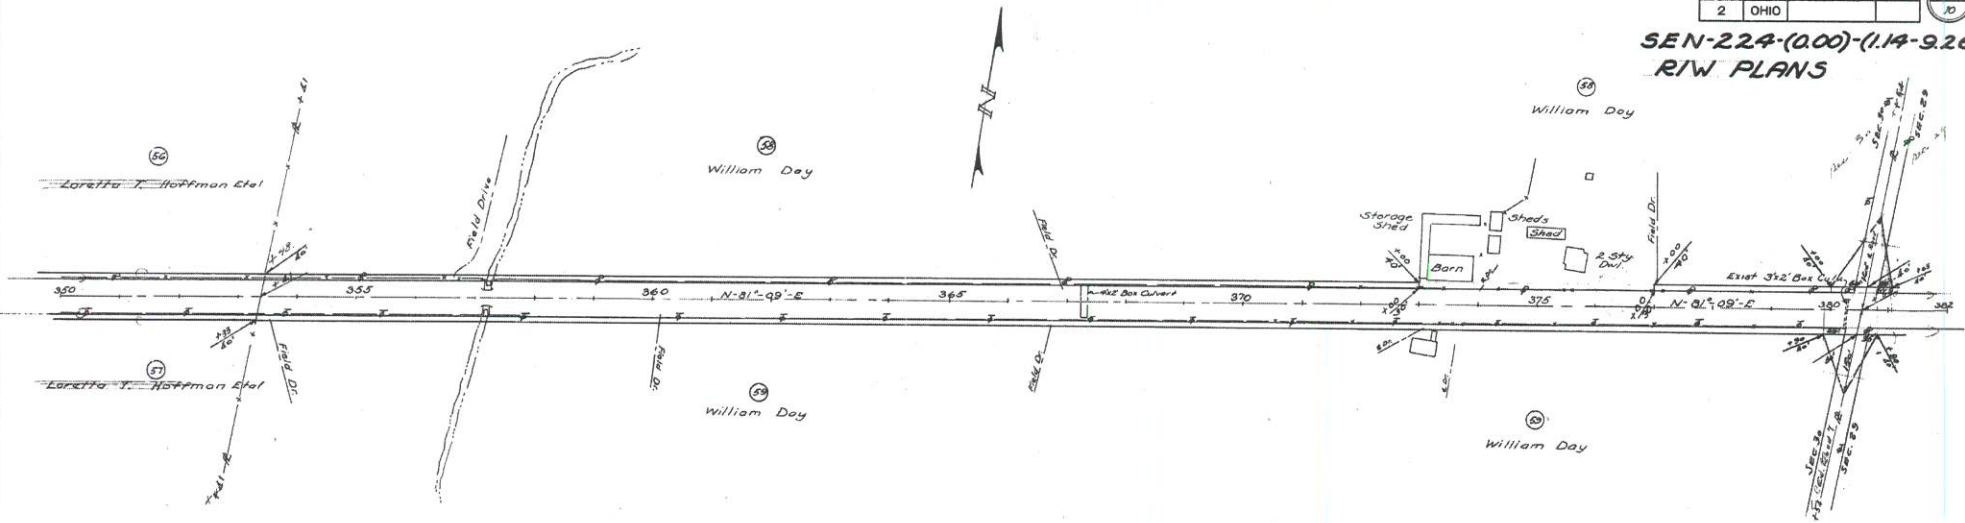


REF26-REF28
 REC: 6714.81'
 MEAS: 6714.59'

REF28

SEC. 30 HOPEWELL TWP. T.2N. R.14E.
 SEC. 29 HOPEWELL TWP. T.2N. R.14E.

REF28-REF29
 REC: 1768.10'
 MEAS: 1768.48'


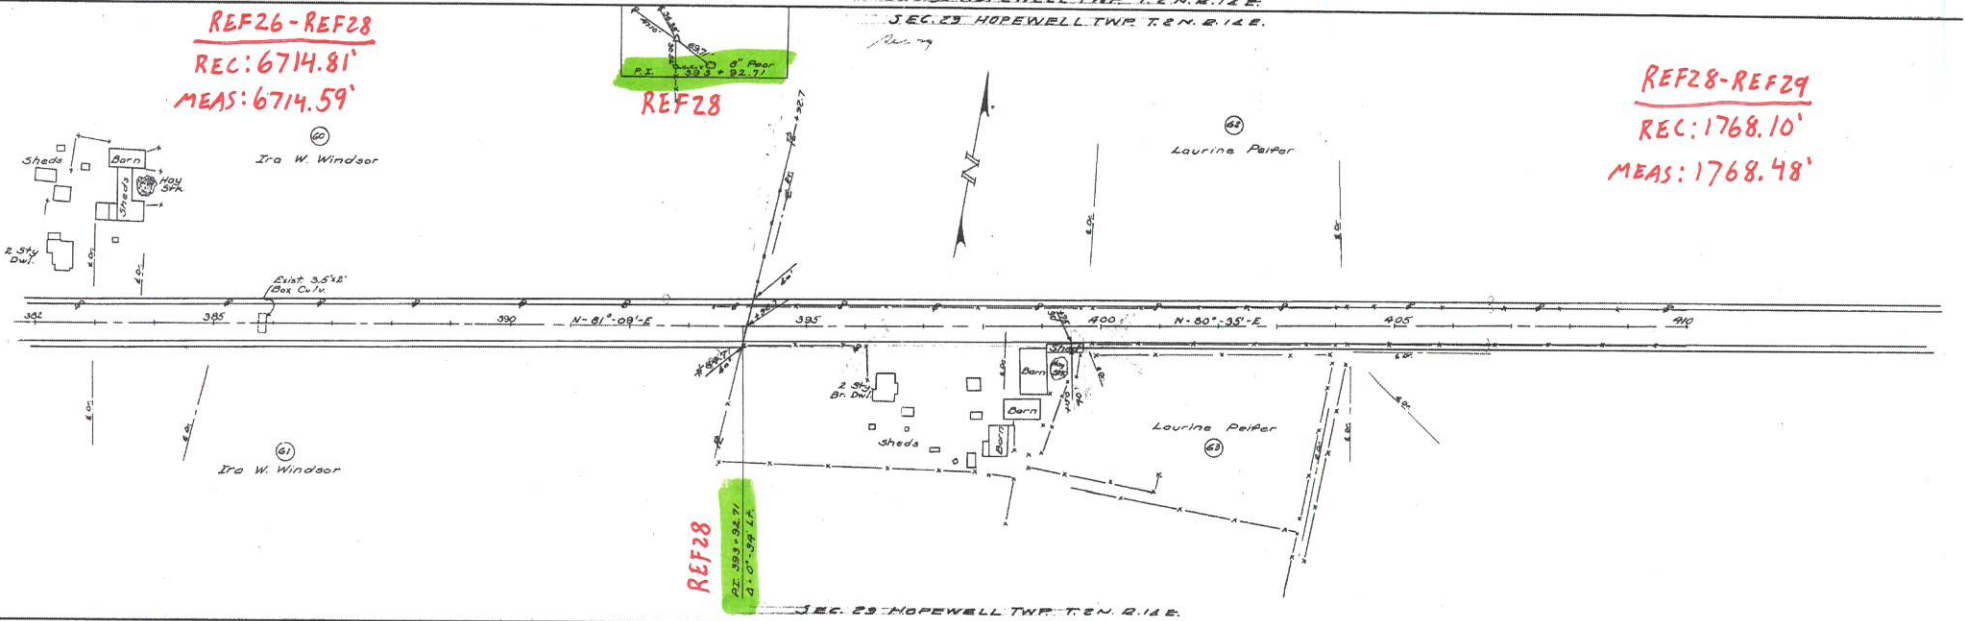



REF28

FOR ANY QUESTIONS PLEASE CONTACT ODOT DISTRICT 2 REAL ESTATE AT 419-353-8131
SEC 29 HOPEWELL TWP T2N R14E

FED. RD. DISTRICT	STATE	PROJECT	SHEET NO.
2	OHIO		10

SEN. -224-(000)-(114-9.26)
R/W PLANS

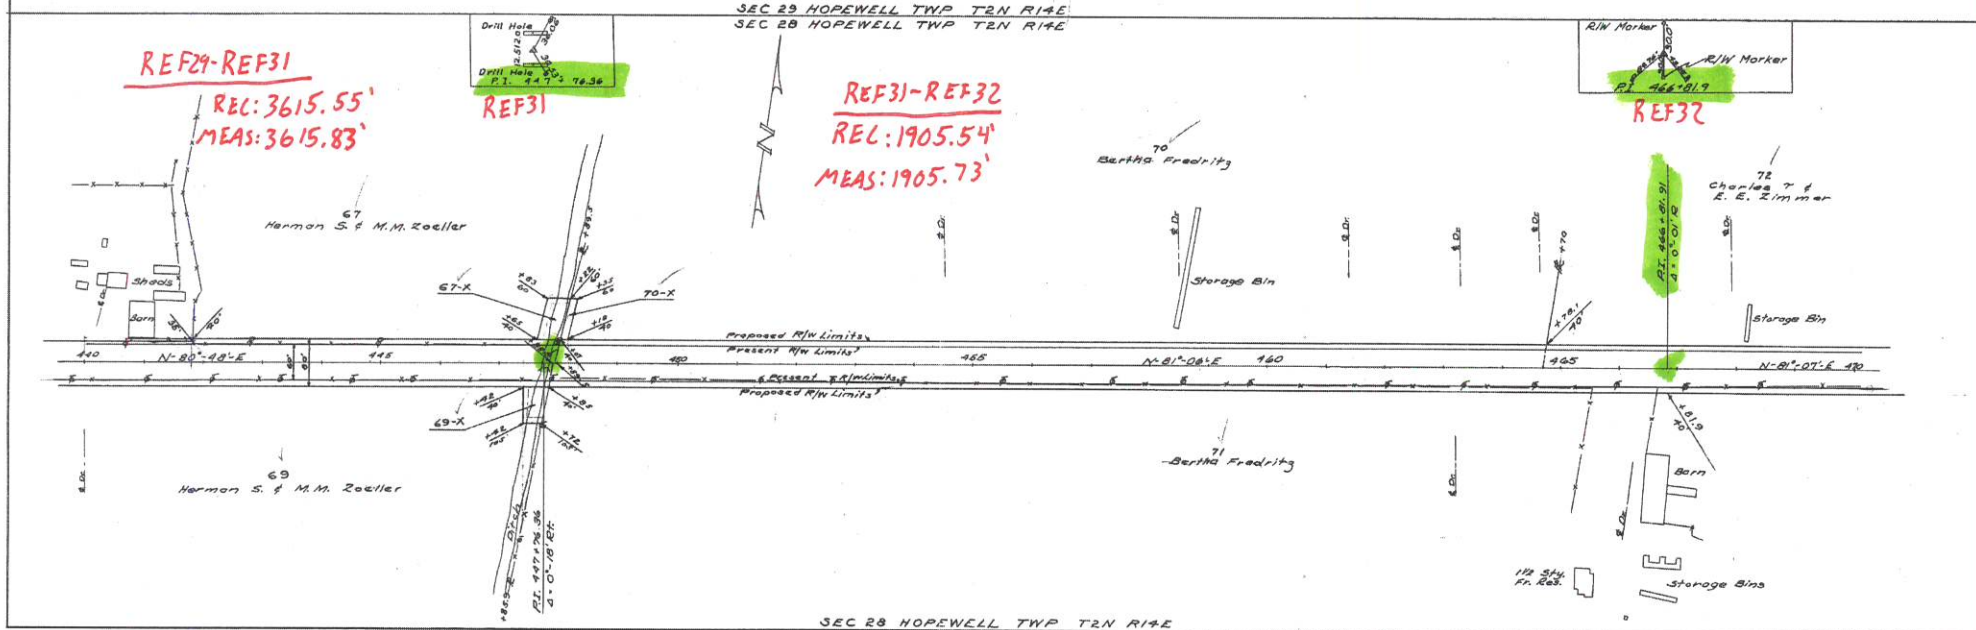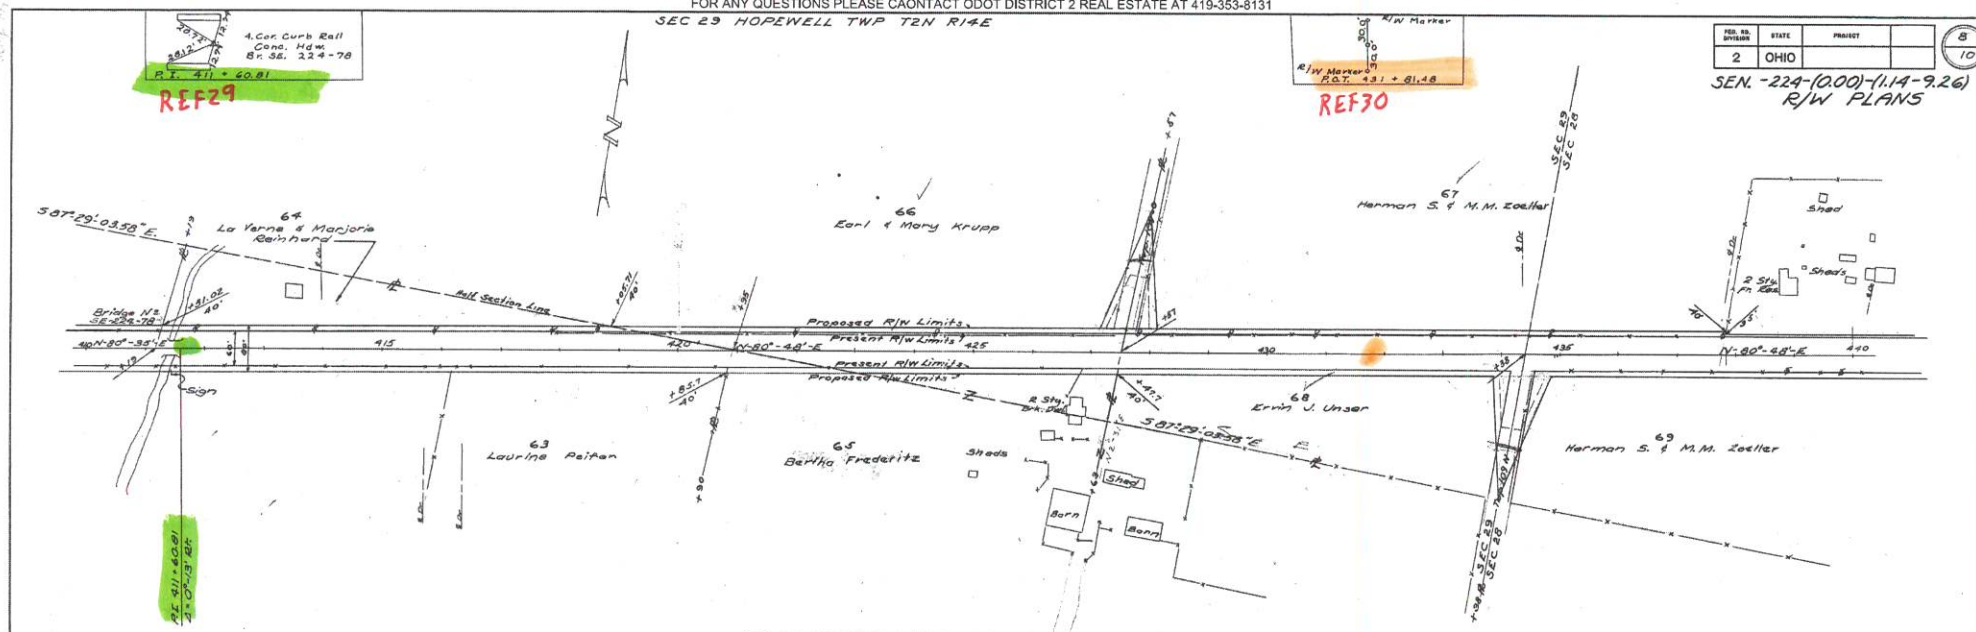

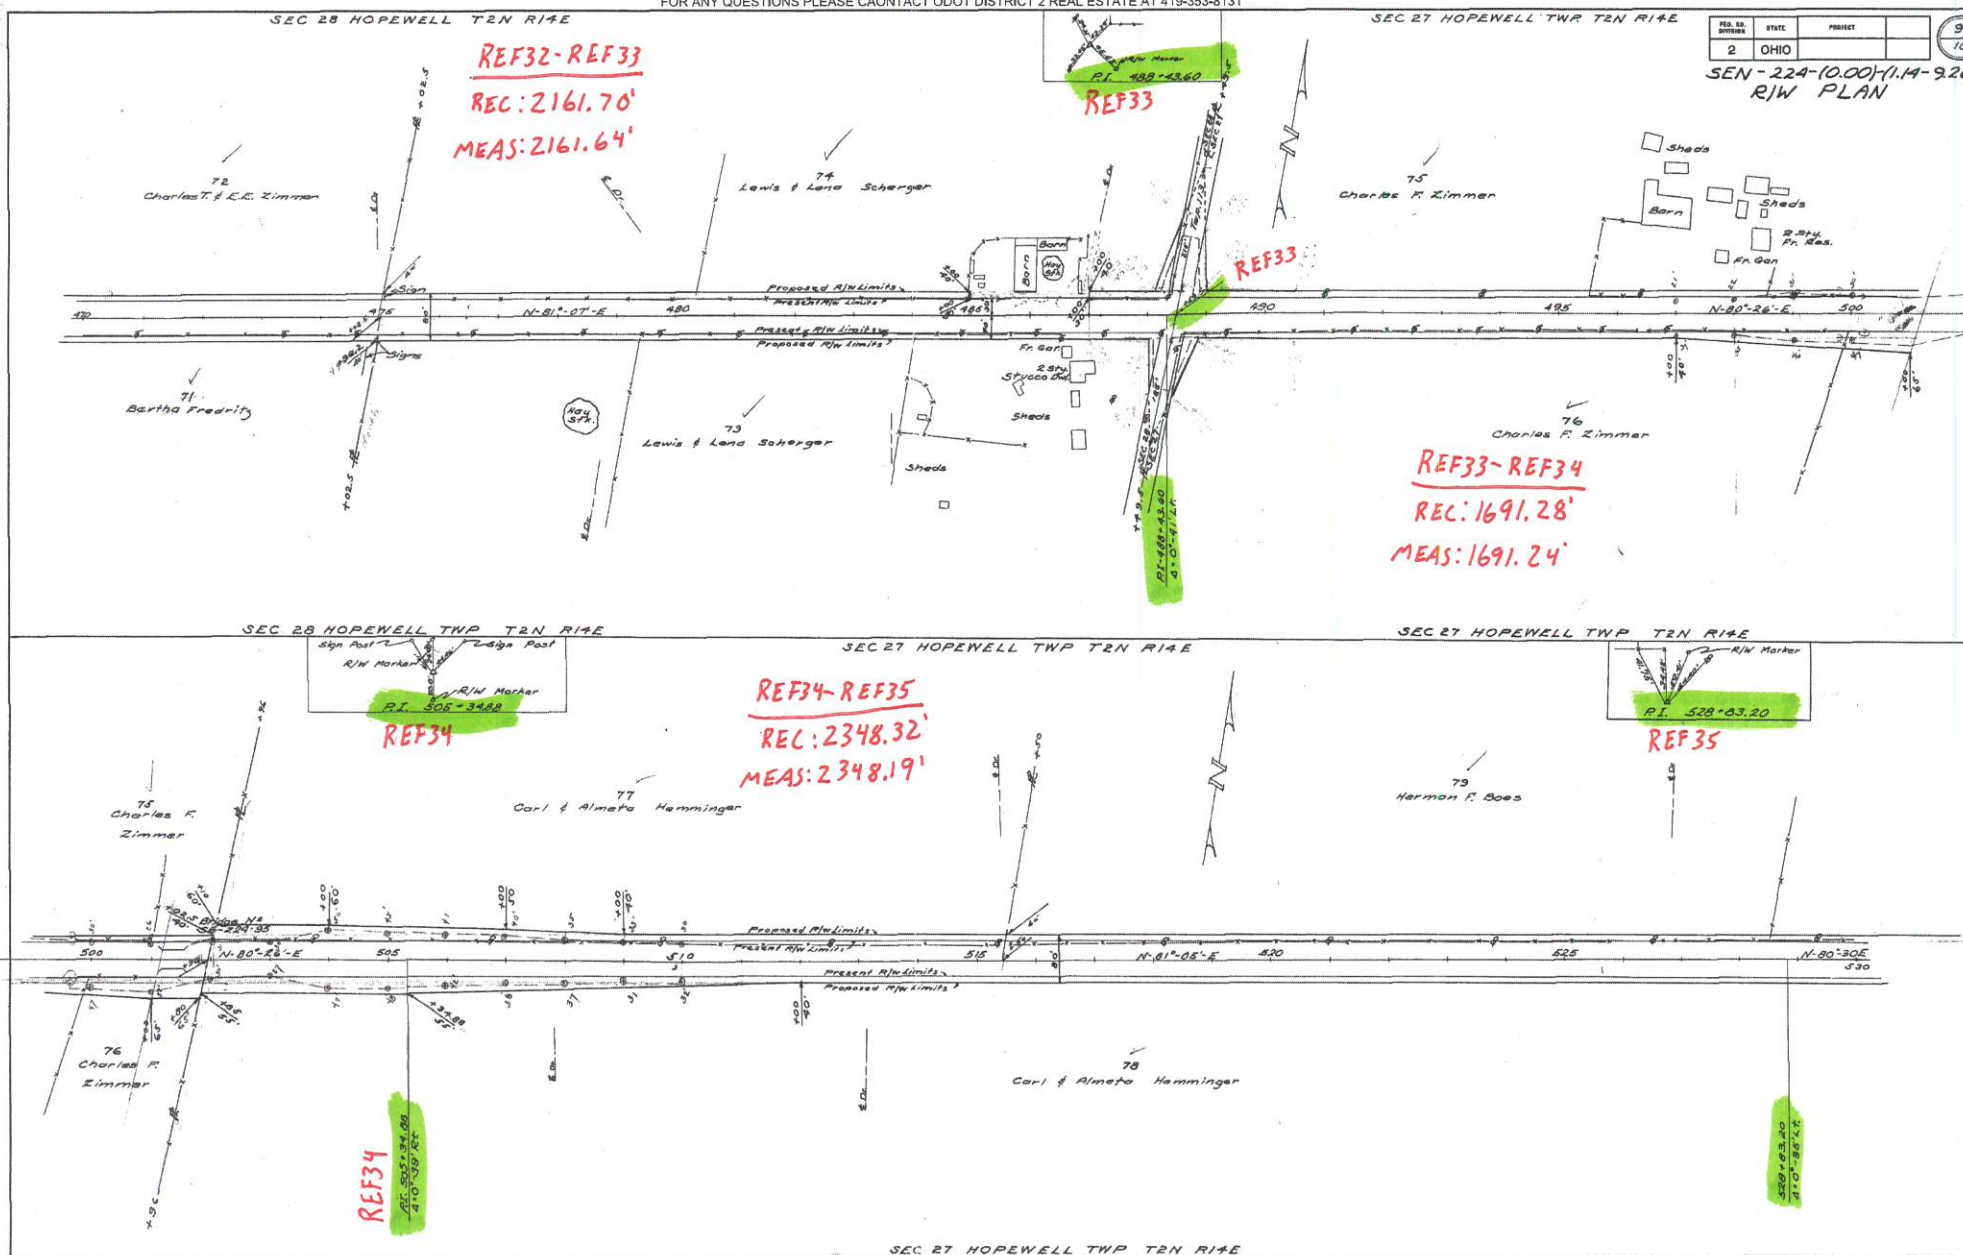

FOR ANY QUESTIONS PLEASE CONTACT ODOT DISTRICT 2 REAL ESTATE AT 419-353-8131

FILE NO.	STATE	PROJECT	10
2	OHIO		10

SEN-224(10.00)11.14-9.26,
R/W PLAN

