


FOR SCHEMATIC PLAN, SEE SHEET 2.
FOR INTERSECTION DETAILS, SEE SHEET 22-23.
FOR STORM SEWER PROFILES, SEE SHEET 25.
FOR SPRUCE AVE. PLAN, SEE SHEET 7-8.
FOR BRIDGE PLANS, SEE SHEET 27-30.

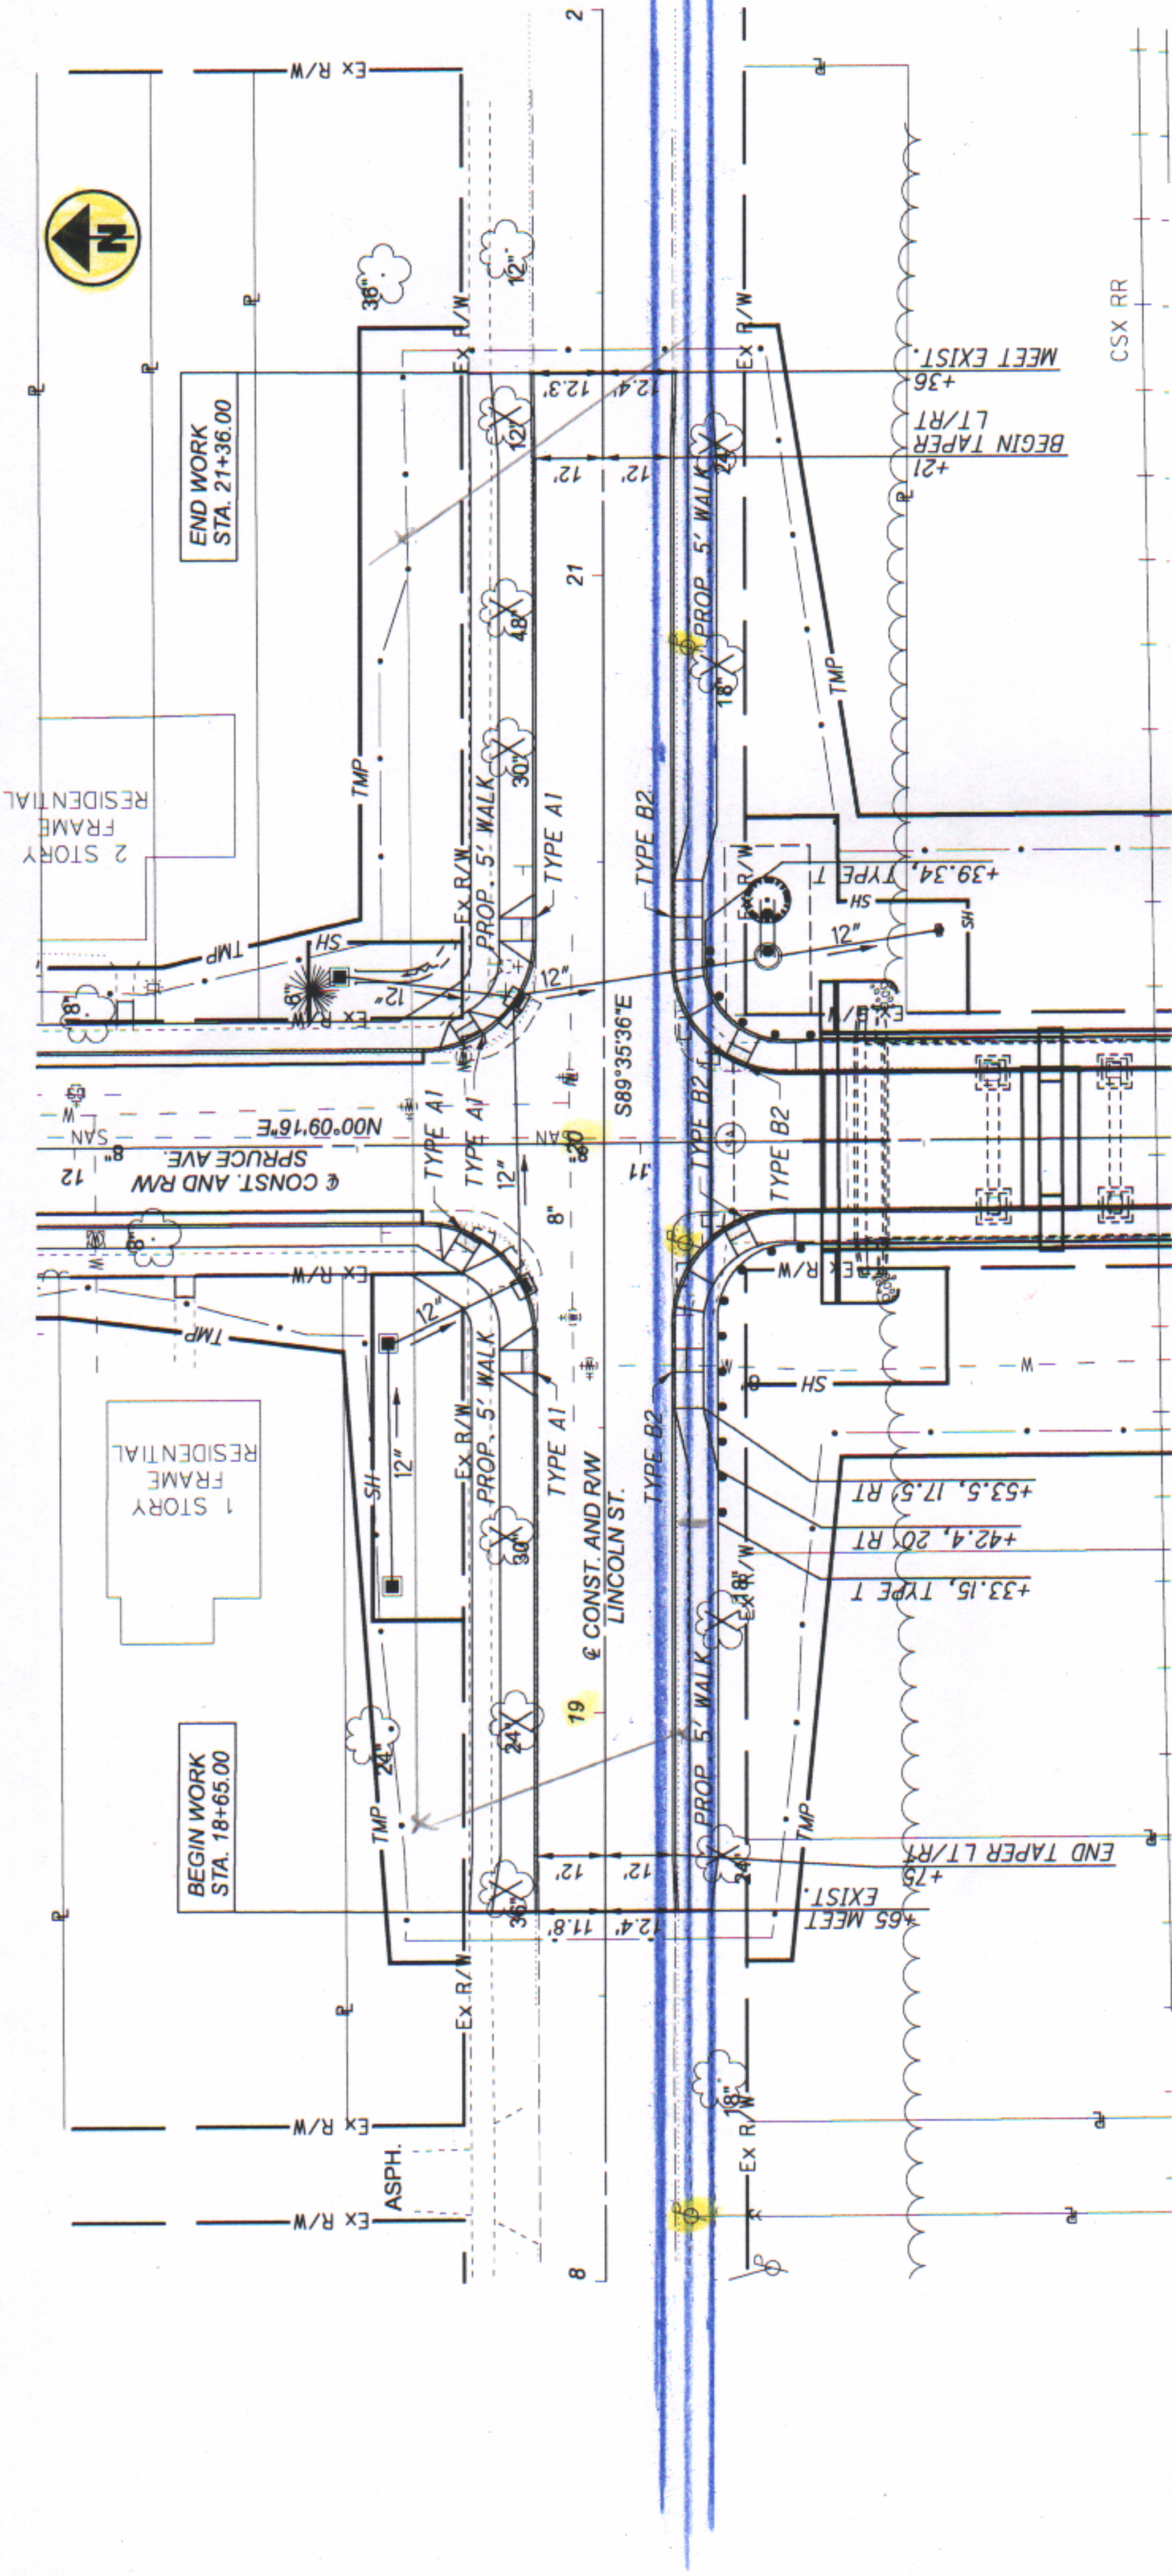

PLAN AND PROFILE-LINCOLN ST.
STA. 18+00 TO STA. 22+00

DESIGN AGENCY	JRE
REVIEWER	MAG
PROJECT ID	114201
SHEET TOTAL	9
SHEET	37

