

From: 0.000

From: 0.000 LEAVE STA CO

Direction: **North**


To: 8.039 CARNEGIE

↑ 45mph

ODOT - DIST 4 - SUMMIT CO - FINAL
No Passing Zone Log (SUM)

Route: SSUMSR00093**C (0093R)
Length: 8.039 Direction: North

From: 0.000 LEAVE STA CO
To: 8.039 CARNEGIE

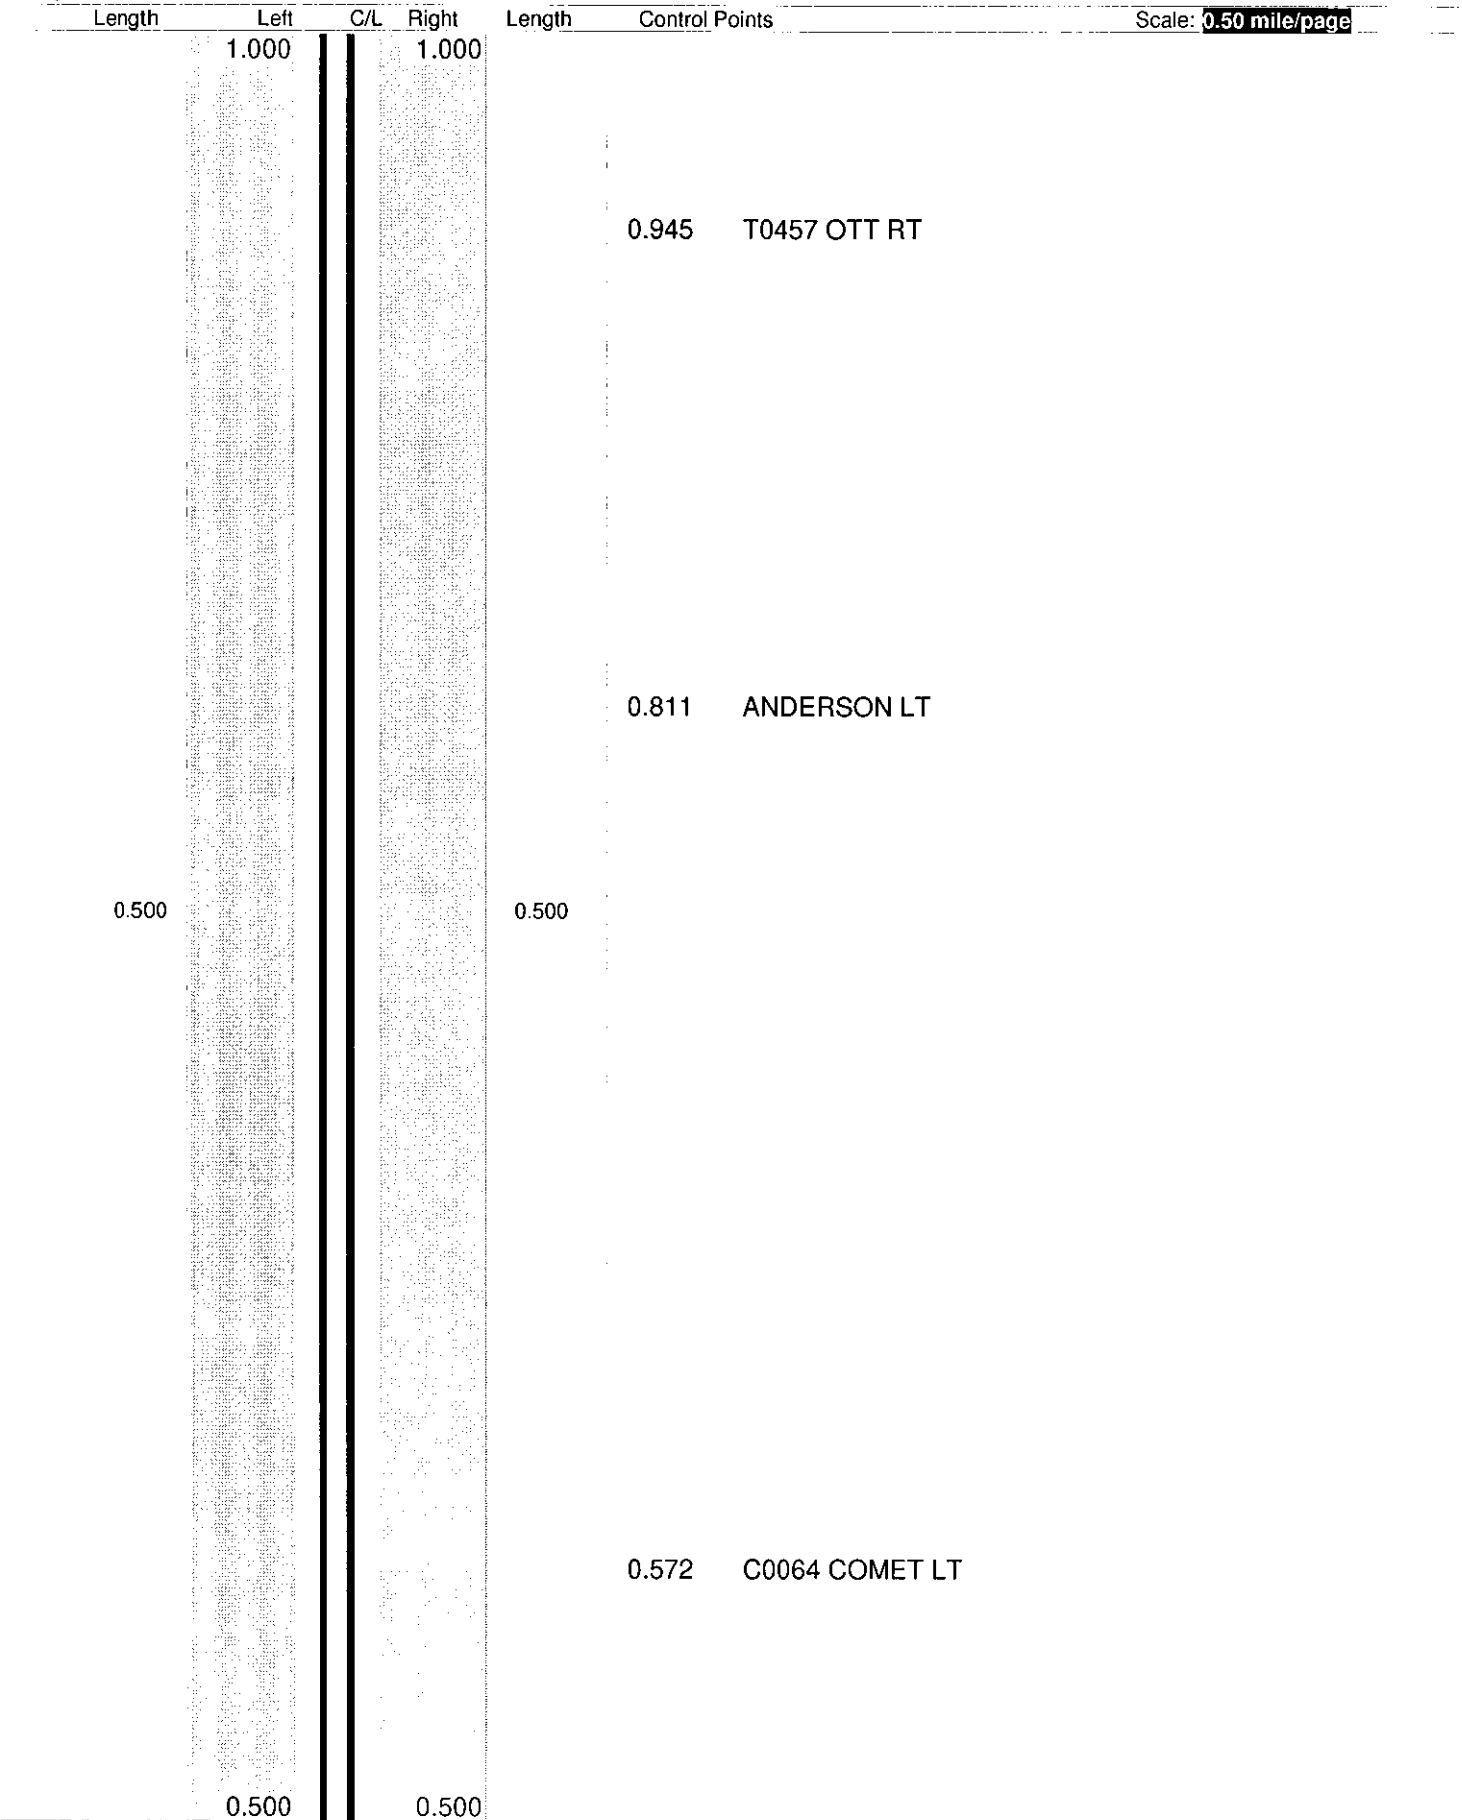





Length	Left	C/L	Right	Length	Control Points	Scale: 1.00 mile/page
	1.999		1.999			
					1.913 C0057 NIMISILA	
					1.788 CHERRY ALLEY RT	
0.560						
				0.701	1.663 T1919 DRAKE RT	
					1.516 T2143 KERTESZ LT	
	1.440					
					1.373 C0067 YAGER RT	
			1.299			
	1.217					
0.217			1.084			
				0.084		
	1.000		1.000	1.006	Mile Post = 001	

Sheet total equivalent length of solid line: 1.642

Accum. total: 1.642

© 2006 - MasterMind Systems, Inc. - Traffic Safety Suite

Page: ~~1~~ of ~~2~~
4 16

From: 2.000 LEAVE STA CO

To: 2,500 CARNEGIE

Sheet total equivalent length of solid line: 0.586 Accum. total: 0.586 © 2006 - MasterMind Systems, Inc. - Traffic Safety Suite

No Passing Zone Log (SUM)


Route: SSUMSR00093**C (0093R)

From: 0.000 LEAVE STA CO

Length: 8.039

Direction: North

To: 8.039 CARNEGIE

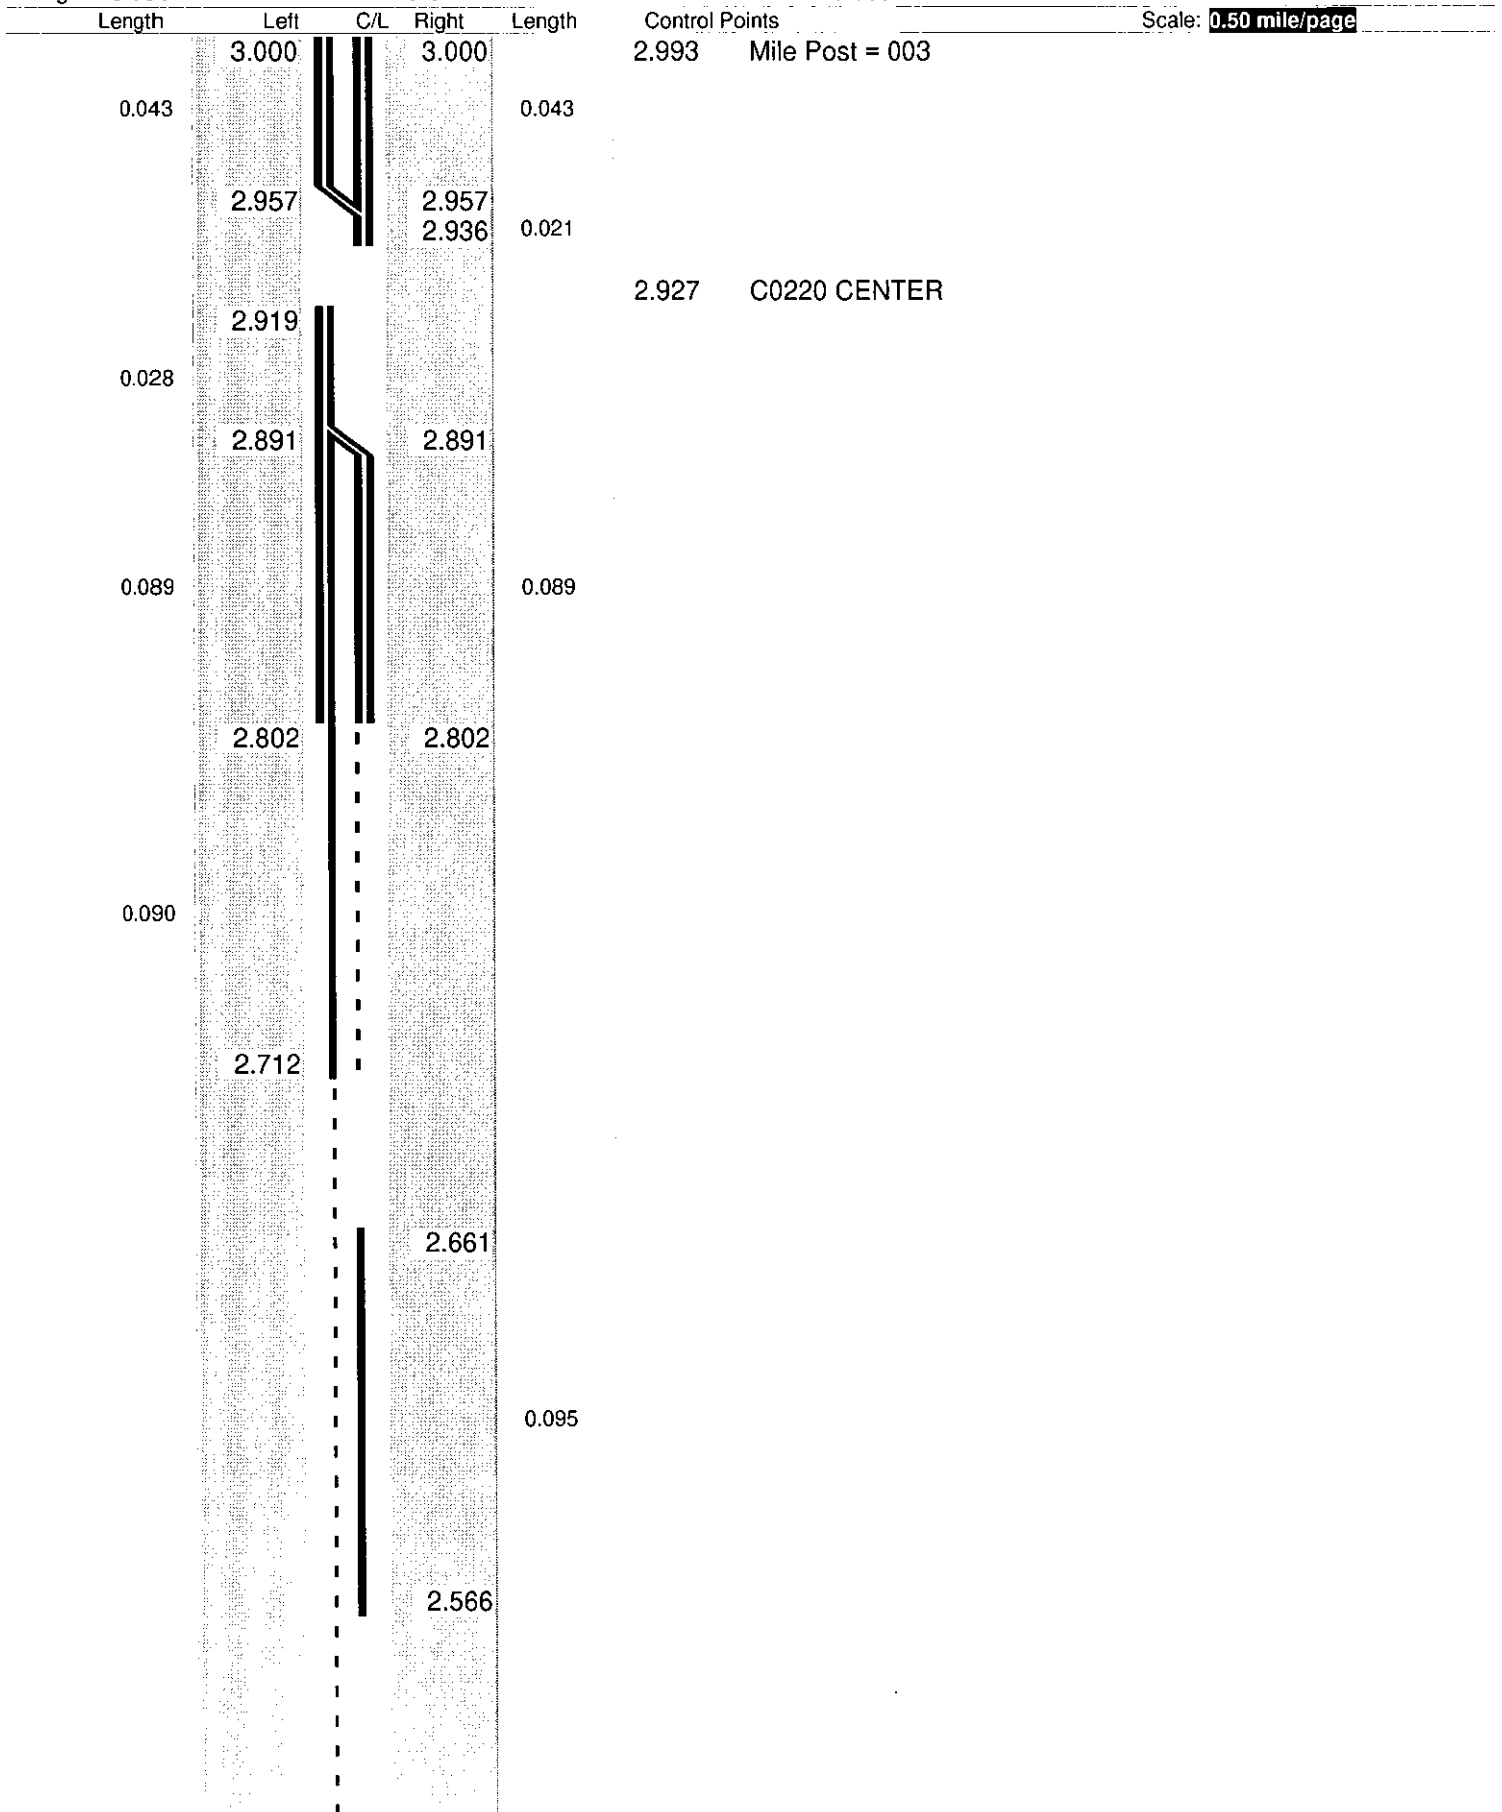

From: 0.000 LEAVE STA CO
To: 8.039 CARNEGIE

© 2004 - MasterMind Systems, Inc. - Traffic Safety Suite


No Passing Zone Log (SUM)

Route: SSUMSR00093**C (0093R)

From: 0.000 LEAVE STA CO

Length: 8.039 Direction: North

To: 8.039 CARNEGIE

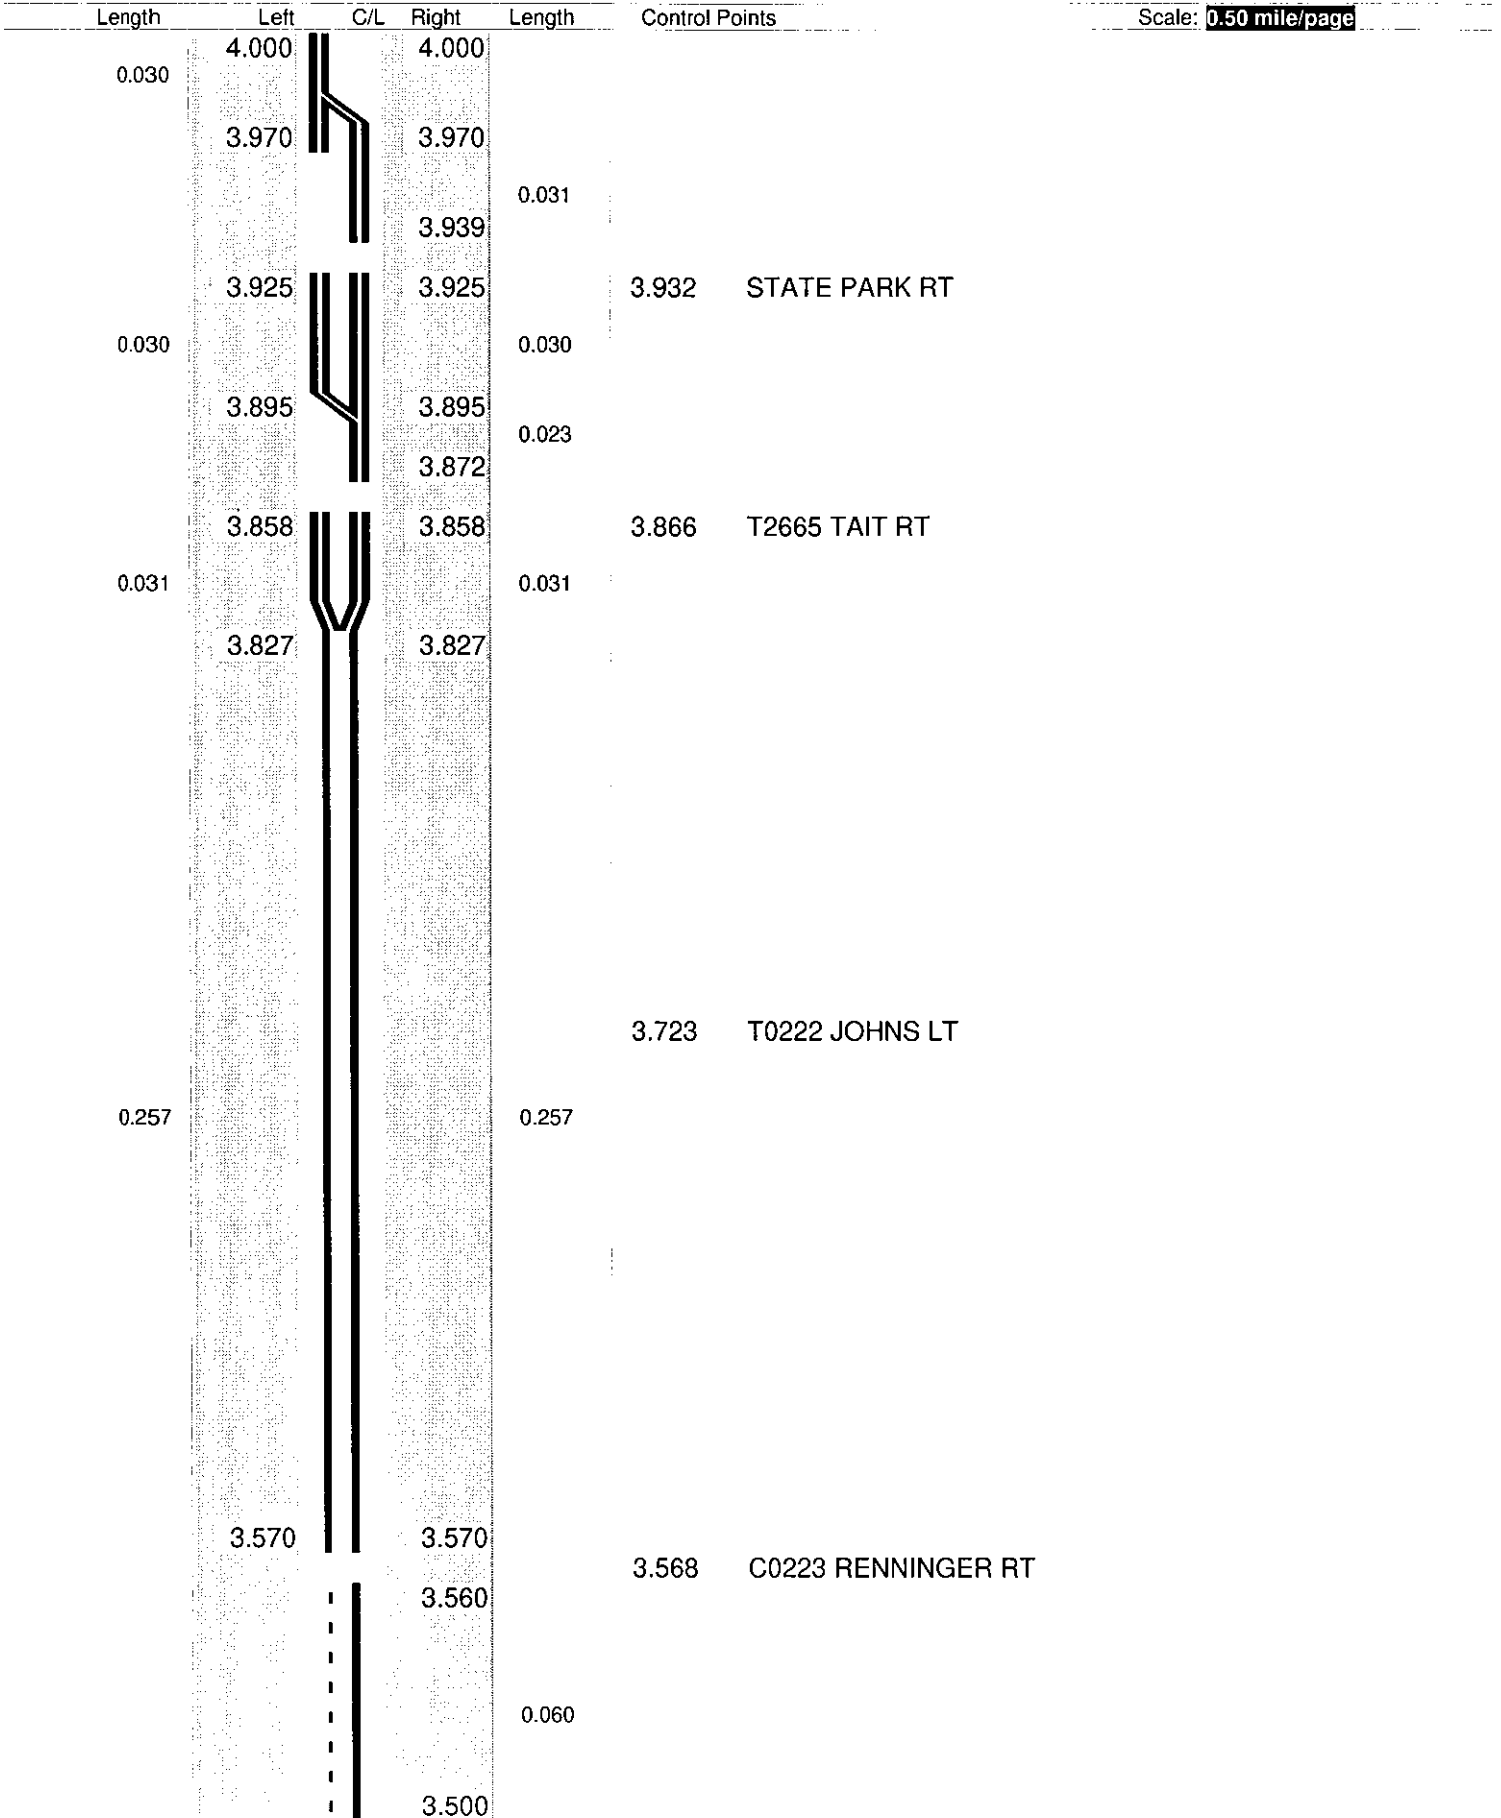

ODOT - Dist 4 - Summit Co - FINAL No Passing Zone Log (SUM)

Page: 8 of 16


Route: SSUMSR00093**C (0093R)

Length: 8.039

Direction: North

From: 0.000 LEAVE STA CO

To: 8.039 CARNEGIE

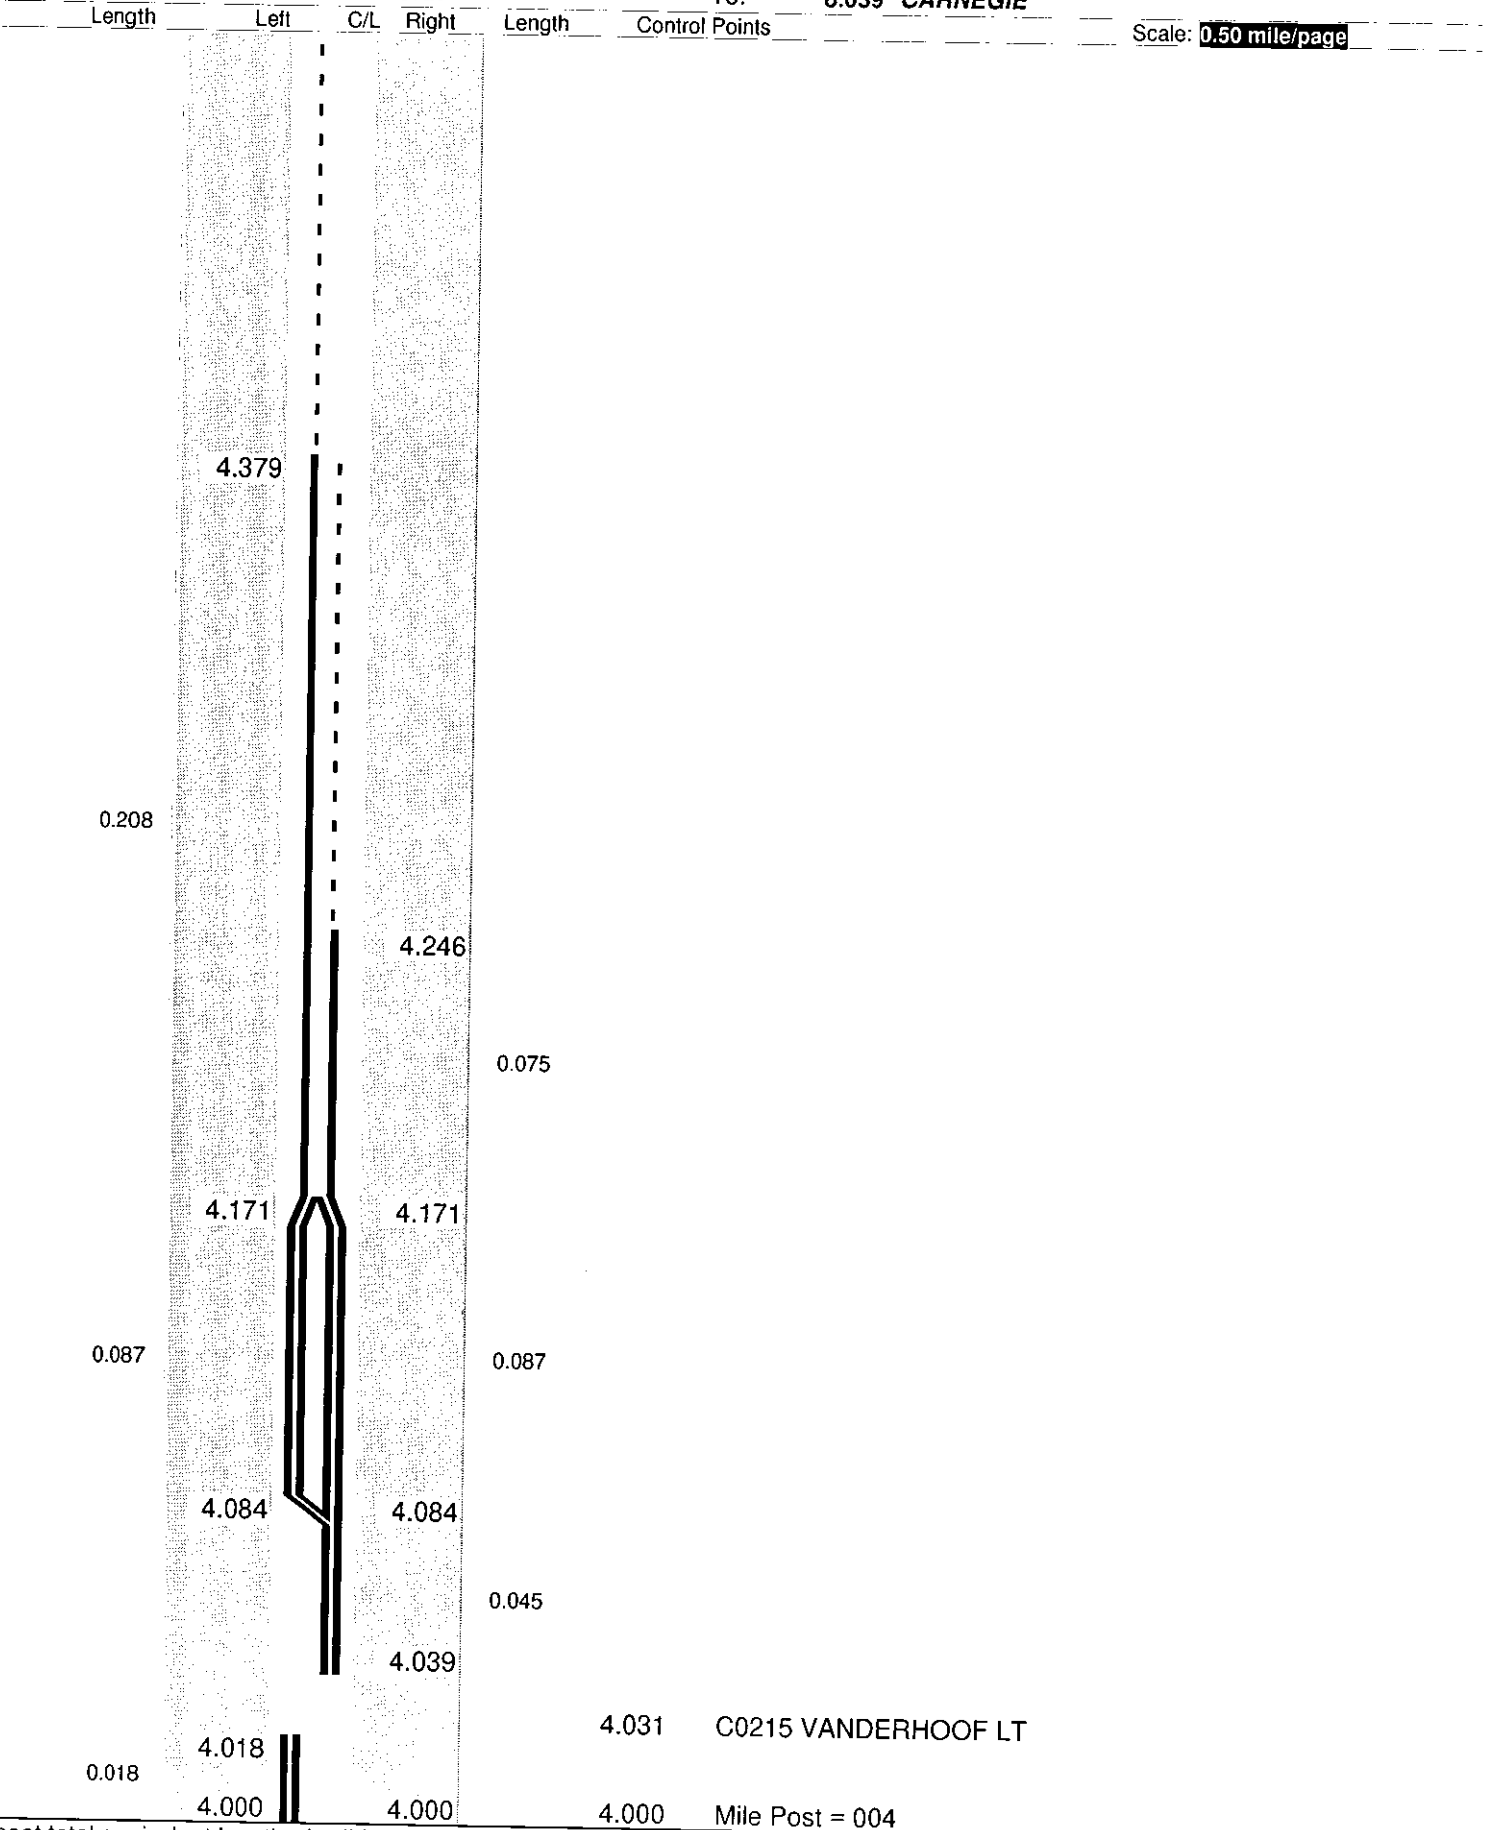

Sheet total equivalent length of solid line: 0.821

Accum. total: 7.081

© 2004 - MasterMind Systems, Inc. - Traffic Safety Suite

No Passing Zone Log (SUM)

Route: SSUMSR00093**C (0093R)

From: 0.000 LEAVE STA CO

Length: 8.039

Direction: North

To: 8.039 CARNEGIE

Length	Left	C/L	Right	Length	Control Points	Scale: 0.50 mile/page
					4.998 Mile Post = 005	
					4.960 T1026 MIDLAND LT	
					4.819 T1027 TWEED RT	
					4.819 T1027 TAPLIN LT	
					4.714 T1028 BLOSSOM RT	
					4.604 T1906 GREENVALLEY RT	
					4.507 T0234 SWIGART RT	
					4.507 C0234 SWIGART LT	

ODOT - Dist 4 - Summit Co - FINAL No Passing Zone Log (SUM)

Page: 10 of 16


Route: **SSUMSR00093**C (0093R)**

Length: **8.039**

Direction: **North**

From: **0.000 LEAVE STA CO**

To: **8.039 CARNEGIE**

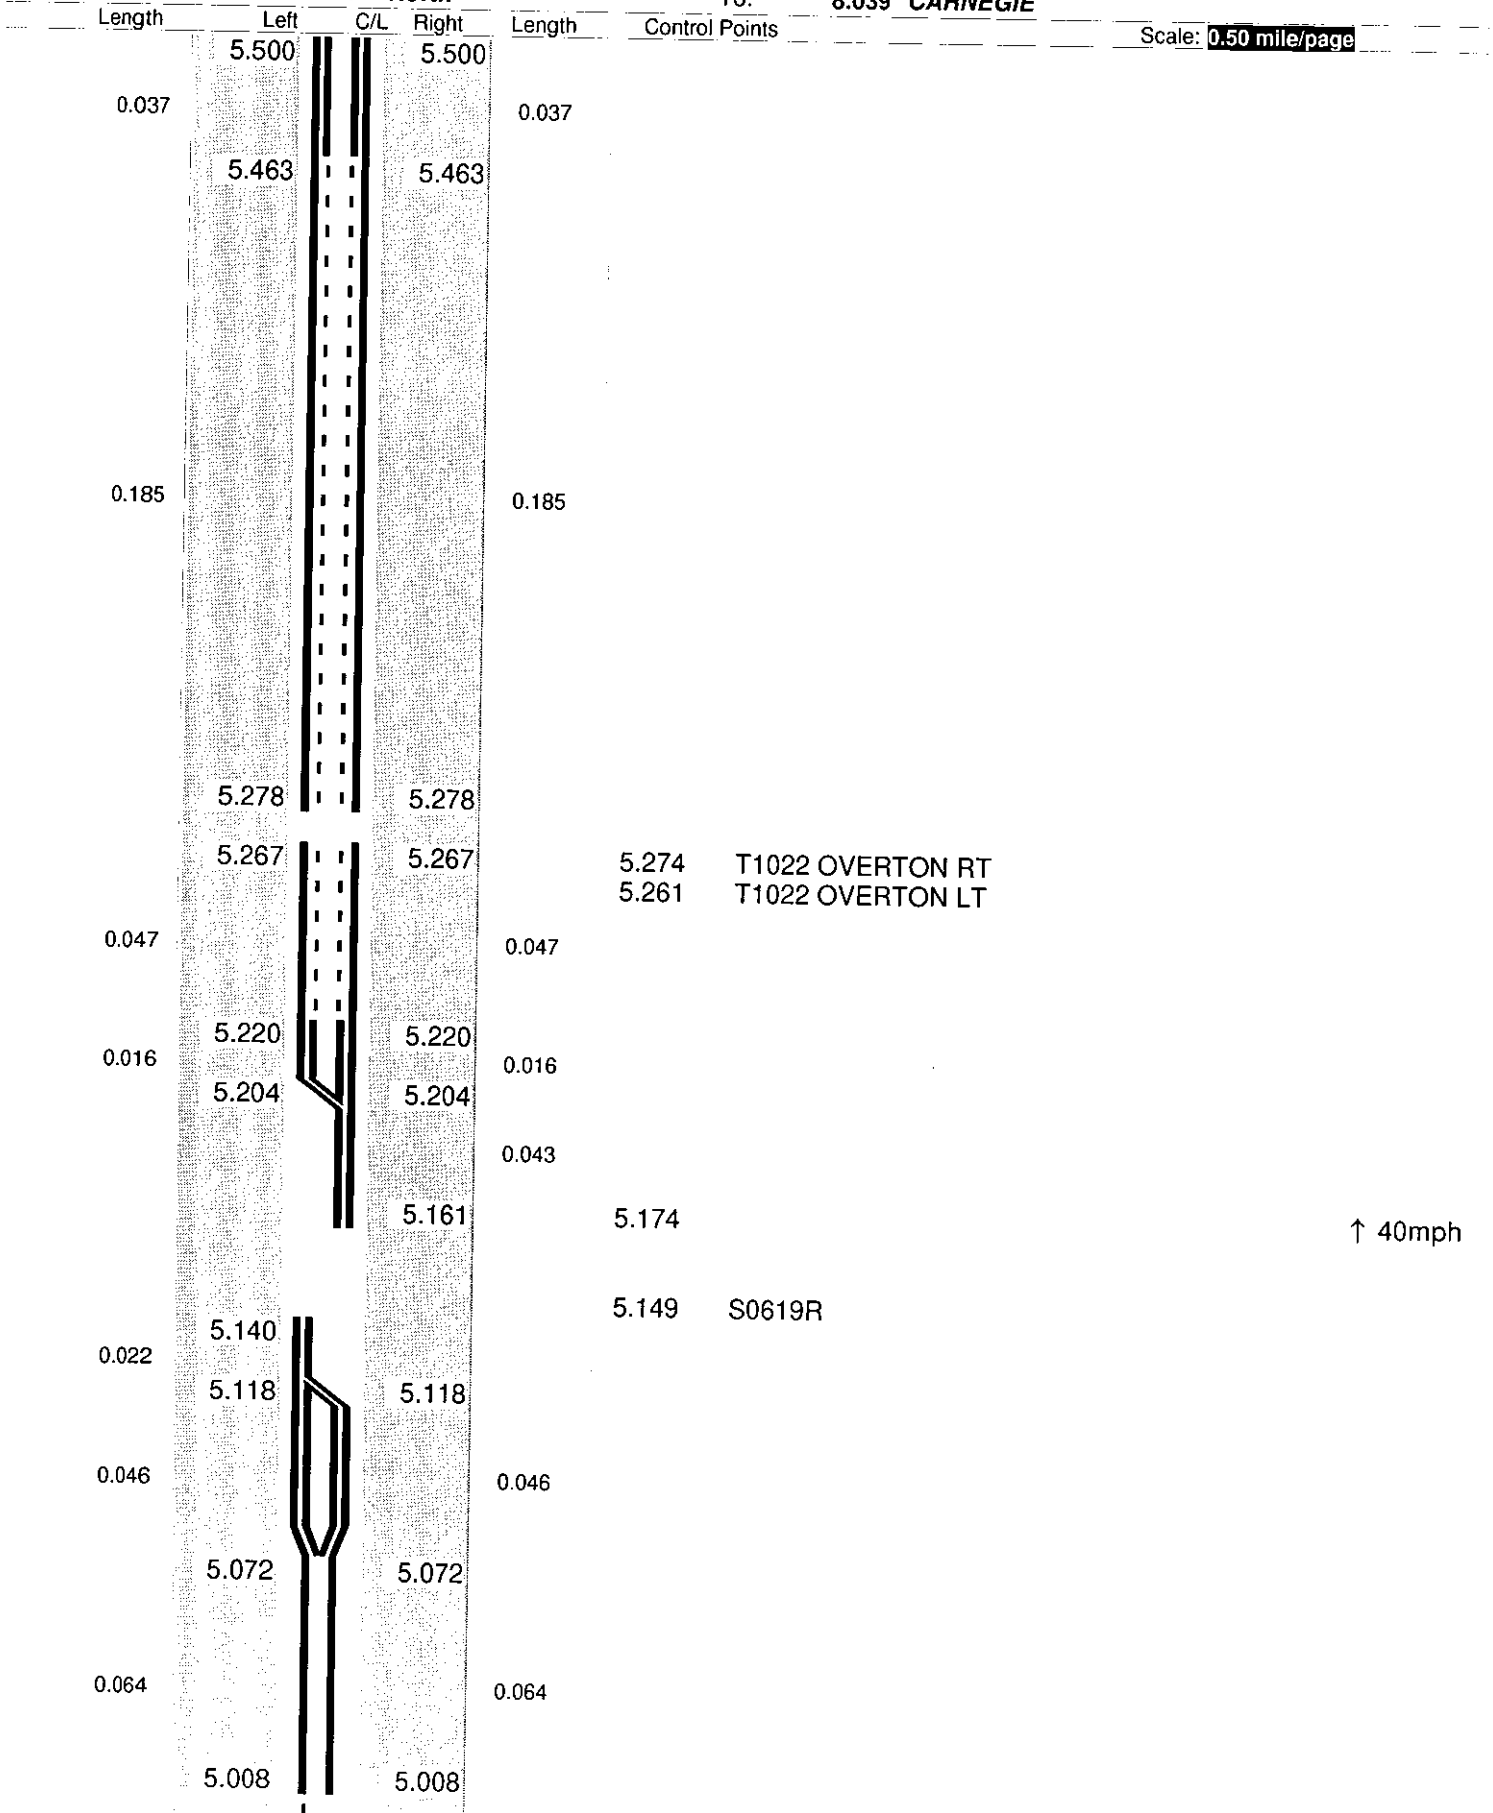

Sheet total equivalent length of solid line: 1.236

Accum. total: 8.567

© 2004 - MasterMind Systems, Inc. - Traffic Safety Suite

ODOT District 4 No Passing Zone Log (SUM)

Page: 11 of 16

Route: 0093R (SSUMSR00093**C)





Scale: 0.50 mile/page

Length	Left	C/L	Right	Length	Control Points
--------	------	-----	-------	--------	----------------

5.865

5.767

5.775 T1299 HYFIELD LT

5.745 T1689 LANG RT

0.336

0.238

5.644 T1297 FARR RT

5.578 T1296 CALDWELL RT

5.529

5.529

5.526 T1024 WOODCREST LT

5.520 NEW FRANKLIN CORP.

0.015

5.515
5.500

5.515
5.500

0.015

Sheet total equivalent length of solid line: 0.692

Accum. total: 0.692

CDOT - DIST 4 - Summit CO - FINAL
No Passing Zone Log (SUM)

Page: 12 of 16


Route: SSUMSR00093**C (0093R)

Length: 8.039

Direction: North

From: 0.000 LEAVE STA CO

To: 8.039 CARNEGIE

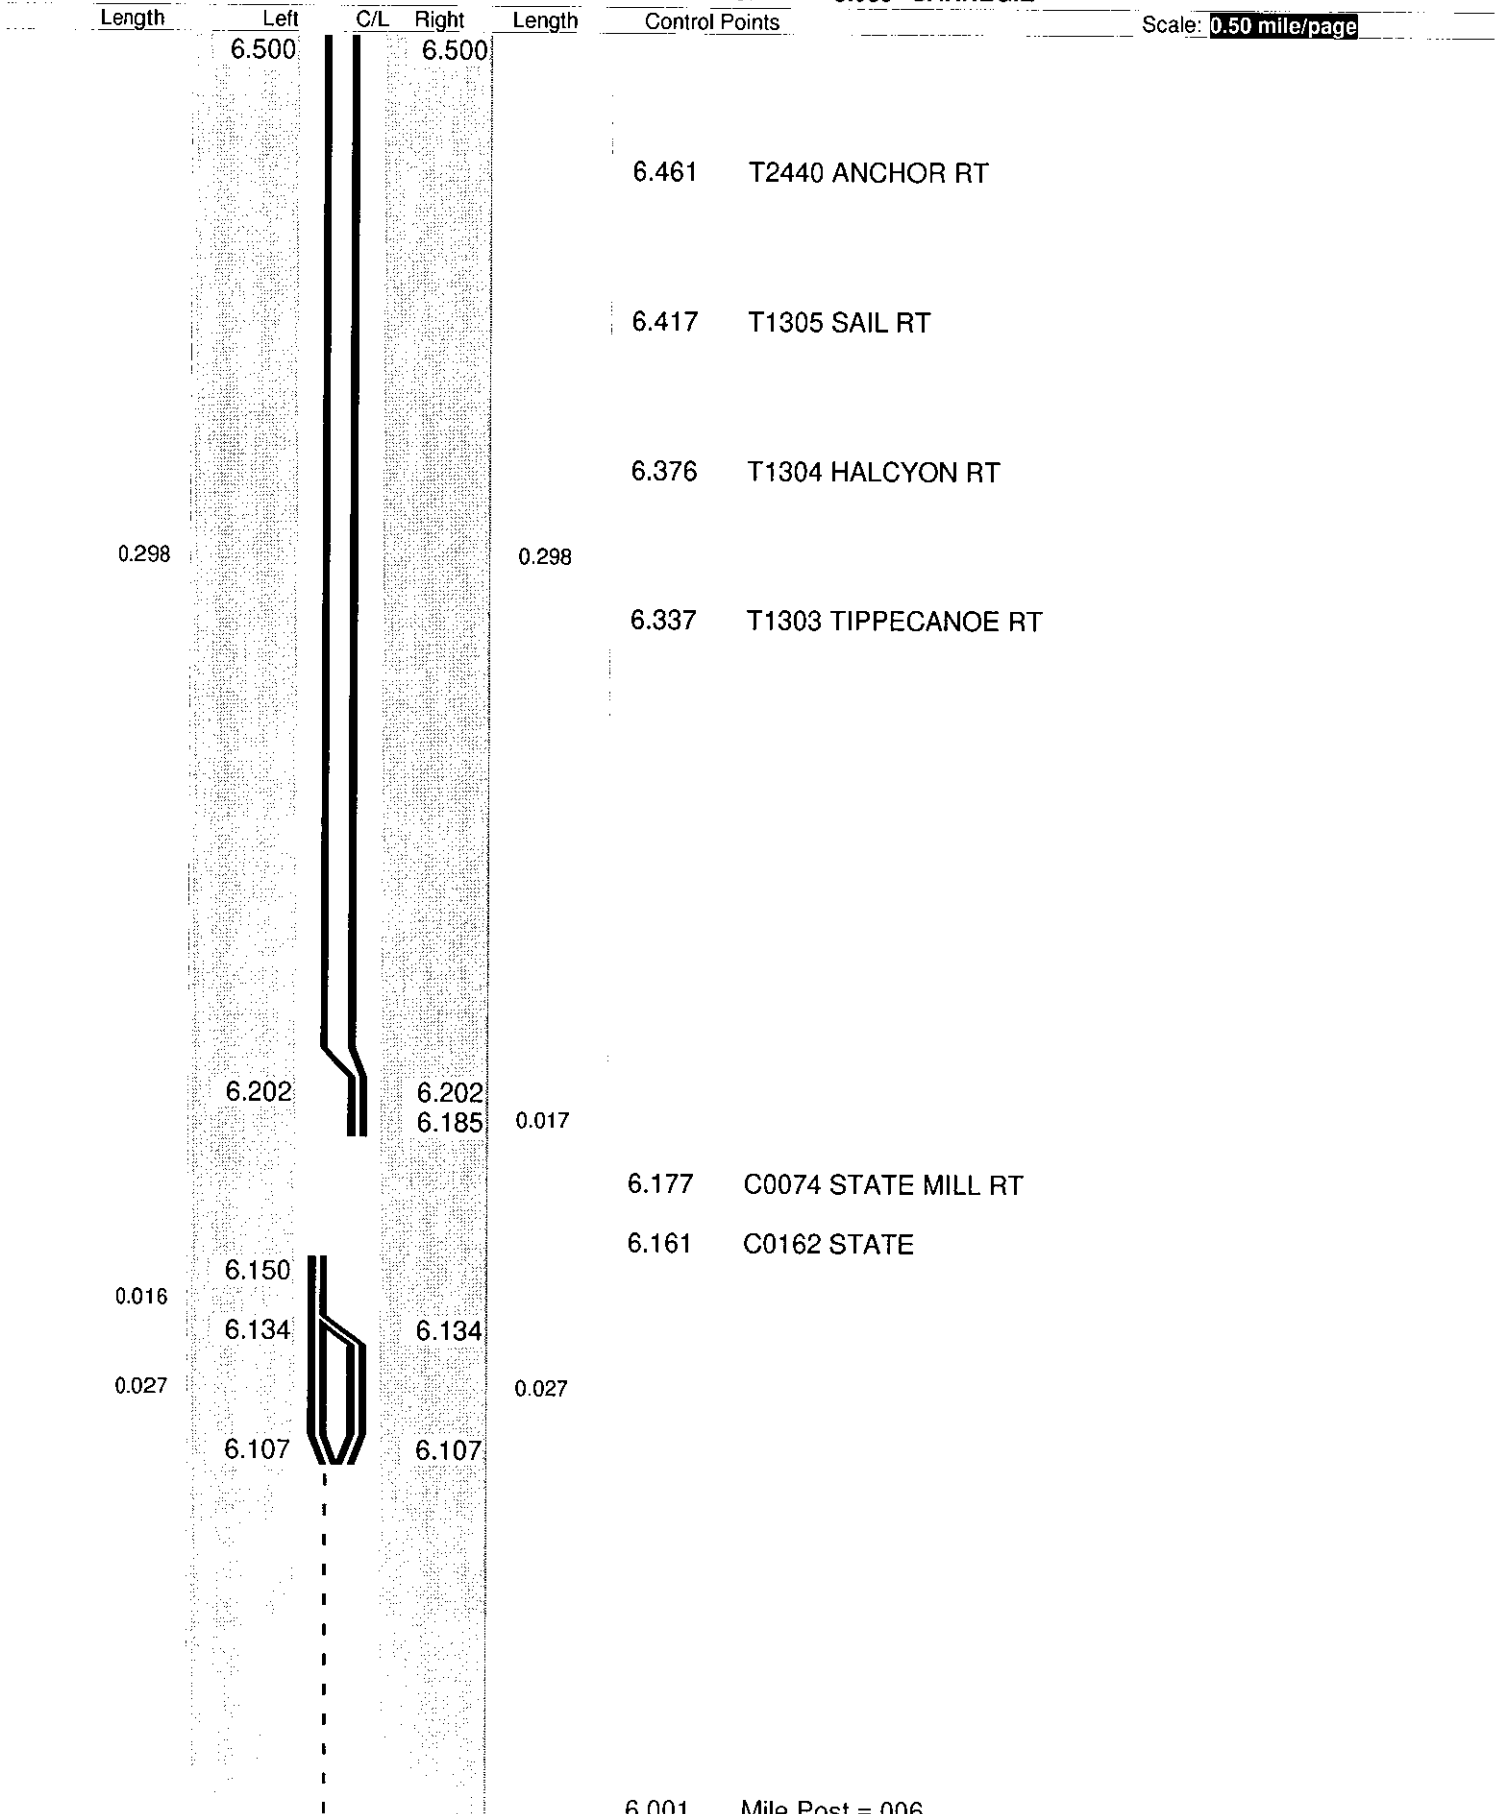

Sheet total equivalent length of solid line: 0.797

Accum. total: 10.078

© 2004 - MasterMind Systems, Inc. - Traffic Safety Suite

ODOT - Dist 4 - Summit Co - FINAL

Page: 13 of 16

Route: SSUMSR00093**C (0093R)

Length: 8.039

Direction: **North**

From: 0.000 LEAVE STA CO

To: 8.039 CARNEGIE

Length	Left	C/L	Right	Length	Control Points
0.021	7.000 6.979		7.000 6.979	0.021	
0.231				0.231	6.914 T1309 PROEHL LT
					6.799 T0302 BEVAN LT
	6.748		6.748	0.025	
	6.710		6.710		6.716 C0075 PORTAGE LAKES RT
0.022	6.688		6.688	0.022	
0.188				0.188	6.599 T1306 IOLA RT
	6.500		6.500		

Scale: 0.50 mile/page

Sheet total equivalent length of solid line: 1.060

Accum. total: 11.138

© 2004 - MasterMind Systems, Inc. - Traffic Safety Suite

ODOT - Dist 4 - Summit Co - FINAL No Passing Zone Log (SUM)

Page: 14 of 16


Route: SSUMSR00093**C (0093R)

Length: 8.039

Direction: North

From: 0.000 LEAVE STA CO
To: 8.039 CARNEGIE

Scale: 0.50 mile/page

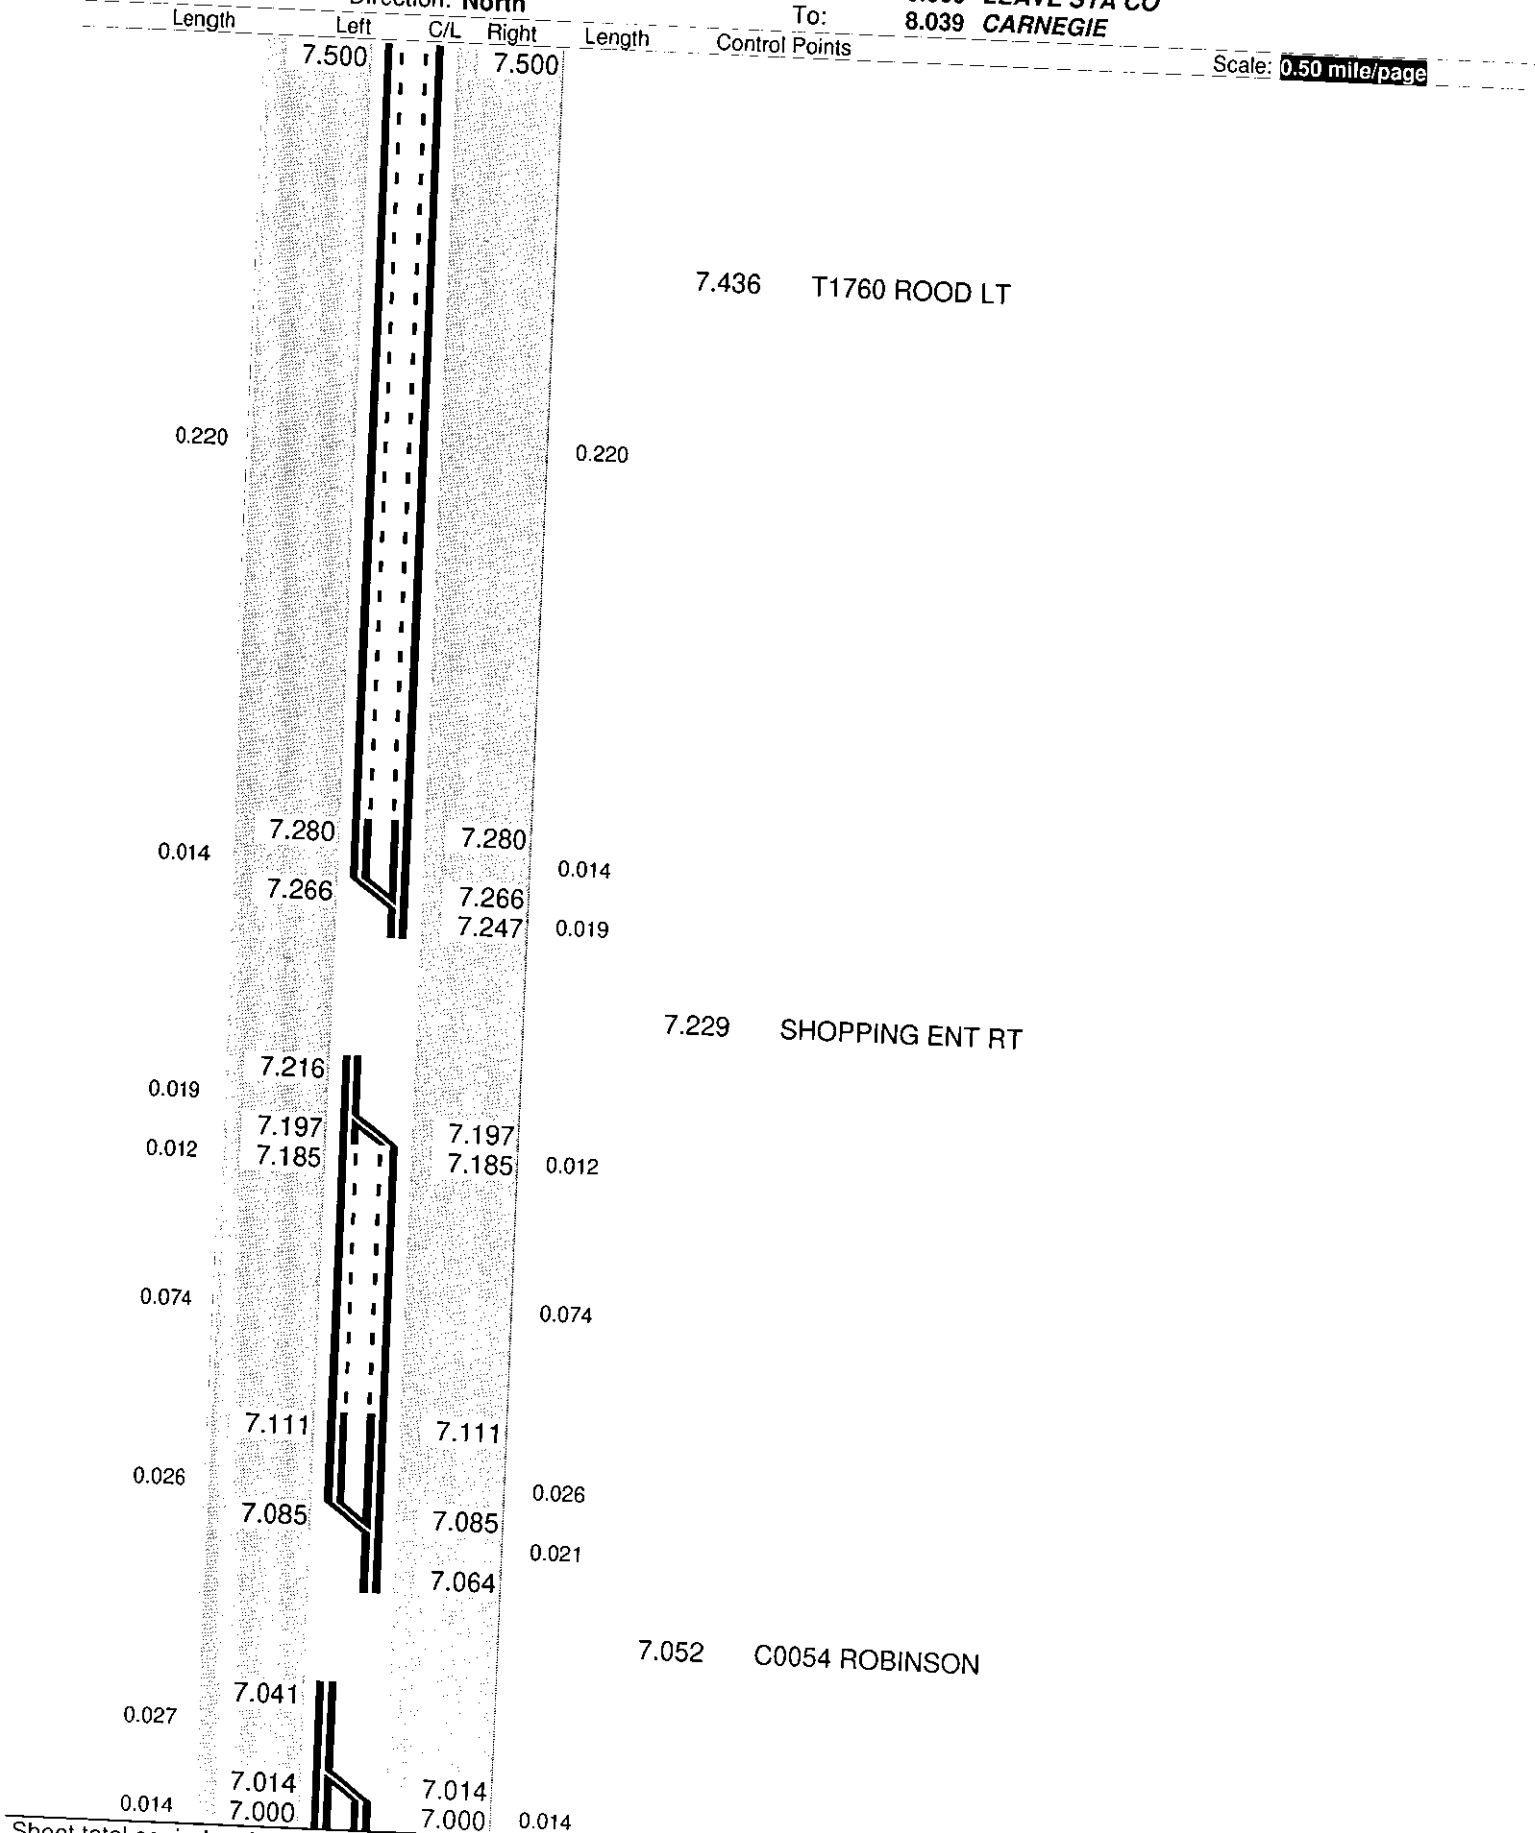

Sheet total equivalent length of solid line: 1.171

Accum. total: 12.309

© 2004 - MasterMind Systems, Inc. - Traffic Safety Suite

No Passing Zone Log (SUM)

Page: 15 of 16

Length: 8.039

Direction: **North**

To: 8,039 **CARNEGIE**

Length

Left

C/L

Right

Length

Control Points

Scale: 0.50 mile/page

8.000

8.000

0.300

0.299

7.863 BRIDGE

7.700

7.701
7.700

7.715 START 4 LANES

0.067

7.673 T1311 COVE RT
7.661 T1314 GARSON LT

7.633

7.627 C0233 CORMANY RT

7.620

7.620

0.120

0.120

7.500

7.500

ODOT - Dist 4 - Summit Co - FINAL No Passing Zone Log (SUM)

Page: 16 of 16

Route: SSUMSR00093**C (0093R)

Length: 8.039

Direction: North

From: 0.000 LEAVE STA CO

To: 8.039 CARNEGIE

Length

Left

C/L

Right

Length

Control

Points

Scale: 1.00 mile/page

0.028 8.028 8.028 8.039 CARNEGIE LT
8.000 8.000 8.013 BRIDGE
0.028 8.004 Mile Post = 008

Sheet total equivalent length of solid line: 0.056

Accum. total: 13.398