




STARK COUNTY
STA-30-14.12
STA-77-9.22

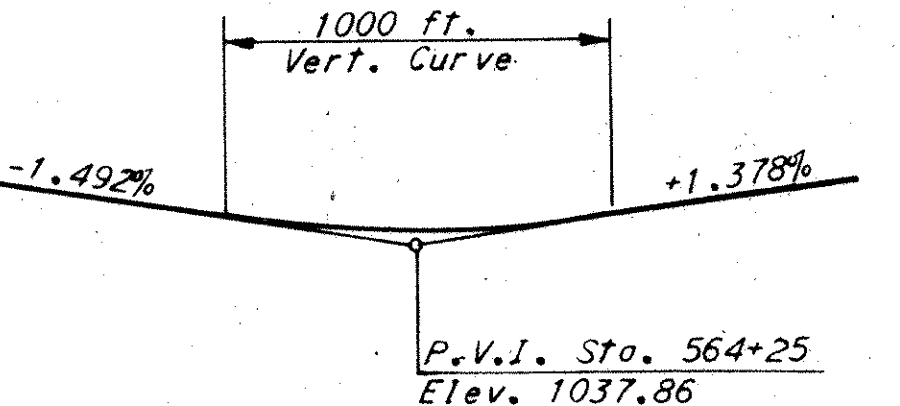


PROFILE GRADE - I-77

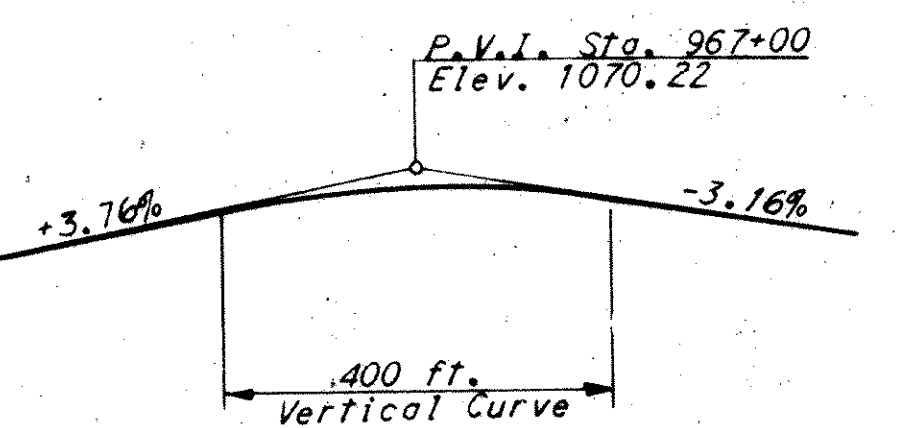

PROFILE GRADE - RAMP G

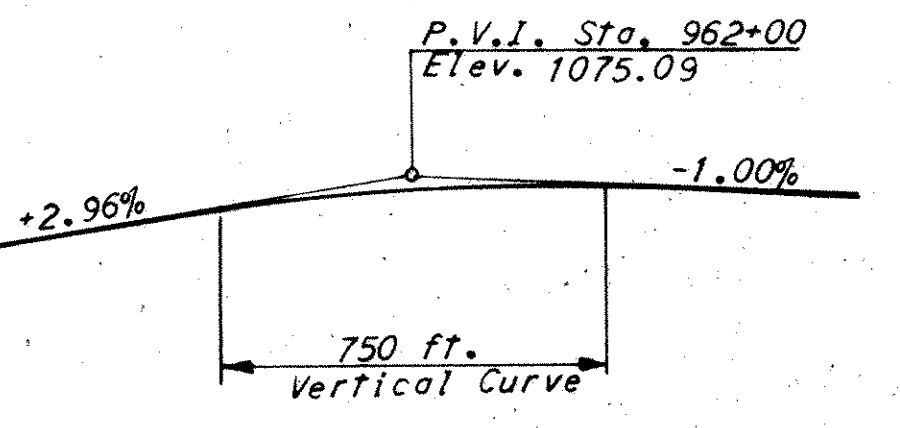

PROFILE GRADE - U.S. 30

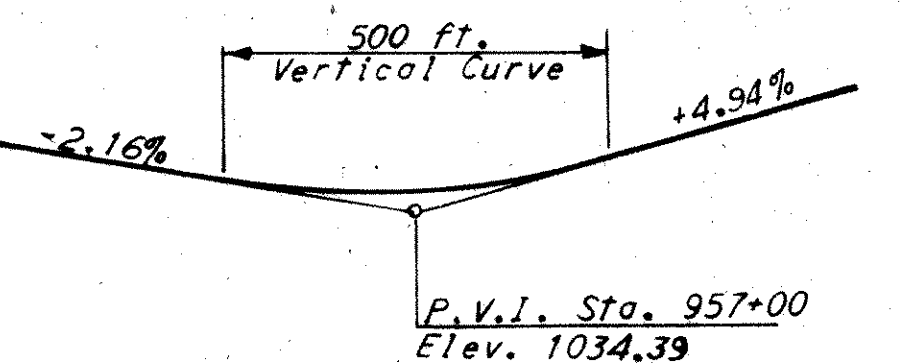

PROFILE GRADE - RAMP C

PROPOSED STRUCTURE
Type: Continuous Welded Curved Girders with Reinforced Concrete Slab.
Spans: 74'-0", 97'-0", 81'-0", 61'-6", 71'-0", 90'-6", 90'-0", 110'-6", 72'-0" = 747'-6" Ctr. to Ctr.
End Bearings along @ Ramp B.
Roadway: 30'-0" Face to Face of parapets.
Loading: HS 20-44.
Skews: Varies; see Plan.
Wearing Surface: 1 1/2" Asphalt Concrete.
Alignment: 350' Radius Left on @ Ramp B.
Approach Slab: AS-1-72 (25' Long) (Modified)

Modify Std. Drwg. AS-1-72 by providing 3" clear over the top rebars instead of the 2" shown on the Std. Drwg. The jacking holes as called for on Std. Drwg. AS-1-72 are not required.


H.N.T.B. BRIDGE NO. 14 Revised 6-26-75 By RAS
HOWARD, NEEDLES, TAMMEN & BERGENDOFF 1/16
CONSULTING ENGINEERS
KANSAS CITY CLEVELAND NEW YORK

SITE PLAN
RAMP B OVER RAMP C AND G,
I-77 AND PENN. R.R.
BR. NO. STA. 30-1489 STA. 958+78.75
SCALE: 1"=50'-0" STA. 966+30.88
RELOCATED U.S. 30
CANTON STARK COUNTY OHIO
DRAWN BY: JSS DATE: 12-70 TRACED BY: DATE: CHECKED BY: DATE: 2-20-70 REVIEWED BY: DATE: 1-20-71 REVISION: 1668

EXISTING UTILITY LEGEND

- 4" G- GAS
- 4" W- WATER
- 16" Storm- STORM SEWER
- 8" San- SANITARY SEWER
- T- TELEPHONE
- E- POWER LINES
- 4W-E4KV 4 WIRE, PRIMARY 4 KILOVOLT
- 3W-E, 3 WIRE, SECONDARY
- WATER HYDRANT
- MANHOLE
- CATCH BASIN

*To be paid for under "Rock Channel Protection, Type A, with Bedding." See Roadway Plans. without

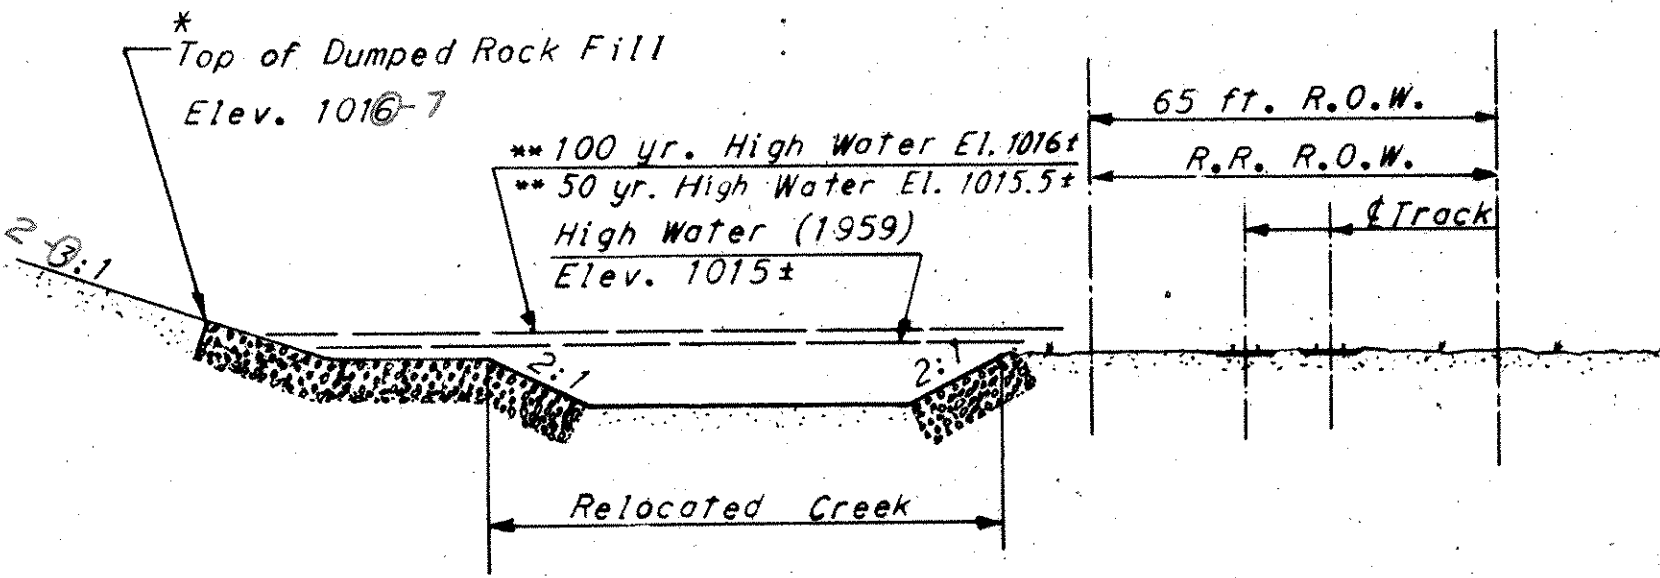


SECTION THRU W. BRANCH NIMISHILLEN CREEK

FLOOD DISCHARGE					
WEST BRANCH NIMISHILLEN CREEK AT NAVARRE ROAD BRIDGE					
Occurance Interval (years)	5	10	20	50	100
*Discharge Q (c.f.s.)	1360	1680	2010	2520	3000

* Taken from Table 5, "Flood Discharge-Frequency Relationship", page 74-23, "Flood Plain Study-Main Report", Corps of Engineers, Feb. 1967.
** Taken 2,000 ft. above mouth as shown on Exhibit No. 4 and Exhibit No. 12, "Flood Plain Study-Main Report", Corps of Engineers, Feb. 1967.

Notes:
The following items are not included in the bridge plans.
See roadway plans for details:
1. Relocation or removal of existing utilities.
2. Approach grading, pavements and slabs.
3. Guardrails.
11,117 Denotes one way 1987 average daily traffic.
Earth work limits shown are schematic. Actual slopes shall conform to plan cross-sections.
■ Denotes standard scupper.

For details of Wall D see Sheets 368 and 369
For profile grade of Ramp B see Sheet 2/16
For information not shown on this sheet see General Plans
Sheets 3/16 and 4/16
For Estimated Quantities, see Sheet 365D.

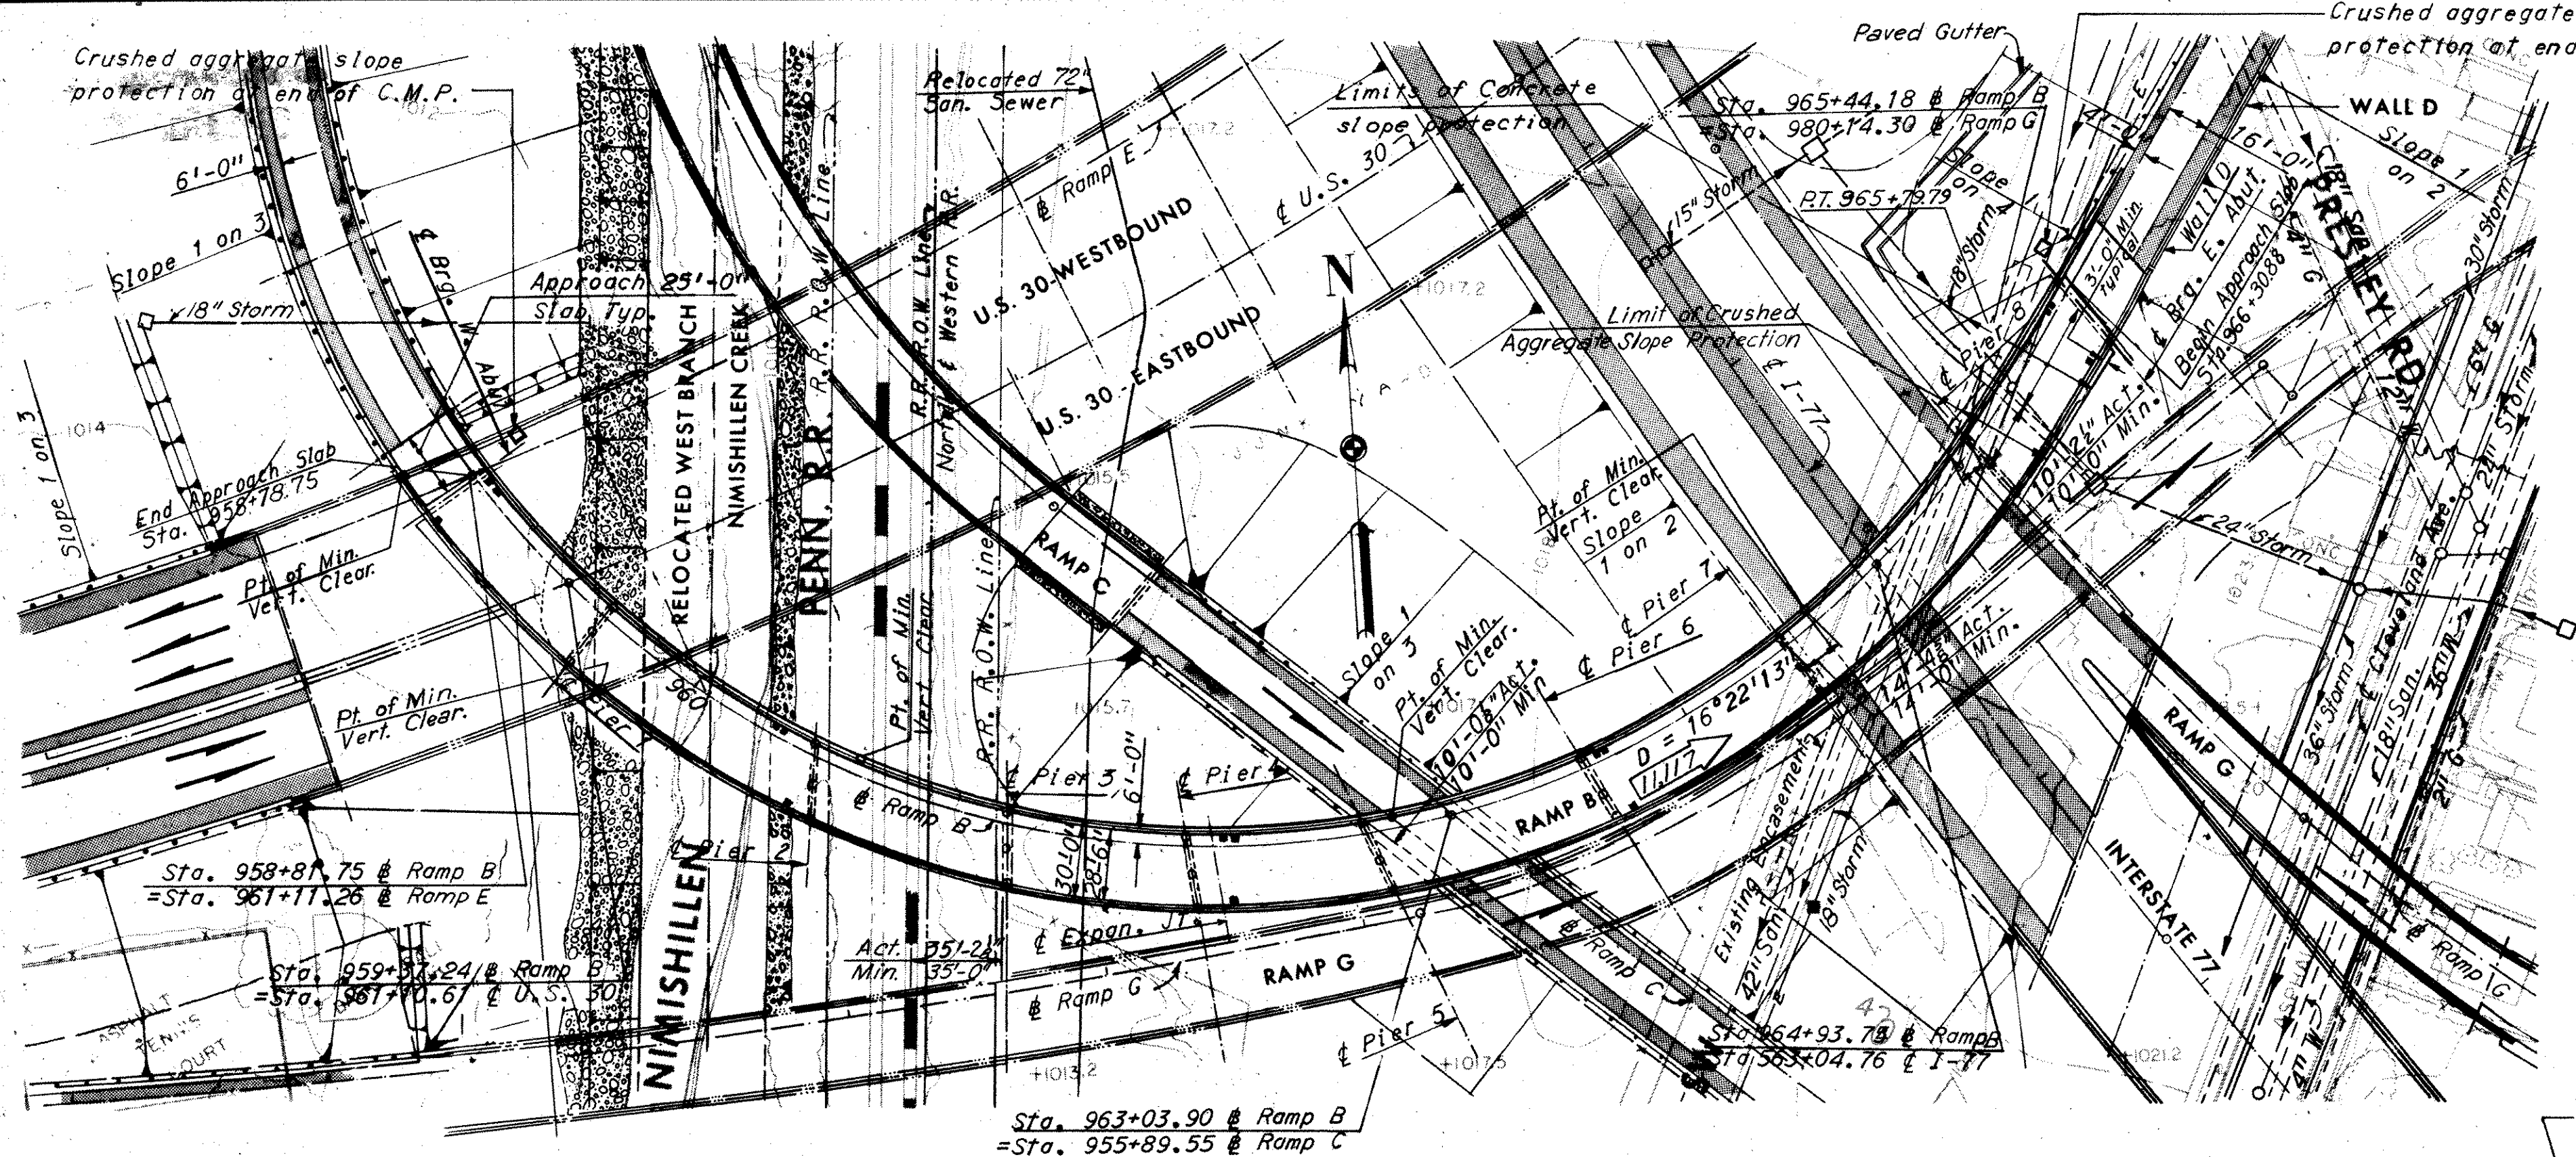

PLAN


NOTES:
Embankment shall be constructed to the level of the subgrade for a minimum distance of 200 feet back of the abutments. Excavation may then be made for the abutments, Pier No. 8 and piles driven.
Other embankment in which piers are to be placed shall be constructed to the level of the sub-grade for a minimum distance of 200 feet, or to the limits of the embankment before excavation for the footings is made and piles driven.
Piling for the West Abutment of Br. No. Sta. 30-1489 and the three northern most footings for Pier No. 1 of Br. No. Sta. 30-1487 shall be driven before placing any concrete for either substructure unit.

MICROFILMED
SEP 14 1983

FED. ROAD DIV. NO.	STATE	FEDERAL AID PROJECT NO.	TYPE FUNDS
2	OHIO		

325
389


STARK COUNTY
STA-30-14.12
STA-77-9.22

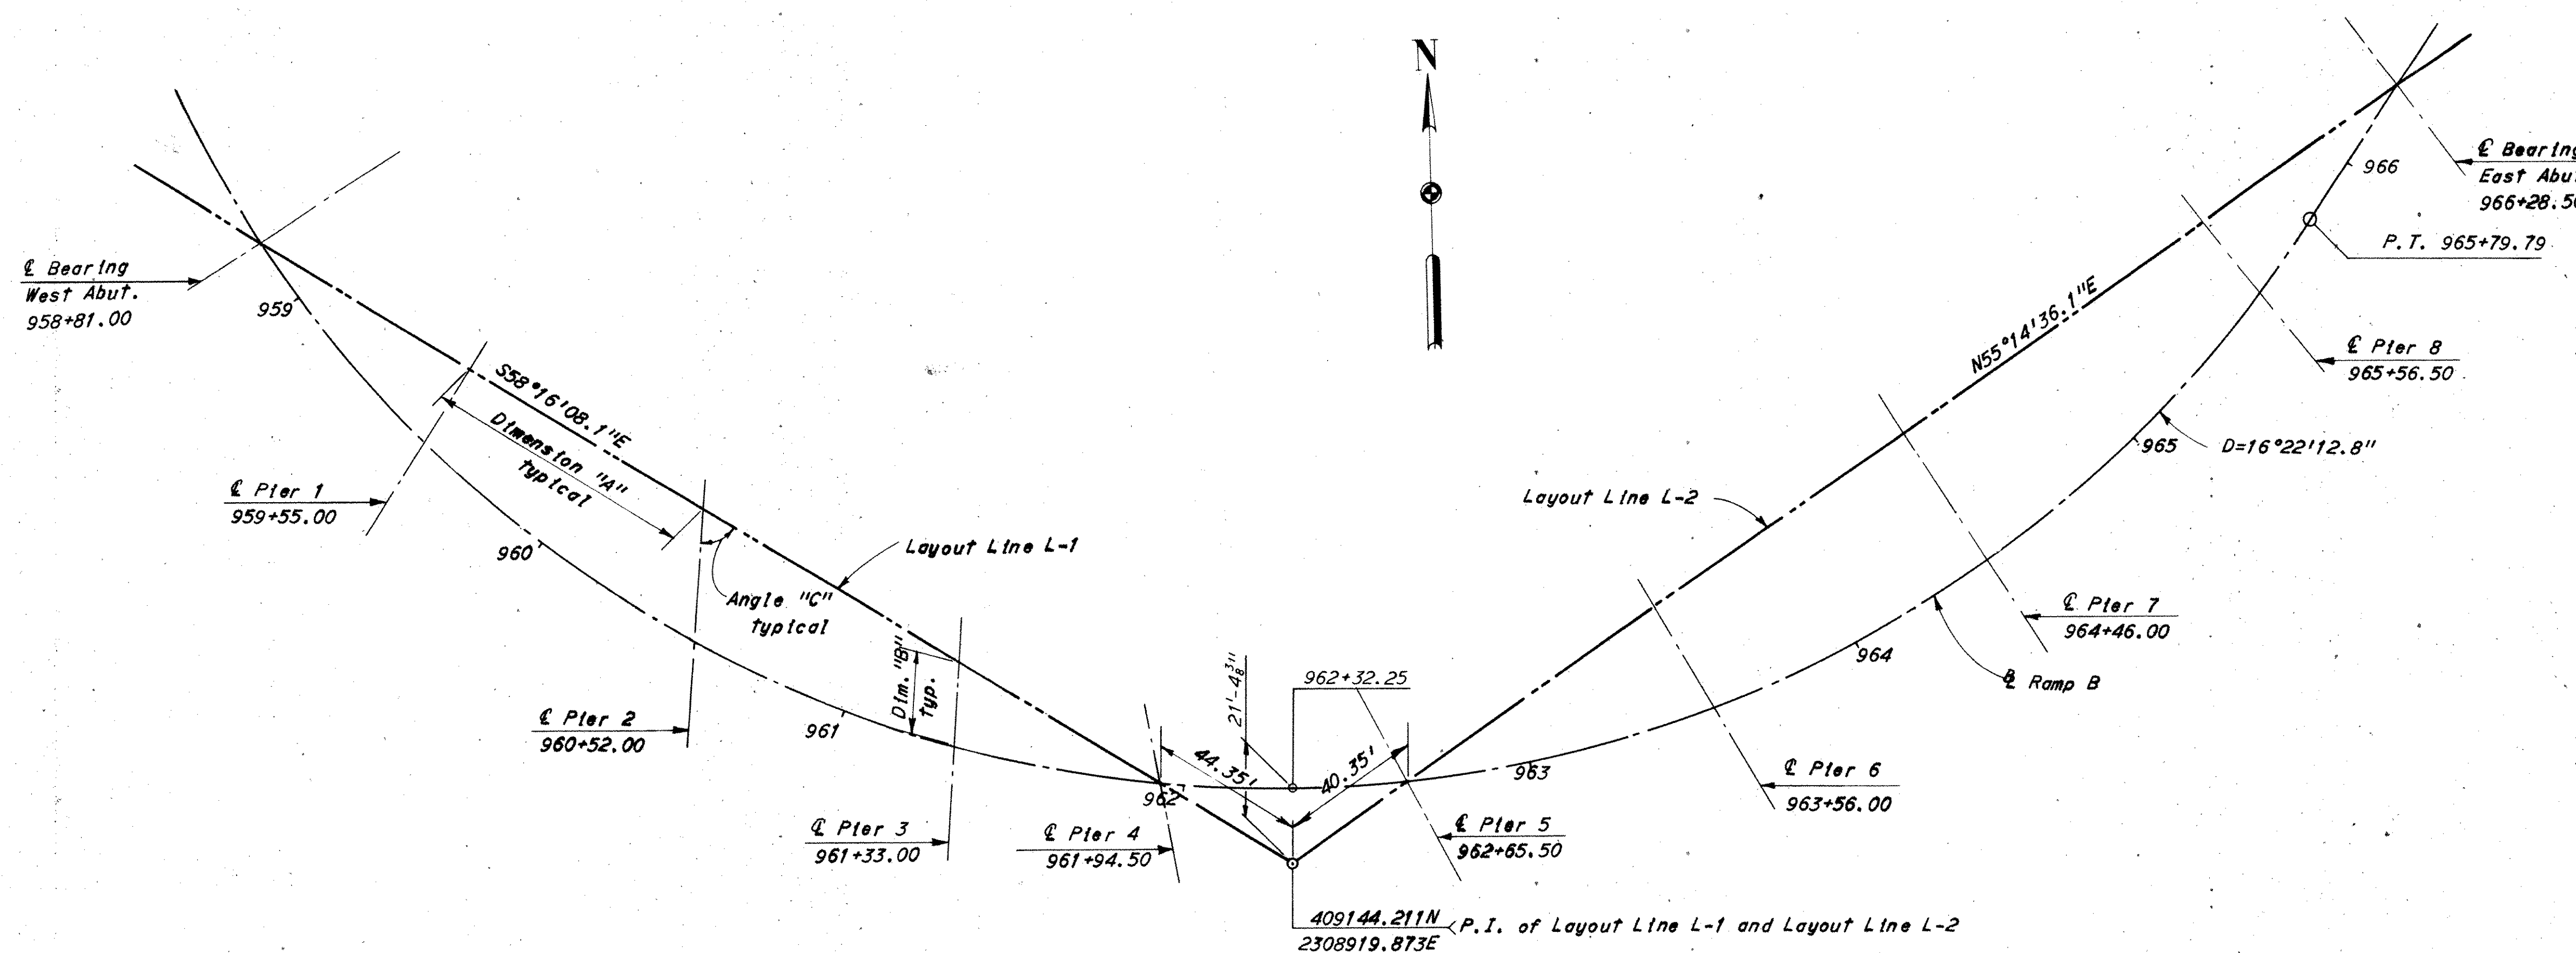

LAYOUT DIMENSIONS			
	"A"	"B"	ANGLE "C"
W. Abut.	0	0	115°39'37.3"
Pier 1	69.82'	24.78'	90°32'47.0"
Pier 2	78.11'	38.62'	62°25'02.2"
Pier 3	86.41'	24.41'	62°25'02.2"
Pier 4	68.79'	0	46°50'23.0"
Pier 5	-	0	97°12'16.5"
Pier 6	86.66'	33.63'	94°53'22.3"
Pier 7	87.89'	44.52'	92°09'22.8"
Pier 8	105.53'	26.57'	87°04'02.0"
E. Abut.	68.28'	0	87°04'02.0"

LAYOUT FROM WEST ABUTMENT TO EAST ABUTMENT

Note:
See General Plan Sheets for bearings of piers
and footing locations.

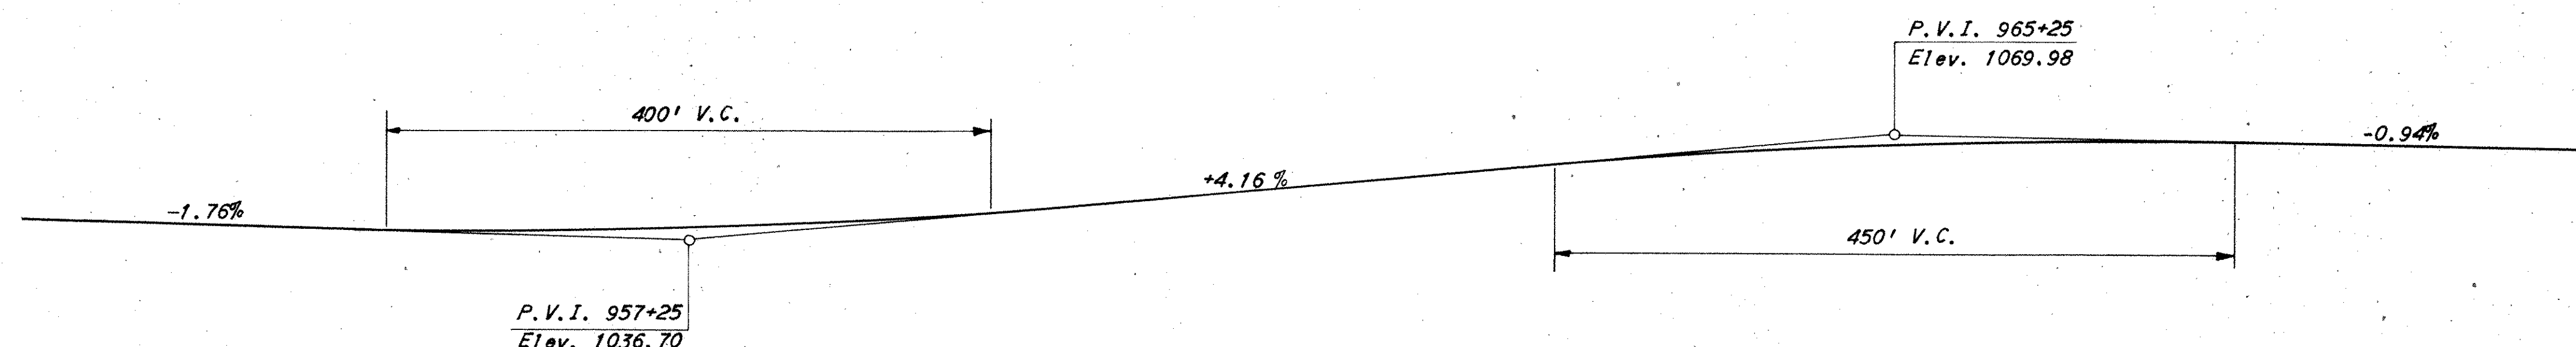

PROFILE GRADE - RAMP B

HORIZONTAL CURVE DATA - RAMP B


P.I. Sta. 975+73.567
D = 16°22'12.8"
Δ = 159°51'14.5" Lt.
R = 350.000'
T = 1970.268
L = 976.493

H.N.T.B. BRIDGE NO. 14			
HOWARD, NEEDLES, TAMMEN & BERGENDOFF CONSULTING ENGINEERS KANSAS CITY CLEVELAND NEW YORK			
2/16			
LAYOUT DATA			
RAMP B OVER RAMPS C AND G, I-77 AND PENN. R.R.			
BR. NO. STA. 30-1489		STA. 958 + 78.75	
SCALE: 1"=30'-0"		STA. 966 + 30.88	
RELOCATED U.S. 30			
CANTON		STARK COUNTY OHIO	
DRAWN BY DATE 1-19-69	TRACED DATE	CHECKED DATE 4-8-70	REVIEWED DATE 1-20-71
			1668

DESIGNED
SEP 14 1980


FED. ROAD DIV. NO.	STATE	FEDERAL AID PROJECT NO.	TYPE FUNDS
2	OHIO		

STARK COUNTY
STA-30-14.12
STA-77-9.22

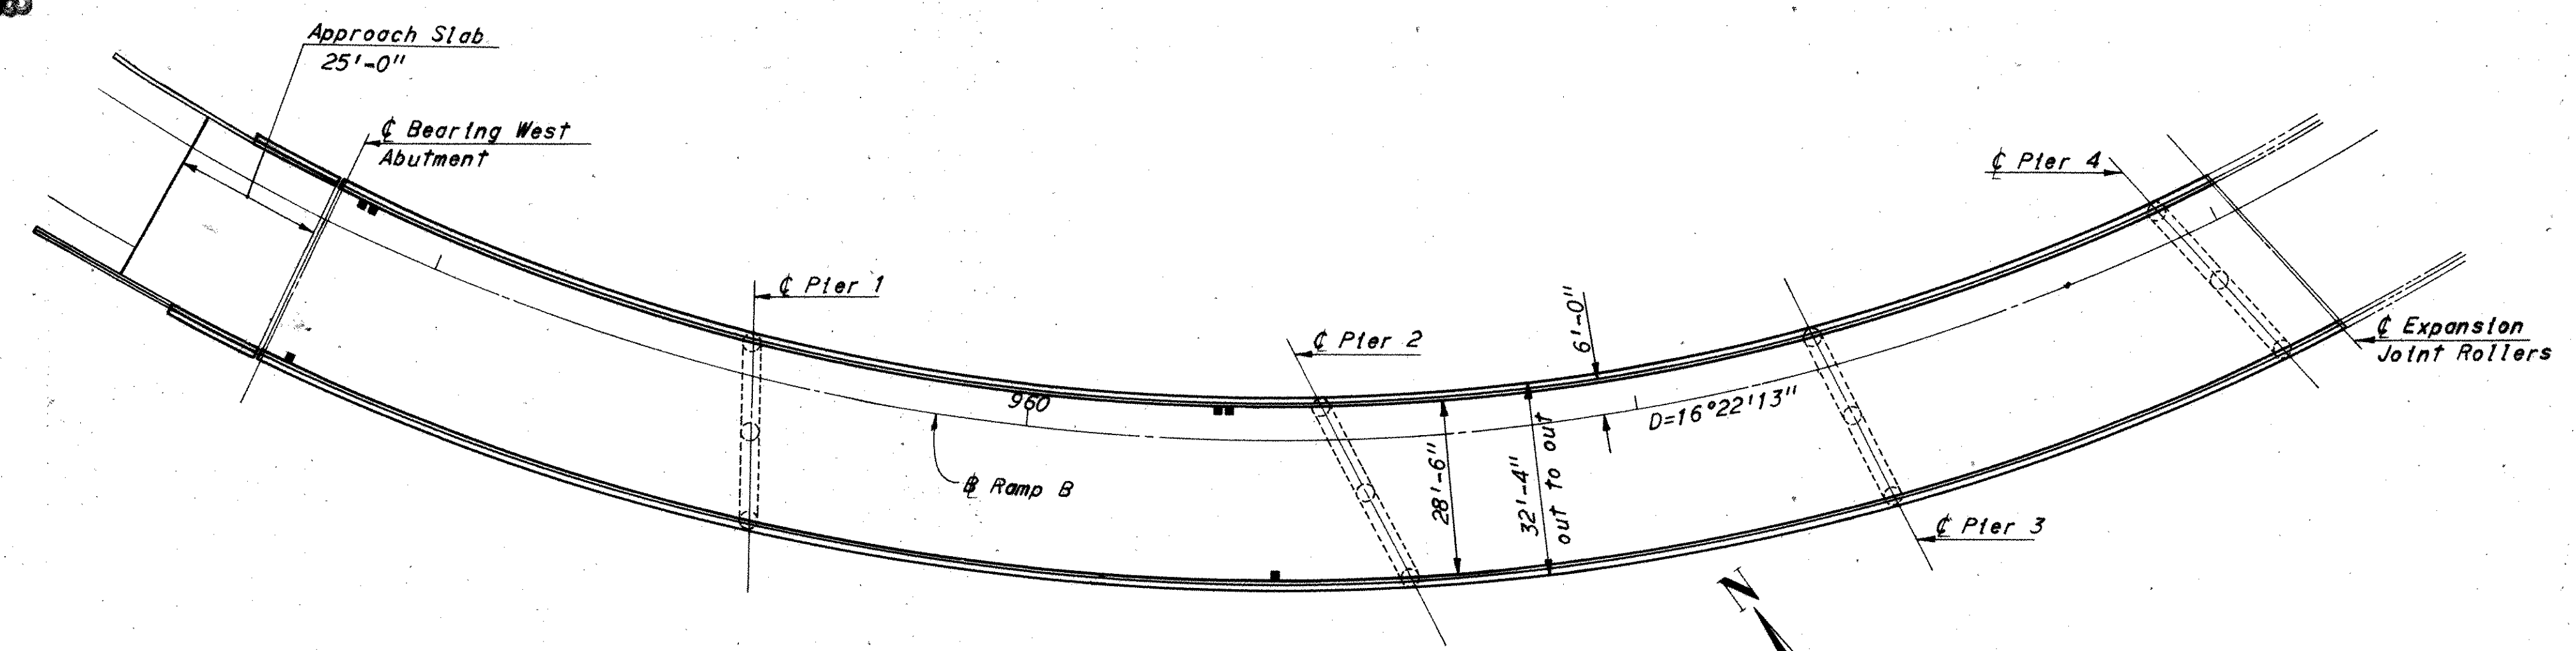


ESTIMATED AVERAGE PAY LENGTHS FOR PILING

West Abutment	70'
Pier 1	70'
Pier 2	70'
Pier 3	70'
Pier 4	70'

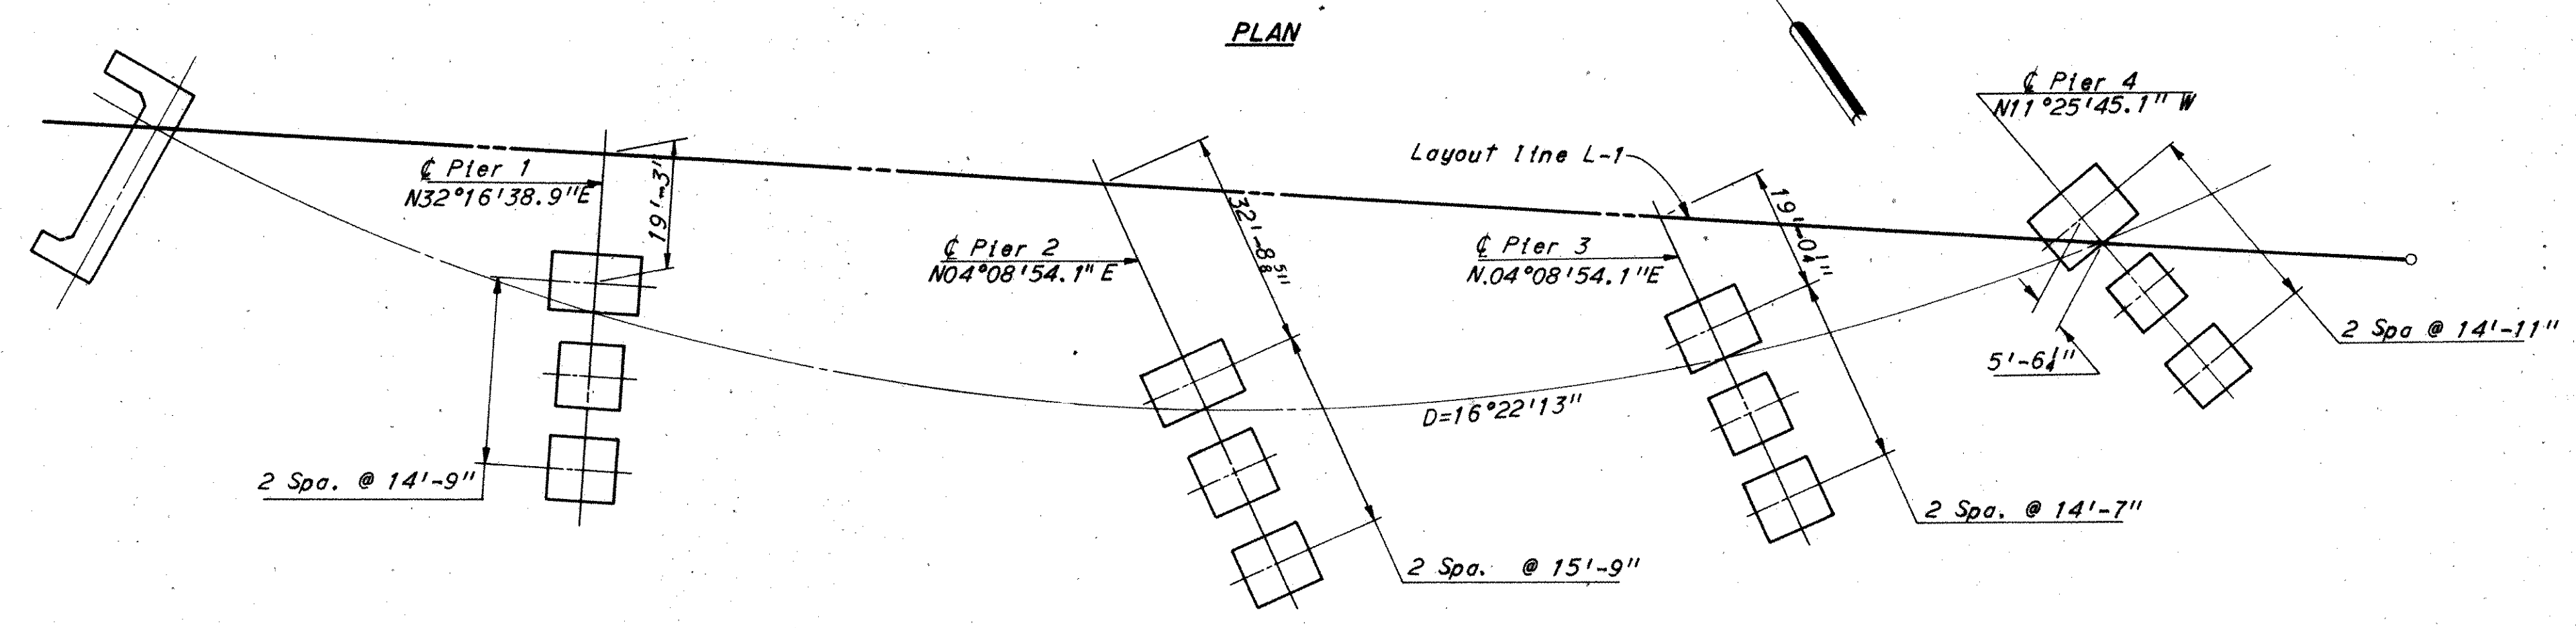

FOOTING LAYOUT

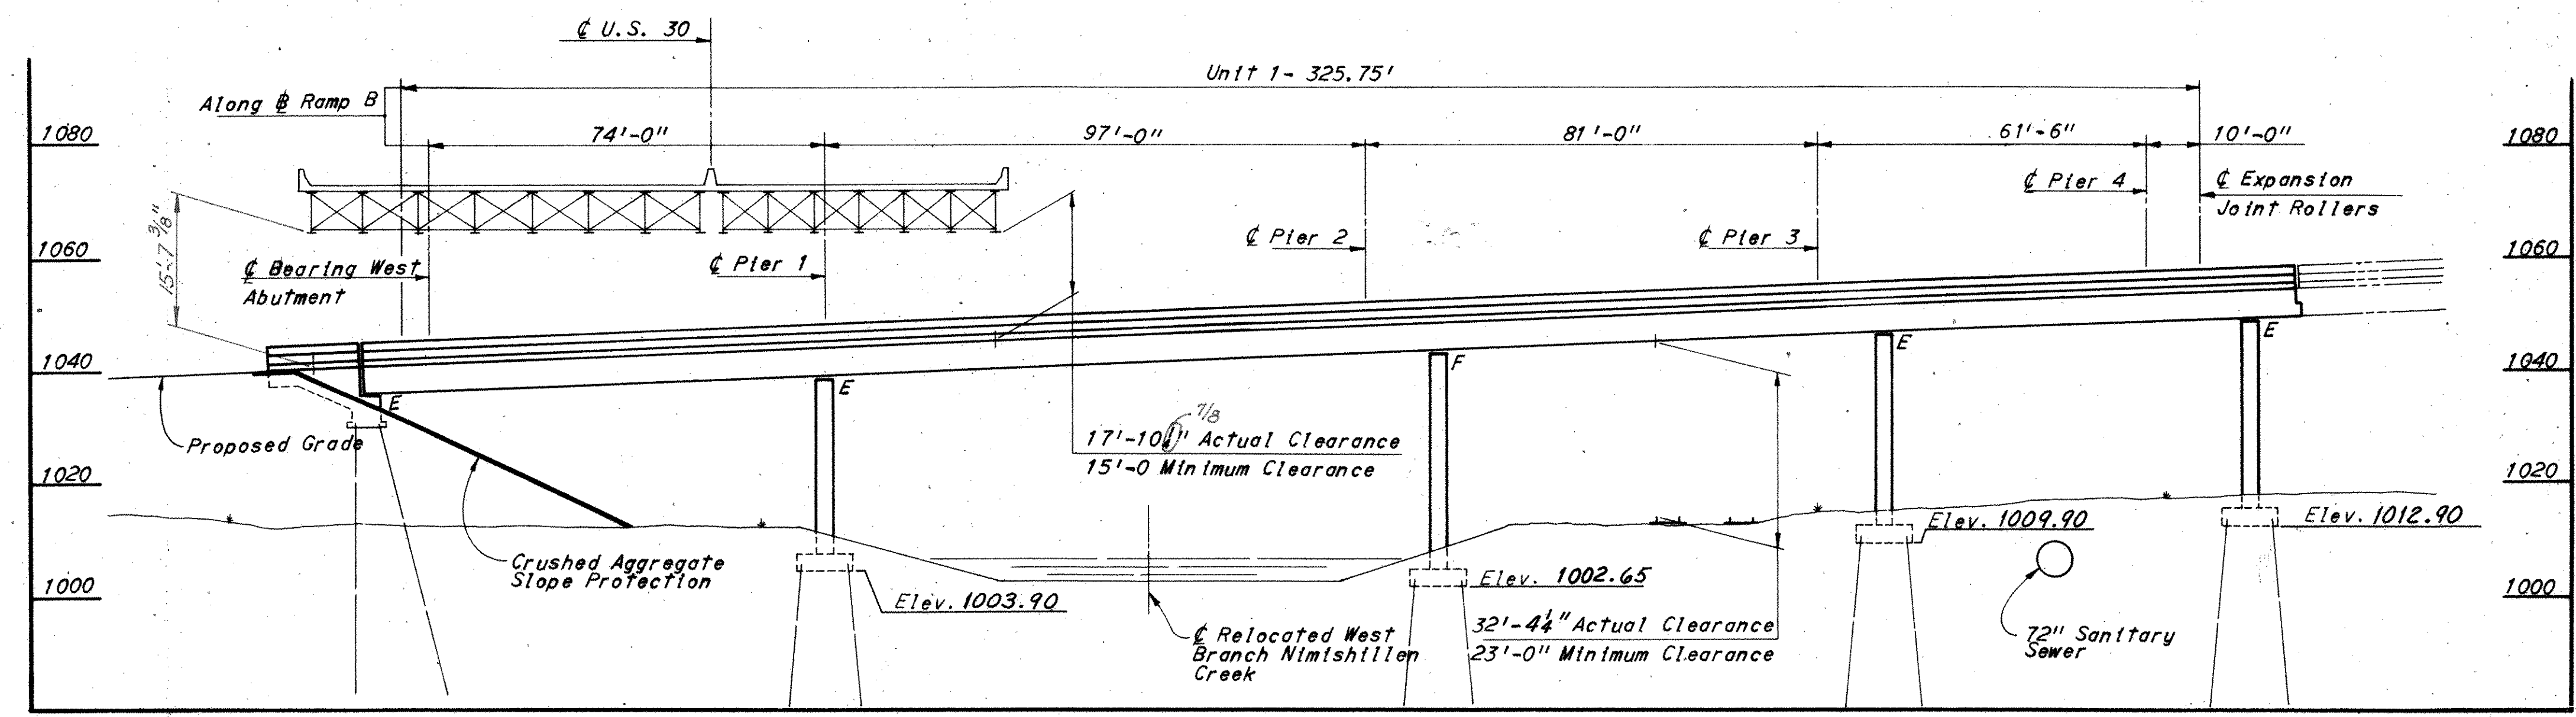

DEVELOPED ELEVATION

Notes:

For Profile grades see Sheet 2/16

For details of Piers 1, 2, 3, and 4 see Sheet 7/16

For details of West Abutment see Sheet 5/16

For Lighting details see Lighting Plans.

Denotes standard scupper.
For Layout data see Sheet 2/16

H.N.T.B. BRIDGE NO. 14 Revised 6-25-75 By RAS

HOWARD, NEEDLES, TAMMEN & BERGENDOFF
CONSULTING ENGINEERS
KANSAS CITY CLEVELAND NEW YORK

3/16

GENERAL PLAN-UNIT I
RAMP B OVER RAMPS C AND G,
I-77 AND PENN. R.R.

BR. NO. STA. 30-1489 STA. 958 + 78.75
SCALE: 1" = 20'-0" STA. 966 + 30.88


RELOCATED U.S. 30

CANTON STARK COUNTY OHIO


DRAWN BY DATE 10-21-69	TRACED DATE	CHECKED BY DATE 6-20-70	REVIEWED DATE 11-20-71	REVISION DATE
---------------------------	----------------	----------------------------	---------------------------	------------------

1668


Backwall elevations are given at this point ($\frac{1}{4}$ " below top of asphalt concrete).

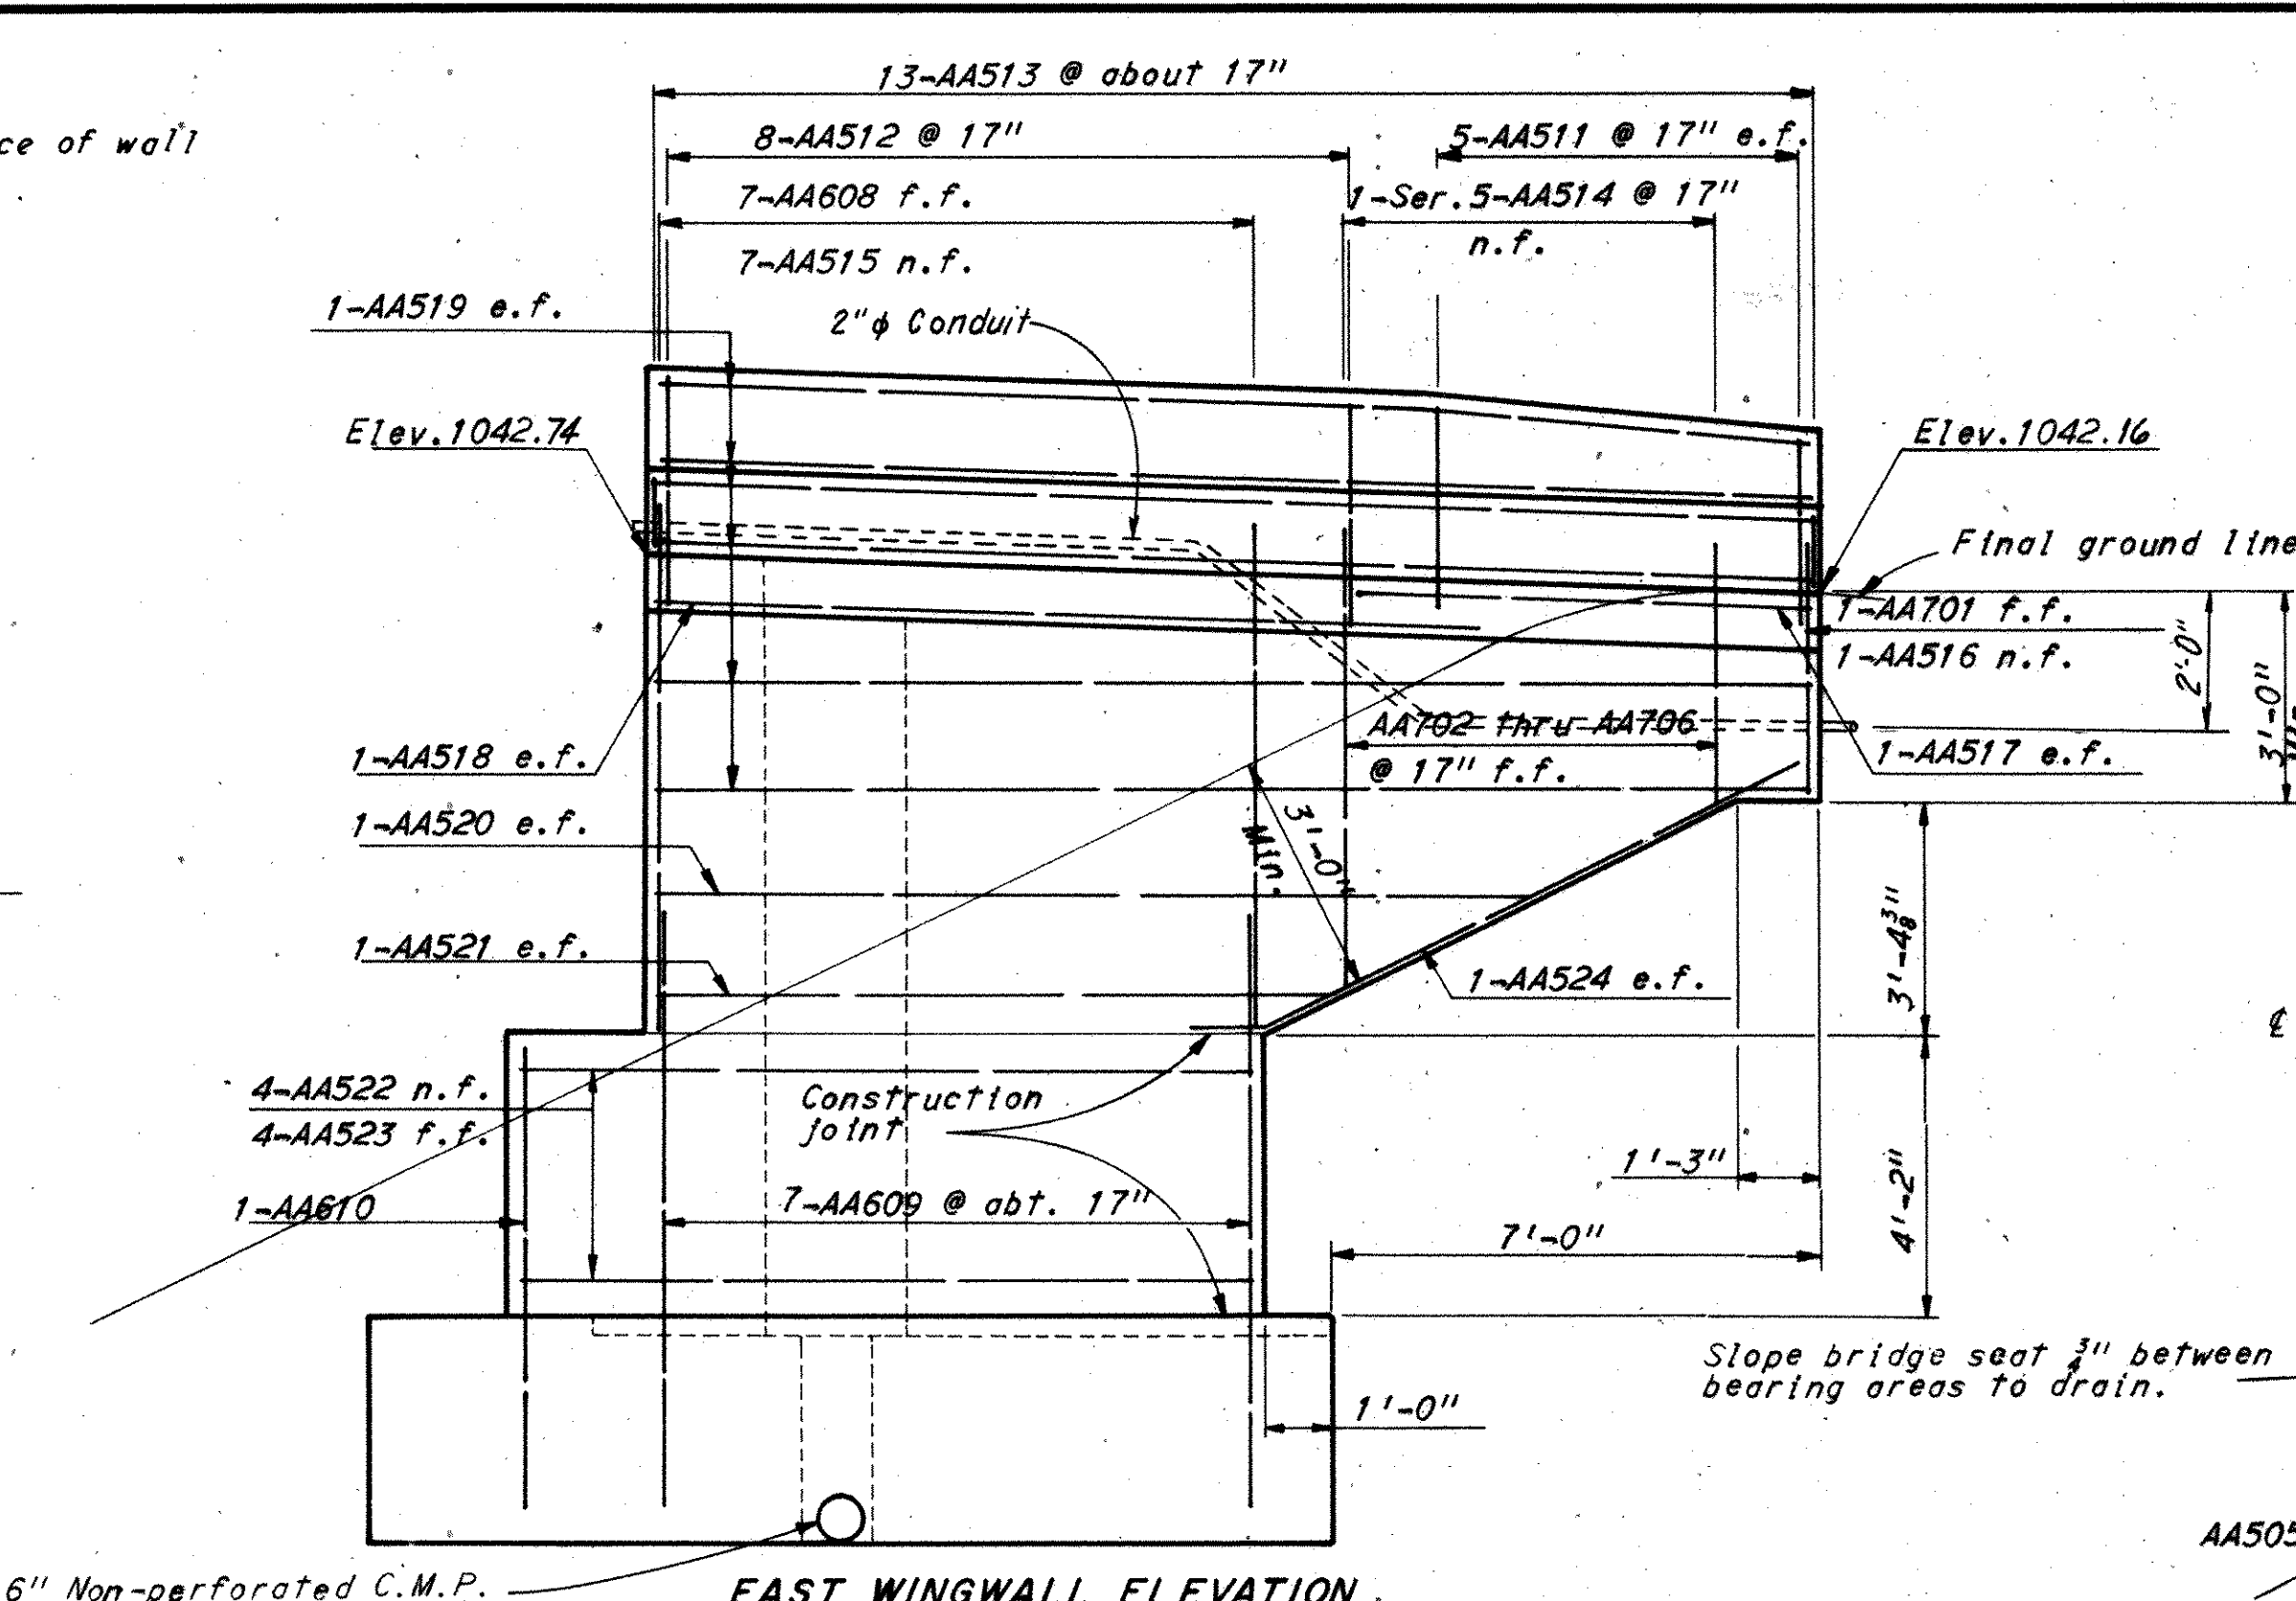

EAST WINGWALL ELEVATION

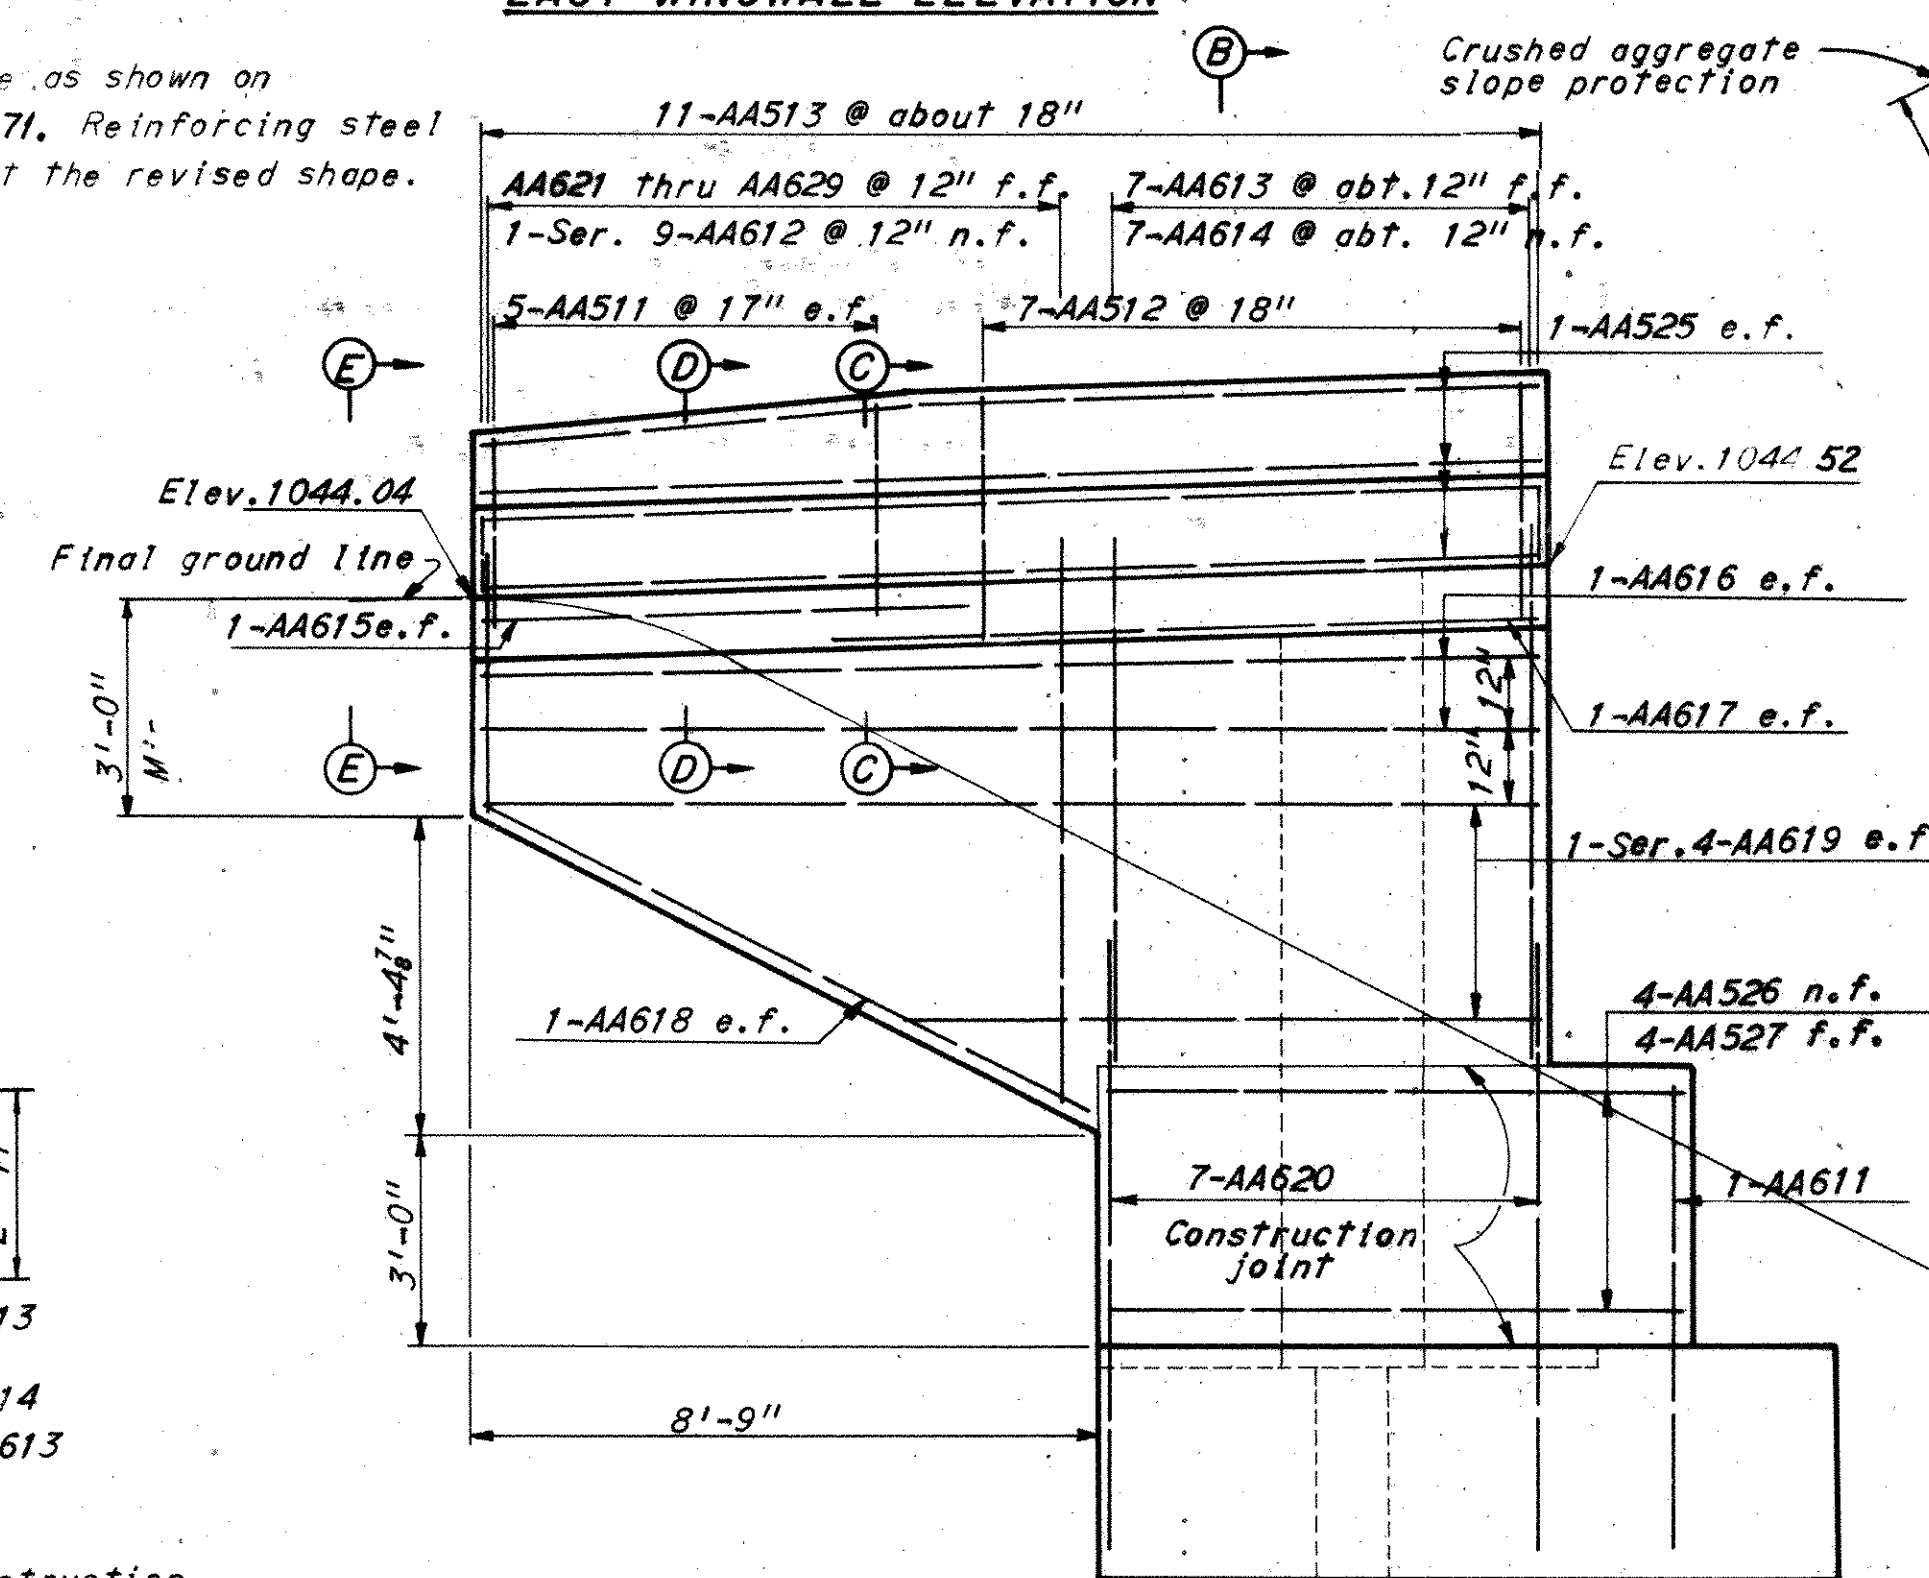


WEST WINGWALL ELEVATION

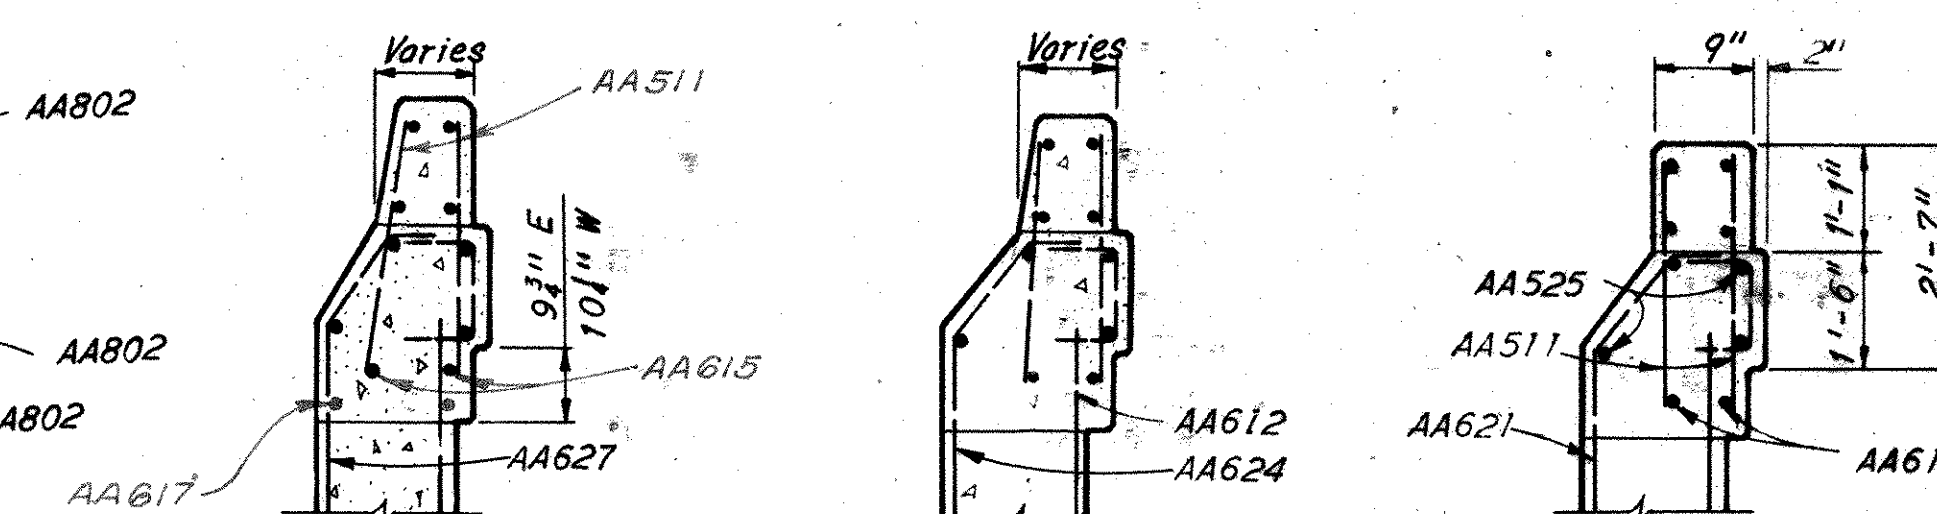


SECTION C-C

SECTION D-D


VIEW E-E

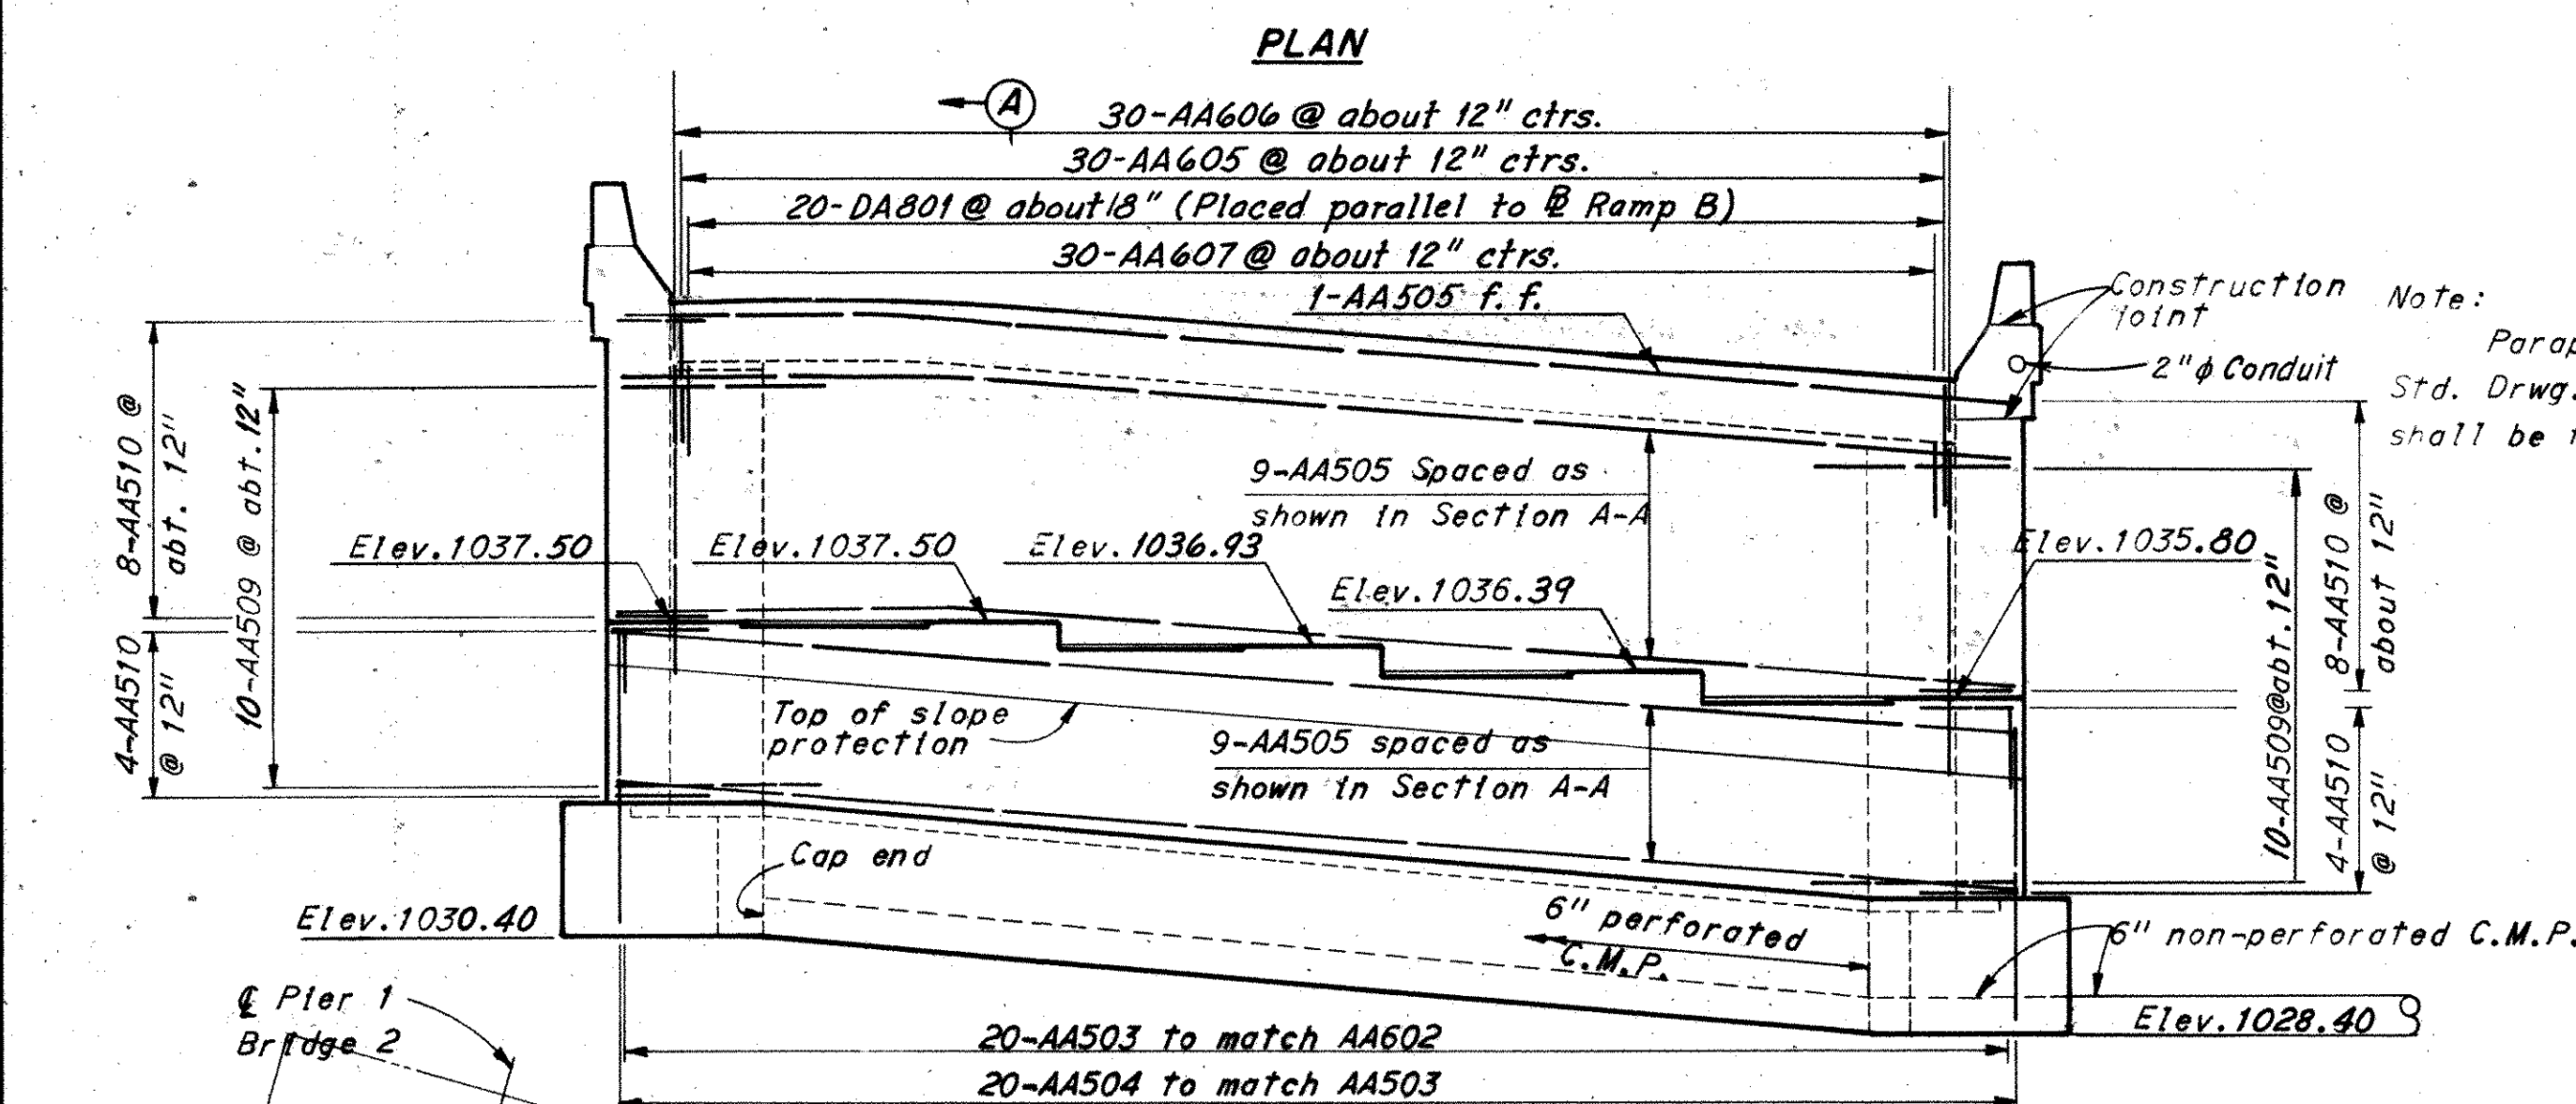

ELEVATION

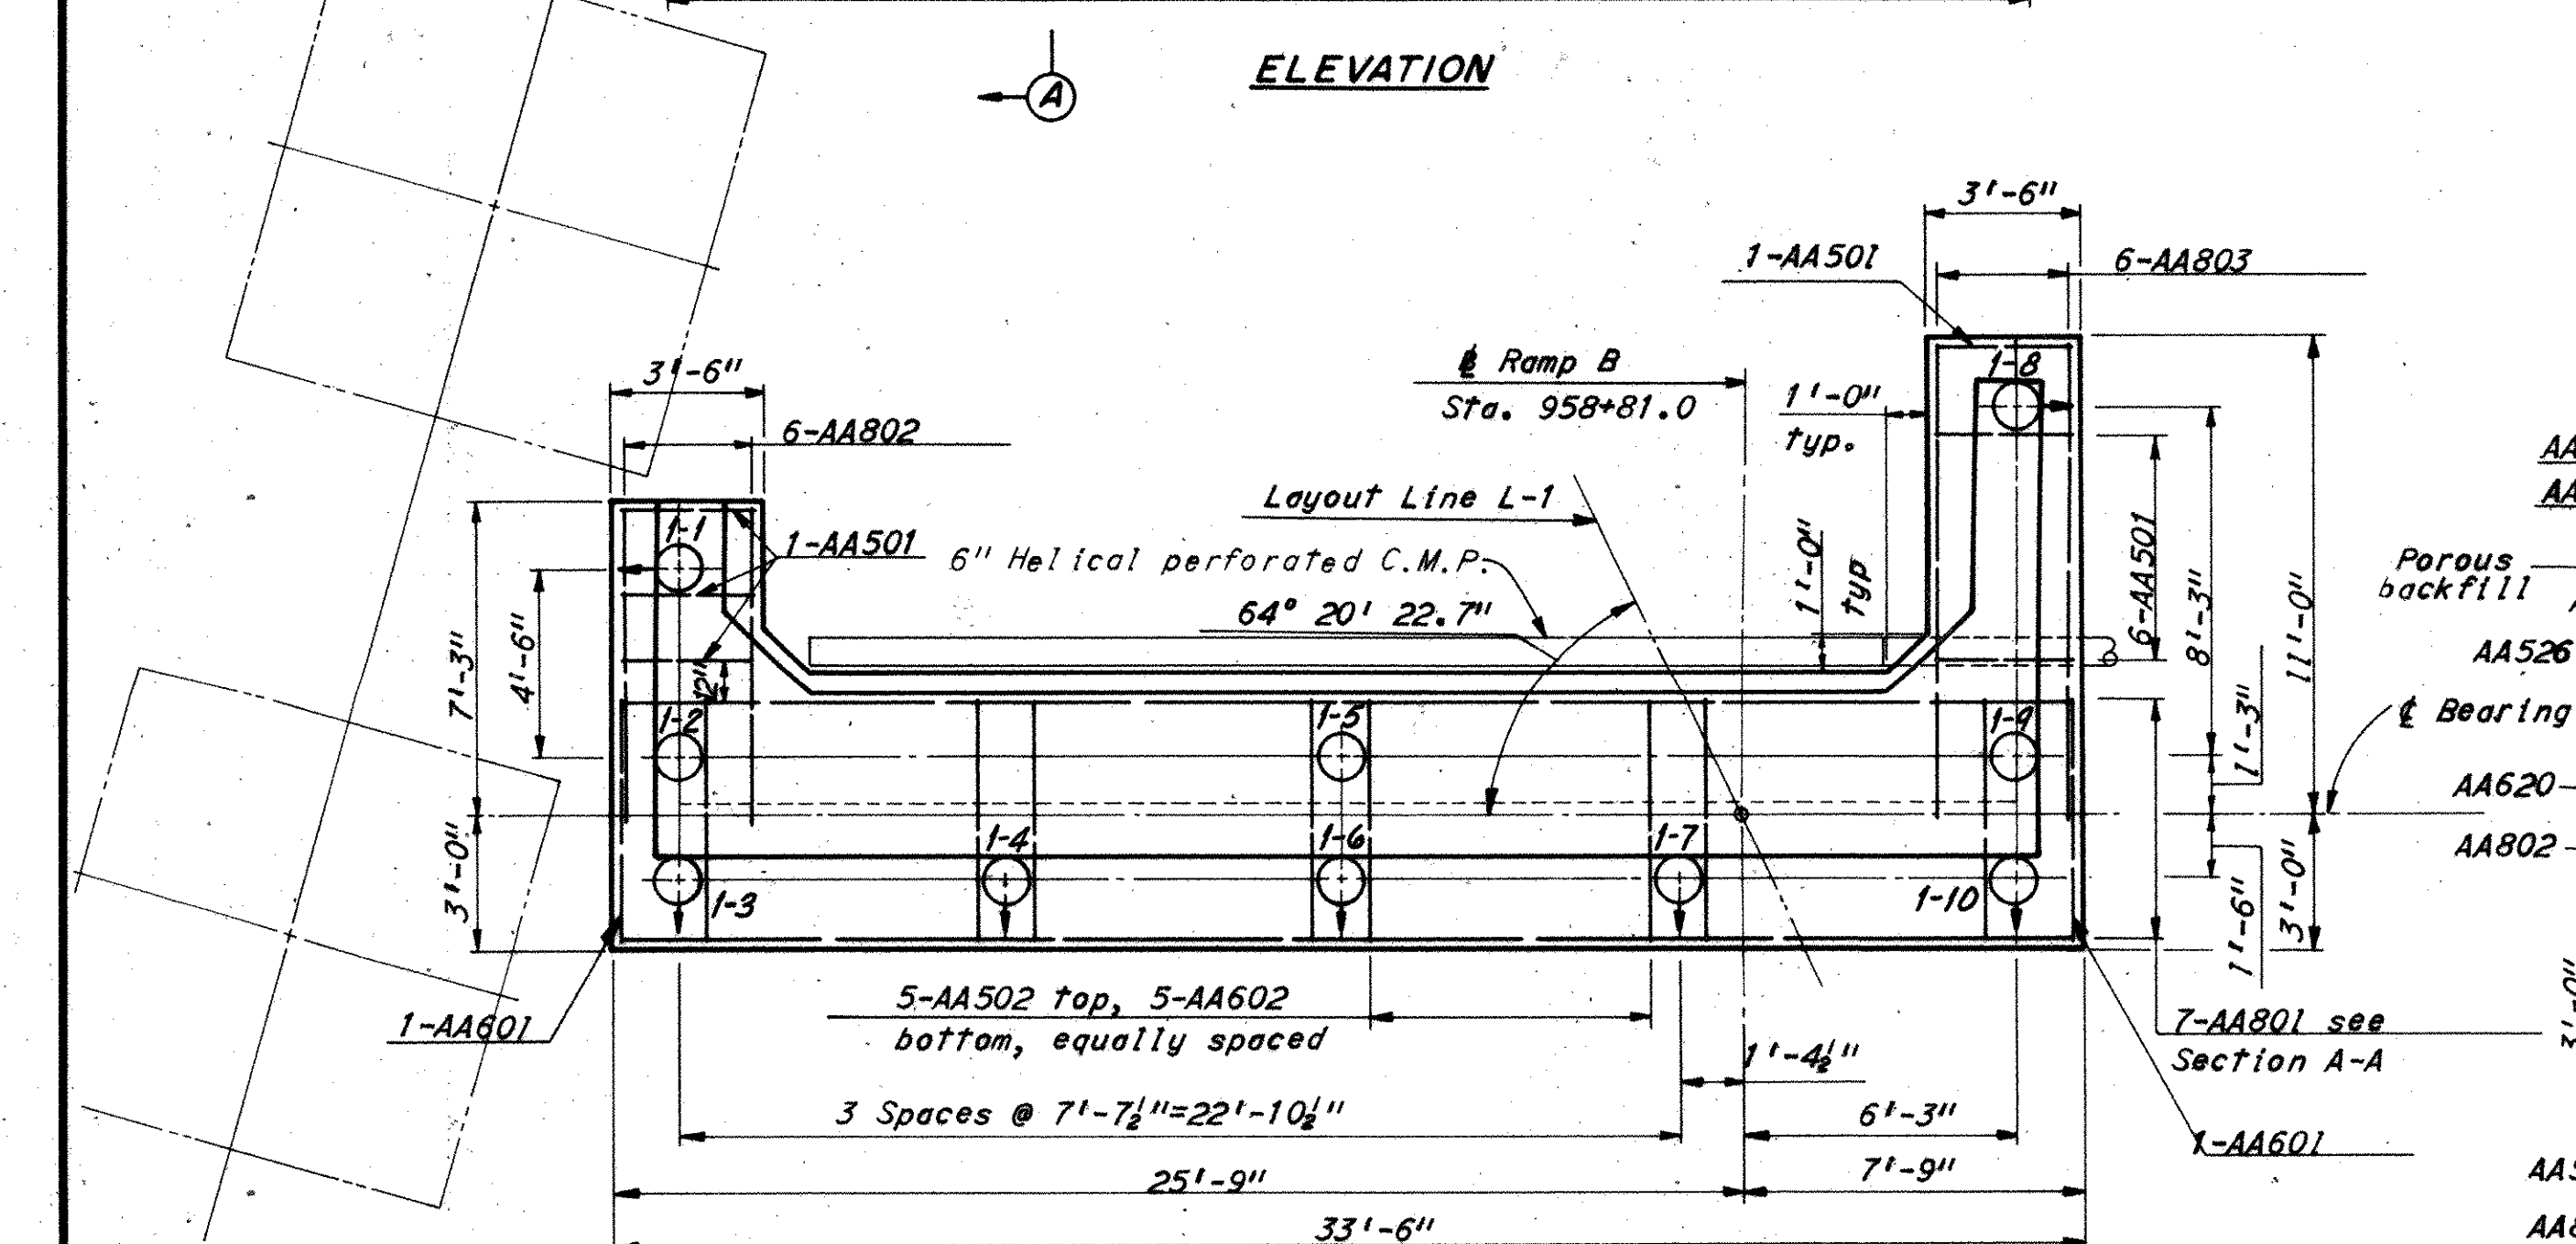

FOOTING PLAN

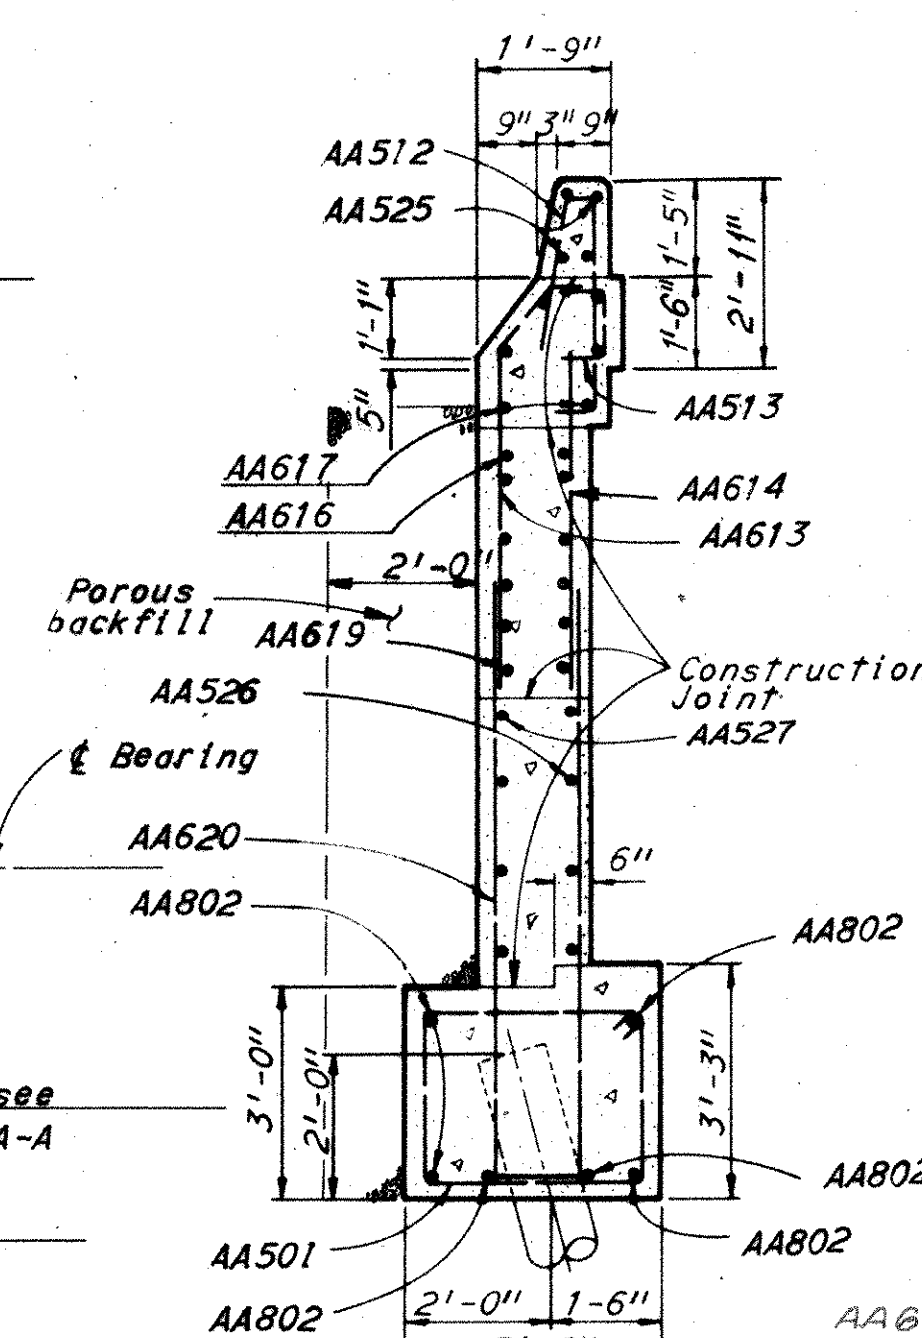

SECTION B-B

H.N.T.B. BRIDGE NO. 14

HOWARD, NEEDLES, TAMMEN & BERGENDOFF 5/16
CONSULTING ENGINEERS
KANSAS CITY CLEVELAND NEW YORK

WEST ABUTMENT

RAMP B OVER RAMPS C AND G,
I-77 AND PENN. R.R.

BR. NO. STA. 30+489
SCALE: 1/4" = 1'-0"

RELOCATED U.S. 30

CANTON STARK COUNTY OHIO


DRAWN <i>QW.B</i>	TRACED	CHECKED <i>MAG</i>	REVIEWED <i>MJK</i>	REVISED
DATE <i>4-10-70</i>	DATE	DATE <i>6-23-70</i>	DATE <i>4-10-70</i>	

Revised 4-28-77


SEP 14 1980

FED. ROAD DIV. NO.	STATE	FEDERAL AID PROJECT NO.	TYPE FUNDS	329 389
2	OHIO			


STARK COUNTY
STA-30-14.12
STA-77-9.22

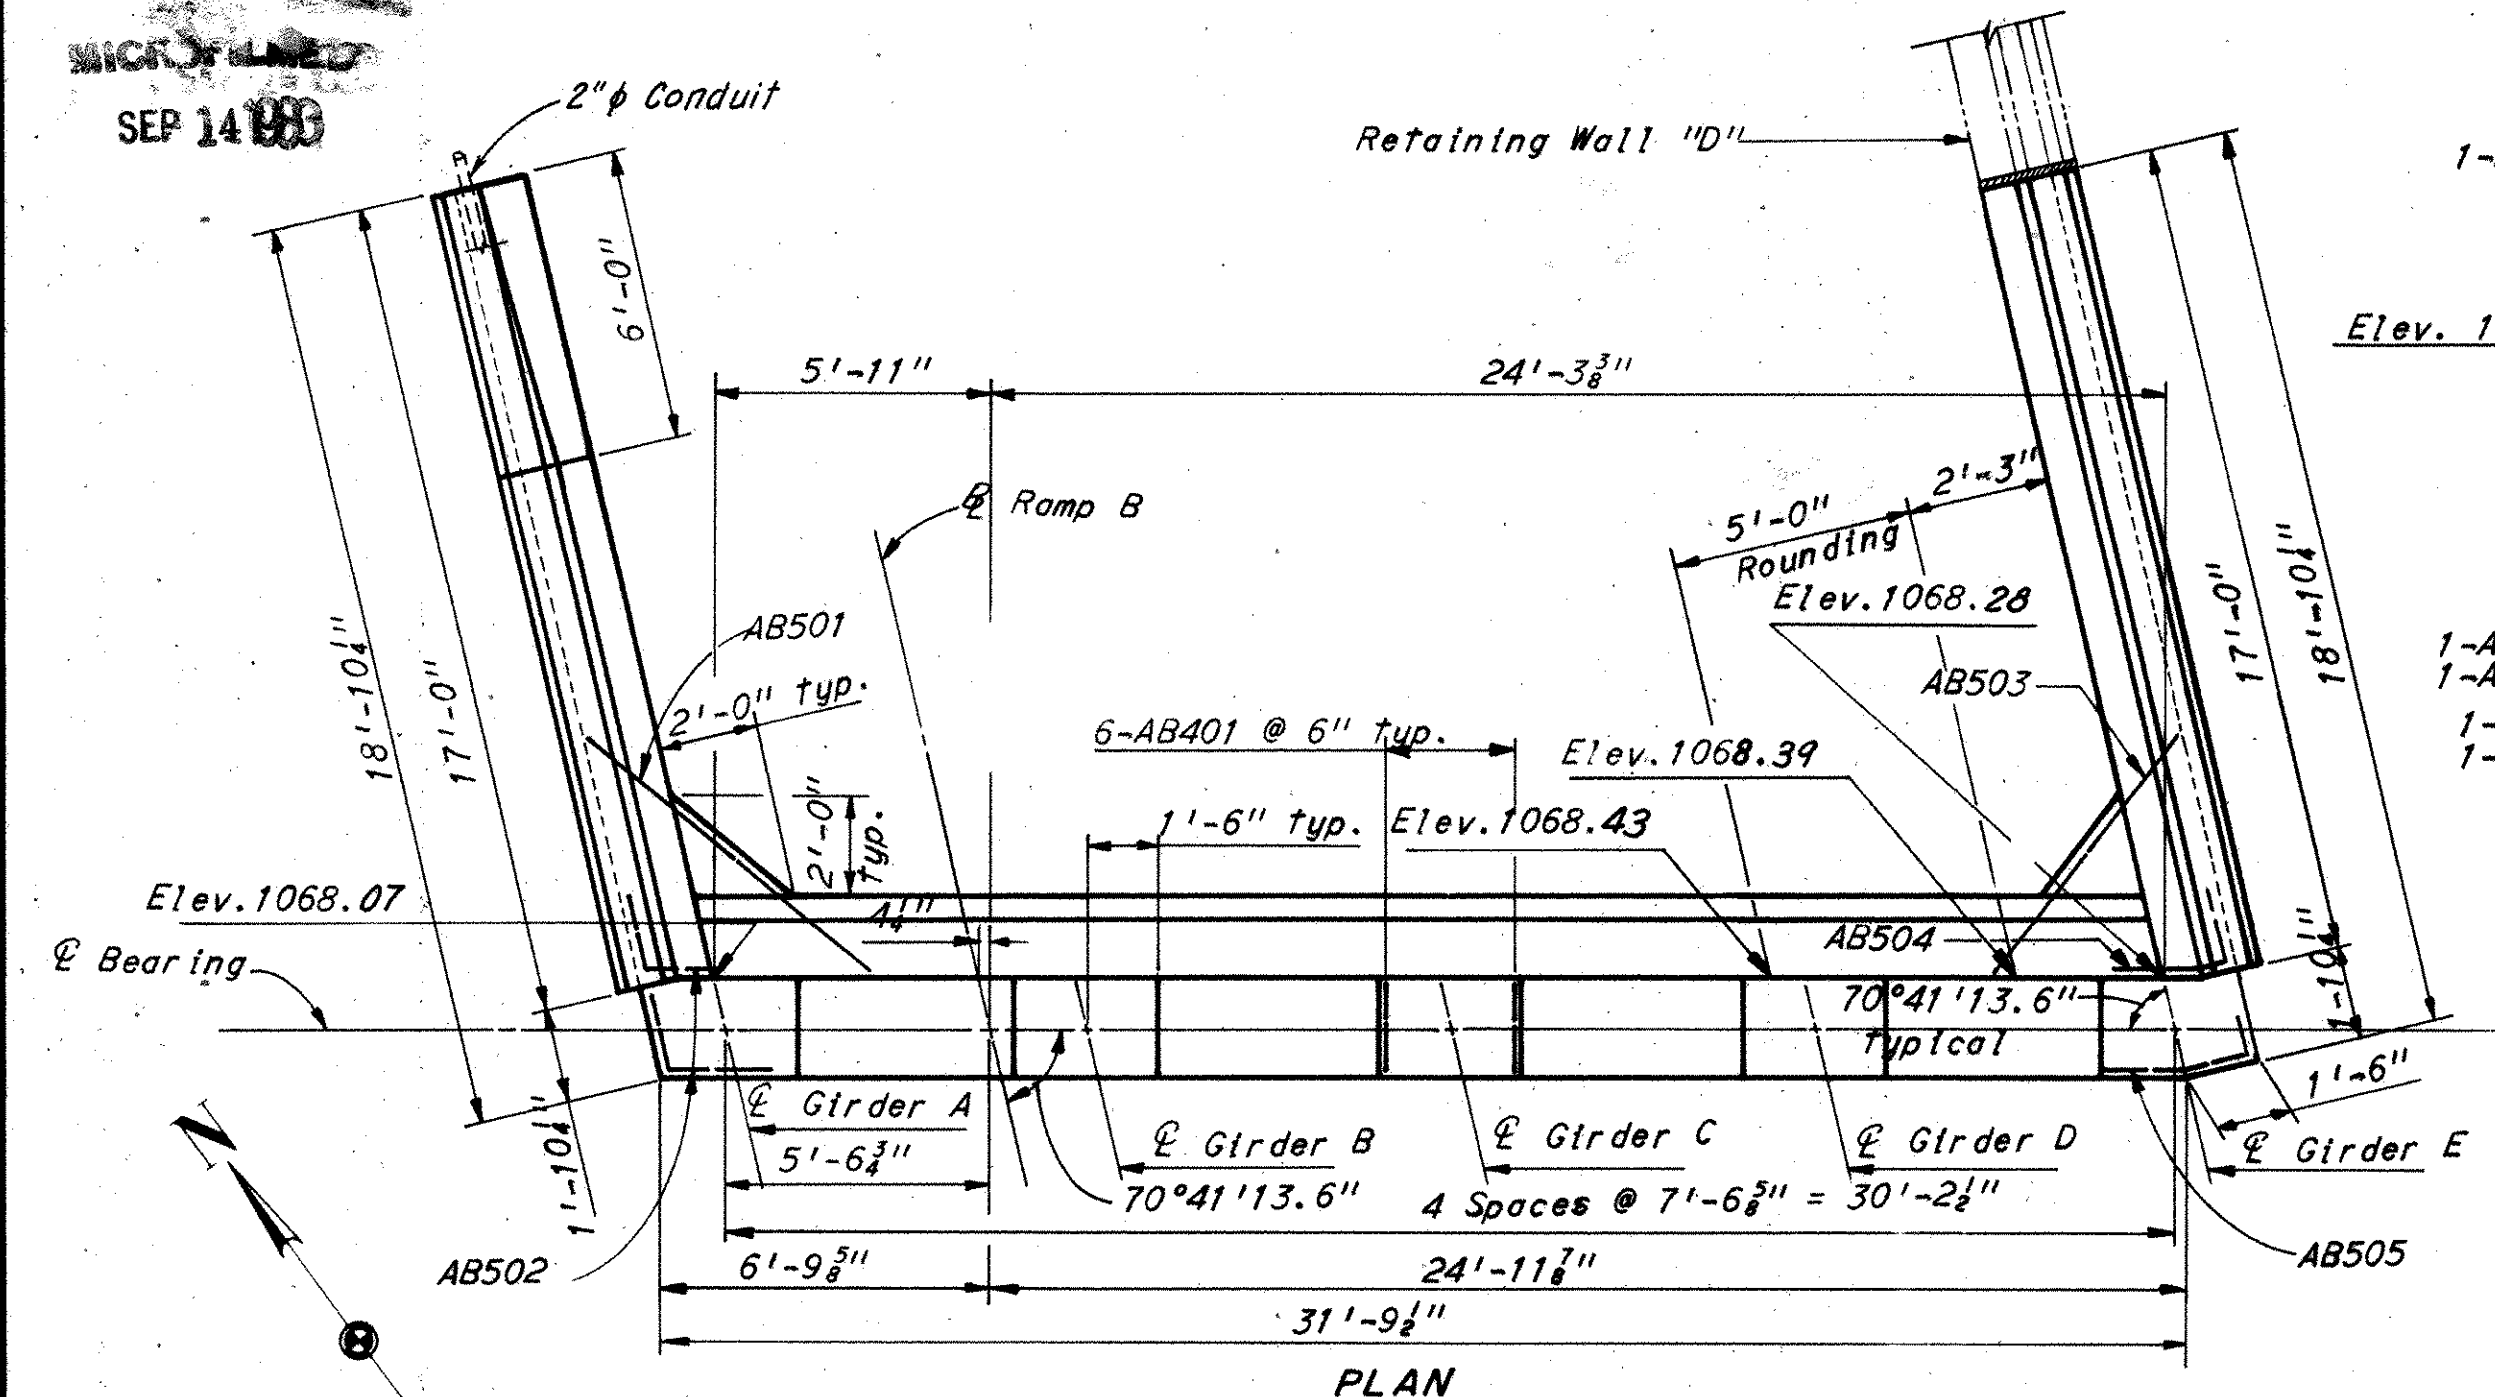


PLAN

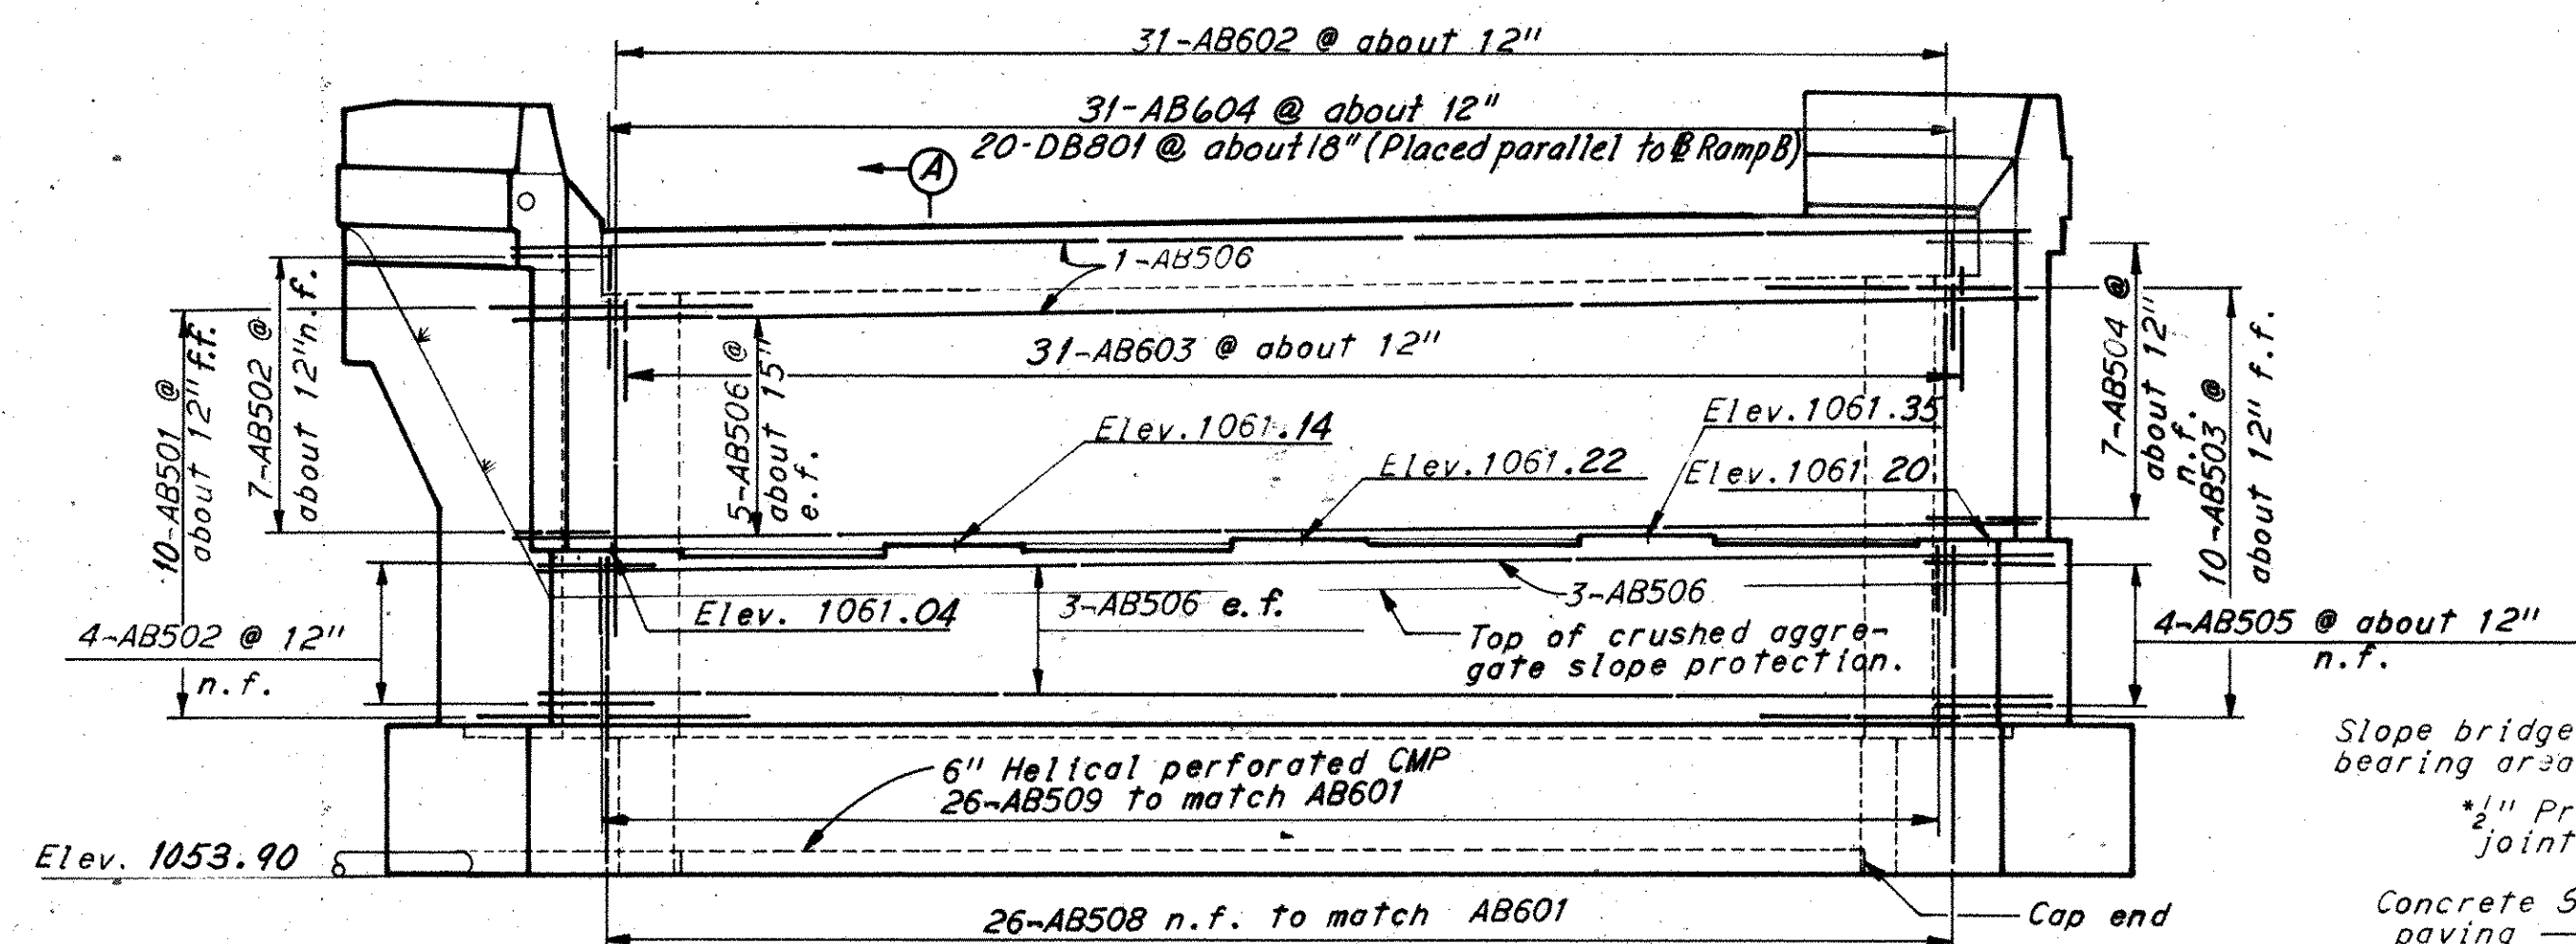

ELEVATION

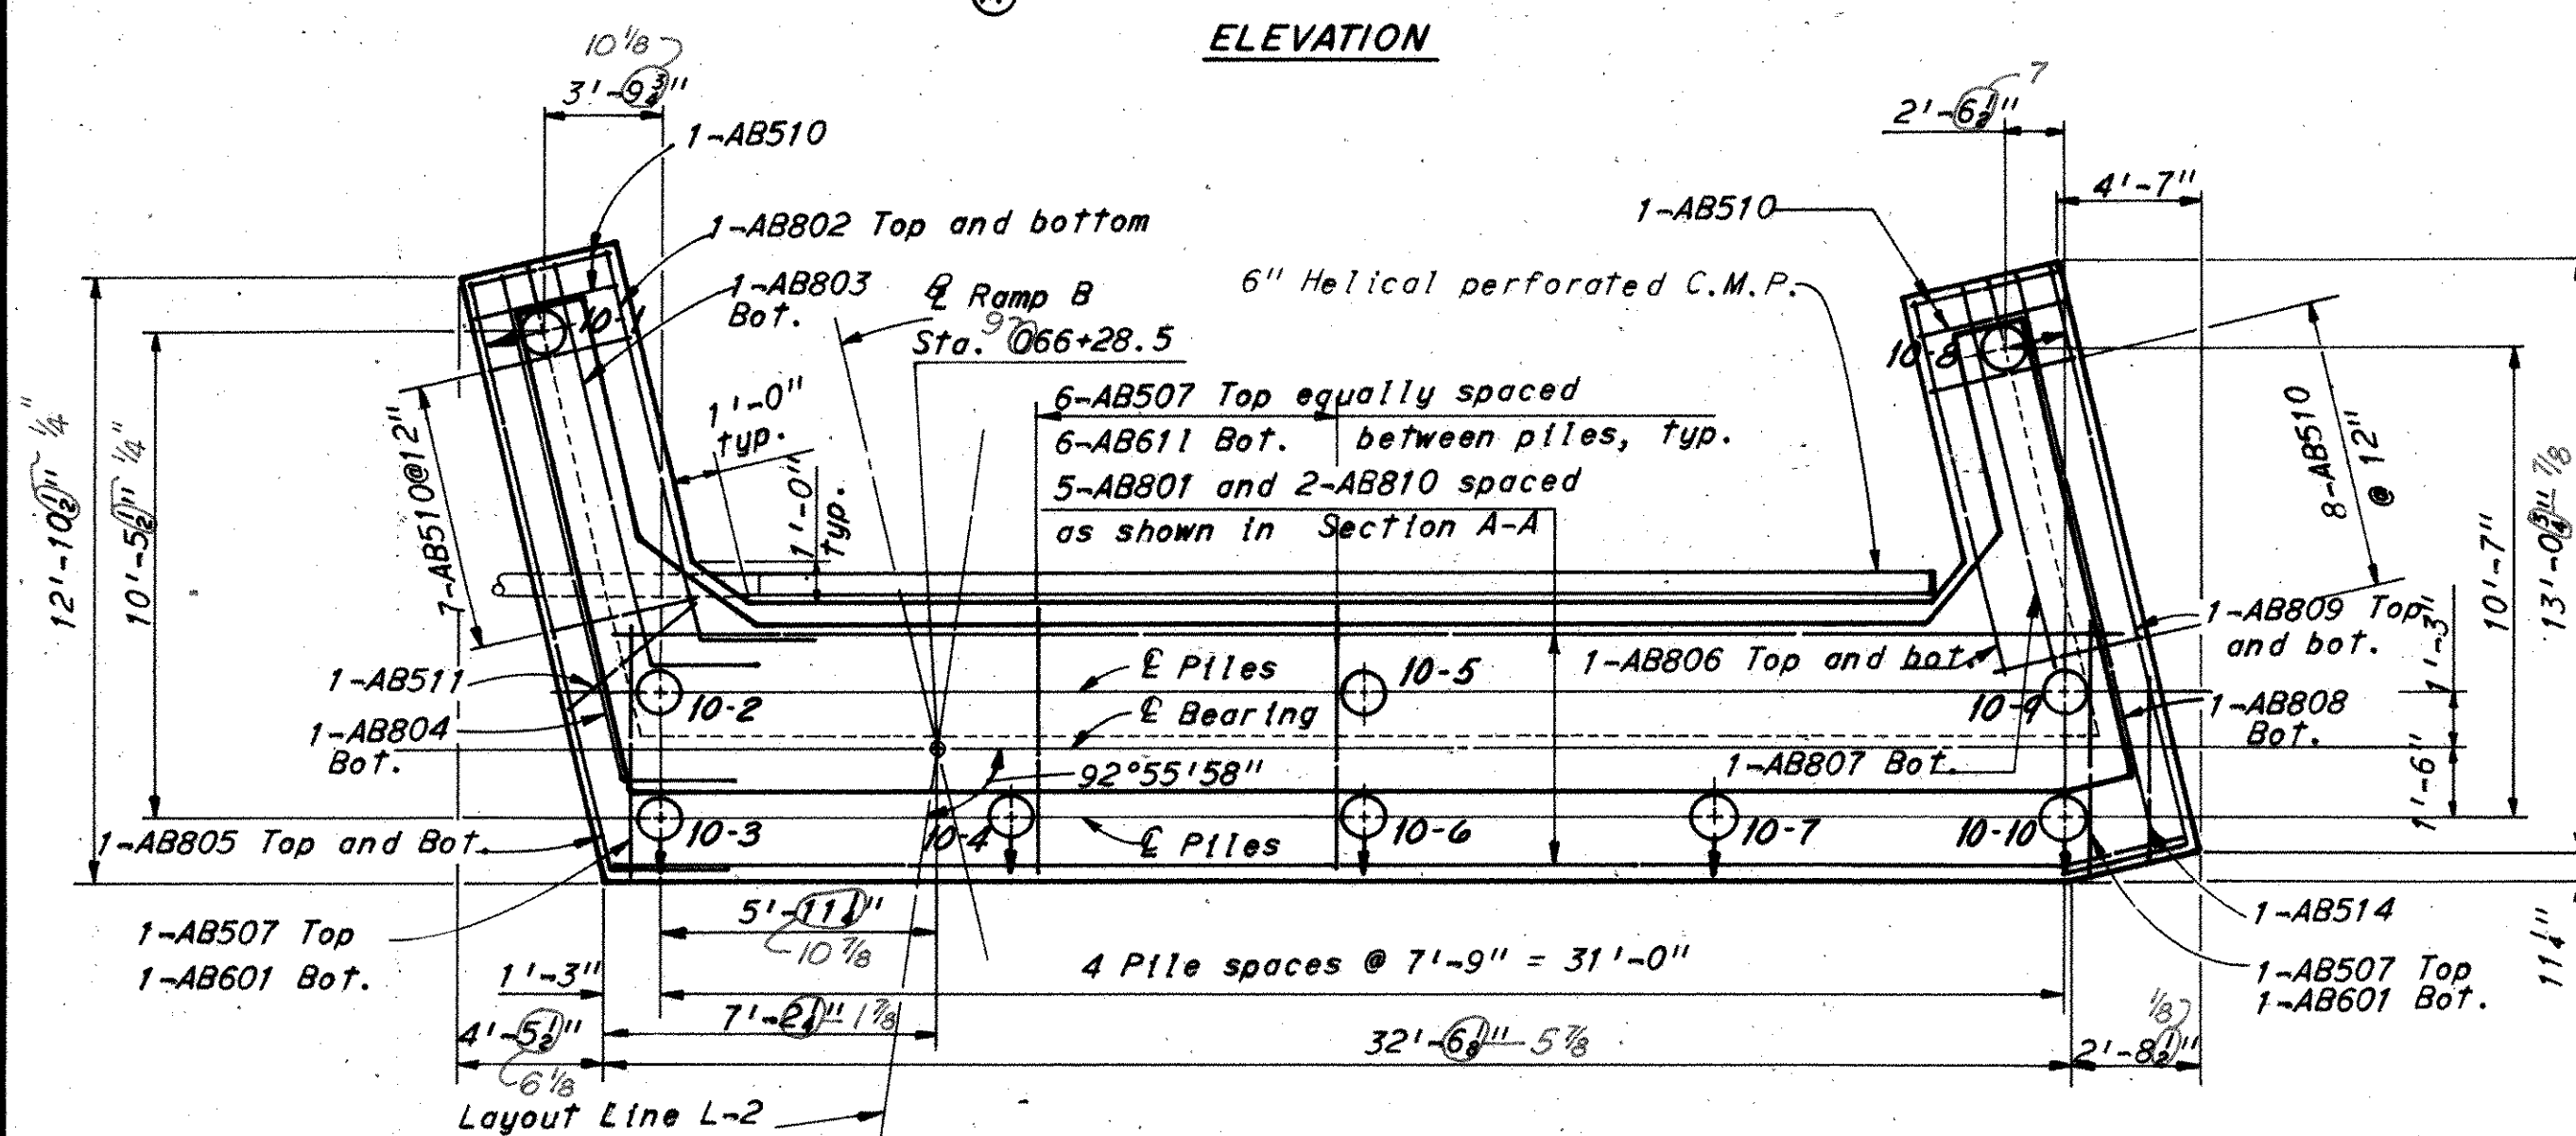


FOOTING PLAN

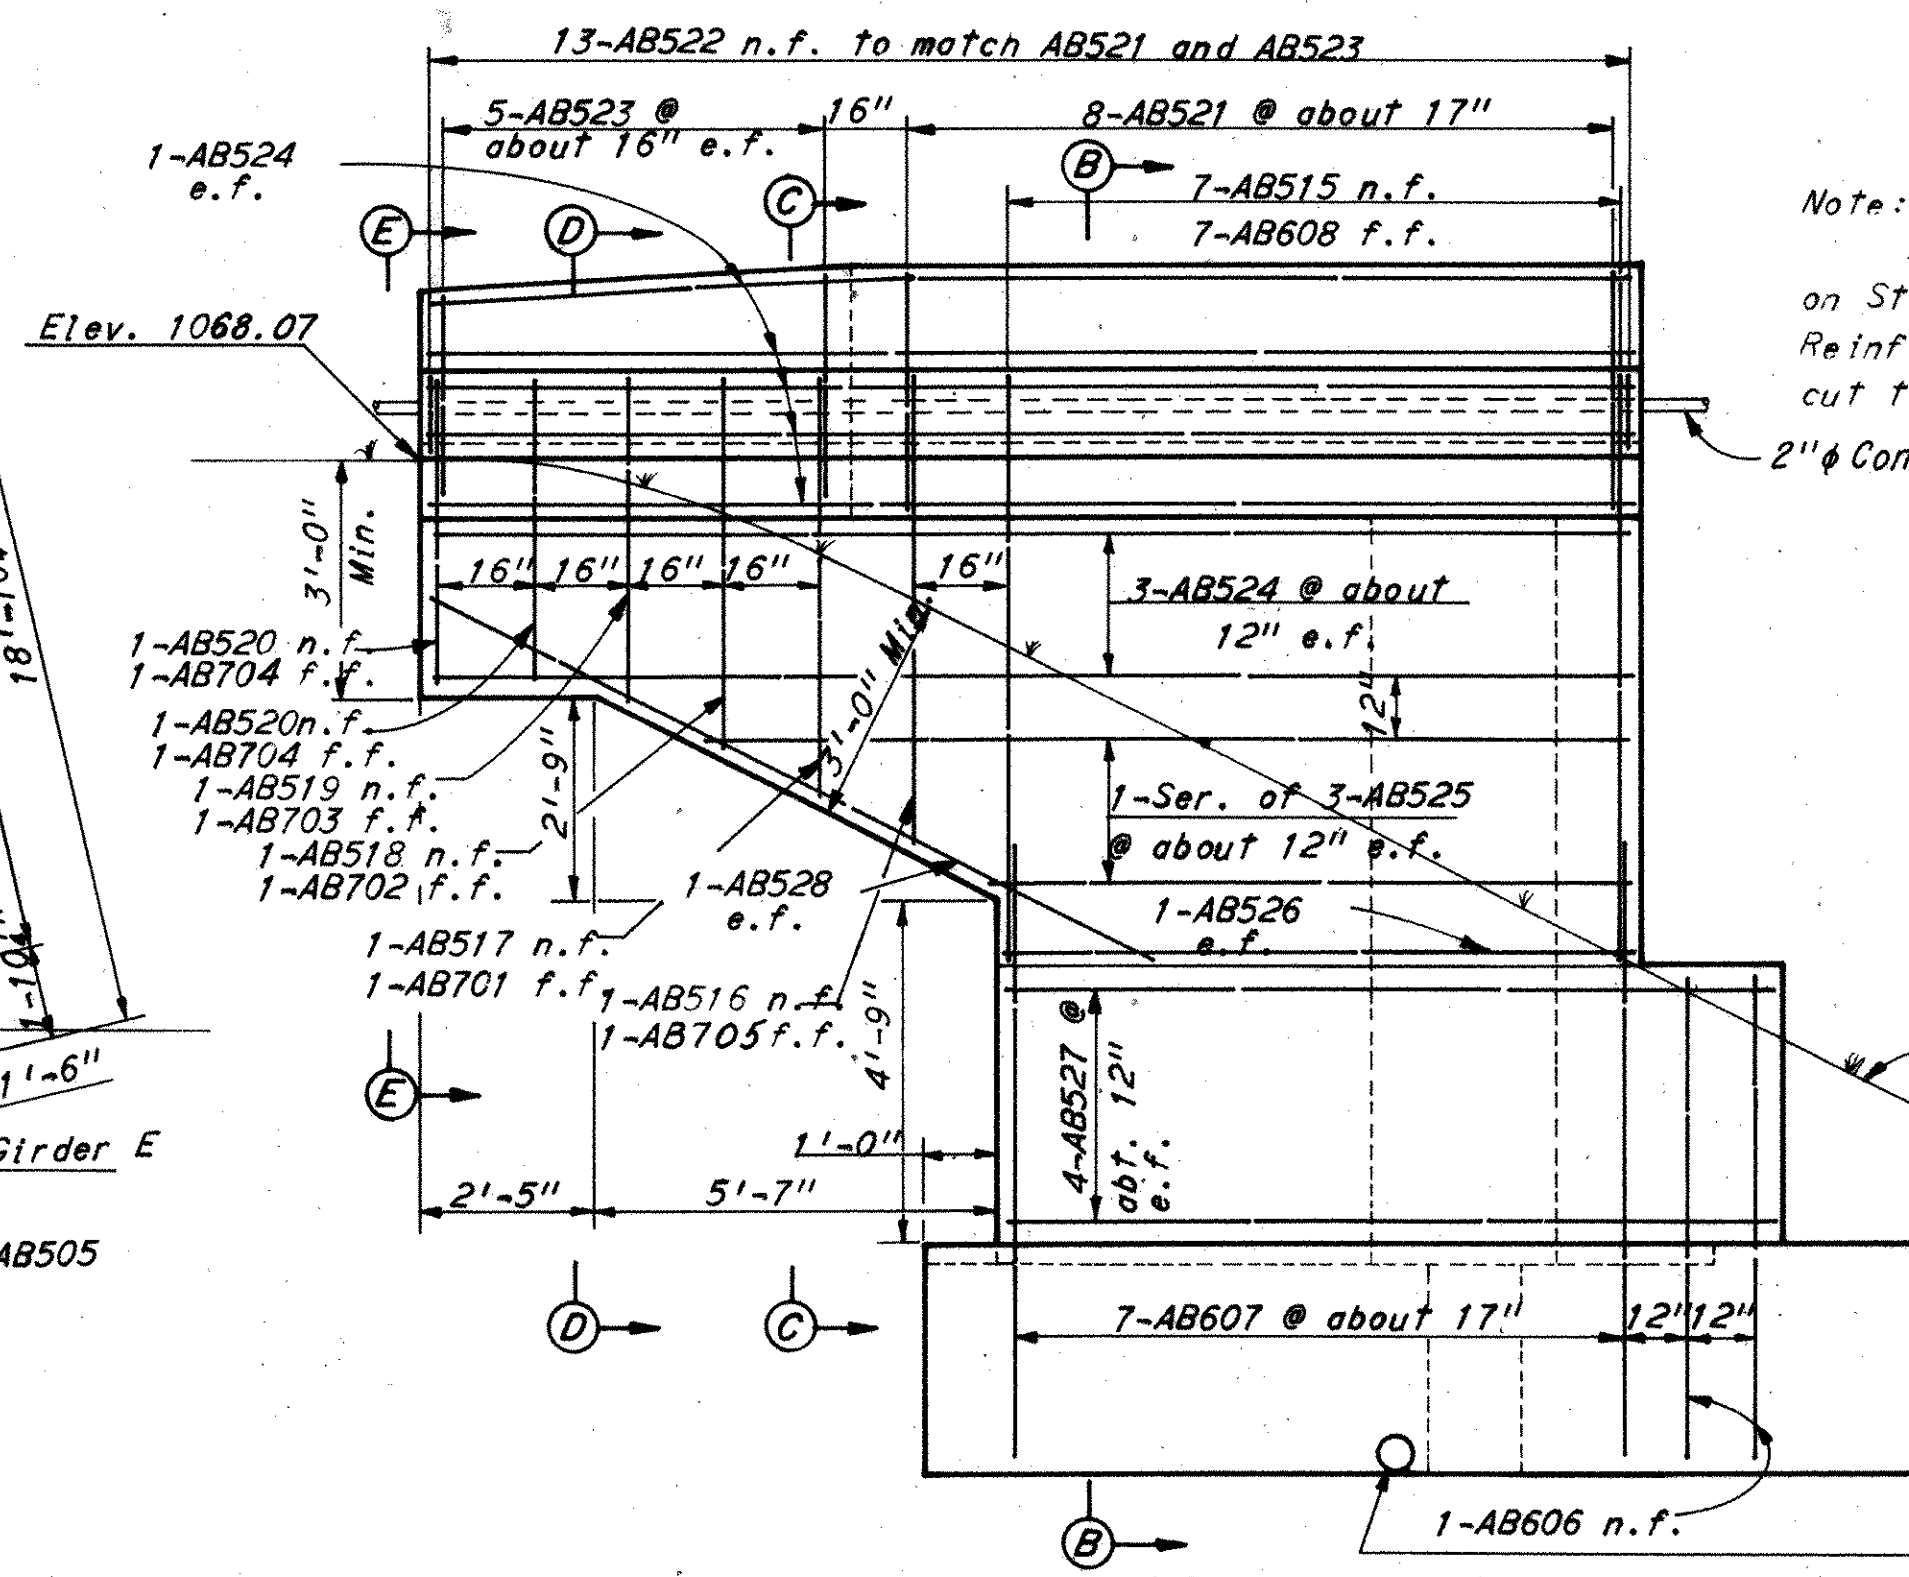









NORTH WINGWALL ELEVATION

Backwall elevations are given at this point (4" below top of asphalt concrete).

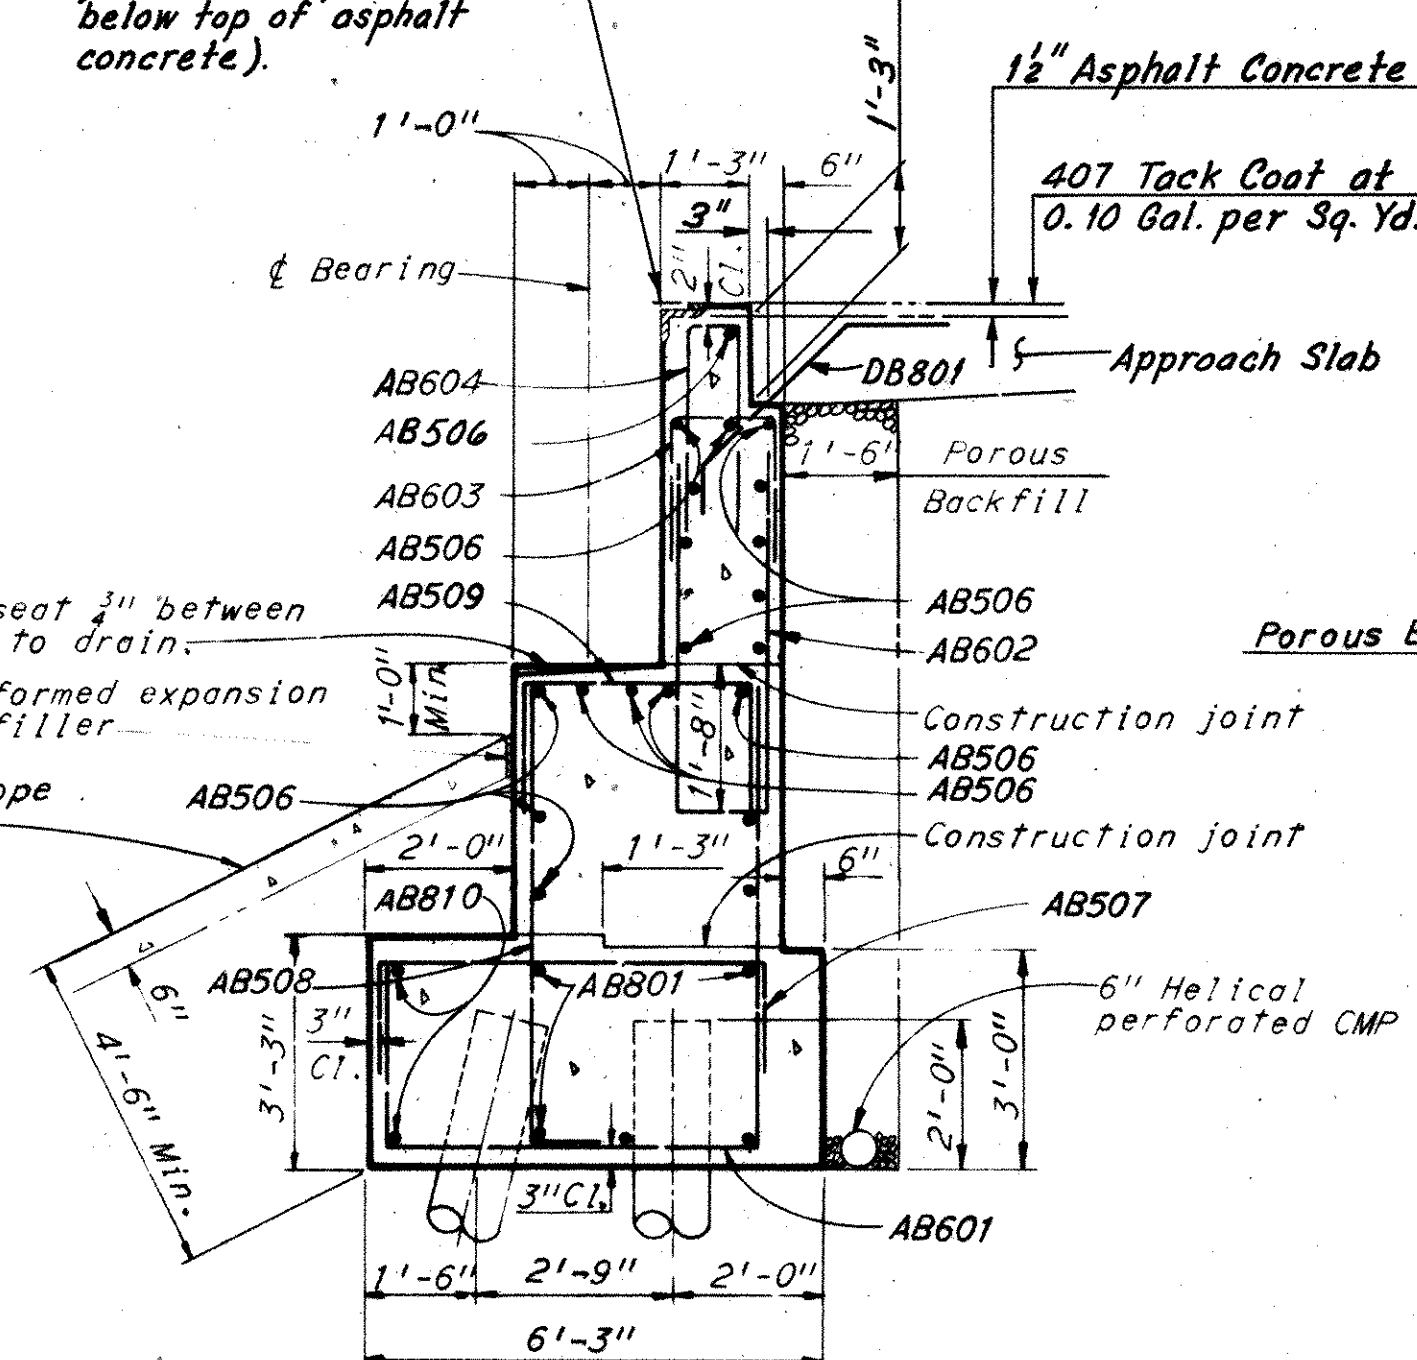


STARK COUNTY
STA-30-14.12
STA-77-9.22

NOTE: The reinf. bars in the top of the cap, Pier 2, shown near & Pier, shall be placed 4" off of the centerline.

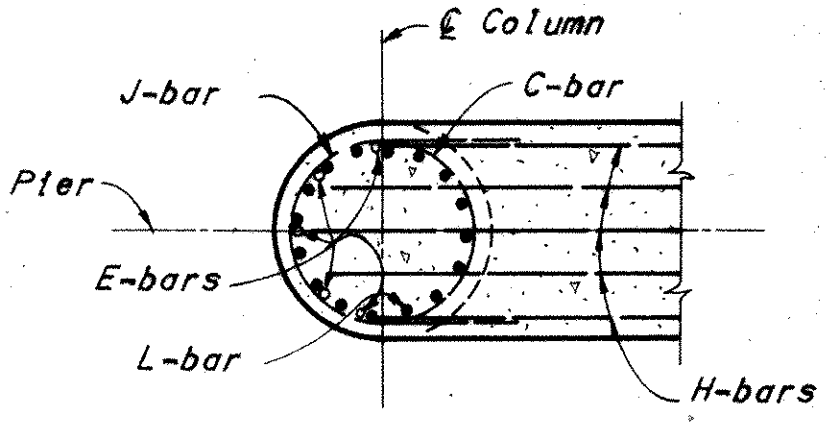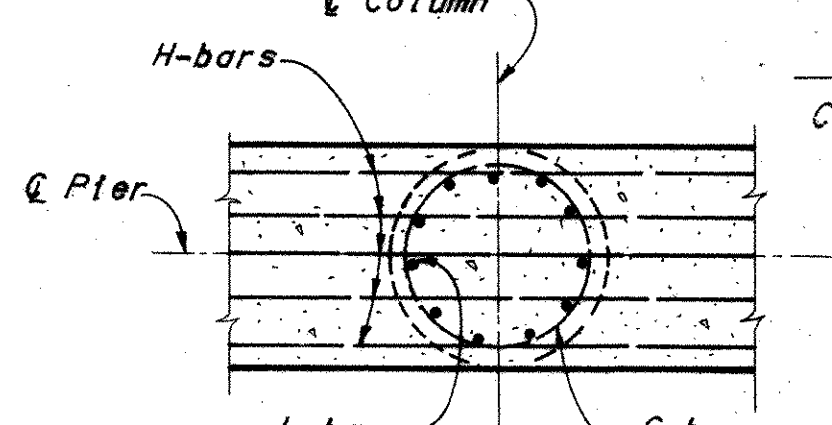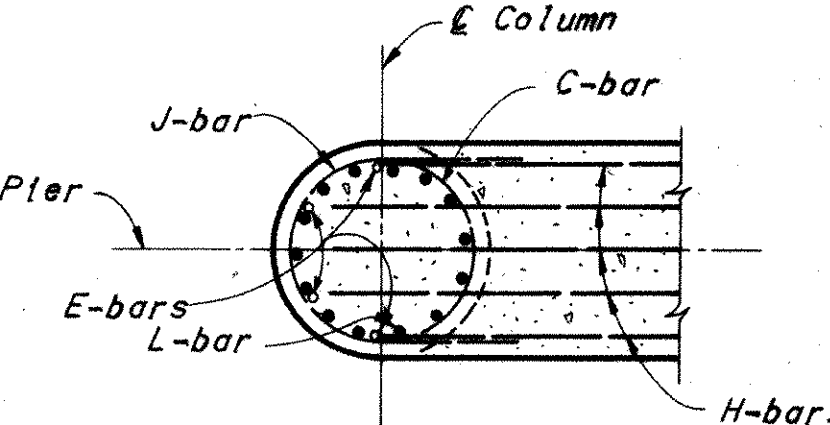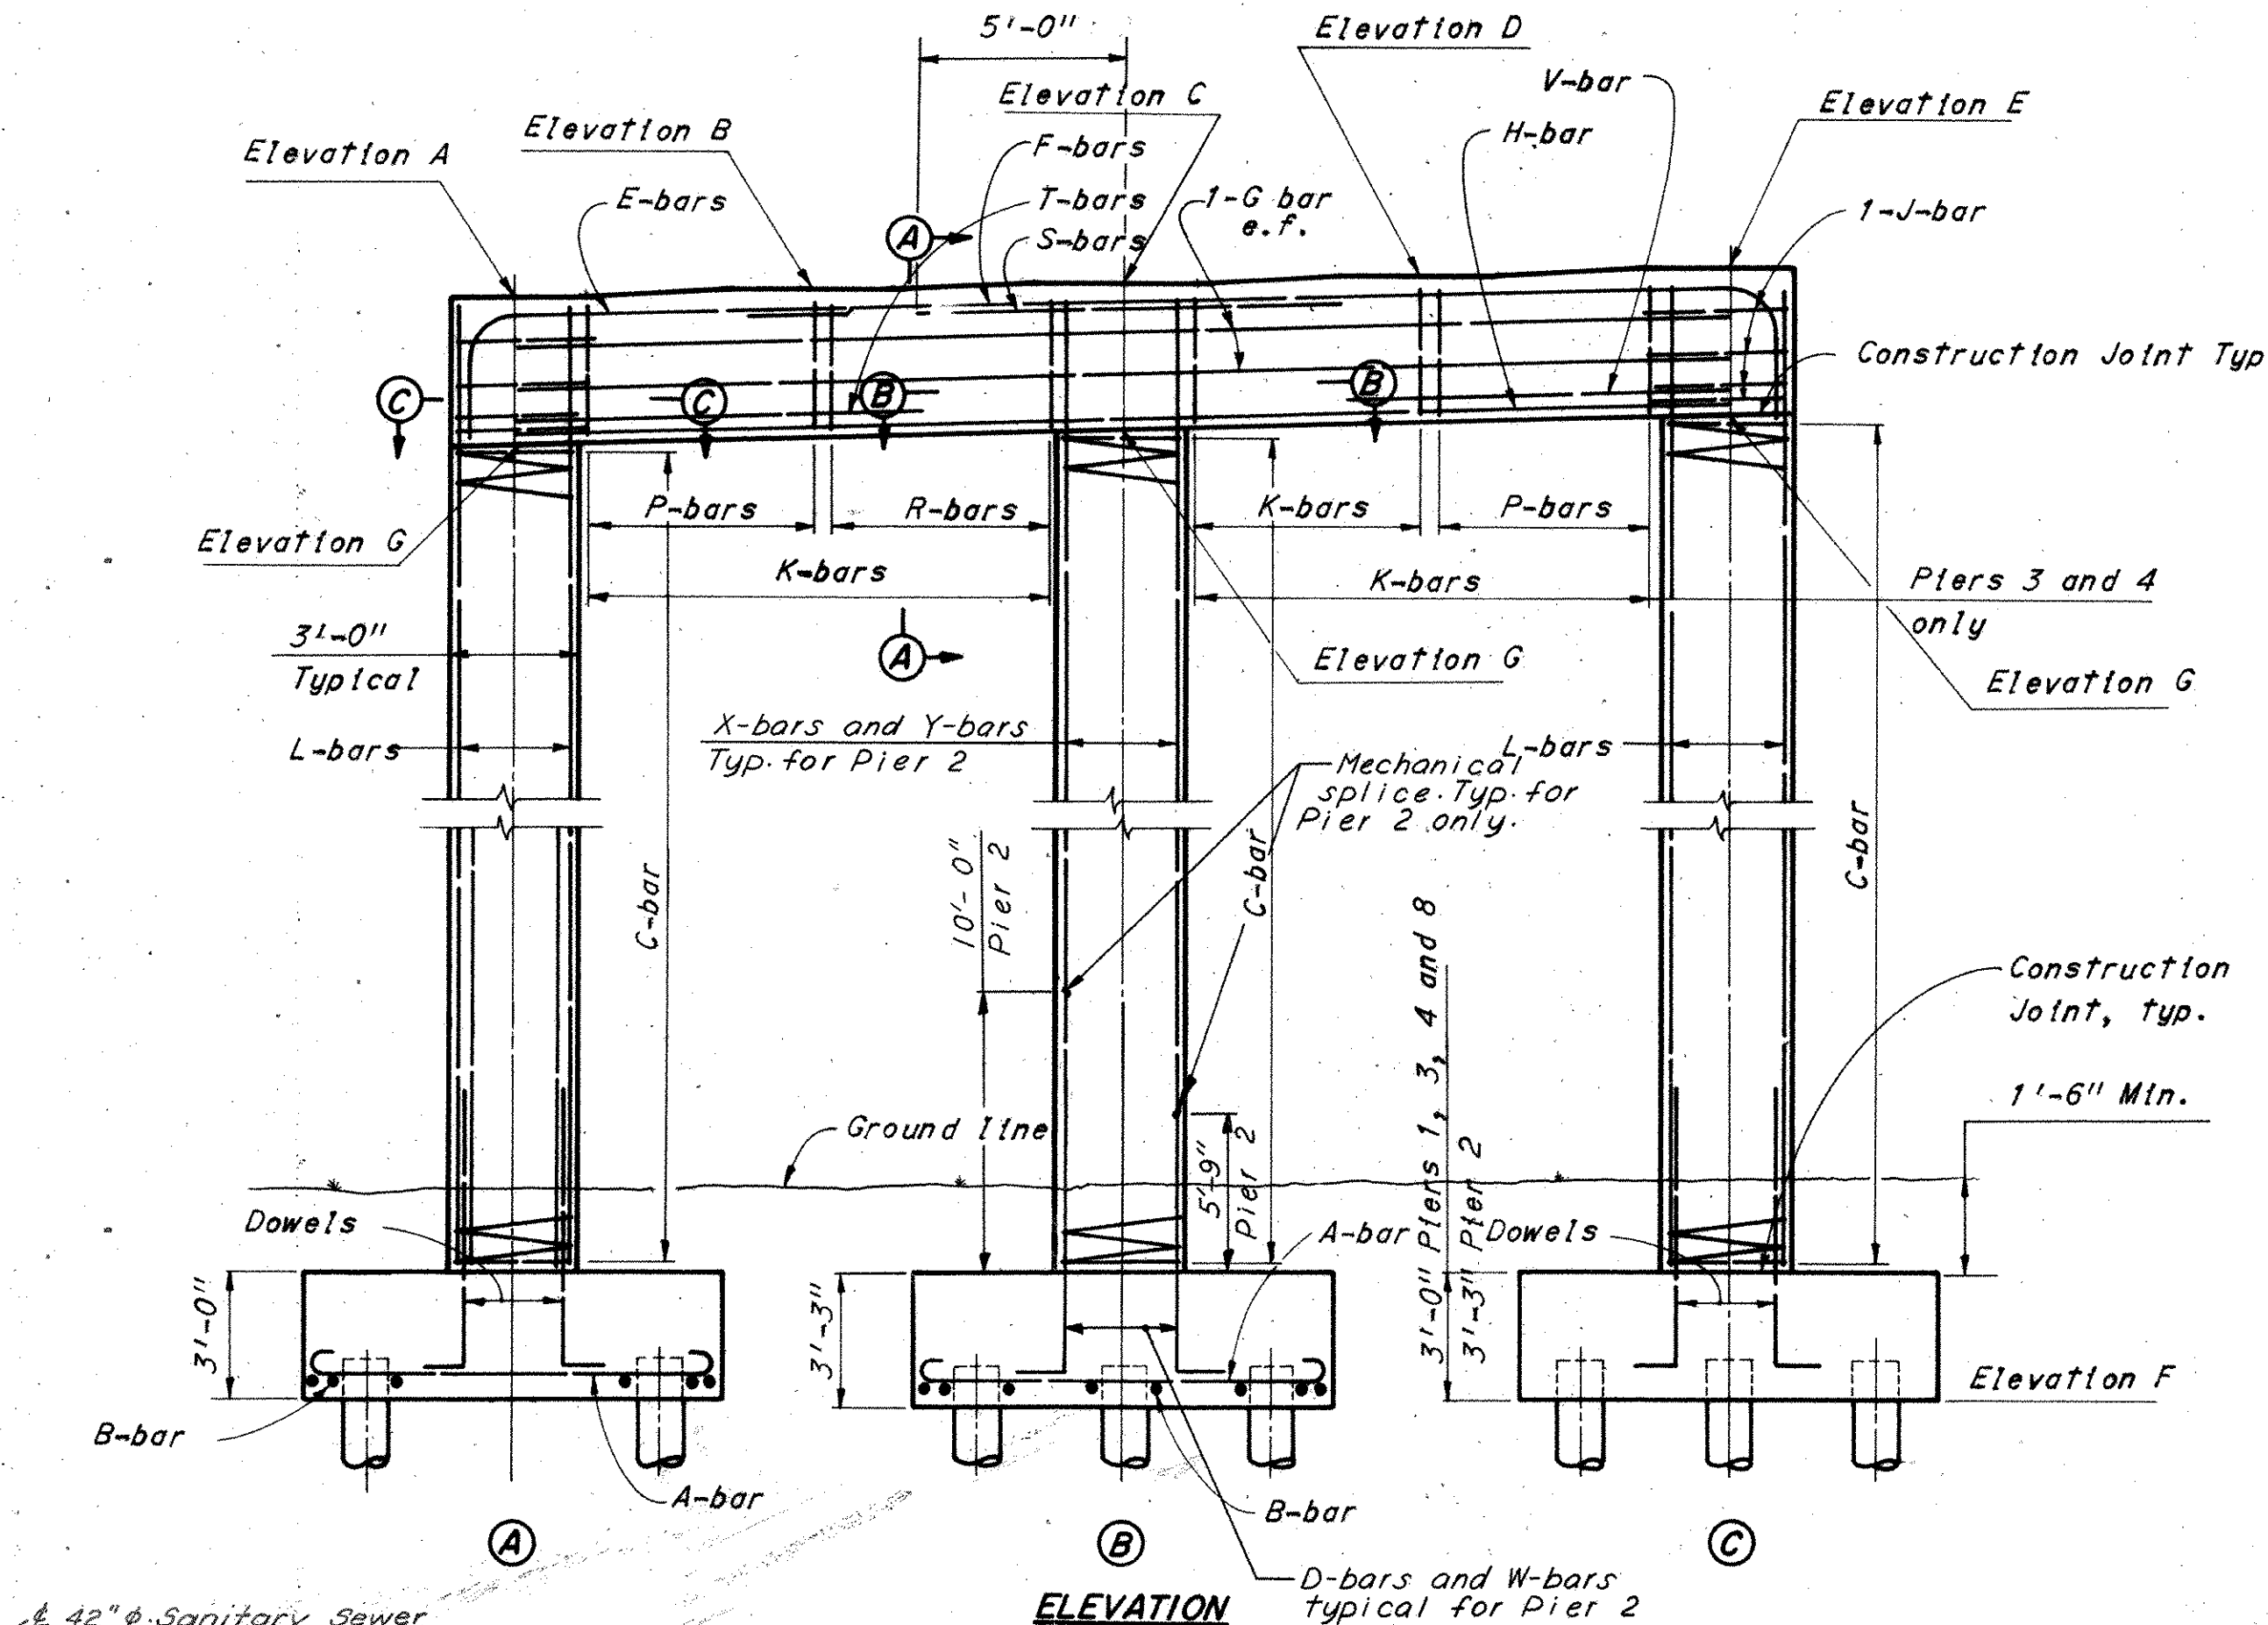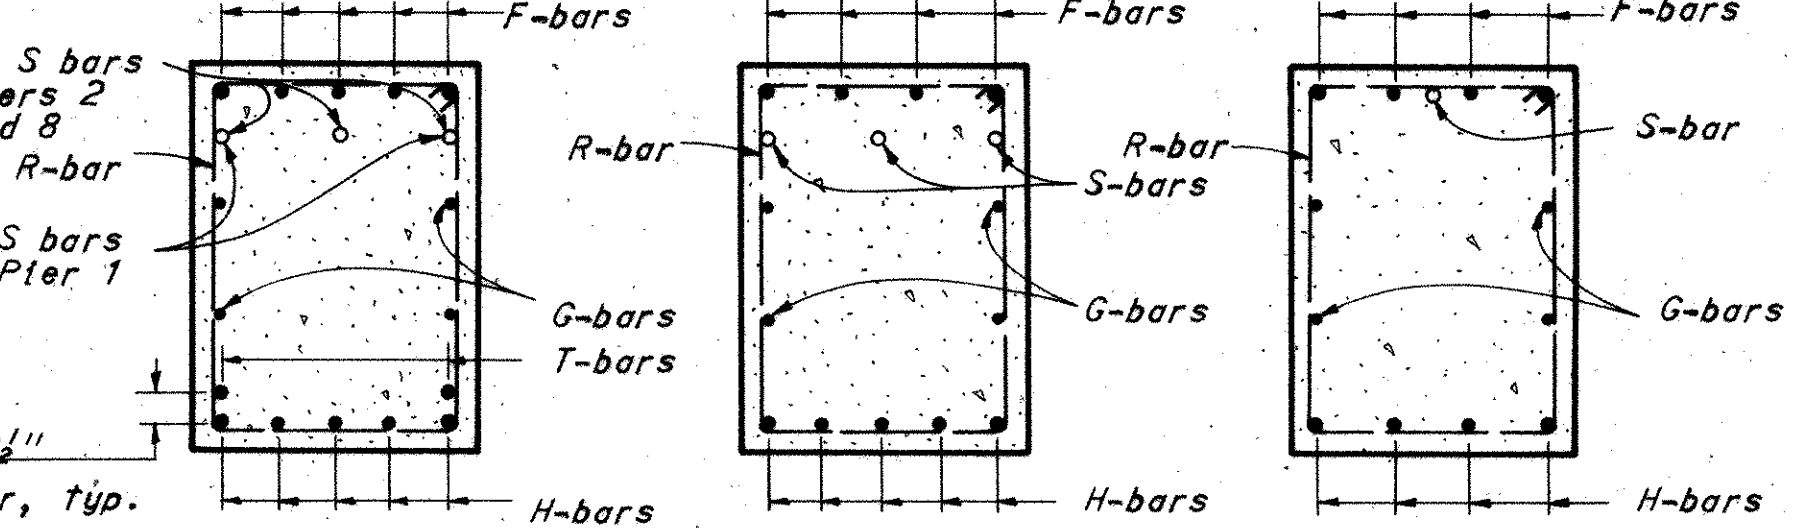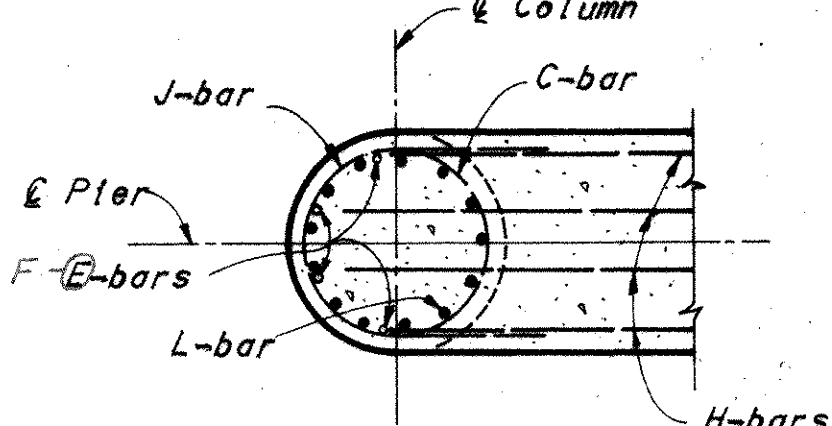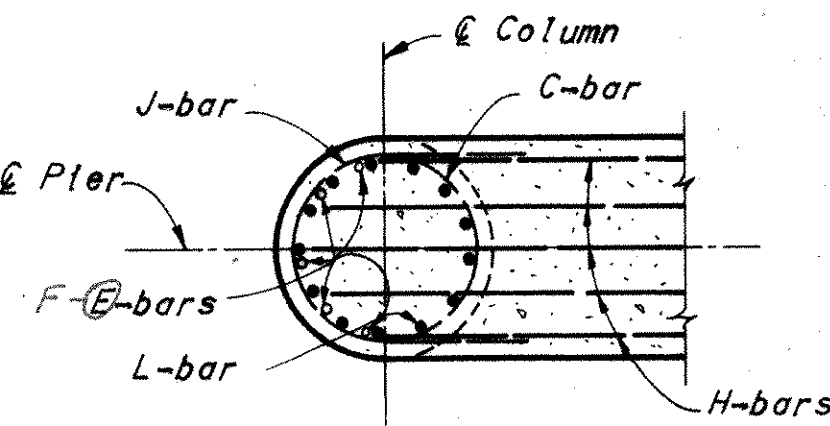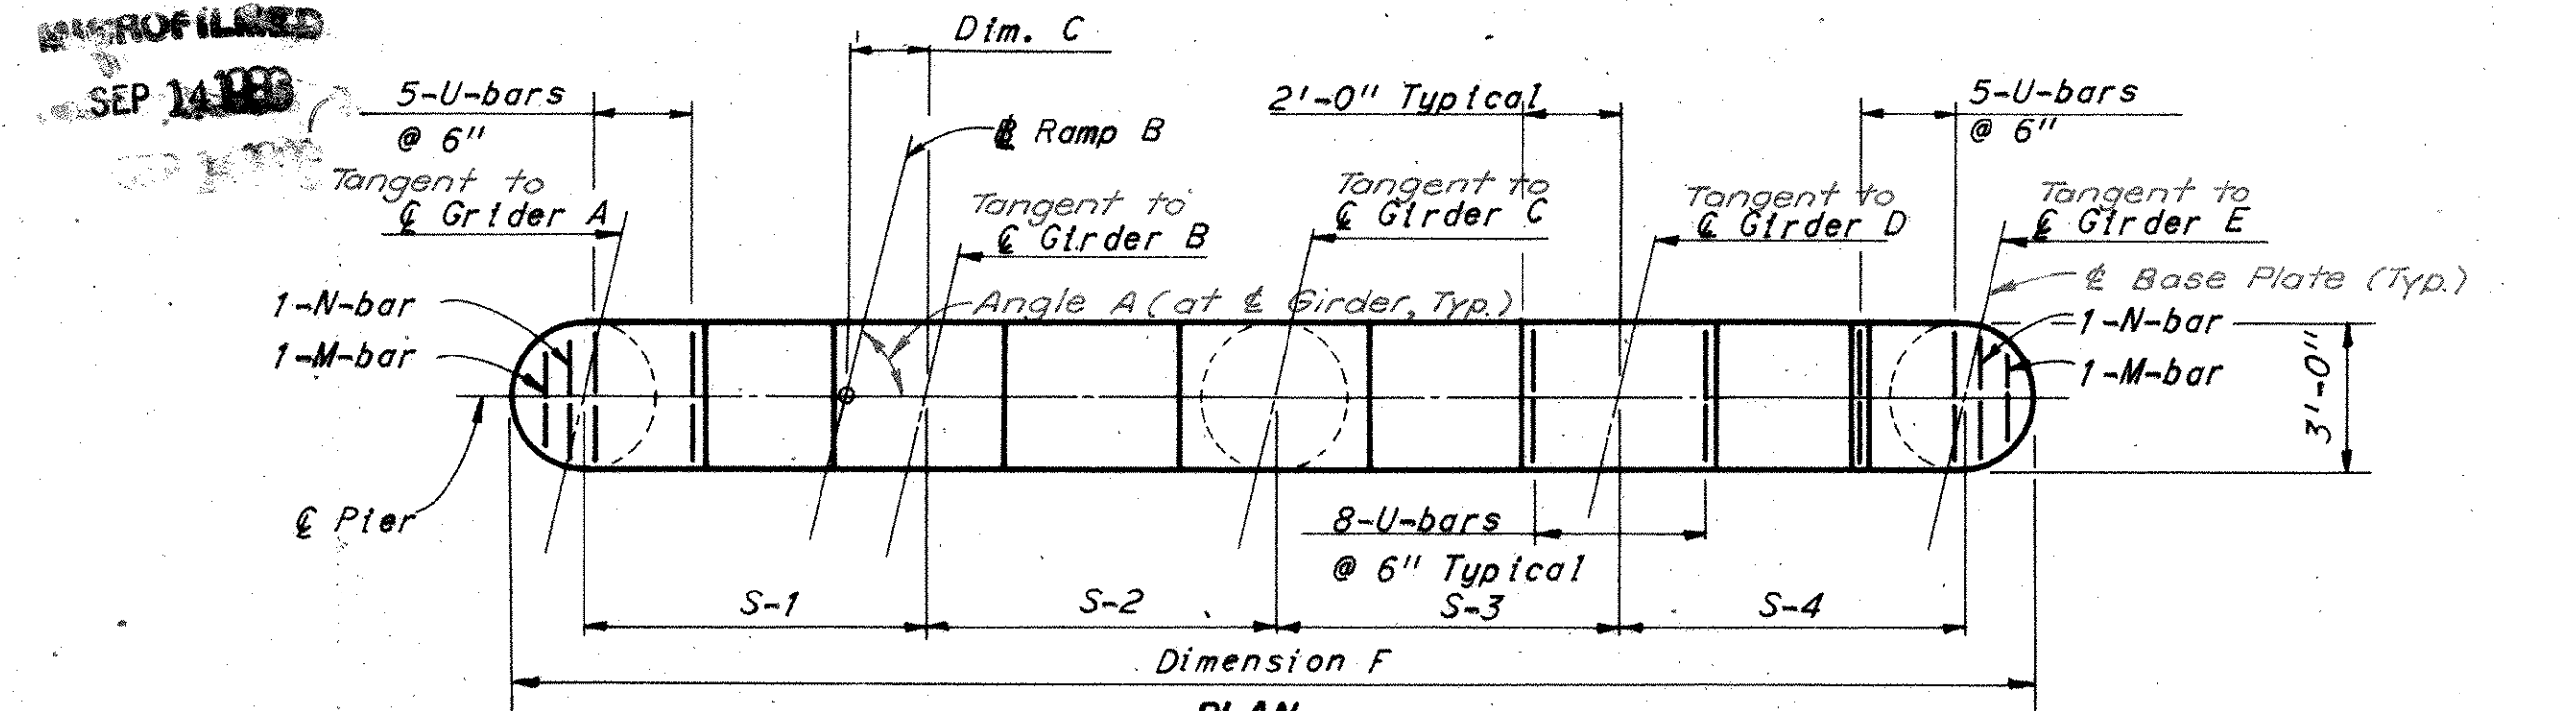







Girder	Angle A
A	64°20'16.0"
B	64°53'38.0"
C	65°25'32.1"
D	65°56'04.0"
E	66°25'19.1"

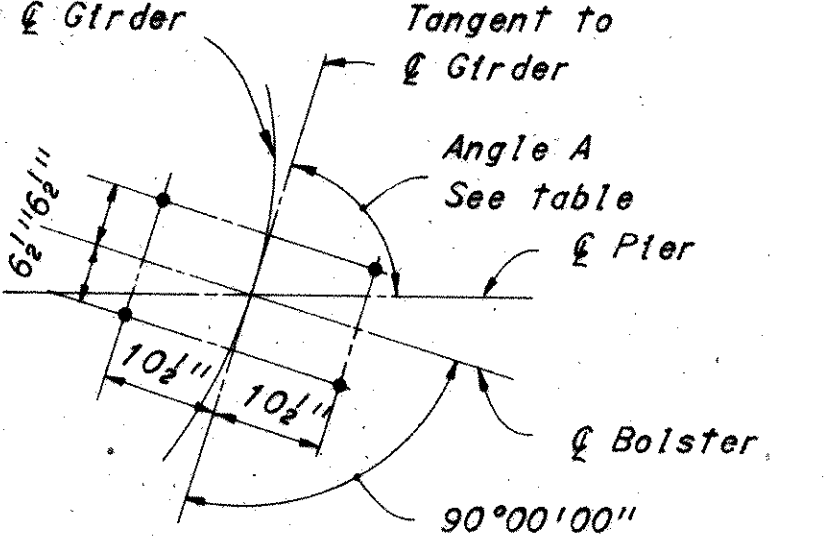

FOOTING	PILE	PIER 1 (PREFIX 2)	PIER 2 (PREFIX 3)	PIER 3 (PREFIX 4)	PIER 4 (PREFIX 5)	PIER 8 (PREFIX 9)
A	A	1	1	1	1	1
	B	2	2	2	2	2
	C	3	3	3	3	3
	D	4	4	4	4	4
	E	5	5	5	5	5
	F	6	6	6	6	6
	G	7	7	7	7	7
	H	8	8	8	8	8
B	J	9	9	9	9	9
	K	10	10	10	10	10
	L	11	11	11	11	11
	M	12	12	12	12	12
	N	13	13	13	13	13
	P	14	14	14	14	14
	Q	15	15	15	15	15
	R	16	16	16	16	16
C	S	17	17	17	17	17
	T	18	18	18	18	18

Notes:
Special care shall be taken when placing reinforcing steel so as not to interfere with anchor bolt setting. Pier 2 only. See Sheet 214.
M, N, and U. bars shall be placed 2 1/2" below top of cap beam.
For reinforcement schedule see Sheet 14/16
All battered piles shall be battered 3 in 12. Piles dimensions are measured along bottom of footing.
All piles are 12" ϕ cast-in-place concrete.

For footing layout see Sheet 3/16 and 4/16
e.f. denotes each face.
All stirrups within 4 feet of ϕ of columns shall be placed with hooks in bottom of cap. All others shall be placed with hooks in the top.
For data not given, see Sheet 8/16

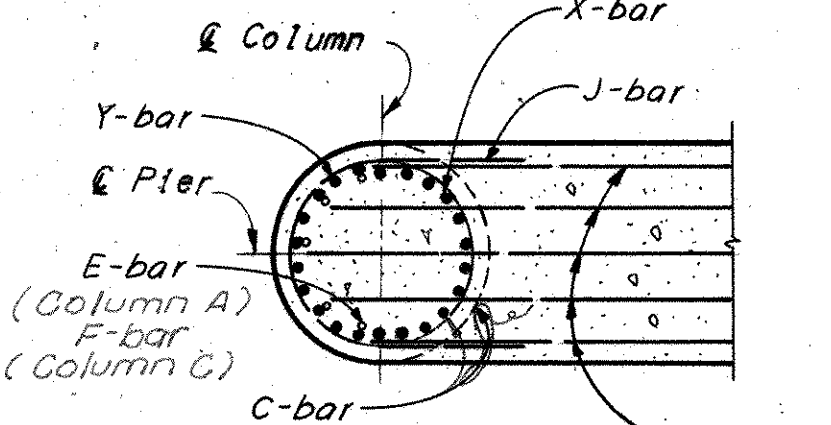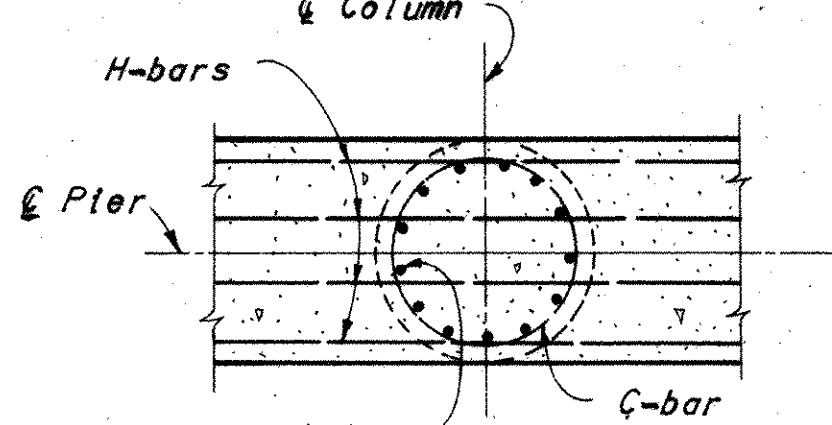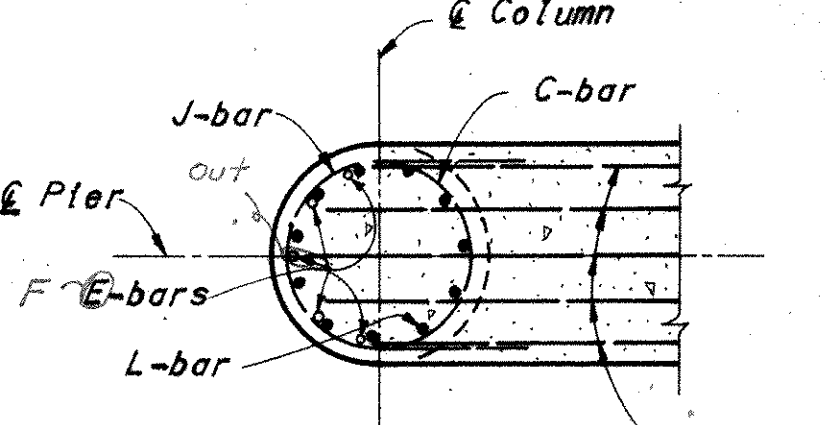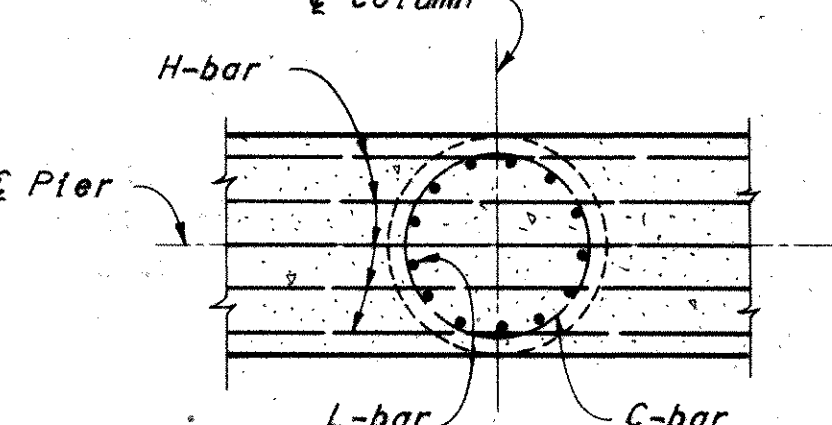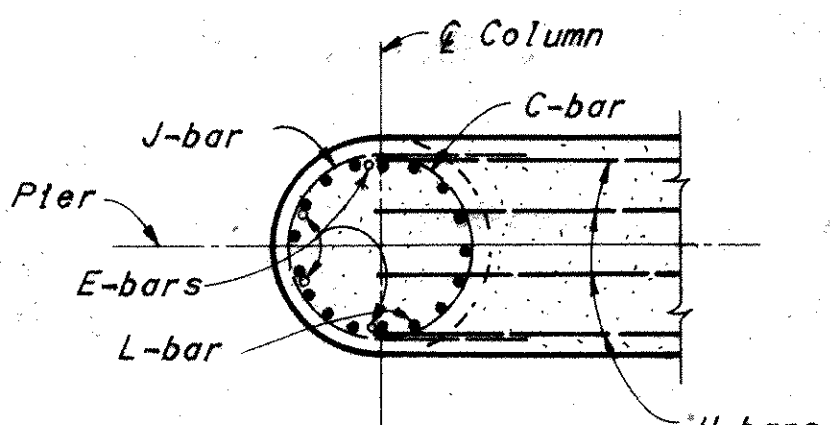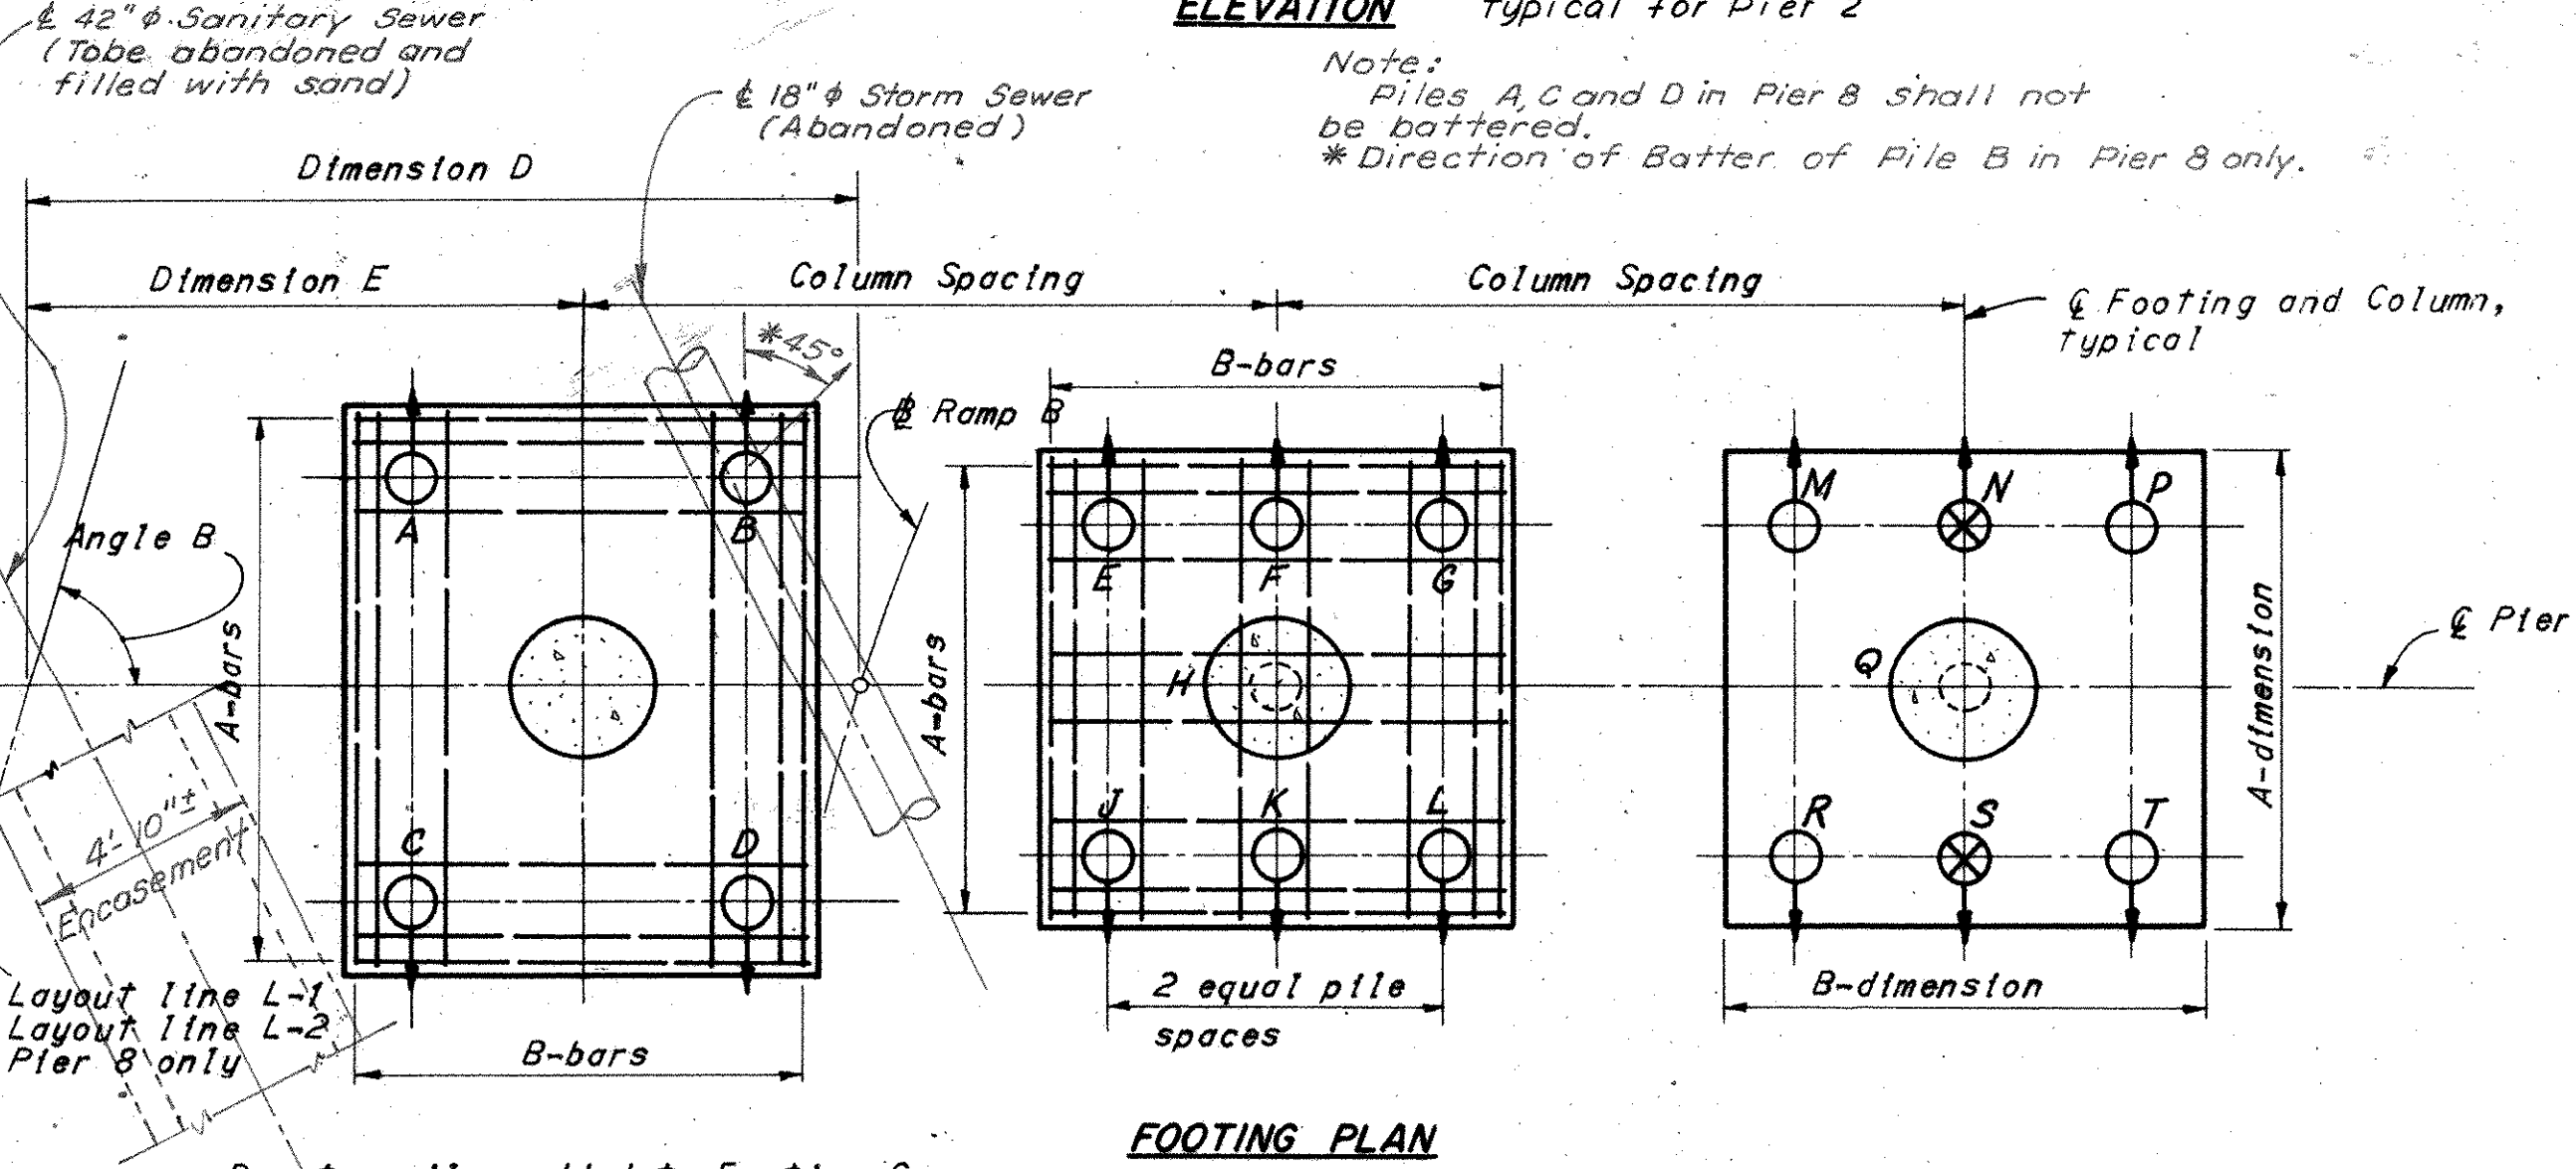

H.N.T.B. BRIDGE NO. 14 Revised 6-25-75 By RAS

HOWARD, NEEDLES, TAMMEN & BERGENDOFF
CONSULTING ENGINEERS
KANSAS CITY CLEVELAND NEW YORK

PIERS 1, 2, 3, 4 AND 8
RAMP B OVER RAMPS C AND G,
I-77 AND PENN. R.R.

BR. NO. STA. 30-1489 STA. 958 + 78.75
SCALE: NONE STA. 966 + 30.88

RELOCATED U.S. 30

CANTON STARK COUNTY OHIO

DRAWN DE	TRACED	CHECKED	REVIEWED	REVISED
DATE 2-11-70	DATE	DATE 5-15-70	DATE 11-24-71	DATE 3-2-76

1668

RECEIVED
SEP 14 1986

FED. ROAD DIV. NO.	STATE	FEDERAL AID PROJECT NO.	TYPE FUNDS
2	OHIO		

331
389

STARK COUNTY
STA-30-14.12
STA-77-9.22

Pier No.	CAP BEAM REINFORCING STEEL													
	E-bars	F-bars	G-bars	H-bars	J-bars	K-bars	M-bars	N-bars	P-bars	R-bars	S-bars	T-bars	U-bars	V-bars
1	5-PA1004	5-PA1003	PA602	5-PA1005	PA601	7-PA502 @ 9"	PA503	PA504	5-PA502 @ 18"	5-PA502 @ 15"	2-PA1007	2-PA1006	PA501	2-PA1006
2	5-PB1001	5-PB1002	PB602	5-PB1003	PB601	7-PB502 @ 12"	PB503	PB504	5-PB502 @ 18"	6-PB502 @ 15"	3-PB1005	2-PB1004	PB501	2-PB1006
3	4-PC1002	4-PC1003	PC602	5-PC1004	PC601	9-PC502 @ 18"	PC503	PC504			3-PC1005		PC501	
4	4-PD1001	4-PD1002	PD602	4-PD1003	PD601	9-PD502 @ 18"	PD503	PD504			1-PD1004		PD501	
8	5-PH1004	5-PH1005	PH602	5-PH1006	PH601	8-PH502 @ 9"	PH503	PH504	5-PH502 @ 18"	6-PH502 @ 12"	3-PH1008	2-PH1009	PH501	2-PH1007

PIER CAP LAYOUT TABLE					
Pier No.	1	2	3	4	8
Pier Sta.	959+55.00	960+52.00	961+33.00	961+94.50	965+56.50
Dimension C	1'-11 1/8"	2'-0 1/8"	1'-11"	1'-11 3/8"	1'-11 3/8"
Girder	A	A	A	A	A
Elevation A	1038.05	1042.09	1045.74	1048.43	1059.67
S-1	7'-3 3/4"	7'-10 5/8"	7'-3 3/4"	7'-5 1/2"	7'-4 3/4"
Girder	B	B	B	B	B
Elevation B	1038.71	1042.82	1046.39	1049.11	1059.93
S-2	7'-3 3/4"	7'-10 5/8"	7'-3 3/4"	7'-5 1/2"	7'-4 3/4"
Girder	C	C	C	C	C
Elevation C	1039.29	1043.49	1047.00	1049.74	1060.15
S-3	7'-3 3/4"	7'-9 5/8"	7'-3 3/4"	7'-5 1/2"	7'-4 1/2"
Girder	D	D	D	D	D
Elevation D	1039.93	1044.19	1047.64	1050.42	1060.41
S-4	7'-3 3/4"	7'-9 5/8"	7'-3 3/4"	7'-5 1/2"	7'-4 3/4"
Girder	E	E	E	E	E
Elevation E	1039.98	1044.31	1047.70	1050.50	1060.30
Dimension F	32'-6"	34'-6"	32'-2"	32'-10"	32'-8"

FOOTING DATA										
Pier No.	Column Spacing	Footing	Elev. F	Dim. A	Dim. B	Reinforcing Steel		Dim. D	Dim. E	Angle B
						A-bars	B-bars			
1	14'-9"	A	1003.90	14'-0"	9'-0"	15-PA801	12-PA1101	24'-9 $\frac{3}{8}$ "	19'-3"	90°32' 47.0"
		B	1003.65	10'-0"	10'-0"	10-PA901	12-PA1001			
		C	1003.90	11'-0"	10'-0"	10-PA1001	10-PA1002			
2	15'-9"	A	1002.90	14'-0"	9'-0"	15-PB801	12-PB1101	38'-7 $\frac{3}{8}$ "	32'-8 $\frac{3}{8}$ "	27 62°35' 02.2"
		B	1002.65	11'-0"	11'-0"	12-PB901	12-PB1102			
		C	1002.65	11'-0"	10'-0"	10-PB902	12-PB1102			
3	14'-7"	A	1009.90	12'-0"	10'-0"	10-PC1001	10-PC1101	24'-5"	19'-0 $\frac{1}{2}$ "	62°25' 02.2"
		B	1009.65	10'-0"	10'-0" ¹⁰	9-PC901	12-PC1001			
		C	1009.90	10'-0"	9'-0"	9-PC902	10-PC901			
4	14'-11"	A	1016.90	14'-0"	10'-0"	14-PD901	13-PD1101	0'-0"	5'-6 $\frac{1}{2}$ "	46°50' 23.0"
		B	1014.15	9'-0"	9'-0"	8-PD801	10-PD902			
		C	1012.90	10'-0"	9'-0"	9-PD902	10-PD901			
8	14'-10"	A	1031.90	13'-0"	9'-0"	13-PH801 ¹²	11-PH1101	26'-6 $\frac{7}{8}$ "	21'-0 $\frac{1}{2}$ "	87°04' 02.0"
		B	1031.65	12'-0"	12'-0"	12-PH1002	16-PH1107			
		C	1031.90	11'-0"	10'-0"	10-PH1001	10-PH1003			

** See Sheet 3/16

ANGLE A					
Girder	Pier 1	Pier 2	Pier 3	Pier 4	Pier 8
A	76°47'54.5"	64°20'16.0"	77°49'28.2"	72°13'28.9"	105°44'31.6"
B	77°04'13.7"	64°53'38.0"	78°04'28.9"	72°35'46.5"	105°24'55.2"
C	77°19'53.0"	65°25'32.1"	78°18'53.1"	72°57'08.4"	105°06'07.3"
D	77°34'54.8"	65°56'04.0"	78°32'43.0"	73°17'38.2"	104°48'04.8"
E	77°49'21.4"	66°25'19.1"	78°46'00.5"	73°37'18.9"	104°30'45.1"

COLUMN DATA					
Pier No.	Column	Elevation G	Reinforcing Steel		
			Dowels	L-bars	C-bars
1	A	1034.09	16-PA1102	16-PA1103	1-SPA401
	B	1035.32	13-PA1106	13-PA1104	1-SPA402
	C	1036.56	13-PA1102	13-PA1105	1-SPA403
3	A	1041.77	14-PC1102	14-PC1103	1-SPC401
	B	1043.02	11-PC1106	11-PC1104	1-SPC402
	C	1044.27	11-PC1102	11-PC1105	1-SPC403
4	A	1044.45	17-PD1102	17-PD1103	1-SPD401
	B	1045.75	13-PD1106	13-PD1104	1-SPD402
	C	1047.05	13-PD1102	13-PD1105	1-SPD403
8	A	1055.99	16-PH1102	16-PH1103	1-SPH401
	B	1056.49	13-PH1106	13-PH1104	1-SPH402
	C	1056.96	13-PH1102	13-PH1105	1-SPH403

COLUMN DATA - PIER 2						
Column	Elevation G	Reinforcing Steel				
		D-bars	W-bars	X-bars	Y-bars	C-bars
A	1038.12	11-PB1401	11-PB1402	11-PB1403	11-PB1404	1-SPB401
B	1039.47	11-PB1405	11-PB1406	11-PB1407	11-PB1408	1-SPB402
C	1040.81	11-PB1405	11-PB1406	11-PB1409	11-PB1410	1-SPB403

Note:
D-bars shall be spliced to X-bars and W-bars spliced to Y-bars.

H.N.T.B. BRIDGE NO. 14		Revised 6-25-75		By RAS
HOWARD, NEEDLES, TAMMEN & BERGENDOFF CONSULTING ENGINEERS KANSAS CITY CLEVELAND NEW YORK				
PIERS 1, 2, 3, 4 AND 8 RAMP B OVER RAMPS C AND G, I-77 AND PENN. R.R.				
BR. NO. STA. 30-1489		STA. 958 + 78.75		
SCALE: NONE		STA. 966 + 30.88		
RELOCATED U.S. 30				
CANTON		STARK COUNTY		OHIO
DRAWN: LDE	TRACED	CHECKED: DWB	REVIEWED: MJK	REVISED
DATE: 2-11-70	DATE	DATE: 5-15-70	DATE: 7-20-71	1668

Revised 4-28-77


STARK COUNTY
STA-30-14.12
STA-77-9.22

Pier No.	CAP BEAM REINFORCING STEEL											
	E-bars	F-bars	G-bars	H-bars	J-bars	K-bars	M-bars	N-bars	P-bars	R-bars	S-bars	U-bars
5	4-PE1003	4-PE1002	PE602	4-PE1004	PE601	9-PE501 @ 18"	PE502	PE503			2-PE1005	PE504
6	5-PF1003	5-PF1002	PF602	4-PF1004	PF601	8-PF501 @ 18"	PF502	PF503	5-PF501 @ 18"	5-PF501 @ 15"	2-PF1005	PF504
7	5-PG1003	5-PG1002	PG602	5-PG1004	PG601		PG502	PG503	5-PG501 @ 18"	7-PG501 @ 9"	2-PG1005	PG504

PIER CAP LAYOUT TABLE			
Pier No.	5	6	7
Dimension F	33'-8"	32'-0"	31'-8"
Dimension C	2'-0"	1'-10"	1'-10"
Girder A	A	A	A
Elevation A	1051.07	1054.68	1057.33
S-1	7'-8"	7'-2"	7'-1"
Girder B	B	B	B
Elevation B	1051.78	1055.32	1057.86
S-2	7'-8"	7'-2"	7'-1"
Girder C	C	C	C
Elevation C	1052.44	1055.91	1058.32
S-3	7'-7"	7'-2"	7'-1"
Girder D	D	D	D
Elevation D	1053.13	1056.53	1058.85
S-4	7'-7"	7'-2"	7'-1"
Girder E	E	E	E
Elevation E	1053.24	1056.57	1058.83

FOOTING DATA									
Pier No.	Column Spacing	Footings	Elev. F	Dim. A	Dim. B	Reinforcing Steel A-bars	B-bars	Dim. D	Angle B
5	15'-4"	A	1028.90	13'-0"	9'-0"	11-PE1101	13-PE801	0'-0"	5'-8"
		B	1027.65	10'-0"	10'-0"	12-PE1001	10-PE901	0'-0"	5'-8"
		C							
6	14'-6"	A	1016.90	14'-0"	9'-0"	12-PF1101	15-PF801	33'-7"	28'-3"
		B	1018.65	12'-0"	12'-0"	16-PF1102	12-PF1001	33'-7"	28'-3"
		C							
7	14'-4"	A	1032.90	14'-0"	9'-0"	12-PG1101	15-PG801	44'-6"	39'-2"
		B	1032.65	10'-0"	10'-0"	12-PG1001	10-PG901	44'-6"	39'-2"
		C							

COLUMN DATA					
Pier No.	Column	Elevation G	Reinforcing Steel		
			C-bars	L-bars	Dowels
5	A	1047.09	1-SPE401	17-PE1006	17-PE1009
	B	1048.42	1-SPE402	9-PE1007	9-PE1010
	C	1049.76	1-SPE403	11-PE1008	
6	A	1050.72	1-SPF401	15-PF1103	20-PF1107
	B	1051.94	1-SPF402	15-PF1104	20-PF1108
	C	1053.16	1-SPF403	15-PF1105	
7	A	1053.44	1-SPG401	15-PG1102	20-PG1106
	B	1054.44	1-SPG402	15-PG1103	20-PG1107
	C	1055.45	1-SPG403	15-PG1104	

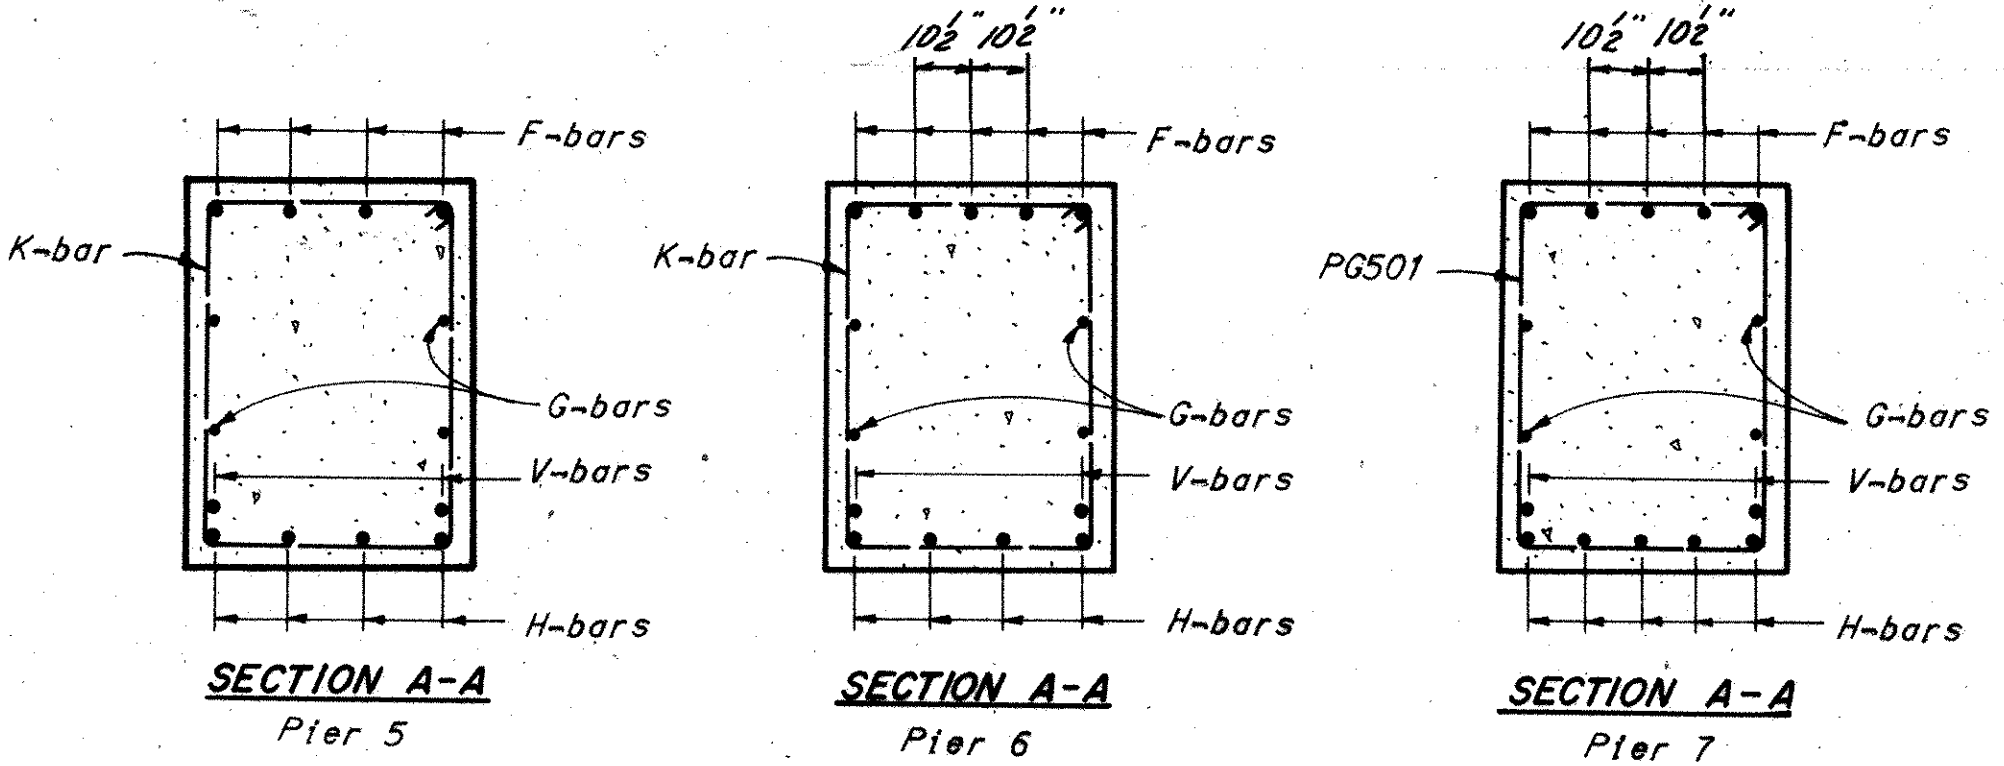


Notes:
Special care shall be taken when placing reinforcing steel so as not to interfere with anchor bolt or anchor bolt setting. Piers 6, 7 only. See Sheet 214.
M, N, and U bars shall be placed 2" below top of cap beam.
For reinforcement schedule see Sheet 15/16.
All battered piles shall be battered 3 in 12.
Piles dimensions are measured along bottom of footing.
All piles are 12" cast-in-place concrete.
For footing layout see Sheet 4/16.
e.f. denotes each face.
For footing C data see Sheet 272.
All stirrups within 4 feet of column shall be placed with hooks in bottom of cap. All others shall be placed with hooks in the top.

ANGLE A			
Grd.	Pier 6	Pier 7	Pier 5
A	99° 38' 45.8"	87° 27' 42.8"	112° 21' 10.7"
B	99° 26' 56.1"	87° 30' 48.0"	111° 52' 36.1"
C	99° 15' 35.0"	87° 33' 45.8"	111° 25' 15.0"
D	99° 04' 40.7"	87° 36' 36.6"	110° 59' 02.6"
E	98° 54' 11.8"	87° 39' 20.9"	110° 33' 54.5"

H.N.T.B. BRIDGE NO. 14
HOWARD, NEEDLES, TAMMEN & BERGENDOFF
CONSULTING ENGINEERS
KANSAS CITY CLEVELAND NEW YORK
Revised 6-25-75 By RAS
9/16

PIERS 5, 6, AND 7
RAMP B OVER RAMP C AND G,
I-77 AND PENN. R.R.
BR. NO. STA. 30-1489
SCALE: NONE
RELOCATED U.S. 30
CANTON STARK COUNTY OHIO
DRAWN LDE TRACED DATE 6-11-70
CHECKED DMB DATE 6-11-70
REVIEWED MJK DATE 11-20-71
REVISED 3-2-76
1668

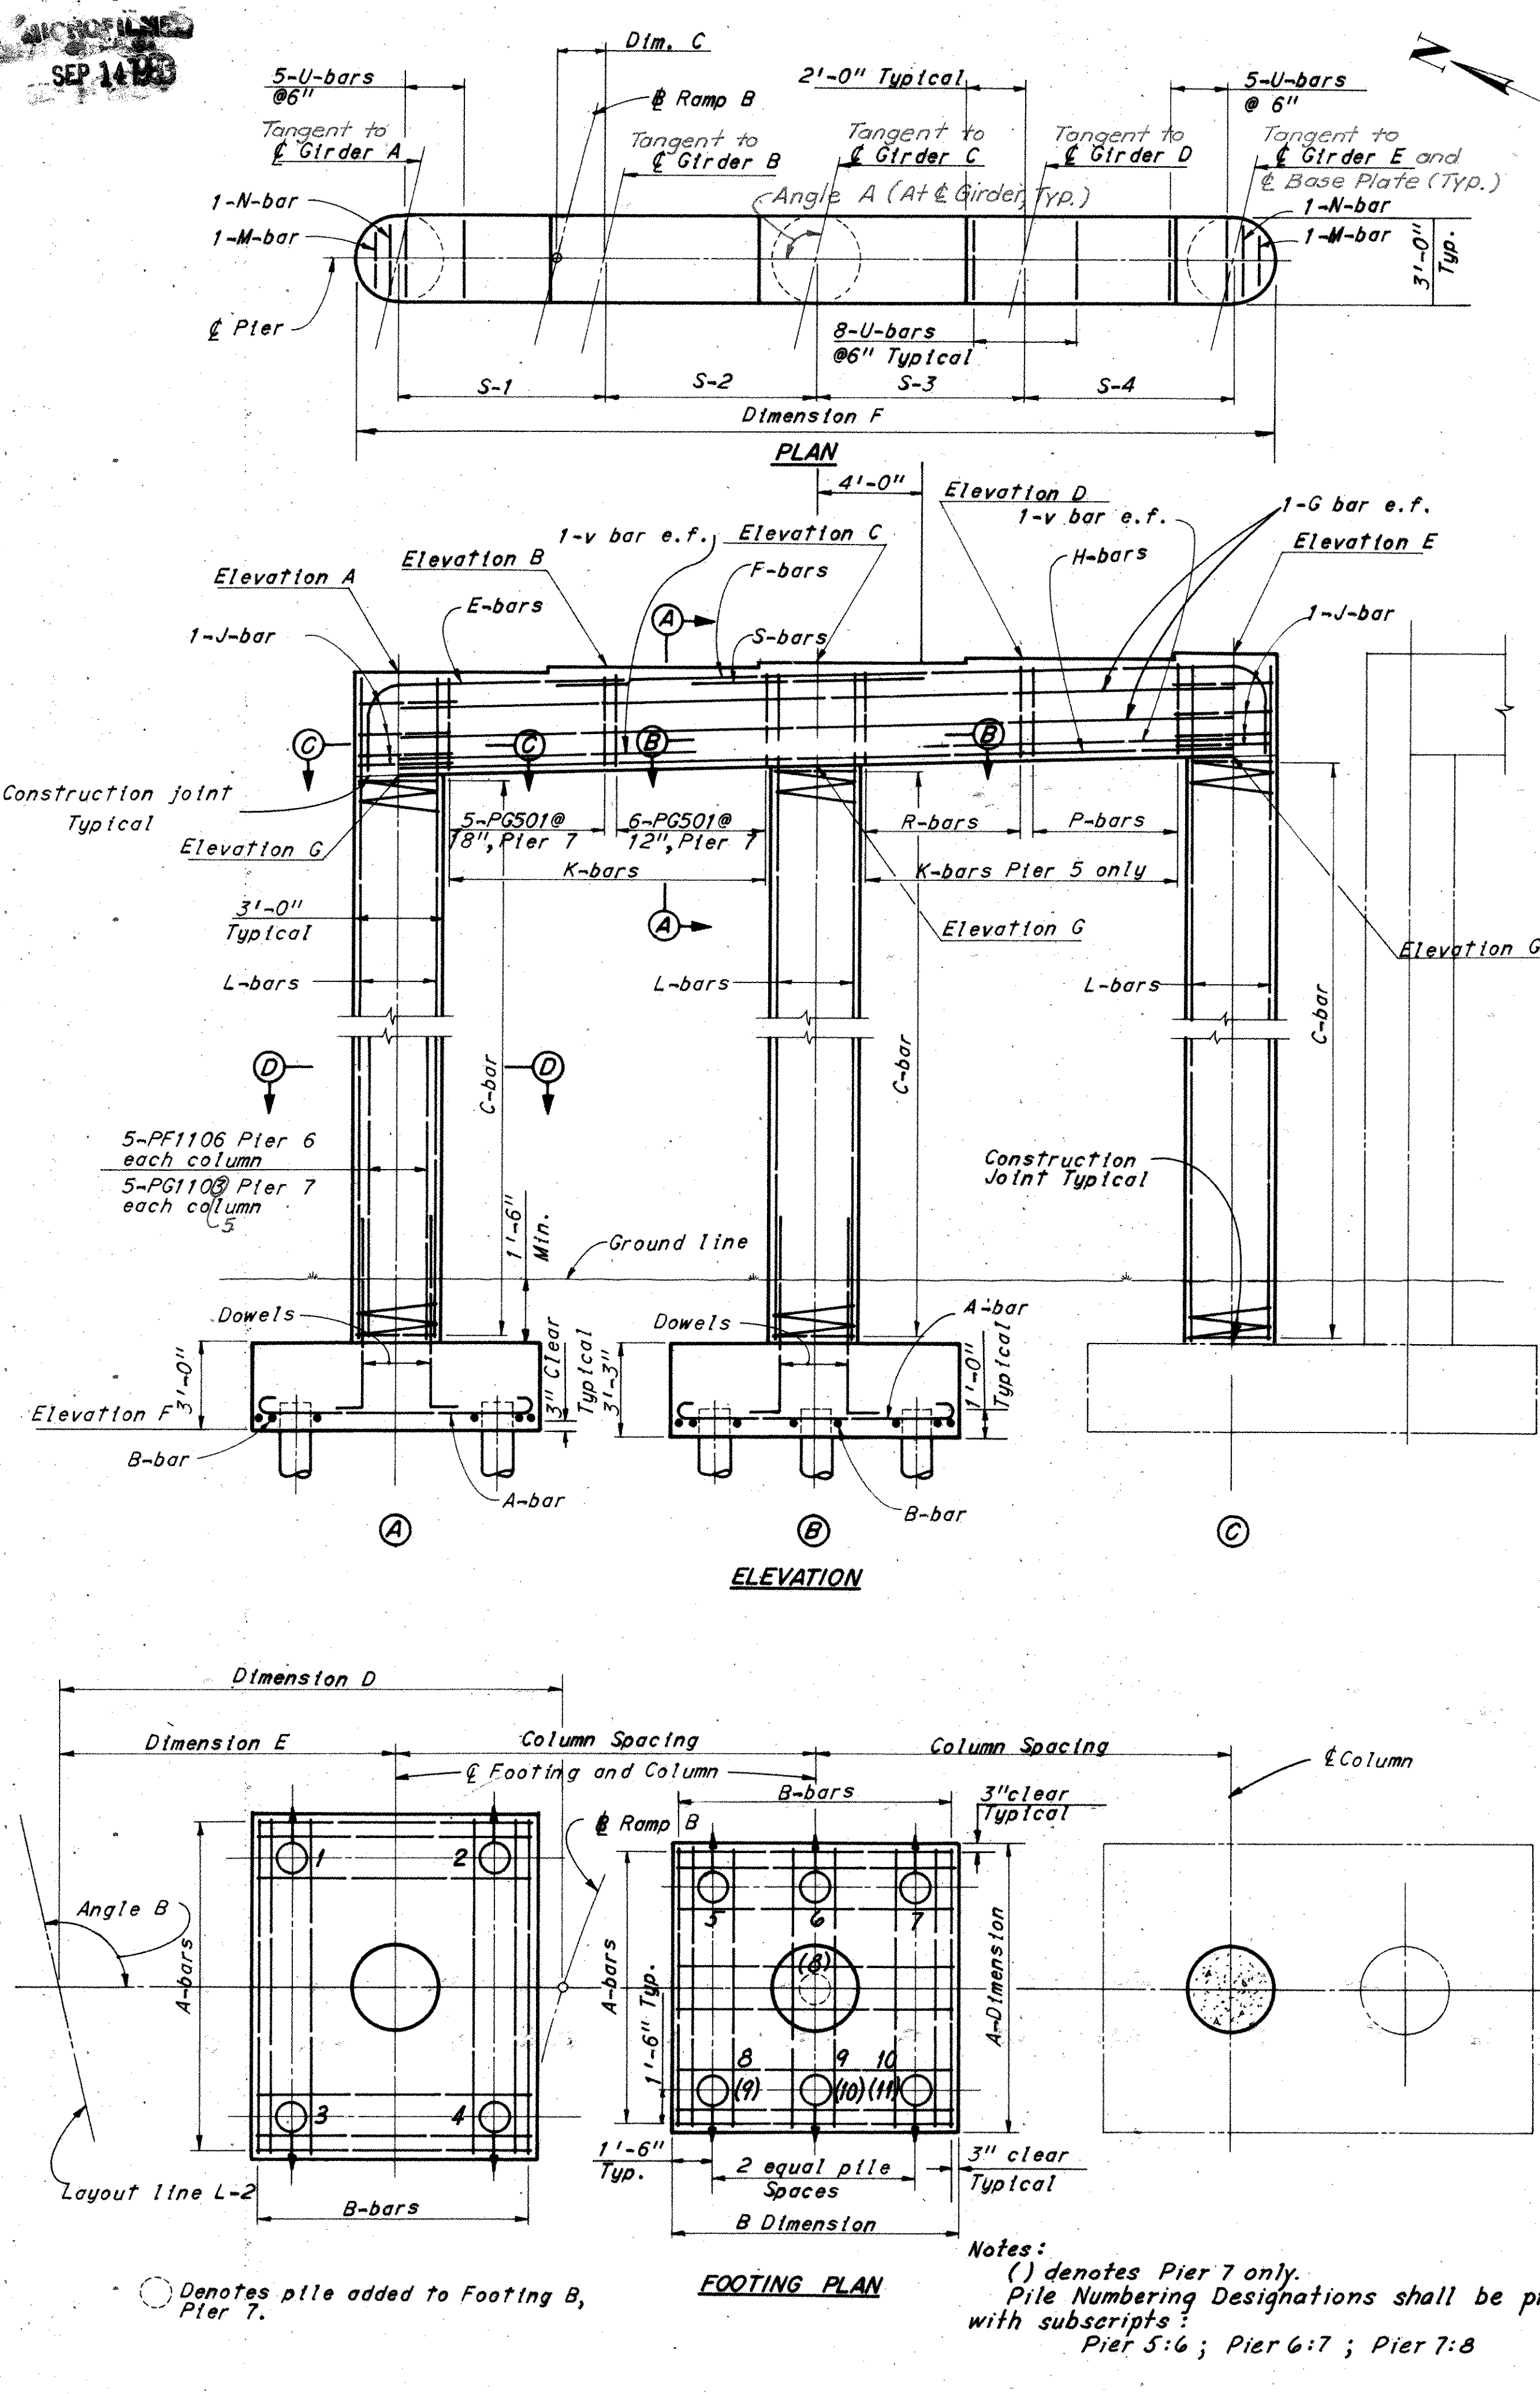


Notes:
() denotes Pier 7 only.
Pile Numbering Designations shall be prefixed with subscripts:
Pier 5:6; Pier 6:7; Pier 7:8

SEP 14 1988

FED. ROAD DIV. NO.	STATE	FEDERAL AID PROJECT NO.	TYPE FUNDS
2	OHIO		

STARK COUNTY
STA-30-14.12
STA-77-9.22

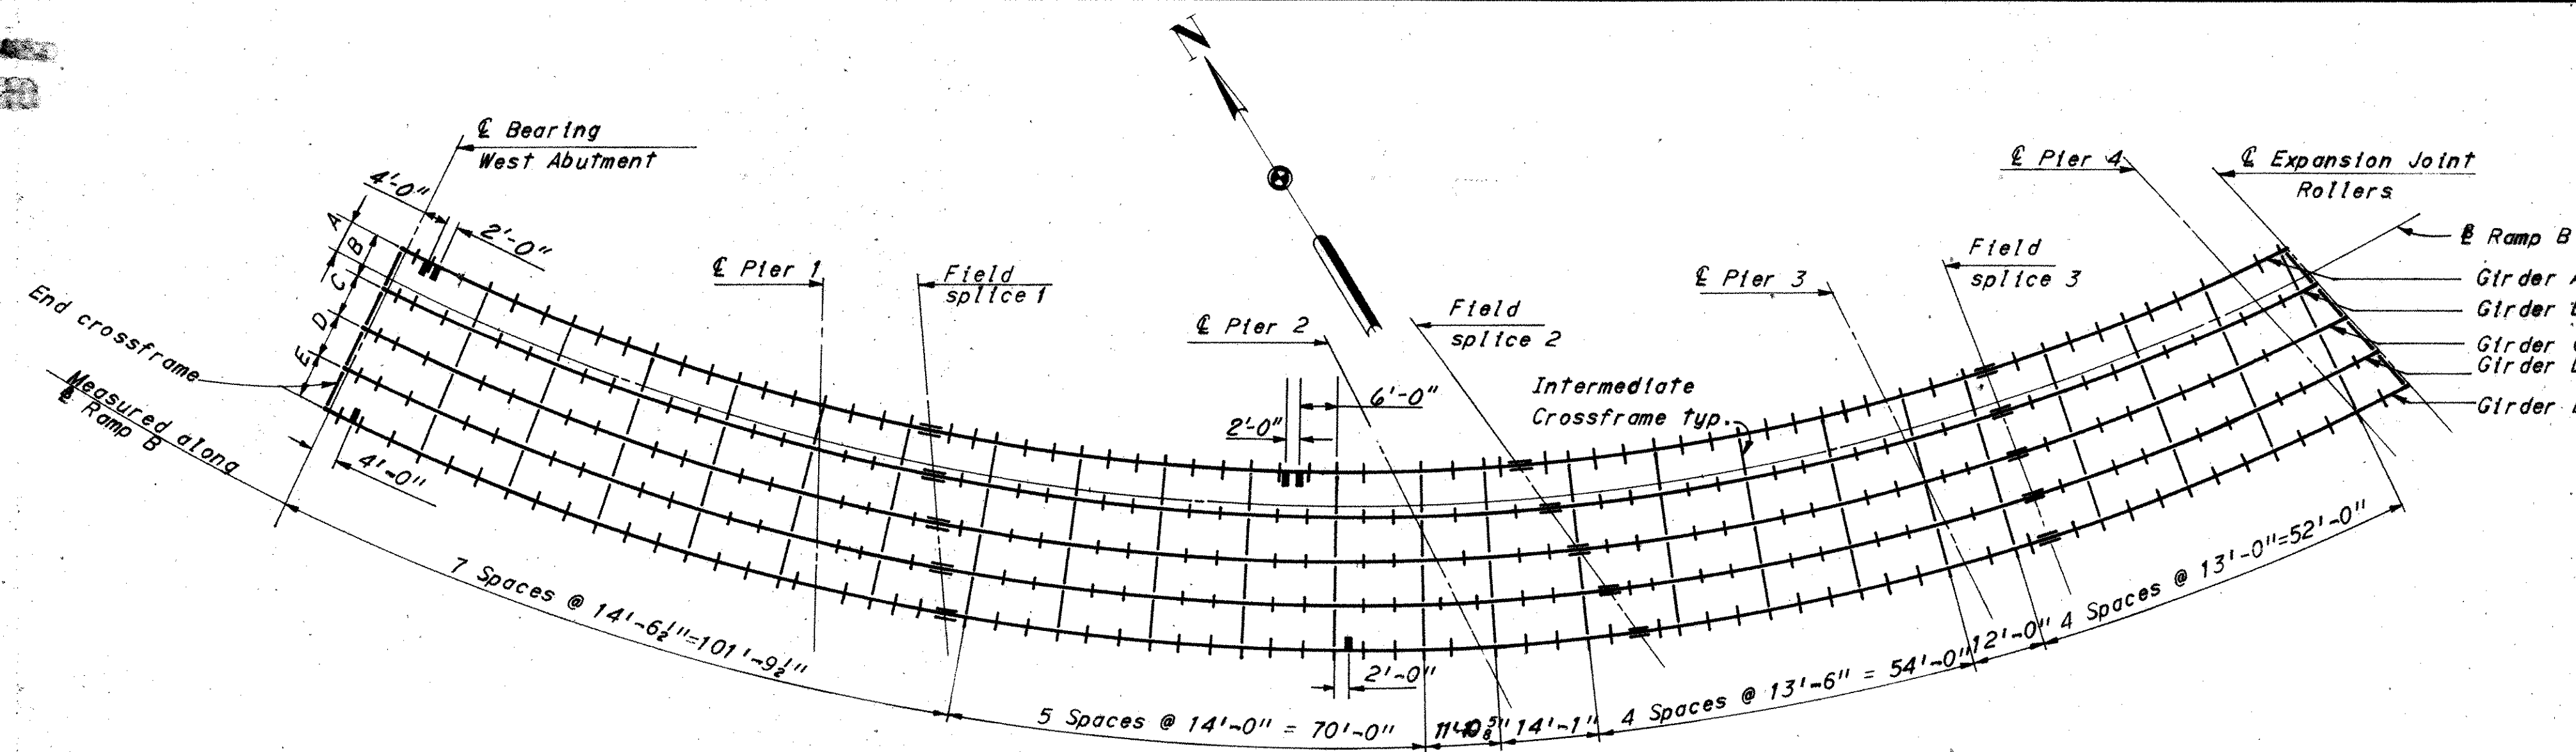

Notes:
Top and bottom flanges are identical in size.
All stiffeners shall be placed normal to girder flanges.
All intermediate stiffener to web welds shall be 1/4\" continuous fillets on both sides of stiffeners.
For detail of field splices see Sheet 355.
All intermediate stiffeners shall be Pls. 5x3/8.

Intermediate stiffeners shall be placed as shown on framing plan, equally spaced between crossframes or crossframes and bearing stiffeners or crossframes and splices.

End crossframe details shall be same as shown on Ohio Standard Drawing SD-1-69, Sheet 1 of 4, and Sheet 359.
For intermediate crossframe details see Sheet 360.
All crossframes are intermediate crossframes unless shown otherwise.
For details of roadway end dam, see Ohio Standard Drawing SD-1-69, Sheet 1 of 4.
For Expansion joint details see Sheet 356.
For details of expansion joint crossframe see Sheet 360.
For Camber and Deflection Table see Sheet 365.
For details at rockers and bolsters see Ohio Standard Drawing RB-1-55.

The girders shall be fabricated to lines parallel to profiles formed by top of pavement elevations directly over girders, plus the camber required to compensate for dead load deflection.

The allowance to be made in screed settings to compensate for dead load deflections due to concrete and wearing course are to be made above or below the top of the pavement elevations as required. Screeds may require further adjustment due to irregularities in fabricated steel.

For details of curb plates at concrete bridge railing see Ohio Standard Drawing SD-1-69, Sheet 2 of 4.


■ Denotes standard scupper.

Dimensions to scuppers are measured along centerline of girders.

For detail of intermediate stiffeners see Sheet 360.

Scuppers shall be in accordance with Std. Dwg. SD-1-69 except that scupper pipes shall extend 8\" below the bottom of girders instead of 2\".

For underdeck lighting details see Lighting Plans.

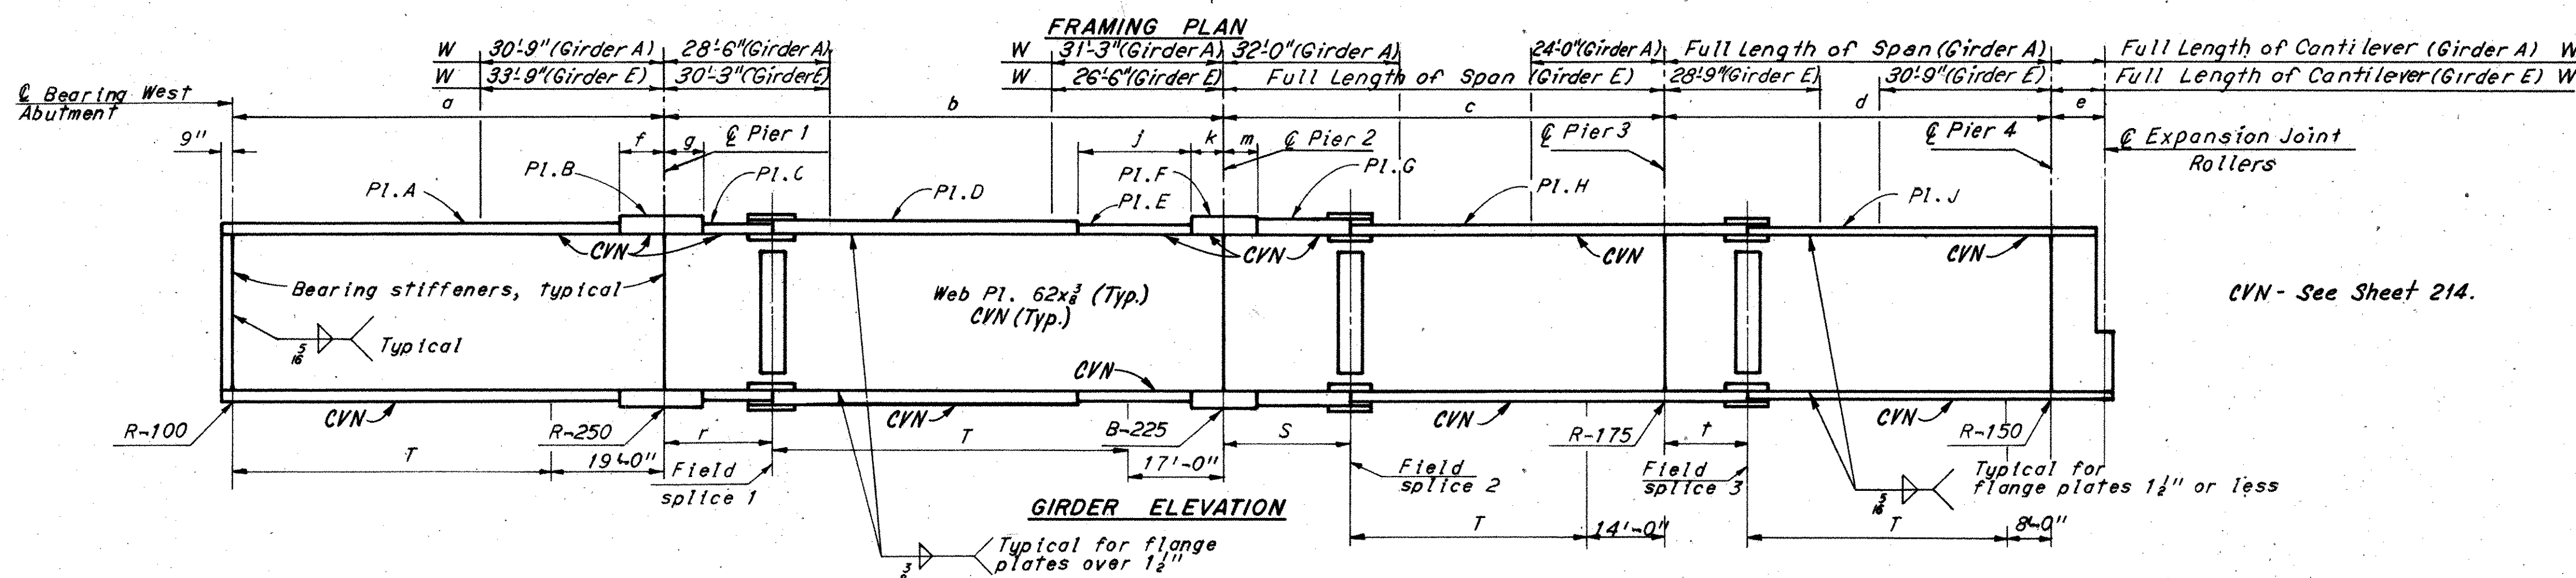

CVN - See Sheet 214.

Note:
Tension areas of bottom flange are denoted by "T". For the top flange, these areas are in compression.
"W" denotes the range where welded attachment cannot be made to the top flange of Girders A and E.

TABLE OF DIMENSIONS

Girder	a	b	c	d	e	f	g	h	i	j	k	m	n	o	p	q	r	s	t
A	71'-8 1/2"	94'-3 3/8"	81'-1 1/8"	60'-0 1/2"	10'-0 3/8"	8'-0"	7'-0"			20'-0"	6'-0"	6'-0"					18'-5 1/4"	20'-6 1/4"	17'-0 1/8"
B	74'-9 5/8"	97'-11 3/8"	80'-11 3/8"	62'-0 1/2"	9'-11 3/8"	6'-0"	8'-0"			18'-0"	8'-0"	5'-0"					19'-2 3/8"	21'-10 1/4"	16'-3 3/8"
C	77'-11 3/4"	101'-7 3/8"	80'-9 1/2"	64'-0 1/2"	9'-11 3/8"	8'-0"	10'-0"			19'-0"	7'-0"	5'-0"					19'-11 3/8"	23'-2 3/8"	15'-7 3/8"
D	81'-1 1/8"	105'-3 3/8"	80'-7"	65'-11 3/8"	9'-11 3/8"	7'-0"	7'-0"			25'-0"	5'-0"	6'-0"					20'-8 3/8"	24'-5 3/8"	14'-11 3/8"
E	84'-3 3/8"	108'-11 3/4"	80'-5 1/2"	67'-11 3/8"	9'-11 3/8"	9'-0"	9'-0"			23'-0"	7'-0"	6'-0"					21'-5 3/4"	25'-9 3/4"	14'-3 3/8"

TOP OF PORTLAND CEMENT CONCRETE ELEVATIONS

Girder	ℓ Brg. W. Abut.	.25	.50	.75	ℓ Pier 1	* .25	.50	.75	ℓ Pier 2	* .25	.50	.75	ℓ Pier 3	* .25	.50	.75	ℓ Pier 4	* .25	.50	.75	ℓ Pier 4	ℓ Exp. J. Roller
A	1042.78	1043.44	1044.15	1044.90	1045.66	1046.44	1047.65	1048.65	1049.64	1050.51	1051.36	1052.21	1053.07	1053.79	1054.34	1054.97	1055.61	1056.03				
B	1043.37	1044.05	1044.78	1045.55	1046.32	1047.12	1048.35	1049.36	1050.38	1051.28	1052.05	1052.89	1053.73	1054.40	1055.01	1055.65	1056.29	1056.71				
C	1043.96	1044.65	1045.40	1046.19	1046.98	1047.79	1049.04	1050.07	1051.10	1052.04	1052.74	1053.56	1054.38	1055.01	1055.68	1056.32	1056.97	1057.38				
D	1044.55	1045.26	1046.02	1046.83	1047.63	1048.46	1049.73	1050.78	1051.82	1052.80	1053.43	1054.29	1055.03	1055.62	1056.34	1057.00	1057.65	1058.05				
E	1044.55	1045.27	1046.05	1046.87	1047.69	1048.53	1049.82	1050.88	1051.95	1052.95	1053.51	1054.30	1055.08	1055.64	1056.41	1057.07	1057.73	1058.12				

* Elevations given are at field splice.

TOP OF PORTLAND CEMENT CONCRETE AT GUTTERLINE

	£ Bearing W. Abut.	0.25	0.50	0.75	£ Pier 1	0.25	0.50	0.75	£ Pier 2	0.25	0.50	0.75	£ Pier 3	0.25	0.50	0.75	£ Pier 4	£ Exp. Jt. Rollers
North Gutter- line	1042.78	1043.45	1044.16	1044.90	1045.66	1046.67	1047.67	1048.66	1049.64	1050.51	1051.37	1052.22	1053.07	1053.70	1054.34	1054.97	1055.61	1056.03
South Gutter- line	1044.55	1045.29	1046.07	1046.88	1047.69	1048.78	1049.86	1050.90	1051.95	1052.73	1053.51	1054.30	1055.08	1055.75	1056.42	1057.08	1057.73	1058.12

TABLE OF GIRDER SPACINGS



	£ Brg. W Abutment	£ Pier 1	Field Splice 1	£ Pier 2	Field Splice 2	£ Pier 3	Field Splice 3	£ Pier 4	£ Exp. Jt. Roller
A	5'-3"	5'-4 ¹¹ / ₁₆ "	5'-5 ¹ / ₂ "	5'-9 ³ / ₈ "	6'-1 ³ / ₈ "	5'-4 ⁷ / ₁₆ "	5'-3 ³ / ₈ "	5'-6 ¹ / ₂ "	5'-5 ³ / ₈ "
B	7'-1 ¹ / ₂ "	7'-3 ³ / ₄ "	7'-4 ⁵ / ₁₆ "	7'-10 ³ / ₈ "	8'-3 ⁵ / ₈ "	7'-3 ⁵ / ₁₆ "	7'-1 ¹ / ₁₆ "	7'-5 ¹ / ₁₆ "	7'-4 ⁵ / ₁₆ "
C	7'-1 ¹ / ₂ "	7'-3 ¹¹ / ₁₆ "	7'-4 ³ / ₄ "	7'-10 ³ / ₈ "	8'-3 ¹ / ₈ "	7'-3 ³ / ₈ "	7'-1 ¹ / ₁₆ "	7'-5 ¹ / ₂ "	7'-4 ³ / ₄ "
D	7'-1 ¹ / ₂ "	7'-3 ⁹ / ₁₆ "	7'-4 ⁵ / ₈ "	7'-10 ³ / ₈ "	8'-2 ⁷ / ₈ "	7'-3 ¹ / ₄ "	7'-1 ¹ / ₁₆ "	7'-5 ³ / ₈ "	7'-4 ⁵ / ₈ "
E	7'-1 ¹ / ₂ "	7'-3 ¹ / ₂ "	7'-4 ¹ / ₂ "	7'-9 ¹ / ₂ "	8'-1 ¹ / ₂ "	7'-3 ¹ / ₂ "	7'-1 ¹ / ₁₆ "	7'-5 ³ / ₈ "	7'-4 ¹ / ₁₆ "

SEP 14 1996

FED. ROAD DIV. NO.	STATE	FEDERAL AID PROJECT NO.	TYPE FUNDS
2	OHIO		




STARK COUNTY
STA-30-14.12
STA-77-9.22

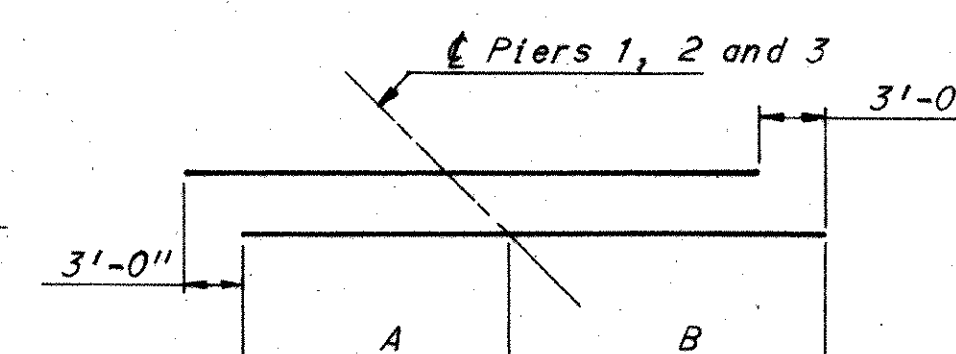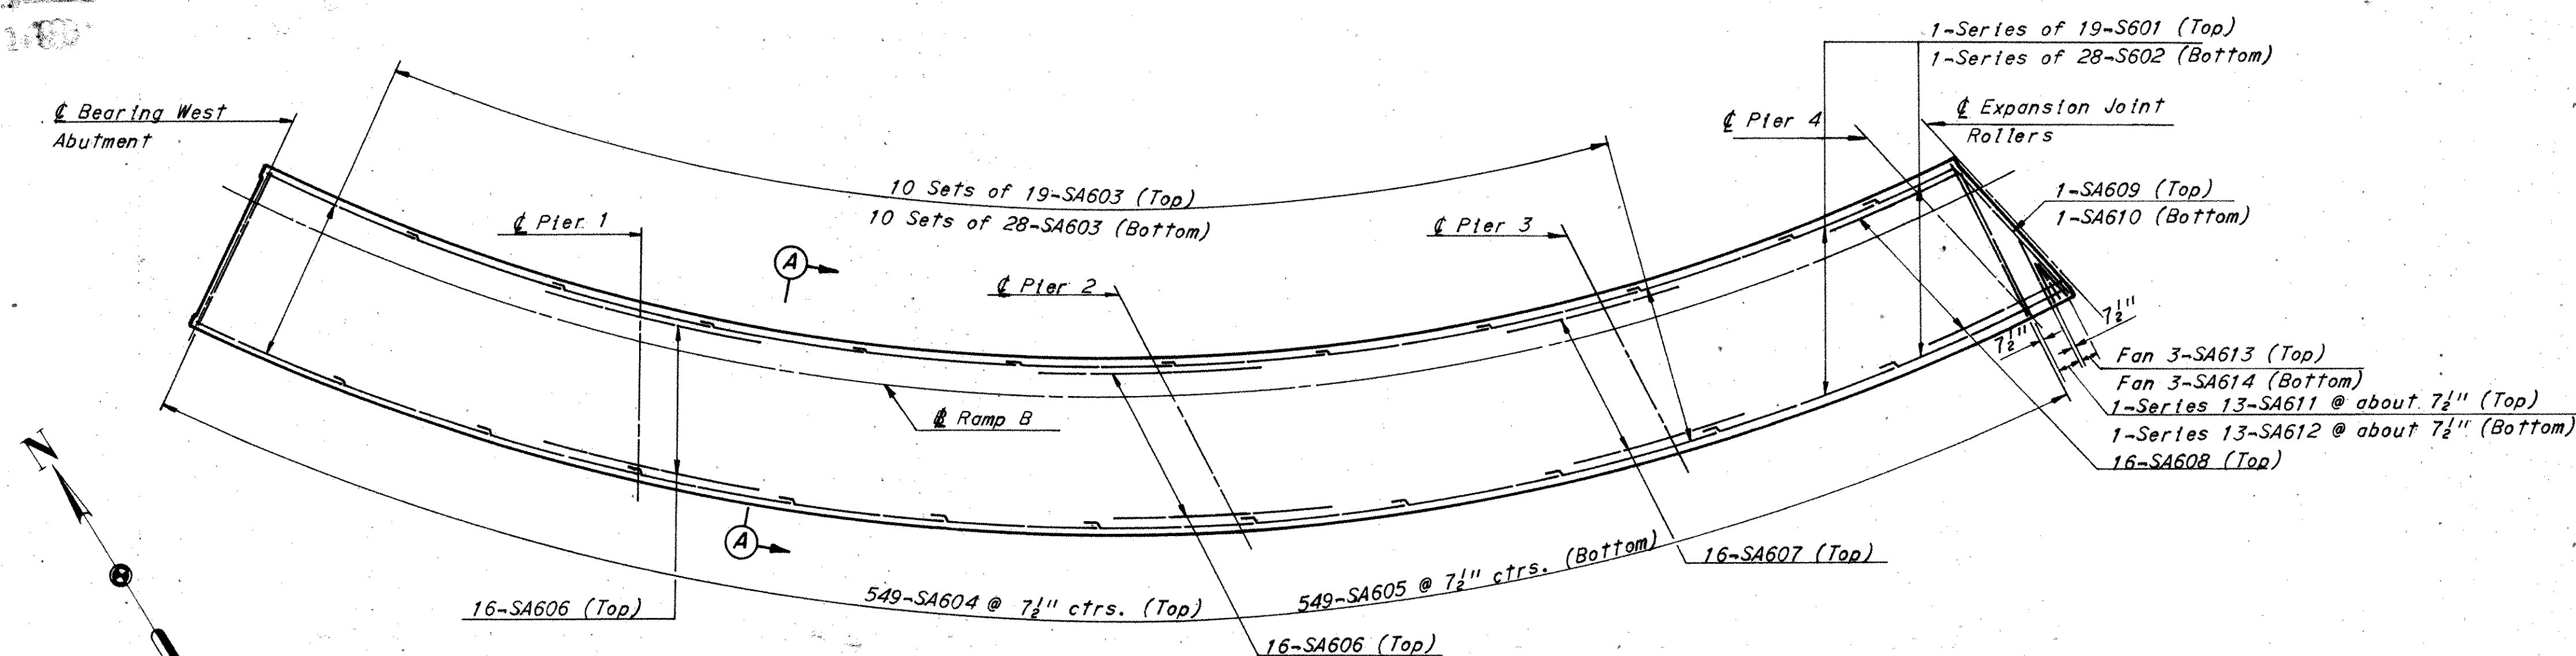

DIAGRAMS SHOWING STAGGER OF
NO. 6 BARS OVER PIERS


	A	B
Pier 1	20'-6"	21'-6"
Pier 2	16'-6"	25'-6"
Pier 3	14'-6"	17'-6"

DECK PLAN

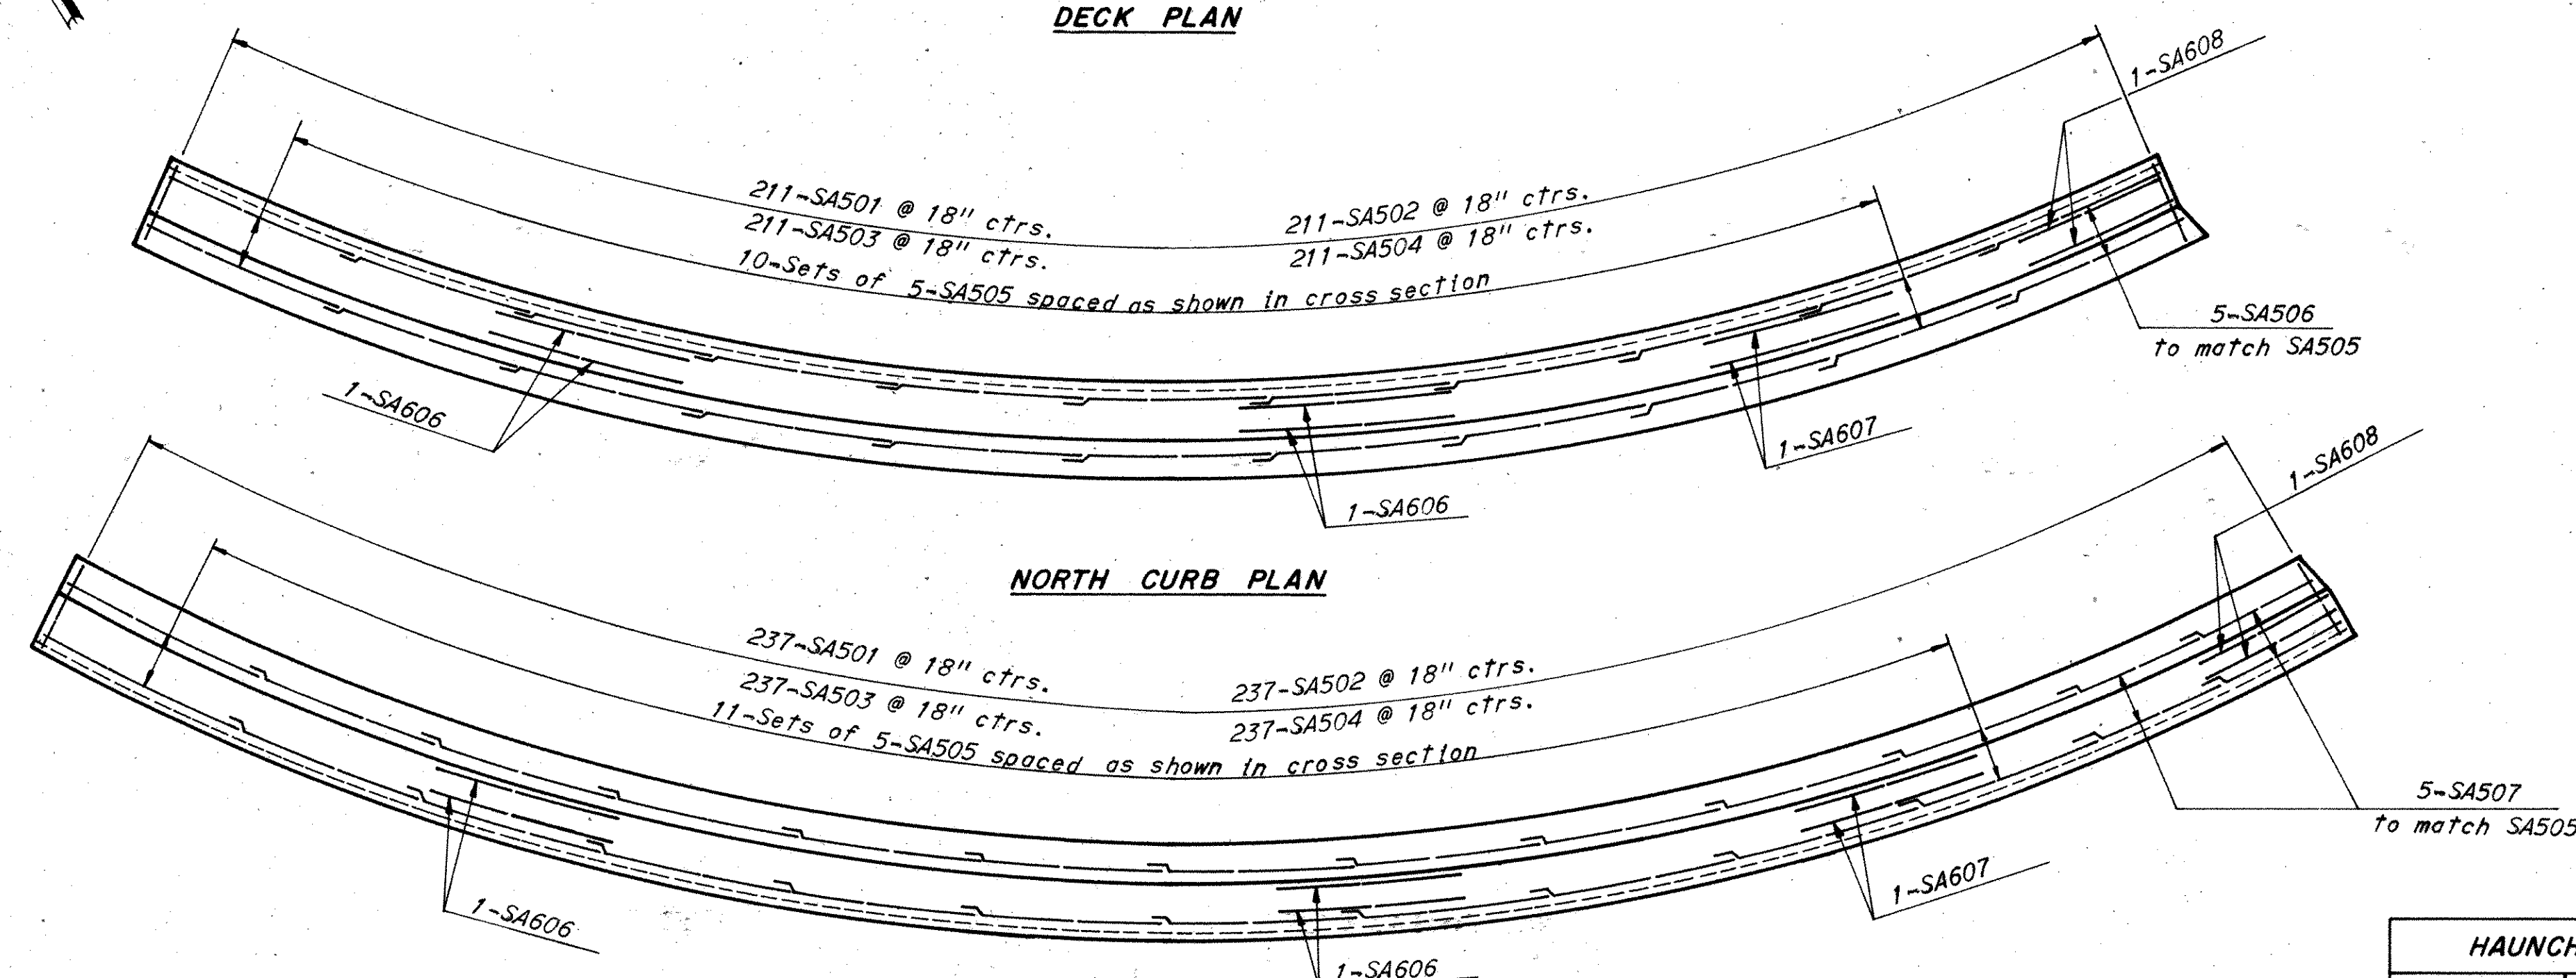

NORTH CURB PLAN

SOUTH CURB PLAN

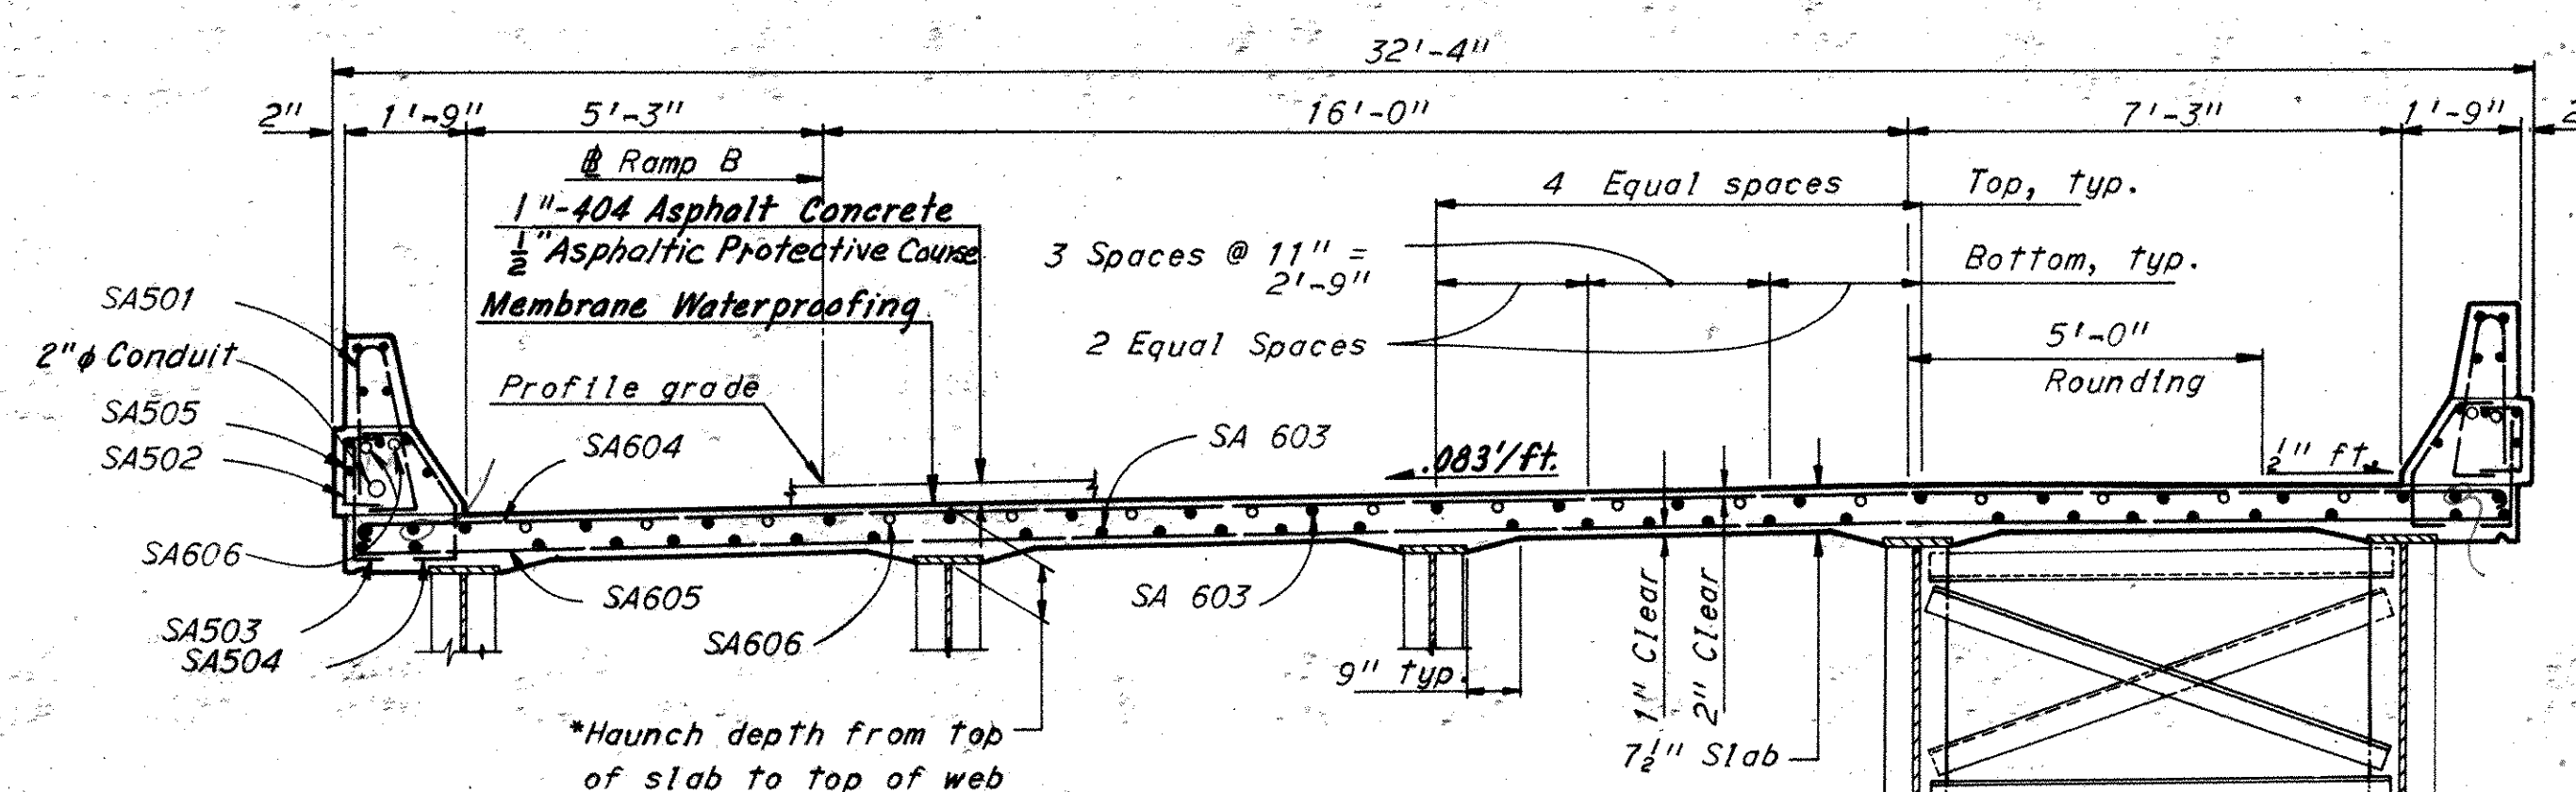

SECTION A - A

HAUNCH DEPTHS	
Girder	Haunch Depth
A	9 $\frac{3}{4}$ "
B	9 $\frac{3}{4}$ "
C	10 $\frac{1}{4}$ "
D	10 $\frac{1}{4}$ "
E	10 $\frac{1}{4}$ "

Notes:

Reinforcing steel shall be adjusted as required to clear scuppers.

A typical haunch width of 9" shall be used for computing quantity of concrete. However, the haunch width may vary between 6" and 12" provided that the slope shall be not more than 1:4 for a haunch less than 9" in width.

For concrete railing details see Sheet 361
For deflection joint details see Sheet 361
For Superelevation Data see Sheet 13/16
For reinforcement schedule see Sheet 16/16

Transverse reinforcing steel shall be placed radially along South edge of slab.

Concrete shall be placed from the expansion joint to Pier 5 before any concrete is placed from the expansion joint to Pier 3.

For subdrainage details, see Sheet 365A.

*This is the nominal dimension. The quantity of deck concrete to be paid for shall be based on this dimension, even though deviation from it may be necessary because the top flange of the girder may not have the exact camber or conformation required to place it parallel to the finished grade. Deduction shall be made for volume of encased steel plates as per Sec. 511.18 of the Construction and Materials Specifications.

H.N.T.B. BRIDGE NO. 14 Revised 6-25-75 By RAS

HOWARD, NEEDLES, TAMMEN & BERGENDOFF 11/16
CONSULTING ENGINEERS
KANSAS CITY CLEVELAND NEW YORK

DECK PLAN UNIT 1

RAMP B OVER RAMPS C AND G,
I-77-AND PENN. R.R.

BR. NO. STA. 30+1489 STA. 958 + 78.75
SCALE: 1" = 20' - 0" STA. 966 + 30.88

RELOCATED U.S. 30

CANTON		STARK COUNTY		OHIO	
DRAWN KSS DATE 2-10-70	TRACED DATE	CHECKED DNB DATE 6-11-70	REVIEWED MJK DATE 11-20-71	REVISED 3-2-76	1668

Revised 4-28-77

STARK COUNTY STA-30-14.12 STA-77-9.22

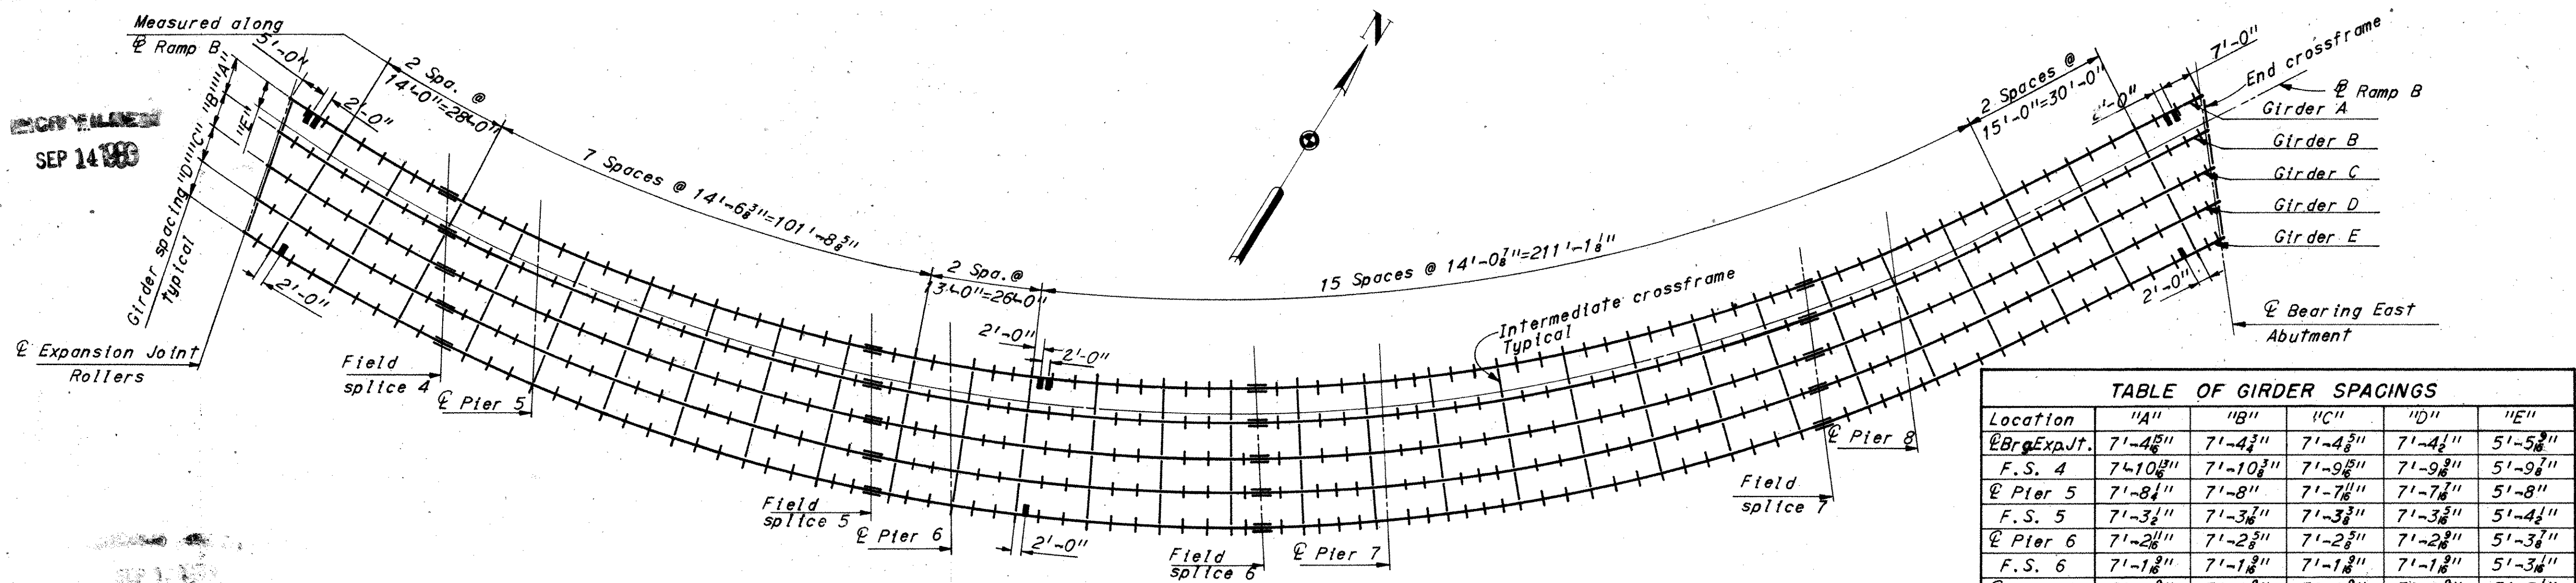


TABLE OF GIRDER SPACINGS					
Location	"A"	"B"	"C"	"D"	"E"

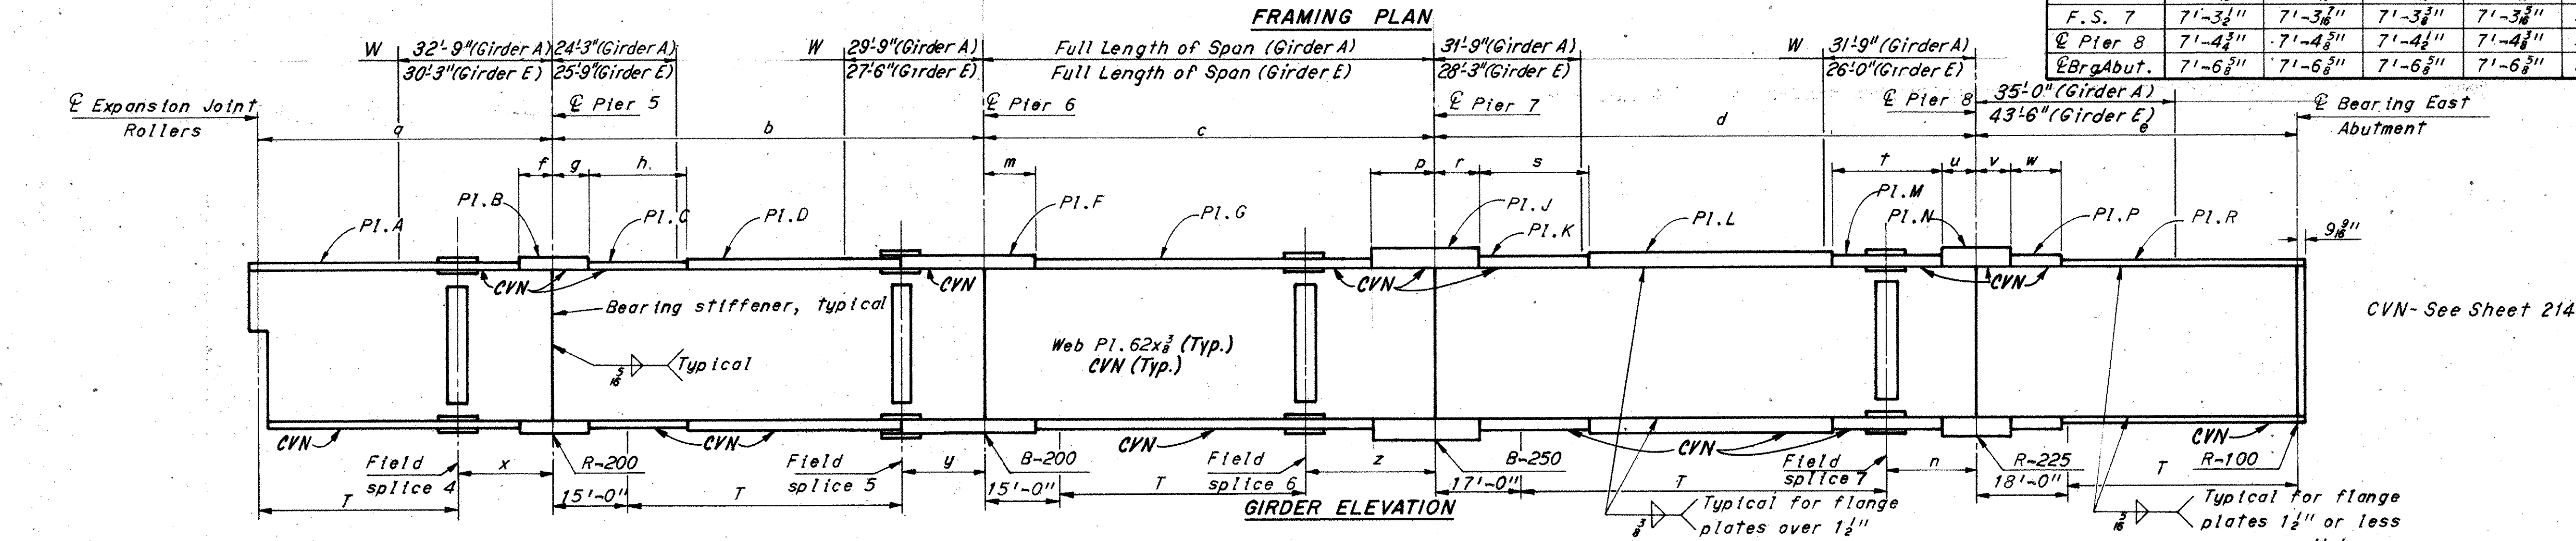


TABLE OF DIMENSIONS

Girder	a	b	c	d	e	f	g	h	m	n	p	r	s	t	u	v	w	x	y	z
A	59'-5 1/2"	90'-4 1/2"	89'-9 1/2"	110'-0 1/2"	72'-0 1/2"	8'-0"	7'-0"	21'-0"	9'-0"	19'-6 3/4"	8'-6"	8'-0"	33'-0"	31'-0"	10'-0"	6'-0"	9'-0"	21'-0 1/2"	17'-0 1/2"	26'-0"
B	61'-6 3/4"	90'-6 1/2"	90'-1 1/2"	110'-7 1/2"	71'-11 1/2"	9'-0"	8'-0"	15'-0"	9'-0"	19'-5 5/8"	11'-6"	9'-0"	20'-0"	21'-0"	8'-0"	7'-0"	10'-0"	20'-11 1/2"	16'-11 1/2"	26'-0"
C	63'-7 1/2"	90'-8 1/2"	90'-5 1/2"	111'-2 1/2"	71'-11 1/2"	7'-0"	5'-0"	22'-0"	9'-0"	19'-5 1/2"	13'-0"	9'-0"	22'-0"	22'-0"	7'-0"	7'-0"	8'-0"	20'-10 1/2"	16'-11 1/2"	26'-0"
D	65'-8 1/2"	90'-10 1/2"	90'-8 1/2"	111'-9 1/2"	71'-10 1/2"	8'-0"	8'-0"	19'-0"	10'-0"	19'-5 3/4"	12'-6"	10'-0"	18'-0"	21'-0"	7'-0"	7'-0"	10'-0"	20'-9 1/2"	16'-11 1/2"	26'-0"
E	67'-9 1/2"	91'-0 1/2"	91'-0 1/2"	112'-5 1/2"	71'-10"	8'-0"	7'-0"	20'-0"	10'-0"	19'-5 1/2"	13'-0"	9'-0"	22'-0"	22'-0"	7'-0"	7'-0"	10'-0"	20'-9 1/2"	16'-11 1/2"	26'-0"

* Elevations given are at field splice.

TOP OF PORTLAND CEMENT CONCRETE ELEVATIONS

Girder	Exp. Jt. Rollers	.25	.50	*.75	Pier 5	.25	.50	*.75	Pier 6	.25	.50	*.75	Pier 7	.1	.2	.3	.4	.5	.6
A	1056.03	1056.66	1057.28	1057.65	1058.54	1059.49	1060.44	1061.56	1062.19	1062.96	1063.68	1064.24	1064.97	1065.26	1065.54	1065.80	1066.05	1066.29	1066.51
B	1056.71	1057.34	1057.98	1058.38	1059.25	1060.19	1061.12	1062.21	1062.82	1063.58	1064.28	1064.83	1065.51	1065.77	1066.02	1066.25	1066.47	1066.68	1066.87
C	1057.38	1058.02	1058.67	1059.11	1059.96	1060.88	1061.79	1062.85	1063.45	1064.20	1064.89	1065.42	1066.04	1066.28	1066.50	1066.70	1066.90	1067.08	1067.25
D	1058.05	1058.70	1059.35	1059.83	1060.66	1061.57	1062.46	1063.50	1064.08	1064.81	1065.49	1066.01	1066.58	1066.79	1066.98	1067.16	1067.33	1067.48	1067.62
E	1058.12	1058.78	1059.44	1059.96	1060.77	1061.66	1062.53	1063.55	1064.12	1064.84	1065.50	1066.01	1066.56	1066.76	1066.94	1067.11	1067.27	1067.41	1067.54

BEARING STIFFENERS

Girder	Pier 5	Pier 6	Pier 7	Pier 8	E. Abut.
A	5 1/2 x 3/4	5 1/2 x 3/4	5 1/2 x 1	5 1/2 x 1	5 1/2 x 1
B	5 1/2 x 3/4	5 1/2 x 3/4	5 1/2 x 1	5 1/2 x 1	5 1/2 x 1
C	5 1/2 x 3/4	5 1/2 x 3/4	5 1/2 x 1	5 1/2 x 1	5 1/2 x 1
D	5 1/2 x 3/4	5 1/2 x 1	5 1/2 x 1 1/2	5 1/2 x 1 1/2	5 1/2 x 1 1/2
E	5 1/2 x 3/4	5 1/2 x 3/4	5 1/2 x 1 1/2	5 1/2 x 1 1/2	5 1/2 x 1 1/2

TABLE OF PLATES

Girder	Pl. A	Pl. B	Pl. C	Pl. D	Pl. F	Pl. G	Pl. J	Pl. K	Pl. L	Pl. M	Pl. N	Pl. P	Pl. R
A	12 x 1 1/2	12 x 1 1/2	12 x 3/4	12 x 1 1/2	12 x 1 1/2	12 x 1	12 x 1 1/2	12 x 1 1/2	12 x 1 1/2	12 x 1 1/2	12 x 1 1/2	12 x 1 1/2	12 x 3/4
B	12 x 1 1/2	12 x 1 1/2	12 x 3/4	12 x 1 1/2	12 x 1 1/2	12 x 1	12 x 1 1/2	12 x 1 1/2	12 x 1 1/2	12 x 1 1/2	12 x 1 1/2	12 x 1 1/2	12 x 3/4
C	12 x 1 1/2	12 x 1 1/2	12 x 1	12 x 1 1/2	12 x 1 1/2	12 x 1	12 x 1 1/2	12 x 1 1/2	12 x 1 1/2	12 x 1 1/2	12 x 1 1/2	12 x 1 1/2	12 x 3/4
D	12 x 1	12 x 1 1/2	12 x 1	12 x 1 1/2	12 x 1 1/2	12 x 1 1/2	12 x 1 1/2	12 x 1 1/2	12 x 1 1/2	12 x 1 1/2	12 x 1 1/2	12 x 1 1/2	12 x 3/4
E	12 x 1	12 x 1 1/2	12 x 1	12 x 1 1/2	12 x 1 1/2	12 x 1 1/2	12 x 1 1/2	12 x 1 1/2	12 x 1 1/2	12 x 1 1/2	12 x 1 1/2	12 x 1 1/2	12 x 3/4

TOP OF PORTLAND CEMENT CONCRETE ELEVATIONS AT GUTTERLINE

	Exp. Jt. Rollers	.25	.50	.75	Pier 5	.25	.50	.75	Pier 6	.25	.50	.75	Pier 7	.1	.2	.3	.4	.5	.6	.7
North Gutterline	1056.03	1056.67	1057.29	1057.91	1058.54	1059.50	1060.46	1061.35	1062.19	1062.96	1063.69	1064.35	1064.97	1065.27	1065.55	1065.82	1066.08	1066.32	1066.54	1066.74
South Gutterline	1058.12	1058.79	1059.45	1060.11	1060.77	1061.67	1062.55	1063.36	1064.12	1064.84	1065.51	1066.08	1066.56	1066.77	1066.96	1067.14	1067.31	1067.46	1067.58	1067.70
	.8	.9	Pier 8	.25	.50	.75	Br. E. Abut.													
North Gutterline	1066.92	1067.10	1067.25	1067.49	1067.70	1067.86	1067.97													
South Gutterline	1067.79	1067.88	1067.95	1068.05	1068.13	1068.18	1068.18													

Note: The gutterline elevations shown have been adjusted for the dead load deflections caused by the weight of concrete and wearing course, and are the elevations required before the concrete deck is placed. No concrete shall be placed until the screed rails have been set for the entire unit.

Notes: Top and bottom flanges are identical in size. All stiffeners shall be placed normal to girder flanges. All intermediate stiffener to web welds shall be 1/4" continuous fillets on both sides of stiffeners. For detail of field splices see Sheet 355. All intermediate stiffeners shall be Pls. 5x 1/2. Scuppers shall be in accordance with Std. Dwg. SD-1-69 except that scupper pipes shall extend 8" below the bottom of the girders instead of 2". Intermediate stiffeners shall be placed as shown on framing plan, equally spaced between crossframes or crossframes and bearing stiffeners or crossframes and splices.

End crossframe details shall be same as shown on Ohio Standard Drawing SD-1-69, Sheet 1 of 4. For intermediate crossframe details see Sheet 360. All crossframes are intermediate crossframes unless shown otherwise. For details of roadway end dam, see Ohio Standard Drawing SD-1-69, Sheet 1 of 4, and Sheet 359. For details at rockers and bolsters see Ohio Standard Drawing RB-1-55. The girders shall be fabricated to lines parallel to profiles formed by top of pavement elevations directly over girders, plus the camber required to compensate for dead load deflection. The allowance to be made in screed settings to compensate for dead load deflections due to concrete and wearing course, are to be made above or below the top of the pavement elevations as required. Screeds may require further adjustment due to irregularities in fabricated steel. For details of curb plates at concrete bridge railing see Ohio Standard Drawing SD-1-69, Sheet 2 of 4. Tension areas of bottom flange are denoted by "T". For top flange, these areas are in compression. "W" denotes the range where welded attachments cannot be made to the top flange of Girders A and E.

Dimensions to scuppers are measured along centerline of girders. Denotes standard scupper. For details of expansion joint crossframe see Sheet 360. For Camber and Deflection Table see Sheet 365. For expansion joint details see Sheet 356. For detail of intermediate stiffeners see Sheet 360. Tension areas of bottom flange are denoted by "T". For the top flange, these areas are in compression. For underdeck lighting details see Lighting Plans.

H.N.T.B. BRIDGE NO. 14 Revised 6-25-75 By RAS HOWARD, NEEDLES, TAMMEN & BERGENDOFF CONSULTING ENGINEERS KANSAS CITY CLEVELAND NEW YORK

FRAMING PLAN - UNIT 2

RAMP B OVER RAMPS C AND G, I-77 AND PENN. R.R.

BR. NO. STA. 30-1489 STA. 958 + 78.75

SCALE: 1" = 20'-0" STA. 966 + 30.88

RELOCATED U.S. 30

CANTON STARK COUNTY OHIO

DRAWN	CHECKED	REVIEWED	DATE
KSS	DWB	MJA	12-31-69
DATE	DATE	DATE	DATE
12-31-69	5-12-70	1-20-71	1968

STARK COUNTY
STA-30-14.12
STA-77-9.22

2-024



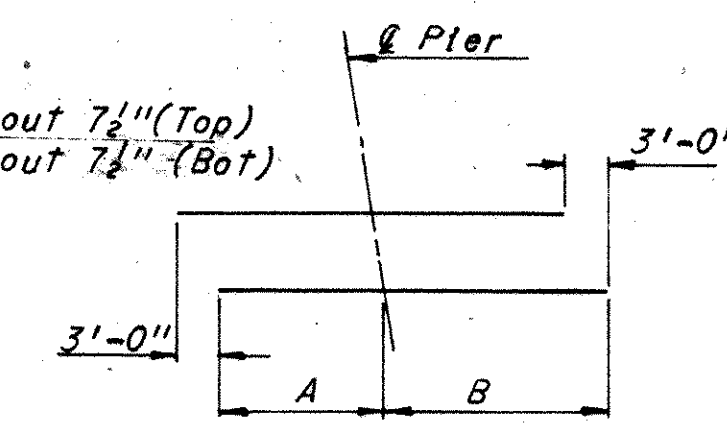


DIAGRAM SHOWING STAGGER OF SB606 AND SB607 BARS OVER PIERS

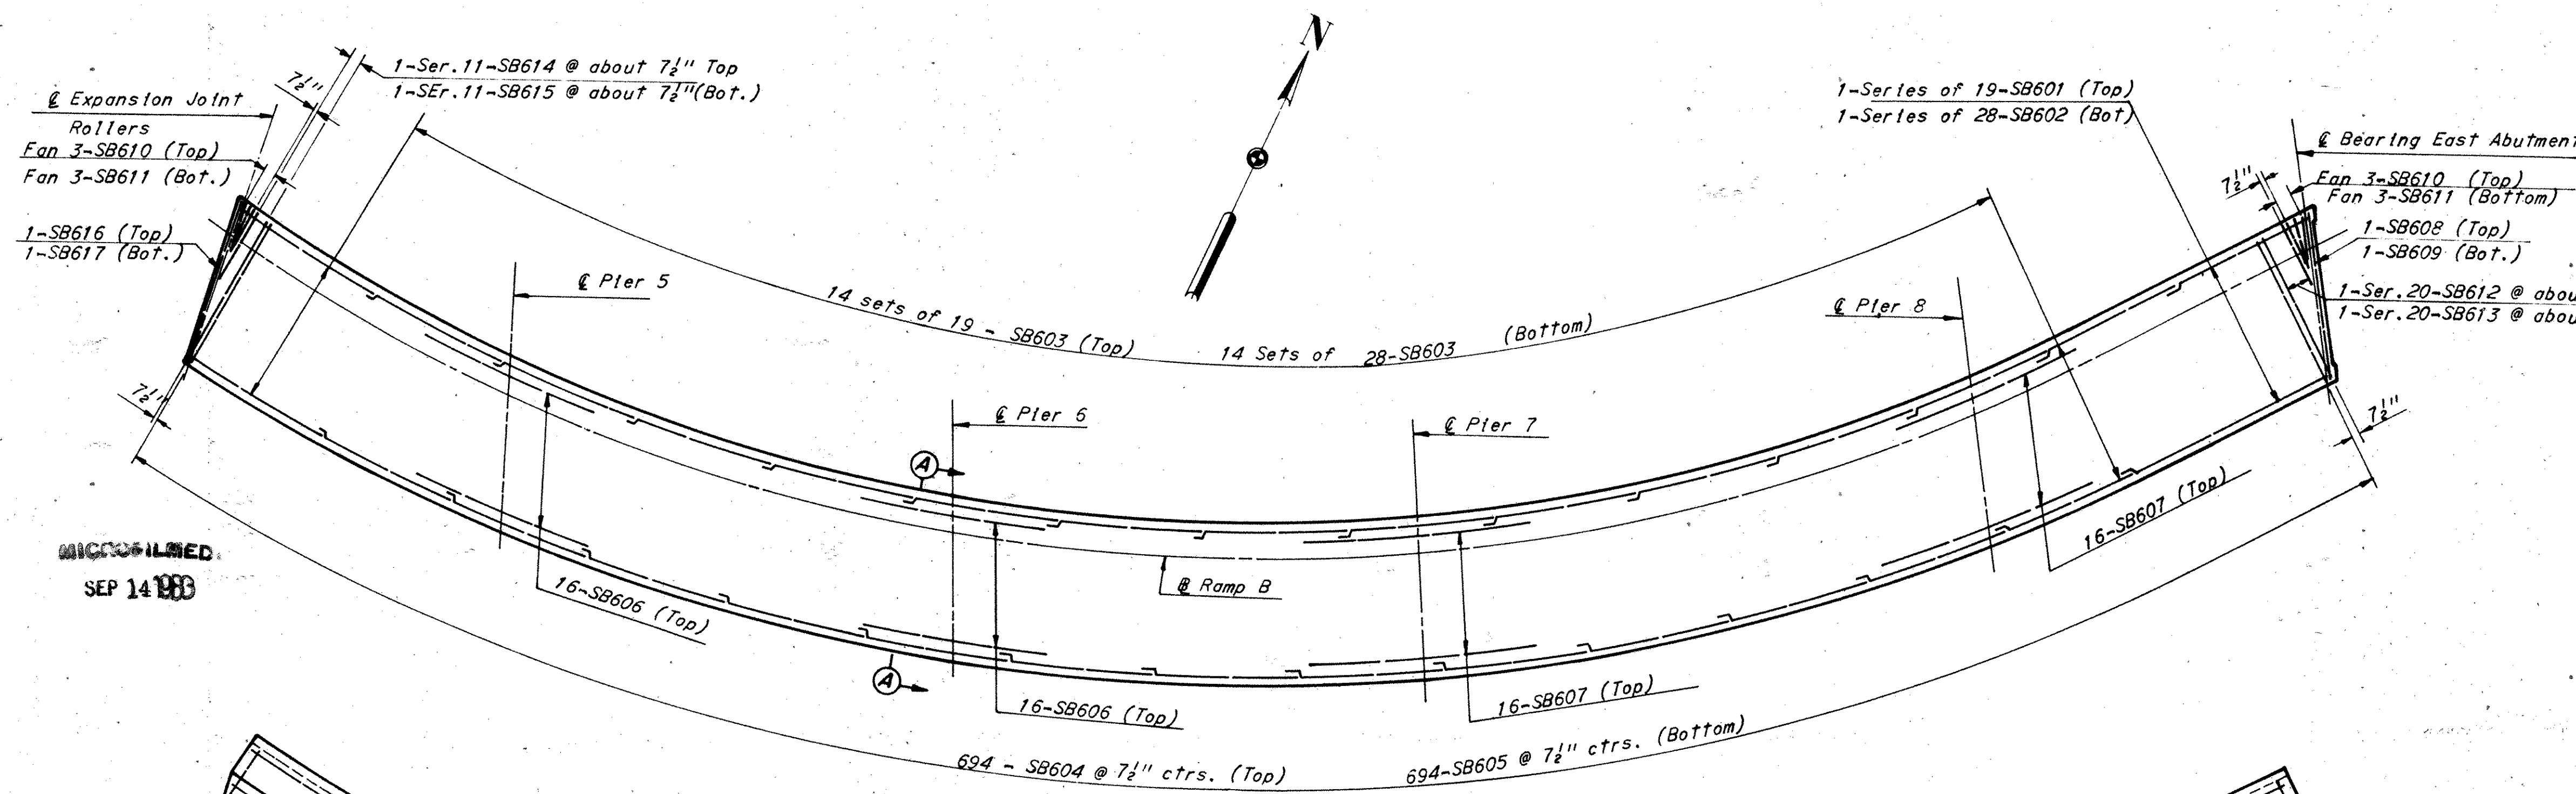
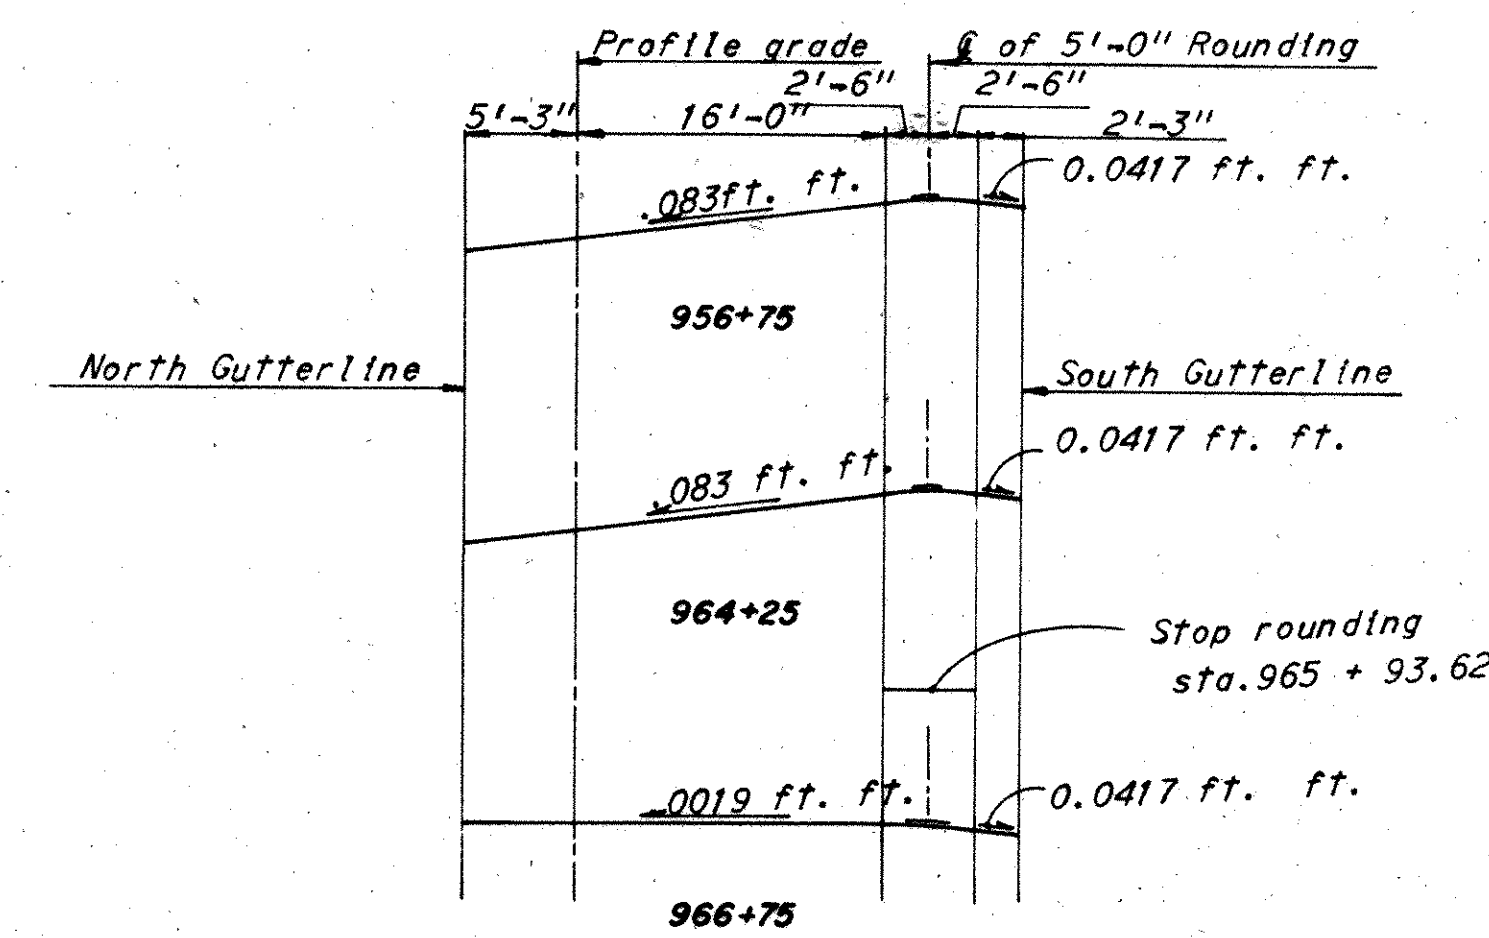


SUPERELEVATION TRANSITION SCHEME

Notes:
Reinforcing steel shall be adjusted as required to clear scuppers.
A typical haunch width of 9" shall be used for computing quantity of concrete. However, the haunch width may vary between 6" and 12" provided that the slope shall be not more than 1:4 for a haunch less than 9" in width.
For concrete railing details see Sheet 361
For deflection joint details see Sheet 361
Transverse reinforcing steel shall be placed radially along South edge of slab.
For reinforcement schedule see Sheet 16/16.
For subdrainage details, see Sheet 365A.

HAUNCH DEPTHS	
Girder	Haunch Depth
A	9 3/4"
B	9 3/4"
C	10 1/4"
D	10 1/4"
E	10 1/4"

*This is the nominal dimension. The quantity of deck concrete to be paid for shall be based on this dimension, even though deviation from it may be necessary because the top flange of the girder may not have the exact camber or conformation required to place it parallel to the finished grade. Deduction shall be made for volume of enclosed steel plates as per Sec. 511.18 of the Construction and Materials Specifications.

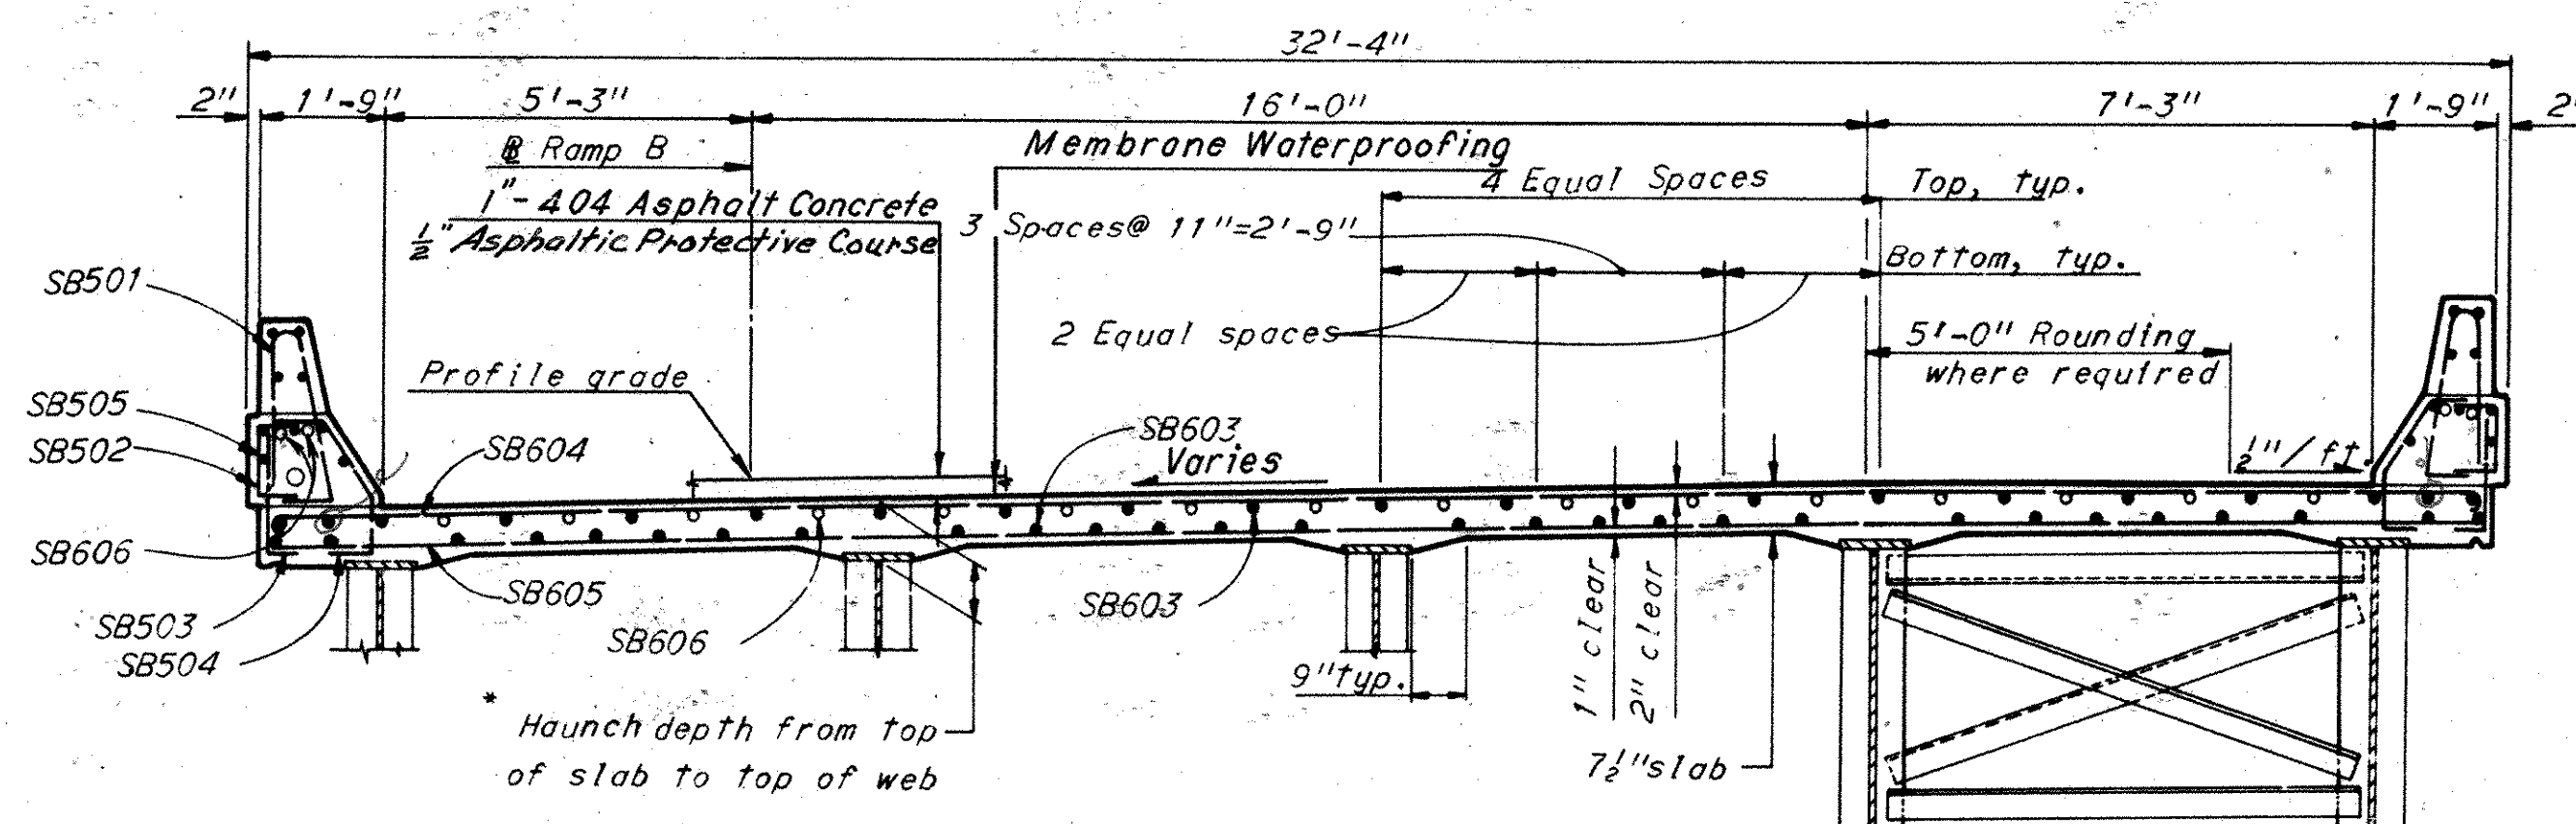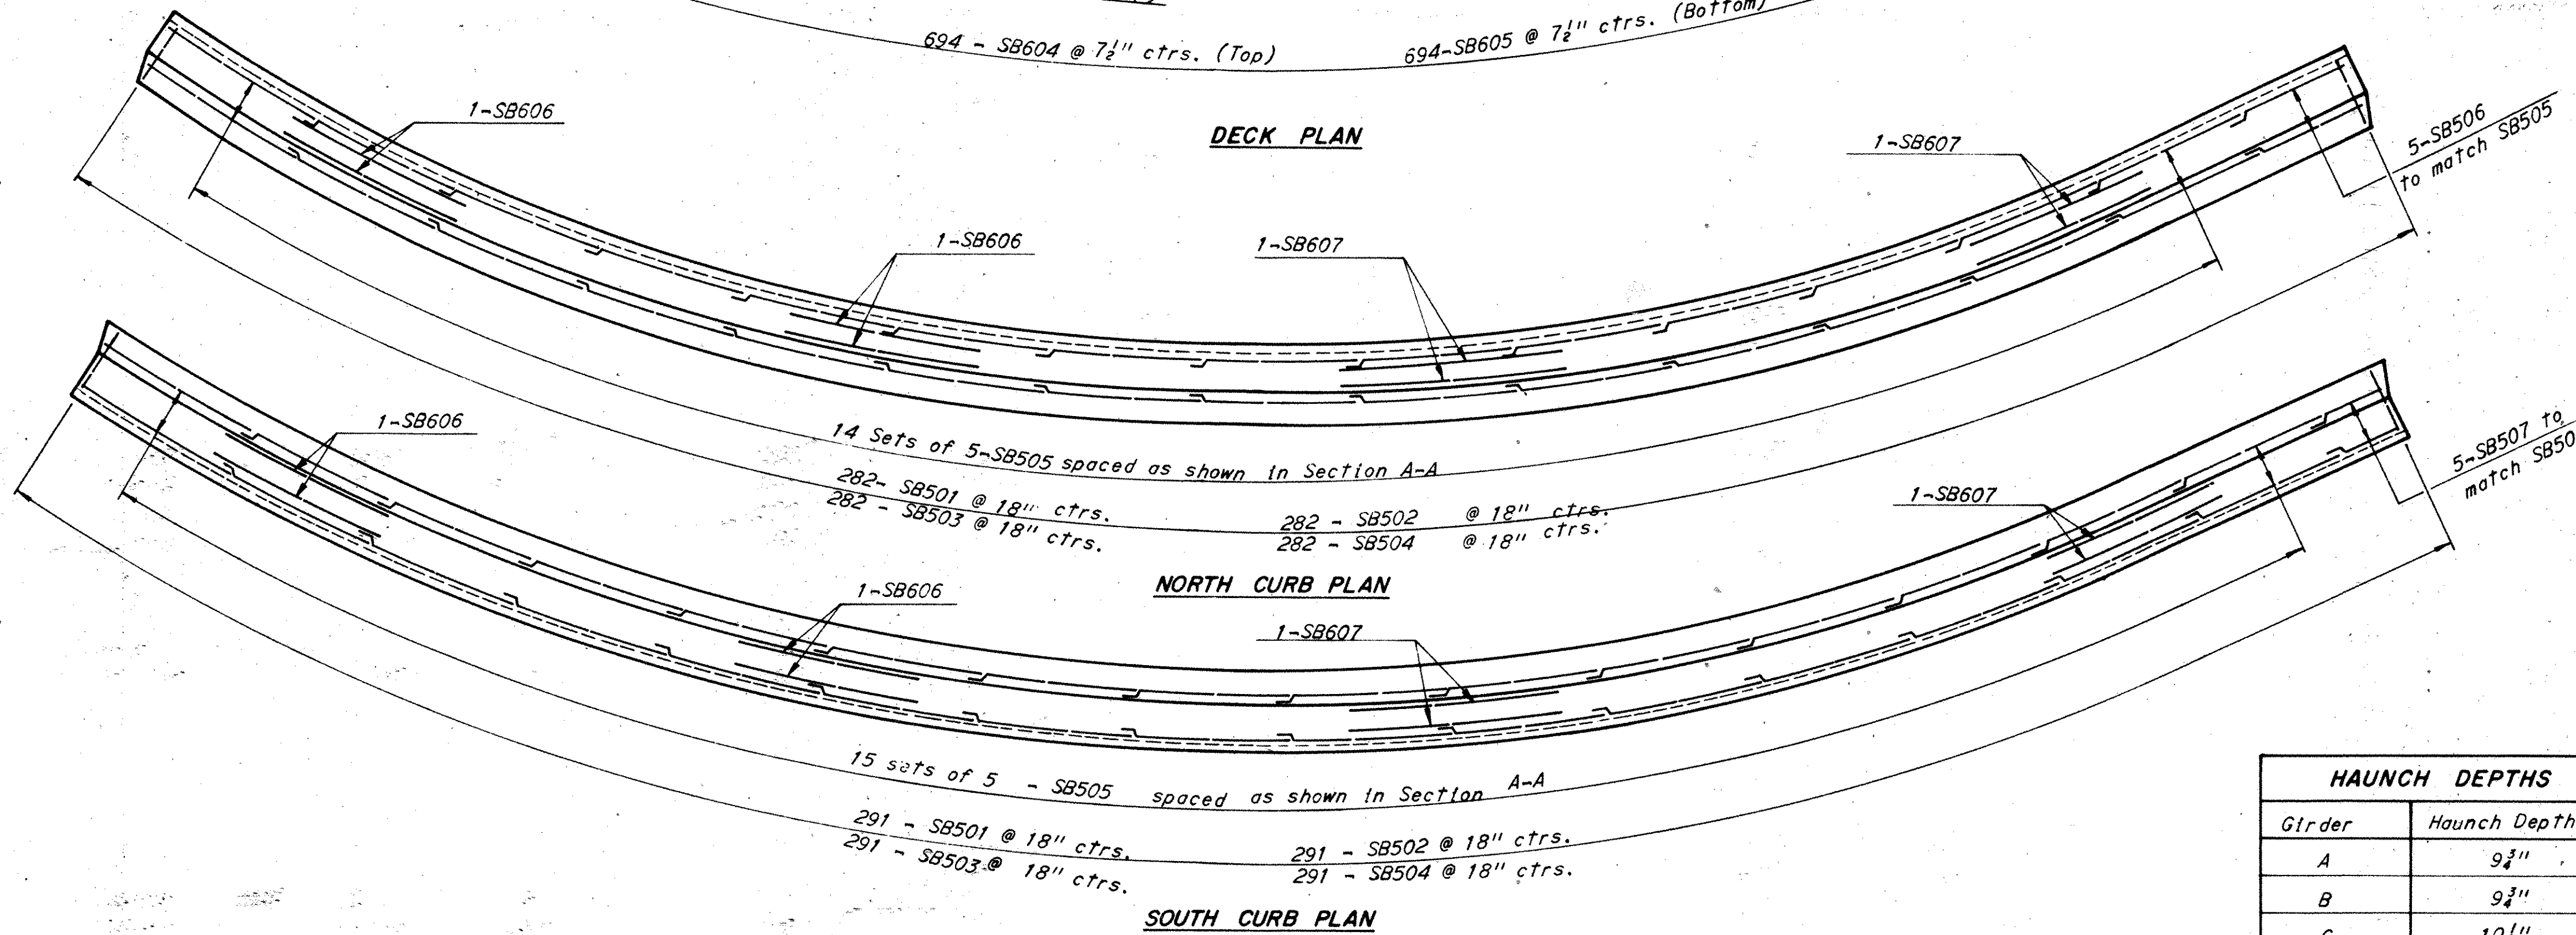

SECTION A-A

H.N.T.B. BRIDGE NO. 14 Revised 625-75 By RAS

HOWARD, NEEDLES, TAMMEN & BERGENDOFF
CONSULTING ENGINEERS
KANSAS CITY CLEVELAND NEW YORK

DECK PLAN UNIT 2
RAMP B OVER RAMPS C AND G
I-77 AND PENN. R.R.

BR. NO. STA 30-1489 STA 958 + 78.75
SCALE: 1" = 20'-0" STA 966 + 30.88

RELOCATED U.S. 30

CANTON STARK COUNTY OHIO

DRAWN KSS	TRACED	CHECKED MJD	REVIEWED	REVISION
DATE 2-10-70	DATE	DATE 6-11-70	DATE 11-20-71	3-2-76

1668

Revised 4-28-77

MARK	NUMBER		LENGTH	TYPE	DIMENSIONS			SERIES INCRE.	WEIGHT POUNDS
					A	B	C		
					WEST ABUTMENT				
AA401	30		3'-5"	105	1'-0"	1'-8"			69
AA501	10		11'-6"	109	3'-0"	2'-6"			120
AA502	20		8'-4"	105	1'-7"	5'-5"			174
AA503	20		7'-8"	104	6'-9"	1'-0"			160
AA504	20		7'-2"	105	2'-0"	3'-5"			150
AA505	19		31'-2"	Str.					618
AA509	20		7'-0"	108	6'-0"	1'-0"	8 1/2"		146
AA510	24		3'-11"	104	2'-0"	2'-0"			98
AA511	20		2'-9"	Str.					57
AA512	15		6'-7"	114	3'-2"				103
AA513	24		2'-2"	105	7 1/2"	1'-2"			54
AA514	1 Ser. 5	6'-8"	to 3'-11"	Str.			8 1/2"		28
AA515	7		7'-6"	Str.					55
AA516	1		3'-6"	Str.					4
AA517	2		7'-0"	Str.					15
AA518	2		11'-6"	Str.					24
AA519	12		16'-8"	Str.					208
AA520	2		12'-6"	Str.					26
AA521	2		9'-8"	Str.					20
AA522	4		10'-8"	Str.					44
AA523	4		6'-11"	Str.					29
AA524	2		10'-8"	108	1'-11"	8'-9"	4'-0"		22
AA525	8		14'-8"	Str.					122
AA526	4		7'-11"	Str.					33
AA527	4		4'-3"	Str.					18
AA601	2		16'-4"	109	5'-5"	2'-6"			49
AA602	20		14'-6"	106	5'-5"	6'-8"	2'-8"		440
AA605	30		5'-8"	105	2'-6"	11"			255
AA606	30		16'-4"	105	7'-7"	1'-5"			736
AA607	30		4'-2"	105	1'-6"	1'-5"			188
AA608	7		8'-8"	115	7'-0"	9"			91
AA609	7		19'-0"	105	9'-1"	1'-2"			200
AA610	1		7'-7"	104	6'-9"	1'-0"			11
AA611	1		7'-6"	104	6'-8"	1'-0"			11
AA612	1 Ser. 9	3'-8"	to 8'-0"	Str.			6 1/2"		79
AA613	7		8'-11"	115	7'-2"	9"			94
AA614	7		7'-6"	Str.					79
AA615	2		7'-0"	Str.					21
AA616	4		14'-8"	Str.					88
AA617	2		9'-6"	Str.					29
AA618	2		9'-4"	Str.					28
AA619	1 Ser. 4	14'-8"	to 8'-10"	Str.			14 1/2"		71
AA620	7		18'-4"	105	8'-9"	1'-2"			193
AA621	1		4'-11"	115	3'-3"	9"			7
AA622	1		5'-5"	115	3'-9"	9"			8
AA623	1		5'-11"	115	4'-3"	9"			9
AA624	1		6'-6"	115	4'-9"	9"			10
AA625	1		7'-0"	115	5'-3"	9"			11
AA626	1		7'-6"	115	5'-9"	9"			11
AA627	1		8'-0"	115	6'-3"	9"			12
AA628	1		8'-6"	115	6'-9"	9"			13
AA629	1		9'-0"	115	7'-4"	9"			14
AA701	1		4'-8"	115	3'-0"	9"			10
AA702	1		8'-1"	115	6'-3"	9"			17
AA703	1		7'-2"	115	5'-6"	9"			15
AA704	1		6'-6"	115	4'-10"	9"			13
AA705	1		5'-10"	115	4'-2"	9"			12
AA706	1		5'-2"	115	3'-6"	9"			11
DA801	20		5'-2"	141	3'-1				276

MARK	NUMBER	LENGTH	TYPE	DIMENSIONS			SERIES INCR.	WEIGHT POUNDS
				A	B	C		
AA801	7	33'-0"	Str.					618
AA802	6	7'-6"	Str.					120
AA803	6	11'-0"	Str.					177
Total West Abutment =								6424
EAST ABUTMENT								
AB401	30	3'-5"	105	1'-0"	1'-8"			69
AB501	10	7'-6"	Str.					78
AB502	11	3'-2"	108	1'-7"	1'-7"	1'-6"		36
AB503	10	6'-0"	Str.					63
AB504	7	3'-7"	118	1'-7"	6"	1'-6"		26
AB505	4	4'-4"	118	1'-7"	1'-3"	1'-6"		18
AB506	21	32'-0" to 9'	Str.					17700
AB507	26	8'-1"	105	1'-7"	5'-5"			228
AB508	26	7'-8"	104	6'-9"	1'-0"			209
AB509	26	7'-0"	105	1'-11"	3'-5"			190
AB510	19	11'-6"	109	3'-0"	2'-6"			228
AB511	1	13'-0"	109	3'-9"	2'-6"			14
AB513	2	9'-0"	Str.					19
AB514	1	13'-2"	109	3'-10"	2'-6"			14
AB515	14	7'-3"	Str.					106
AB516	1	5'-6"	Str.					6
AB517	1	5'-0"	Str.					5
AB518	1	4'-6"	Str.					5
AB519	1	4'-0"	Str.					4
AB520	5	3'-9"	Str.					20
AB521	21	6'-7"	114	3'-2"	1'-2"			144
AB522	26	2'-2"	105	7 1/2"	1'-2"			59
AB523	10	3'-0"	Str.					31
AB524	32	16'-6"	Str.					551
AB525	2 Ser. 3	9'-0" to 12'-9"	Str.				14 0 1/2"	68
AB526	4	8'-6"	Str.					35
AB527	8	10'-6"	Str.					88
AB528	2	11'-0"	Str.					23
AB529	1 Ser. 3	3'-6" to 5'-0"	Str.				9"	13
AB531	8	10'-3"	Str.					86
AB532	2 Ser. 3	8'-6" to 12'-3"	Str.				14 0 1/2"	65
AB601	26	14'-2"	106	5'-3"	6'-9"	2'-6"		554
AB602	31	15'-7"	105	7'-3"	1'-5"			725
AB603	31	5'-1"	105	2'-0"	1'-5"			237
AB604	31	5'-7"	105	2'-6"	11"			260
AB606	2	7'-4"	104	6'-6"	1'-0"			22
AB607	14	19'-2"	105	9'-2"	1'-2"			402
AB608	14	8'-10"	115	7'-2"	9"			186
AB609	1 Ser. 3	5'-4" to 6'-10"	115	3'-8" to 5'-2"	9"		9"	27
AB610	2	7'-7"	104	6'-9"	1'-0"			24
AB611	3	4'-8"	115	3'-0"	9"			21
AB701	1	6'-4"	115	4'-8"	9"			13
AB702	1	5'-10"	115	4'-2"	9"			12
AB703	1	5'-1"	115	3'-5"	9"			10
AB704	2	5'-0"	115	3'-4"	9"			20
AB705	1	6'-10"	115	5'-2"	9"			14
DB801	20	5'-3"	141	3'-2"				280
AB801	5	34'-6"	Str.					460
AB802	2	11'-3"	108	8'-9"	2'-6"	2'-5"		60

MARK	NUMBER	LENGTH	TYPE	DIMENSIONS			SERIES INCR.	WEIGHT POUNDS
				A	B	C		
AB803	1	11'-6"	108	9'-0"	2'-6"	2'-5"		31
AB804	1	14'-0"	108	11'-6"	2'-6"	2'-5"		37
AB805	2	15'-6"	108	13'-0"	2'-6"	2'-5"		83
AB806	2	7'-9"	Str.					41
AB807	1	8'-6"	Str.					23
AB808	1	13'-3"	Str.					35
AB809	2	15'-4"	104	13'-3"	2'-3"			82
AB810	2	39'-6"	108	39'-3"	2'-3"	9"		1079
Total East Abut. =								7039
PIER 1								
SPA401	1	620'-0"	112	75.1	27'-2"	2'-8"		501
SPA402	1	647'-7"	112	78.4	28'-5"	2'-8"		524
SPA403	1	673'-8"	112	81.6	29'-7"	2'-8"		544
PA501	34	4'-5"	105	1'-0"	2'-8"			157
PA502	22	12'-2"	109	2'-8"	3'-2"			278
PA503	2	2'-11"	105	1'-0"	1'-2"			6
PA504	2	3'-11"	105	1'-0"	2'-2"			8
PA601	8	8'-0"	113	1'-11"	4'-2"	2'-8"		96
PA602	4	29'-6"	Str.					178
PA801	15	10'-8"	100	8'-6"				428
PA901	10	12'-0"	100	9'-6"				408
PA1001	22	12'-4"	100	9'-6"				1171
PA1002	10	13'-4"	100	10'-6"				575
PA1003	5	28'-4"	111	24'-0"	2'-0"			610
PA1004	5	15'-6"	111	11'-2"	2'-0"			334
PA1005	5	29'-6"	Str.					636
PA1006	4	9'-9"	Str.					168
PA1007	2	10'-0"	Str.					86
PA1101	12	16'-8"	100	13'-6"				1062
PA1102	29	8'-3"	104	6'-6"	2'-0"			1270
PA1103	16	30'-9"	Str.					2623
PA1104	13	32'-0"	Str.					2210
PA1105	13	32'-9"	Str.					2260
PA1106	13	8'-6"	104	6'-9"	2'-0"			587
Total Pier 1 =								16,720

SEP 14 1983

141

FED. ROAD DIV. NO.

STATE

FEDERAL AID PROJECT NO.

TYPE FUNDS

2

OHIO

STARK COUNTY

STA-30-14.12

STA-77-9.22

MARK	NUMBER		LENGTH	TYPE	DIMENSIONS			SERIES INCRE.	WEIGHT POUNDS
					A	B	C		
PIER 2									
SPB401	1		730'-1"	112	88.4	32'-2"	2'-8"		589
SPB402	1		761'-4"	112	92.2	33'-7"	2'-8"		616
SPB403	1		790'-10"	112	95.8	34'-11"	2'-8"		640
PB501	34		4'-5"	105	1'-0"	2'-8"			157
PB502	23		12'-2"	109	2'-8"	3'-2"			292
PB503	2		2'-11"	105	1'-0"	1'-2"			6
PB504	2		3'-11"	105	1'-0"	2'-2"			8
PB601	8		8'-0"	113	1'-11"	4'-2"	2'-8"		96
PB602	4		31'-6"	Str.					190
PB801	15		10'-8"	100	8'-6"				428
PB901	12		13'-0"	100	10'-6"				528
PB902	10		12'-0"	100	9'-6"				408
PB1001	5		15'-7"	111	11'-3"	2'-0"			335
PB1002	5		31'-0"	111	27'-0"	2'-0"	1'-9"		674
PB1003	5		31'-7"	Str.					678
PB1004	2		10'-9"	Str.					93
PB1005	3		9'-0"	Str.					116
PB1006	2		11'-9"	Str.					102
PB1101	12		16'-8"	100	13'-6"				1062
PB1102	24		13'-8"	100	10'-6"				1742

MARK	NUMBER	LENGTH	TYPE	DIMENSIONS			SERIES INCRE.	WEIGHT POUNDS
				A	B	C		
		23						16
PC901	19-20	10'-0"	100	9'-6"				840
PC902	9	11'-0"	100	8'-6"				336
PC1001	22	12'-4"	100	9'-6"				1171
PC1002	4	14'-11"	111	10'-7"	2'-0"			256
PC1003	4	28'-6" 3	111	24'-2"	2'-0"	1'-9"		490
PC1004	5	29'-3"	Str.					629
PC1005	3	8'-0"	Str.					103
PC1101	10	14'-8"	100	11'-6"				780
PC1102	25	8'-3"	104	6'-6"	2'-0"			1095
PC1103	14	32'-6"	Str.					2417
PC1104	11	33'-9"	Str.					1970
PC1105	11	34'-6"	Str.					2020
PC1106	11	8'-6"	104	6'-9"	2'-0"			496
					Total	Pier	3 =	14,970
								886
PIER 4								
SPD401	1	563'-0"	112	68.2	24'-7"	2'-8"		455
SPD402	1	645'-6"	112	78.2	28'-4"	2'-8"		522
SPD403	1	706'-7"	112	85.6	31'-1"	2'-8"		571
PD501	34	4'-5"	105	1'-0"	2'-8"			157
PD502	18	12'-2"	109	2'-8"	3'-2"			228
PD503	2	2'-11"	105	1'-0"	1'-2"			6
PD504	2	3'-11"	105	1'-0"	2'-2"			8
PD601	6-6	8'-0"	113	1'-11"	4'-2"	2'-8"		72-69
PD602	4	30'-0"	Str.					180

MARK	NUMBER	LENGTH	TYPE	DIMENSIONS			SERIES INCRE.	WEIGHT POUNDS
				A	B	C		
PIER 5								
SPE401	1	355'-9"	112	43.1	15'-2"	2'-8"		286
SPE402	1	407'-0"	112	49.3	17'-6"	2'-8"		328
SPE403	1	502'-9"	112	60.9	21'-10"	2'-8"		406
PE501	18	12'-2"	109	2'-8"	3'-2"			228
PE502	2	2'-11"	105	1'-0"	1'-2"			6
PE503	2	3'-11"	105	1'-0"	2'-2"			8
PE504	34	4'-5"	105	1'-0"	2'-8"			157
PE601	8	8'-0"	113	1'-11"	4'-2"	2'-8"		96
PE602	4	30'-10"	Str.					185
PE801	13	14'-8"	100	12'-6"				509
PE901	10	12'-0"	100	9'-6"				408
PE1001	12	12'-4"	100	9'-6"				637
PE1002	4	28'-7"	111	24'-9"				491
PE1003	4	13'-0" 7	111	9'-6"	1'-6"	9		230
PE1004	4	30'-10"	Str.					529
PE1005	2	9'-0"	Str.					78
PE1006	17	18'-9"	Str.					1370
PE1007	9	21'-3"	Str.					819
PE1008	11	25'-0"	Str.					1185
PE1009	17	8'-0"	104	6'-3"	2'-0"			582
PE1010	9	8'-3"	104	6'-6"	2'-0"			319
PE1011	4	17'-0"	Str.					291
PE1101	11	11'-8"	100	8'-6"				682

SEP 14 1988

141, 142, 143, 144, 145, 146, 147, 148

338
389

STARK COUNTY
STA-30-14.12
STA-77-9.22

BENDING DIAGRAMS

Notes:

- All bar dimensions are given out to out.
- All bars of a series shall vary in length by a constant increment.
- For replacement reinforcement schedule see sheet 256.
- Four steel channels, tee or angle spacers weighing approximately 0.80 pounds per linear foot shall be provided for each spiral unit. They shall be equally spaced along the periphery of the coil. An allowance of 0.80 pounds per linear foot for spacers is included with the weight of the spiral bars and paid for as reinforcing steel.
- Splices in No. 14 or No. 18 size reinforcing bars shall be made by an approved positive mechanical method designed to develop 125% of the specified yield strength of the bar.

H.N.T.B. BRIDGE NO. 14

HOWARD, NEEDLES, TAMMEN & BERGENDORFF
CONSULTING ENGINEERS

