
plw:\\VANVA01PWINTOL.Parsons.com:Ohio State\Documents\DB-Akron Beltway Rehab\10 - Design\102329\Drainage\Sheets\BU-43\102329_BU-43_CT001.dgn Sheet 7/13/2023 11:54:01 AM p0003246

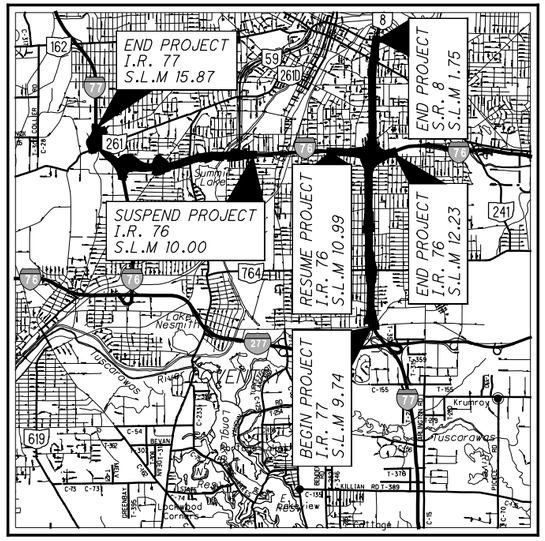

LOCATION MAP

LATITUDE: 41° 03′ 43″ LONGITUDE: 81° 30′ 17″

SCALE IN MILES

0 1 2 3 4

N

PORTION TO BE IMPROVED

INTERSTATE HIGHWAY

FEDERAL ROUTES

STATE ROUTES

COUNTY & TOWNSHIP ROADS

OTHER ROADS

DESIGN DESIGNATION

SEE BU-19

NHS PROJECT *YES*

DESIGN EXCEPTIONS

DESIGN FEATURE	*APPROVAL DATE*	*SHEET NUMBER*
N/A		

UNDERGROUND UTILITIES

Contact Two Working Days Before You Dig

OHIO811.org Before You Dig

OHIO811, 8-1-1, or 1-800-362-2764
(Non-members must be called directly)

PLAN PREPARED BY:

PARSONS

ENGINEERS SEAL:

STATE OF OHIO
FERNANDO RODRIGUEZ
PE.64181
PROFESSIONAL ENGINEER

Digitally signed by Fernando Rodriguez
Date: 2023.07.19 10:04:40-05'00'

STATE OF OHIO

DEPARTMENT OF TRANSPORTATION

SUM-76-8.24
SUM-77-9.74
SUM-8-0.00

CITY OF AKRON

SUMMIT COUNTY

INDEX OF SHEETS:

TITLE	*1*
CULVERT DETAIL	*2*

RECORD DRAWING PLANS

BU-43 - I-76/77 STATION 287+36 CULVERT LINING PLANS

The undersigned hereby confirms that, to the best of their knowledge, all known field modifications made after the Released for Construction plans were sealed by the Designer are included in these drawings.

RSS JV

Joseph J. Buchtinec, Jr., PE

Digitally signed by Joseph J. Buchtinec, Jr., PE
DN: C=US, E=jbuchtinec@shellysandsands.com, O=Shelly and Sands, Inc., OU=Project Manager, CN=Joseph J. Buchtinec, Jr., PE
Date: 2026.07.07 11:43:34-04'00'

Signed: _____ Date: 7/7/2026

The undersigned hereby confirms that, to the best of their knowledge, all presented field changes have been included in the Record Drawings and the Designer concurs that the changes meet the design intent of the Contract.

Parsons Transportation Group, Inc.

Signed: _____ *Fernando Rodriguez*
Design Project Manager

Date: *July 16, 2026*

STANDARD CONSTRUCTION DRAWINGS	*SUPPLEMENTAL SPECIFICATIONS*	*SPECIAL PROVISIONS*
	800-2019 10/16/20	
	832 10/19/18	

ISSUE RECORD:

NO.	DATE	DESCRIPTION

PROJECT DESCRIPTION

PAVEMENT REPLACEMENT OVER SUM - I.R. 76 FROM S.L.M. 8.24 TO 10.00, SUM - 77 FROM S.L.M. 9.74 TO 11.54, AND SUM - 8 FROM S.L.M. 0.00 TO 1.75. COVERS THE "SOUTH LEG" AND "WEST LEG", INCLUDES REHABILITATION OF SEVERAL STRUCTURES IN THE CITY OF AKRON, SUMMIT COUNTY, OHIO.

LIMITED ACCESS

THIS IMPROVEMENT IS ESPECIALLY DESIGNED FOR THROUGH TRAFFIC AND HAS BEEN DECLARED A LIMITED ACCESS HIGHWAY OR FREEWAY BY ACTION OF THE DIRECTOR IN ACCORDANCE WITH THE PROVISIONS OF SECTION 5511.02 OF THE OHIO REVISED CODE.

2019 SPECIFICATIONS

THE STANDARD SPECIFICATIONS OF THE STATE OF OHIO, DEPARTMENT OF TRANSPORTATION, INCLUDING SUPPLEMENTAL SPECIFICATIONS LISTED IN THE PLANS AND CHANGES LISTED IN THE PROPOSAL SHALL GOVERN THIS IMPROVEMENT.

RSS ruhlin SHELLY & SANDS
AKRON BELTWAY JV

BU-43

CULVERT

I-76/77 STA. 287+36

RELEASED FOR CONSTRUCTION
July 13, 2023

FEDERAL PROJECT NO. E180(428)

PID NO. 102329

CONSTRUCTION PROJECT NO. 21-3000

RAILROAD INVOLVEMENT NONE

2025-03-14 - BU-43 - RECORD DRAWING PLANS


SUM-76/77/8-
8.24/9.74/0.00

1/2


pw:\\VANVA01PWINT01.Parsons.com:Ohio State\Documents\DB-Akron Beltway Rehab\10 - Design\102329\Drainage\Sheets\BU-43\102329_BU-43_CD001.dgn Sheet 7/13/2023 11:54:20 AM p00032

BU-43

ISSUE RECORD:		
NO.	DATE	DESCRIPTION

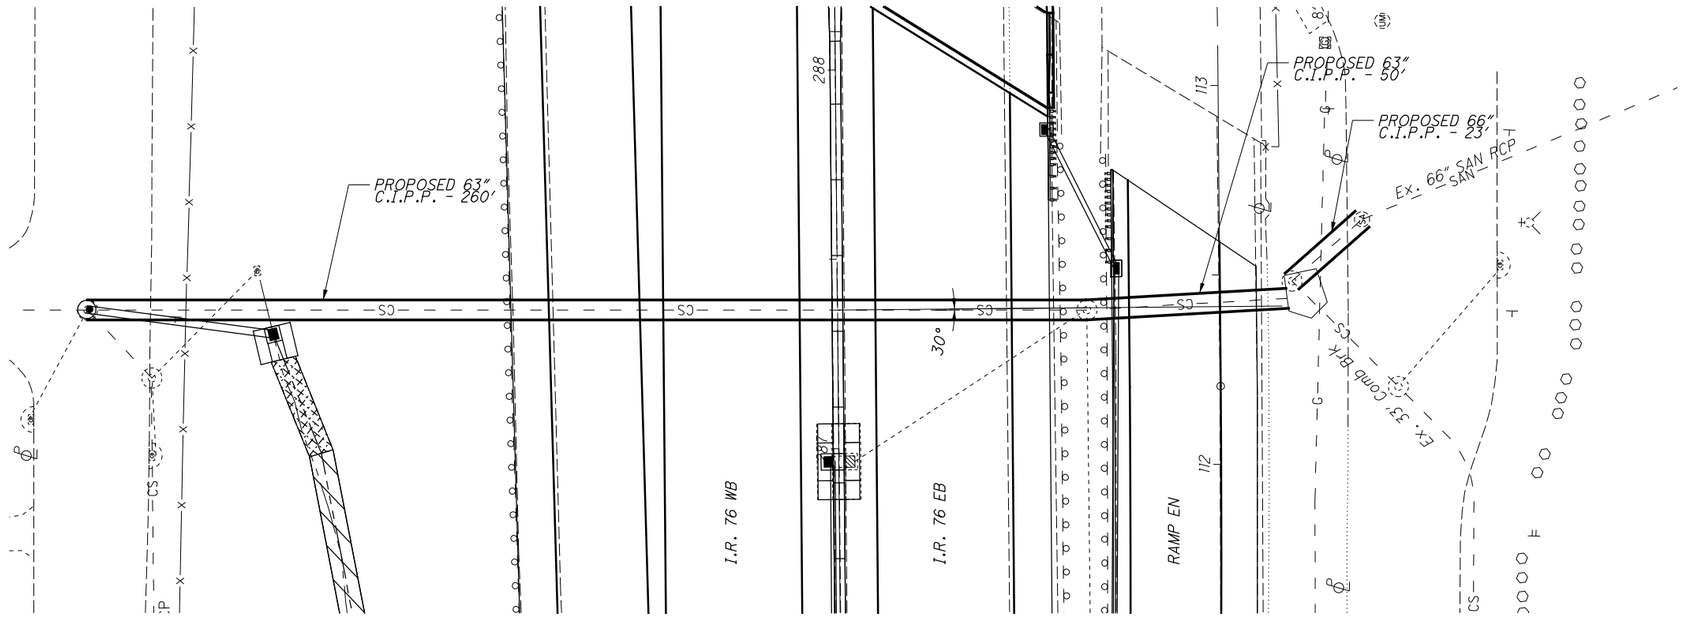

PLAN

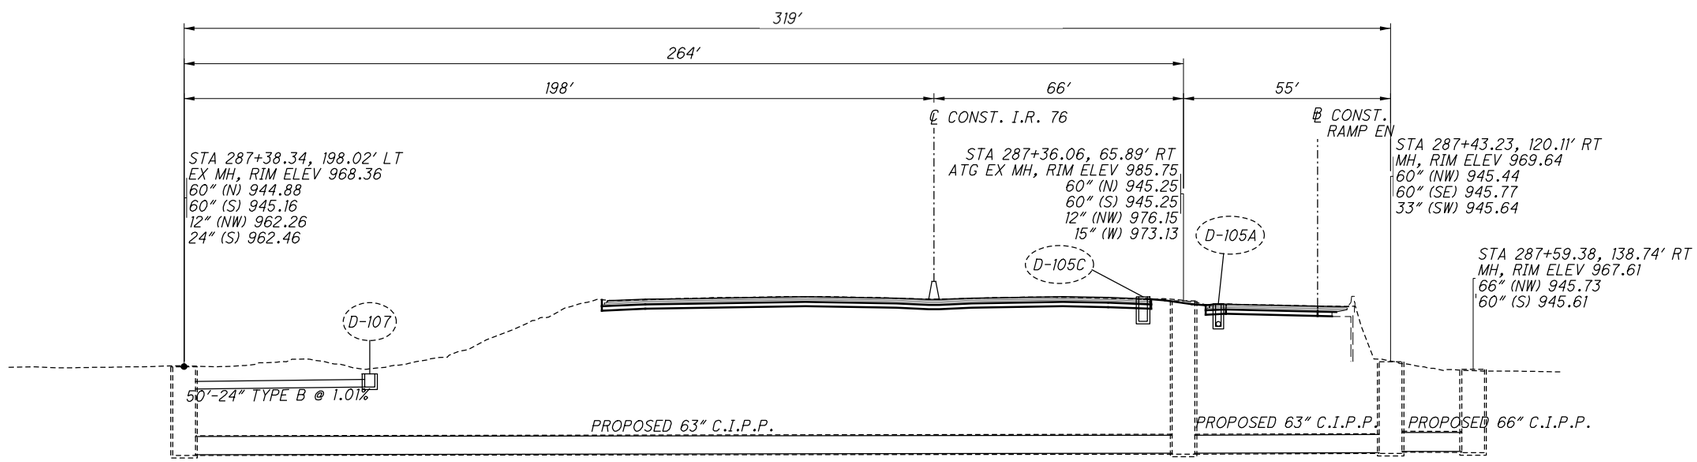

PROFILE

CALCULATED AB
CHECKED FR

HORIZONTAL SCALE IN FEET
0 10 20 40

CULVERT CIPP LINING PLAN
I.R. 76 STA. 287+36



The undersigned hereby confirms that, to the best
after the Released for Construction plans were se
RSS JV
Signed:
The undersigned hereby confirms that, to the best
been included in the Record Drawings and the De
of the Contract.
Parsons Transportation Group, Inc.
Signed:
2023-03-14 - BU-43 - RECORD DRAWING PLANS