Hinge 1 & 3 Pin Diameter shall be increased to 8.063 (0.005" ±)

Hinge 1 & 3 Bushing Diameter shall be increased to 8.094" (0.005" ±)

Hinge 2 - No changes

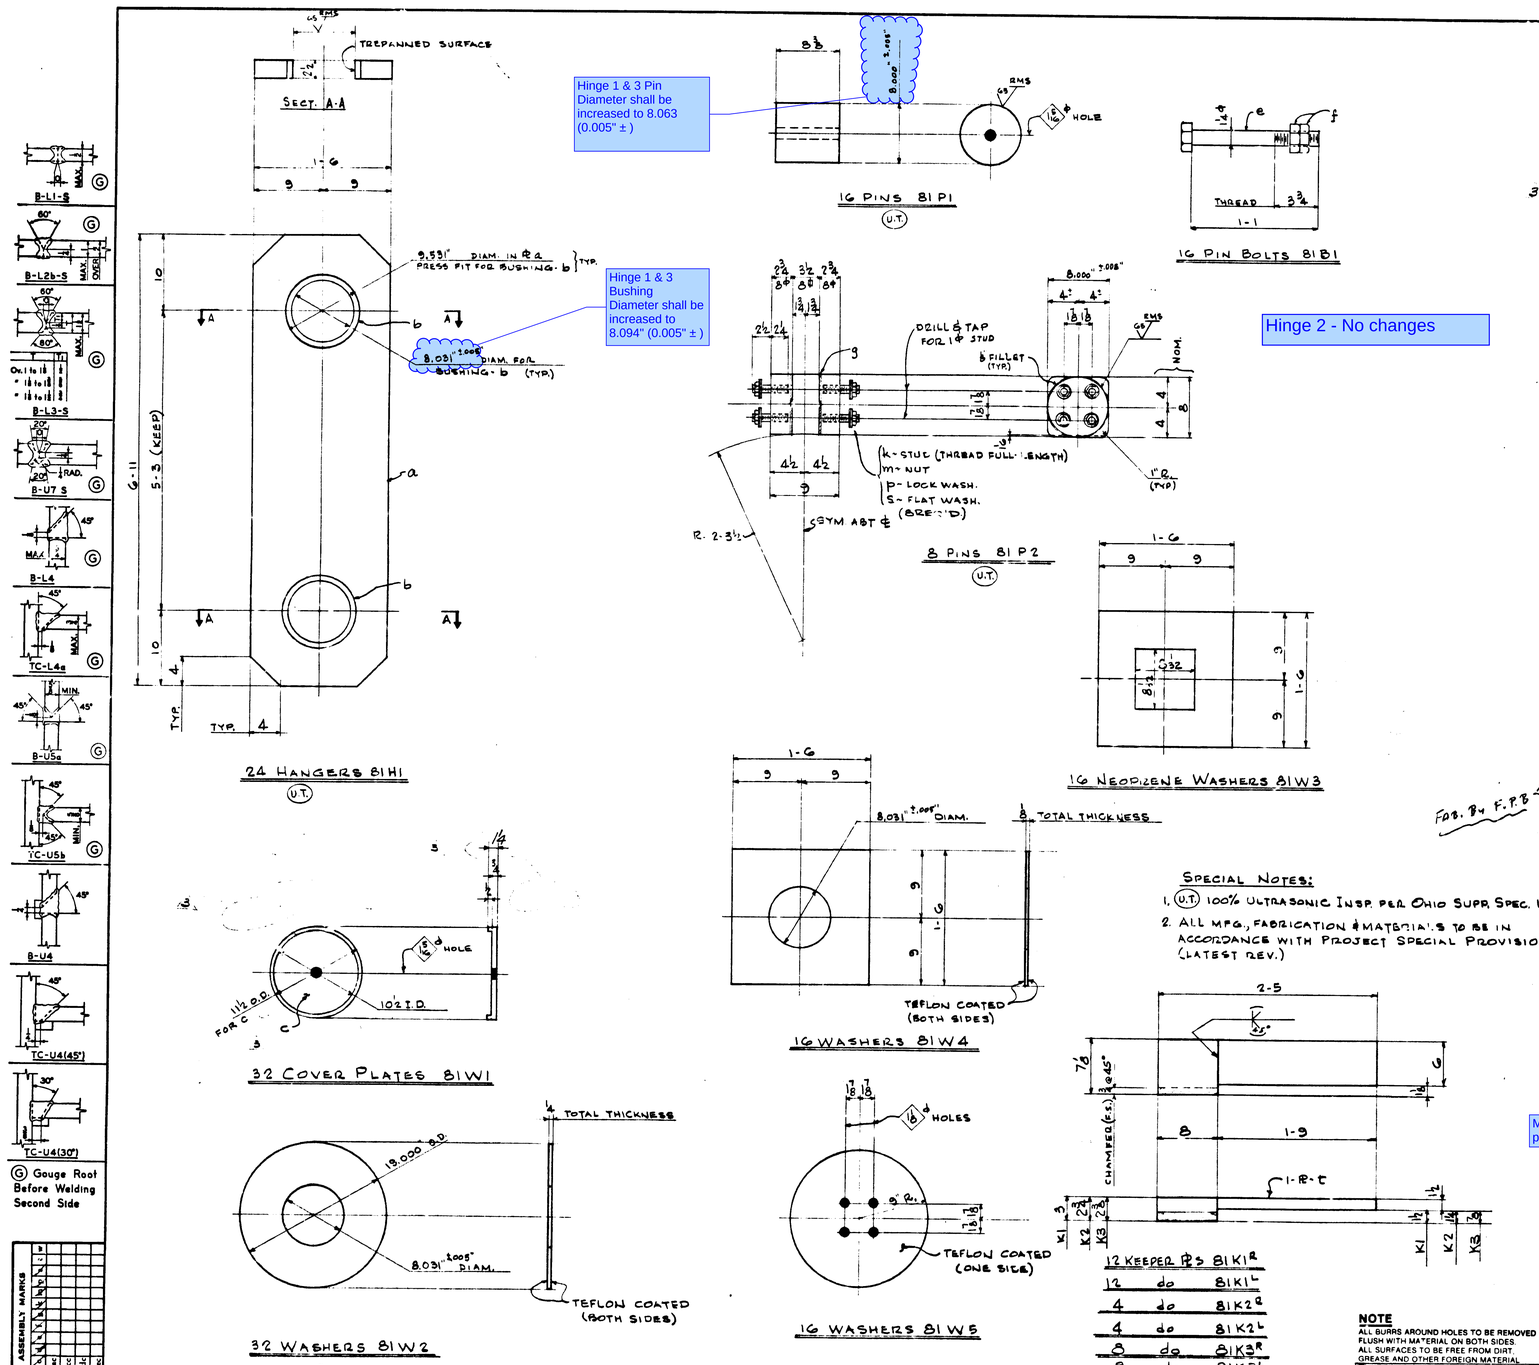

SPECIAL NOTES:

1. (U.T.) 100% ULTRASONIC INSP. PER OHIO SUPP. SPEC. 1027
2. ALL MFG., FABRICATION & MATERIALS TO BE IN ACCORDANCE WITH PROJECT SPECIAL PROVISIONS (LATEST REV.)

| SHIPMENT | | | | | ASSEMBLY MARK | FINISHED MATERIAL NO. PCS | SECT | SIZE | SIZE WT | L THK | LENGTH | WELD | EXTRAS | MAT'L SPECS | REFERENCE NO(P/L) SHIPMENT | | | | |