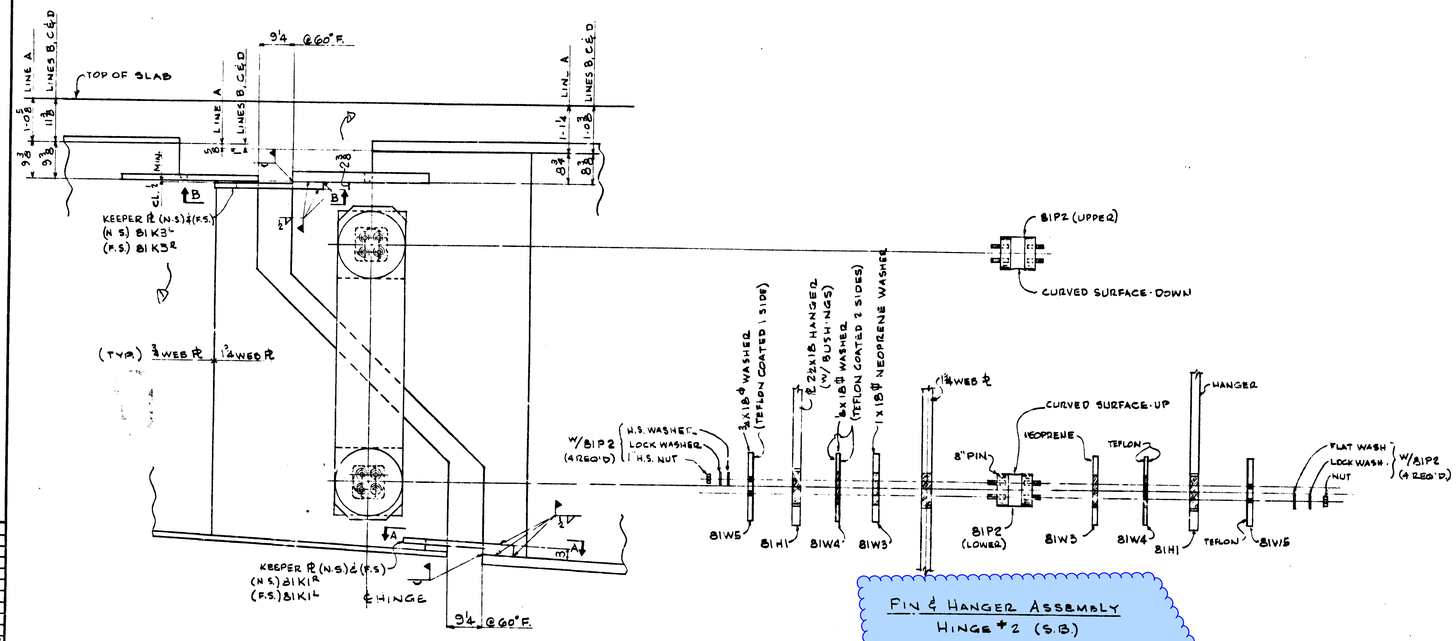

PIN & HANGER ASSEMBLY
HINGE #2 (S.B)

All hanger assembly components shall be new. (excluding Web plate)

HINGE # 2 (S.B)
W IS DIAPHRAGMS NOT SHOWN FOR CLARITY

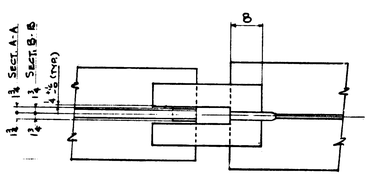

SECTION A-A
SECTION B-B (SIMILAR)

ASSEMBLY MARKS

Approved By the State of Ohio.
4-17-80
6-30-80

PUT IN SHOP MAY 6 1980 PROD. CONTROL
SPECIFICATIONS
MATERIAL
SHOP PAINT
REAMING
FOR GENERAL NOTES SEE SHT. GN-1
HOLES GALV. WELD. MACH.
LAST ASS'BL'Y MK. ERECT. DWG.

NO.	DESCRIPTION	MADE	DATE
4	KEEPER BARS REVD. FOR CLEARANCE	GG	5-19-80

REVISIONS

FORT PITT BRIDGE
DIV. OF SPANG INDUSTRIES, INC.
CANONSBURG, PENNSYLVANIA

CUSTOMER INDUSTRIAL FIRST
ENG'R. OR ARCH'T. DALTON-DALTON-LITTLE NEWPORT
DESCRIPTION N. MAIN ST. VIADUCT (S.B)
BR. No SUM-261-1005 PROJ. 701 (79)
SUMMIT Co., OHIO
HINGE # 2
MADE JJM DATE 2-9-80 CHECKED ECR DATE 2-28-80
IN CHARGE T.N.C., INC.
CONTRACT No. C-1808 DWG. No E10

47F