

ODOT Dist 4 - Trumbull Co - FINAL
No Passing Zone Log (TRU)

Route: 0007R (STRUSR00007**C)

From: 5.710 U0062R - END OVERLAP

Length: 22.150

Direction: North

To: 27.860 ENTER ATB CO

Length	Left	C/L	Right	Length	Control Points	Scale: 0.50 mile/page
	9.000		9.000 8.978	0.022		
					8.969 C0329 WARREN SHARON	
					8.855 T0176 GROVE	
0.007	8.817		8.817	0.007		
0.060				0.060		
	8.757		8.757			
0.006	8.742		8.742	0.006	8.752 T0178 WOOD LT	
0.086				0.086		
	8.656		8.656			
				0.045		
			8.611			
					8.589 S0082R	
0.072	8.572					
	8.500		8.500			

ODOT Dist 4 - Trumbull Co - FINAL
No Passing Zone Log (TRU)


Route: 0007R (STRUSR00007**C)

From: 5.710 U0062R - END OVERLAP

Length: 22.150

Direction: North

To: 27.860 ENTER ATB CO

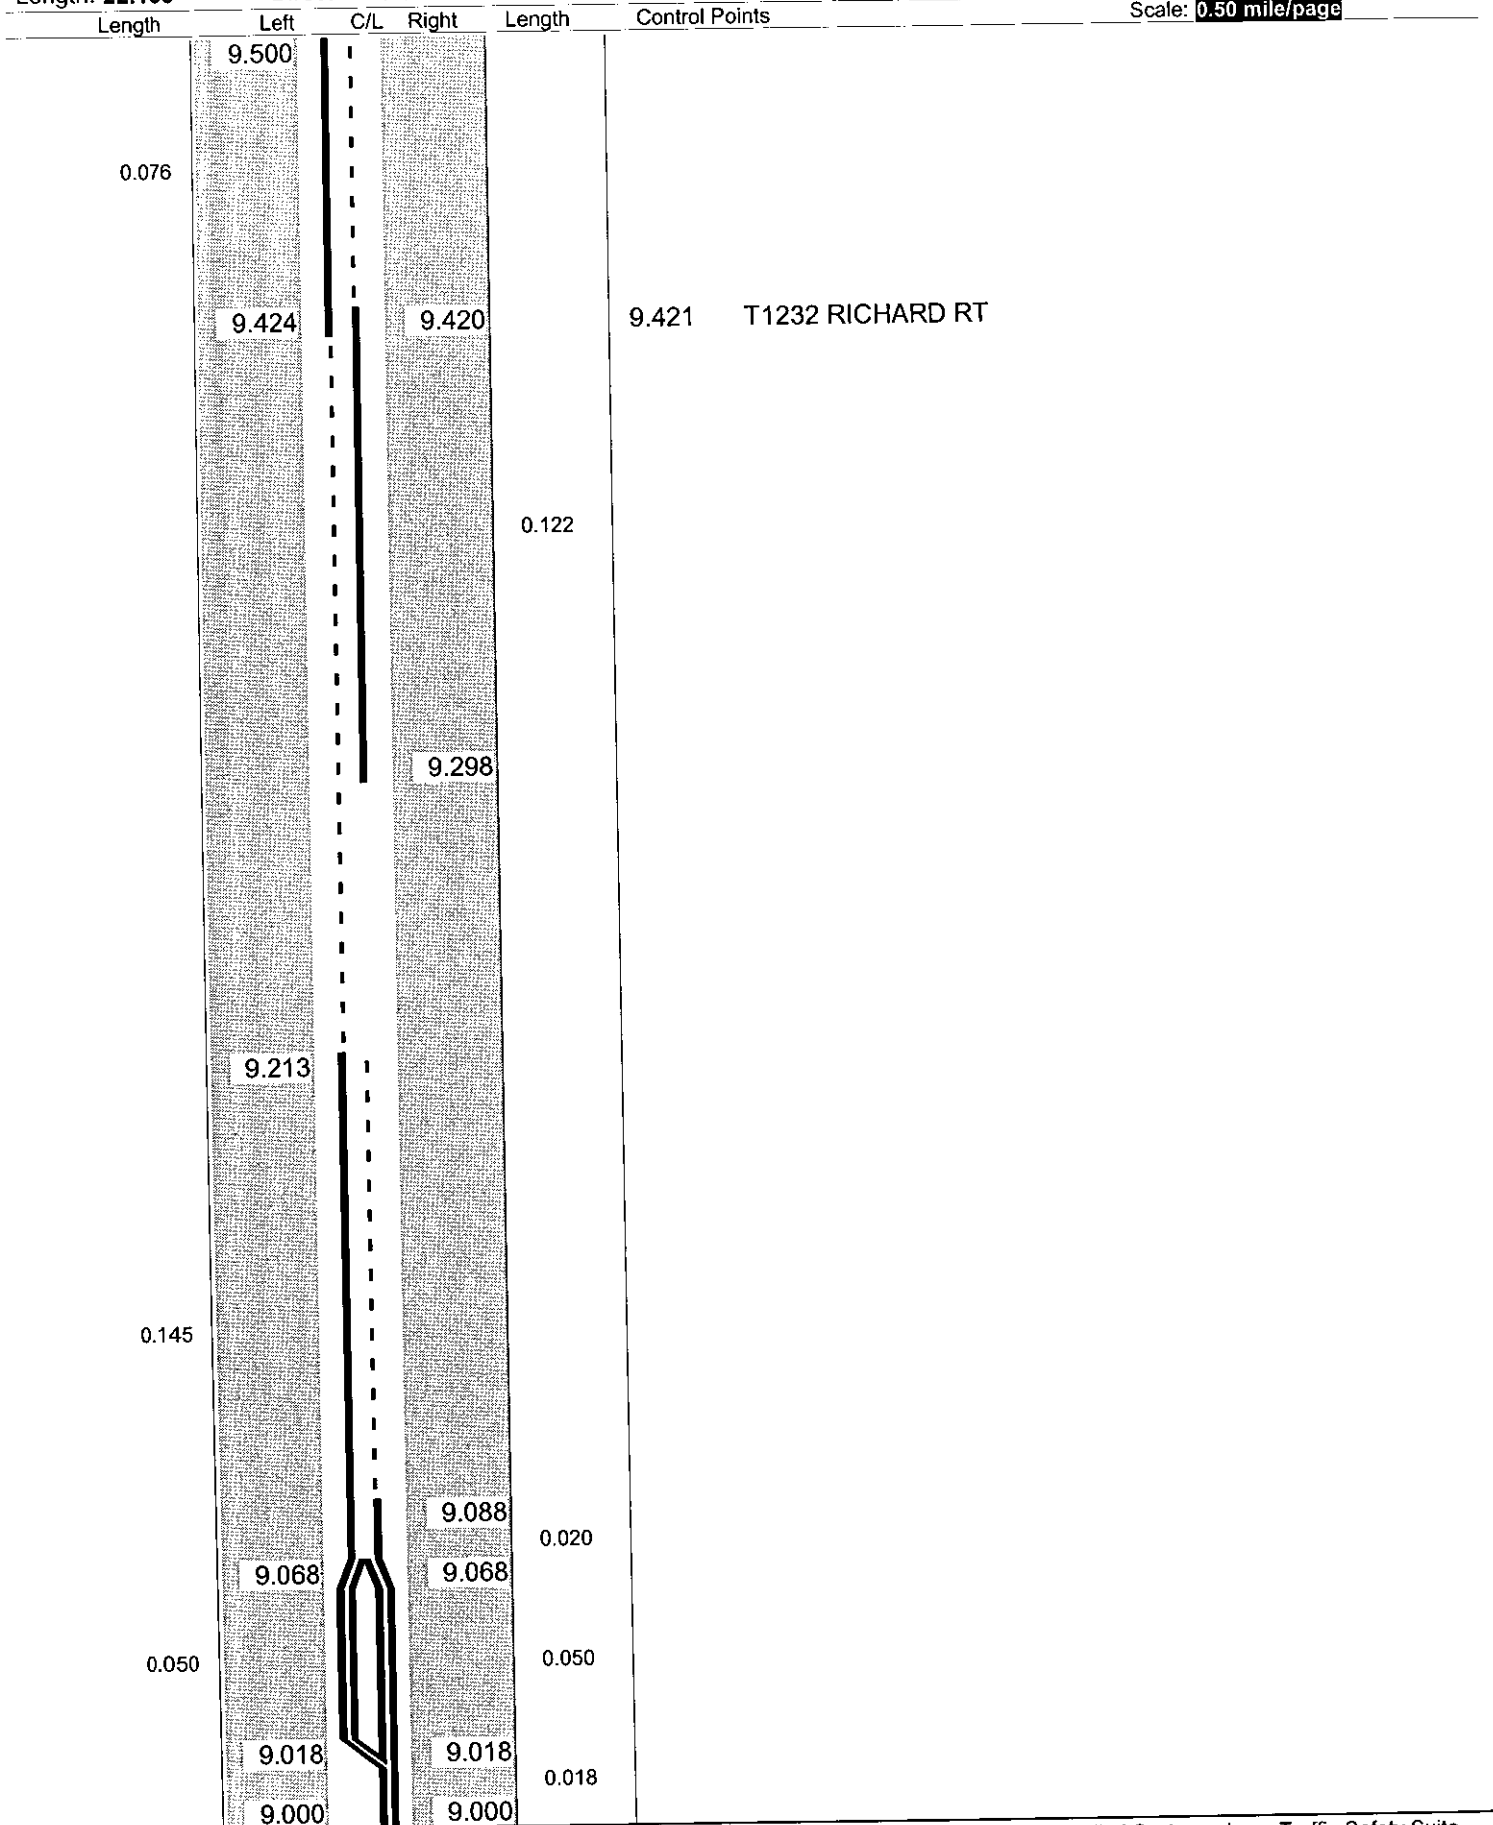

Sheet total equivalent length of solid line: 0.702

Accum. total: 6.439

ODOT Dist 4 - Trumbull Co - FINAL
 No Passing Zone Log (TRU)

Route: 0007R (STRUSR00007**C)


From: 5.710 U0062R - END OVERLAP

Length: 22.150

Direction: North

To: 27.860 ENTER ATB CO

Length	Left	C/L	Right	Length	Control Points	Scale: 0.50 mile/page
--------	------	-----	-------	--------	----------------	-----------------------

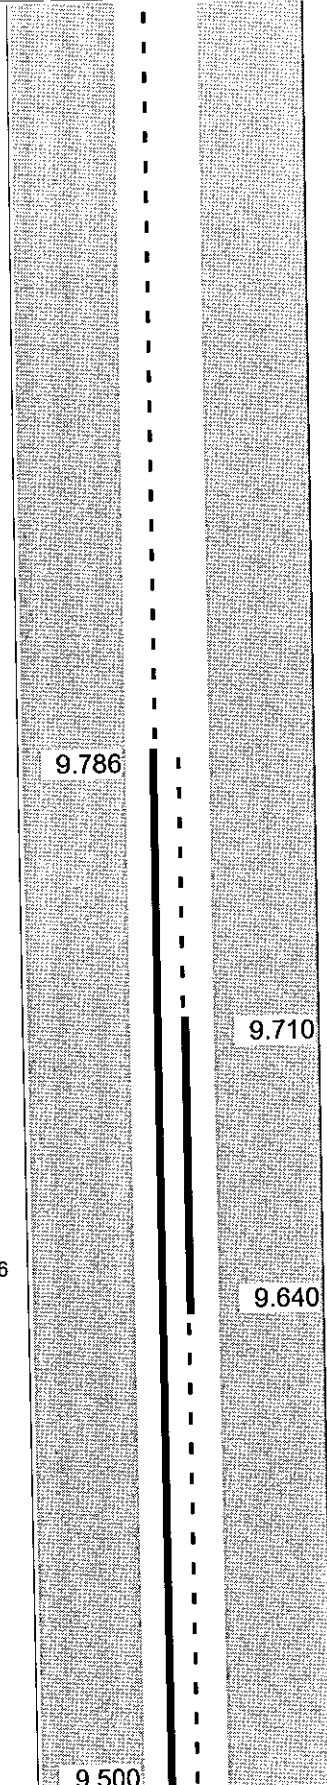

9.716 WYNGATE MANOR LT

0.070

0.286

ODOT Dist 4 - Trumbull Co - FINAL
No Passing Zone Log (TRU)

Route: 0007R (STRUSR00007**C)

From: 5.710 U0062R - END OVERLAP

Length: 22.150

Direction: North

To: 27.860 ENTER ATB CO

Length	Left	C/L	Right	Length	Control Points	Scale: 1.00 mile/page
			11.000	0.083		
			10.917			
			10.720			
0.192			10.627		10.633 C0169 CUSTER ORANGEVILLE RT	
			10.528	0.269		
			10.358			
			10.157			
0.066			10.091		10.086 C0168 MERWIN CHASE LT	
			10.079	0.068		
			10.011		10.007 Mile Post = 010	

ODOT Dist 4 - Trumbull Co - FINAL
 No Passing Zone Log (TRU)

Route: 0007R (STRUSR00007**C)
 Length: 22.150 Direction: North

From: 5.710 U0062R - END OVERLAP
 To: 27.860 ENTER ATB CO

Length	Left	C/L	Right	Length	Control Points	Scale: 1.00 mile/page
0.040	12.000				11.953 C0186 THOMPSON SHARPSVILLE RT	
	11.960				11.953 C0361 YOUNGSTOWN CONNEAUT LT	
			11.945	0.063		
			11.882			
					11.634 BRIDGE	
					11.630 LEAVE YANKEE LAKE	
0.067	11.571					
	11.504					
			11.493	0.063	11.499 NO NAME LT	
			11.430			
	11.257					
			11.176	0.176	11.184 BROCKWAY RT	
0.205					11.145 FAIRVIEW RT	
	11.052				11.046 ENTER YANKEE LAKE	
					11.046 T0166 AMY BOYLE LT	
			11.000		11.004 Mile Post = 011	







Length	Left	C/L	Right	Length	Control Points	Scale: 1.00 mile/page
			12.998			
				0.095	12.978 Mile Post = 013	
	12.890		12.903			
0.502			12.645		12.638 T0188 DRAKE STATE LINE RT	
	12.388			0.427		
			12.218			
	12.019					
0.019	12.000				12.049 Mile Post = 012	