


TO FRANKLIN  
R.R. SOUTH  
M.P. INCREASING

TO CARLISLE JCT.  
R.R. NORTH  
M.P. DECREASING

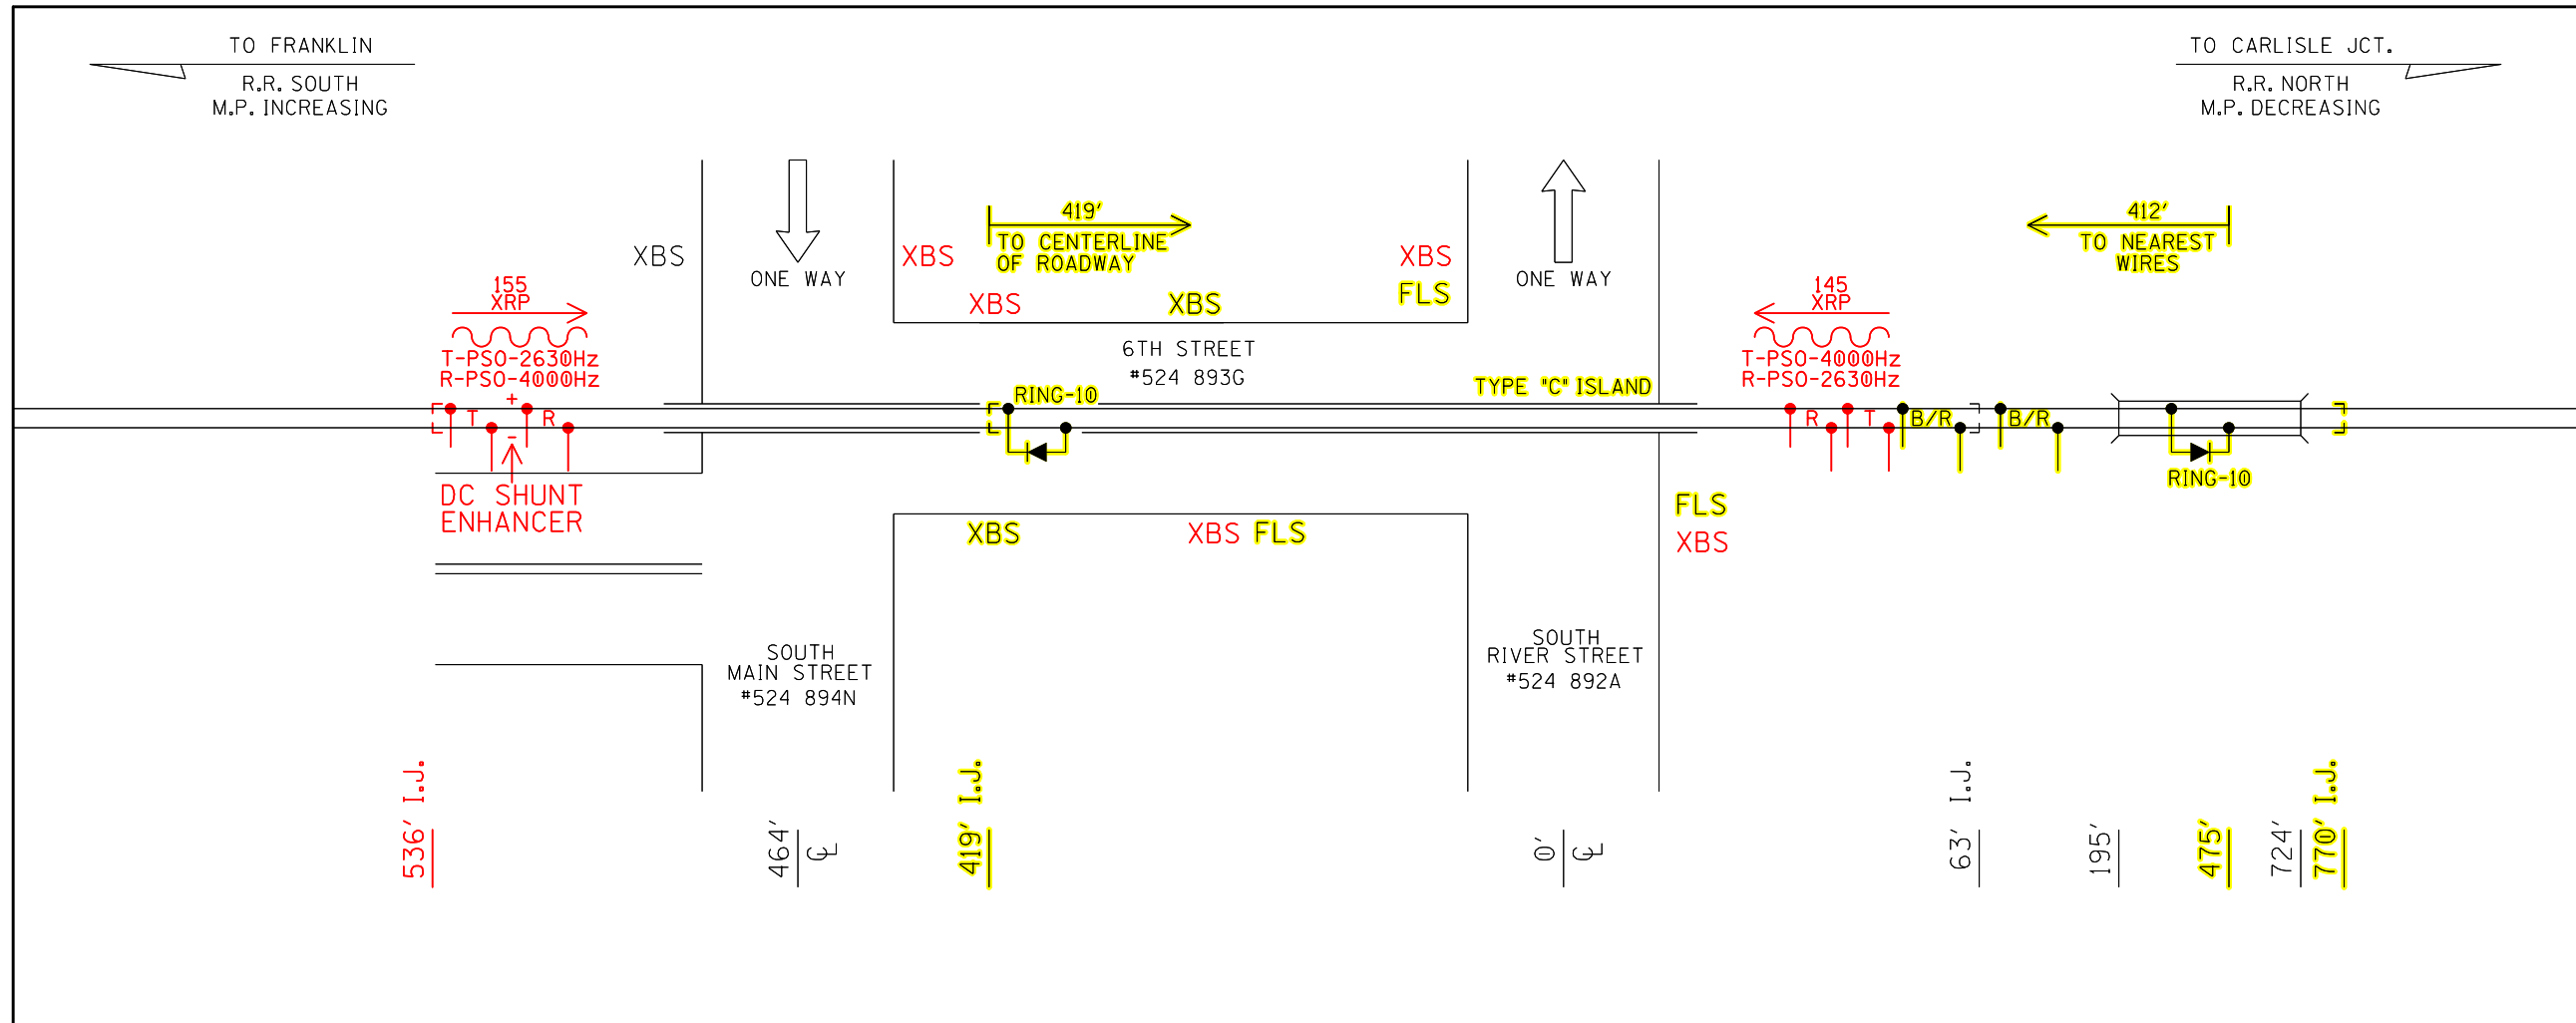

536' I.J.

464'  $\frac{1}{2}$

419' I.J.

0'  $\frac{1}{2}$

63' I.J.

195'

475'

724'

770' I.J.

PROJECT:  
#10.3273  
RED = IN  
YELLOW = OUT  
DESIGN: 10-12-21  
PROGRESS RAIL  
CHECK: XX-XX-XX  
JMW

PRELIMINARY  
NOT FOR  
CONSTRUCTION


PROPOSED PROFILE

PROPERTY  
PENNSYLVANIA R.R.

DESIGNED BY:	MST	10-12-21		OFFICE OF ASS'T. VICE PRESIDENT COMM. & SIGNAL, ATLANTA, GA.	M.P.: QD-1.45
DRAWN BY:	PRS	10-12-21			
CHECKED BY:	JMW	- -	FRANKLIN, OH XBS AT SOUTH RIVER STREET		
IN SERVICE:	- -	- -	DAYTON DISTRICT	REV. 1	
			CADD or DWG. No. 82580016.003	SHEET No. 3	

TO FRANKLIN  
R.R. SOUTH  
M.P. INCREASING

TO CARLISLE JCT.  
R.R. NORTH  
M.P. DECREASING

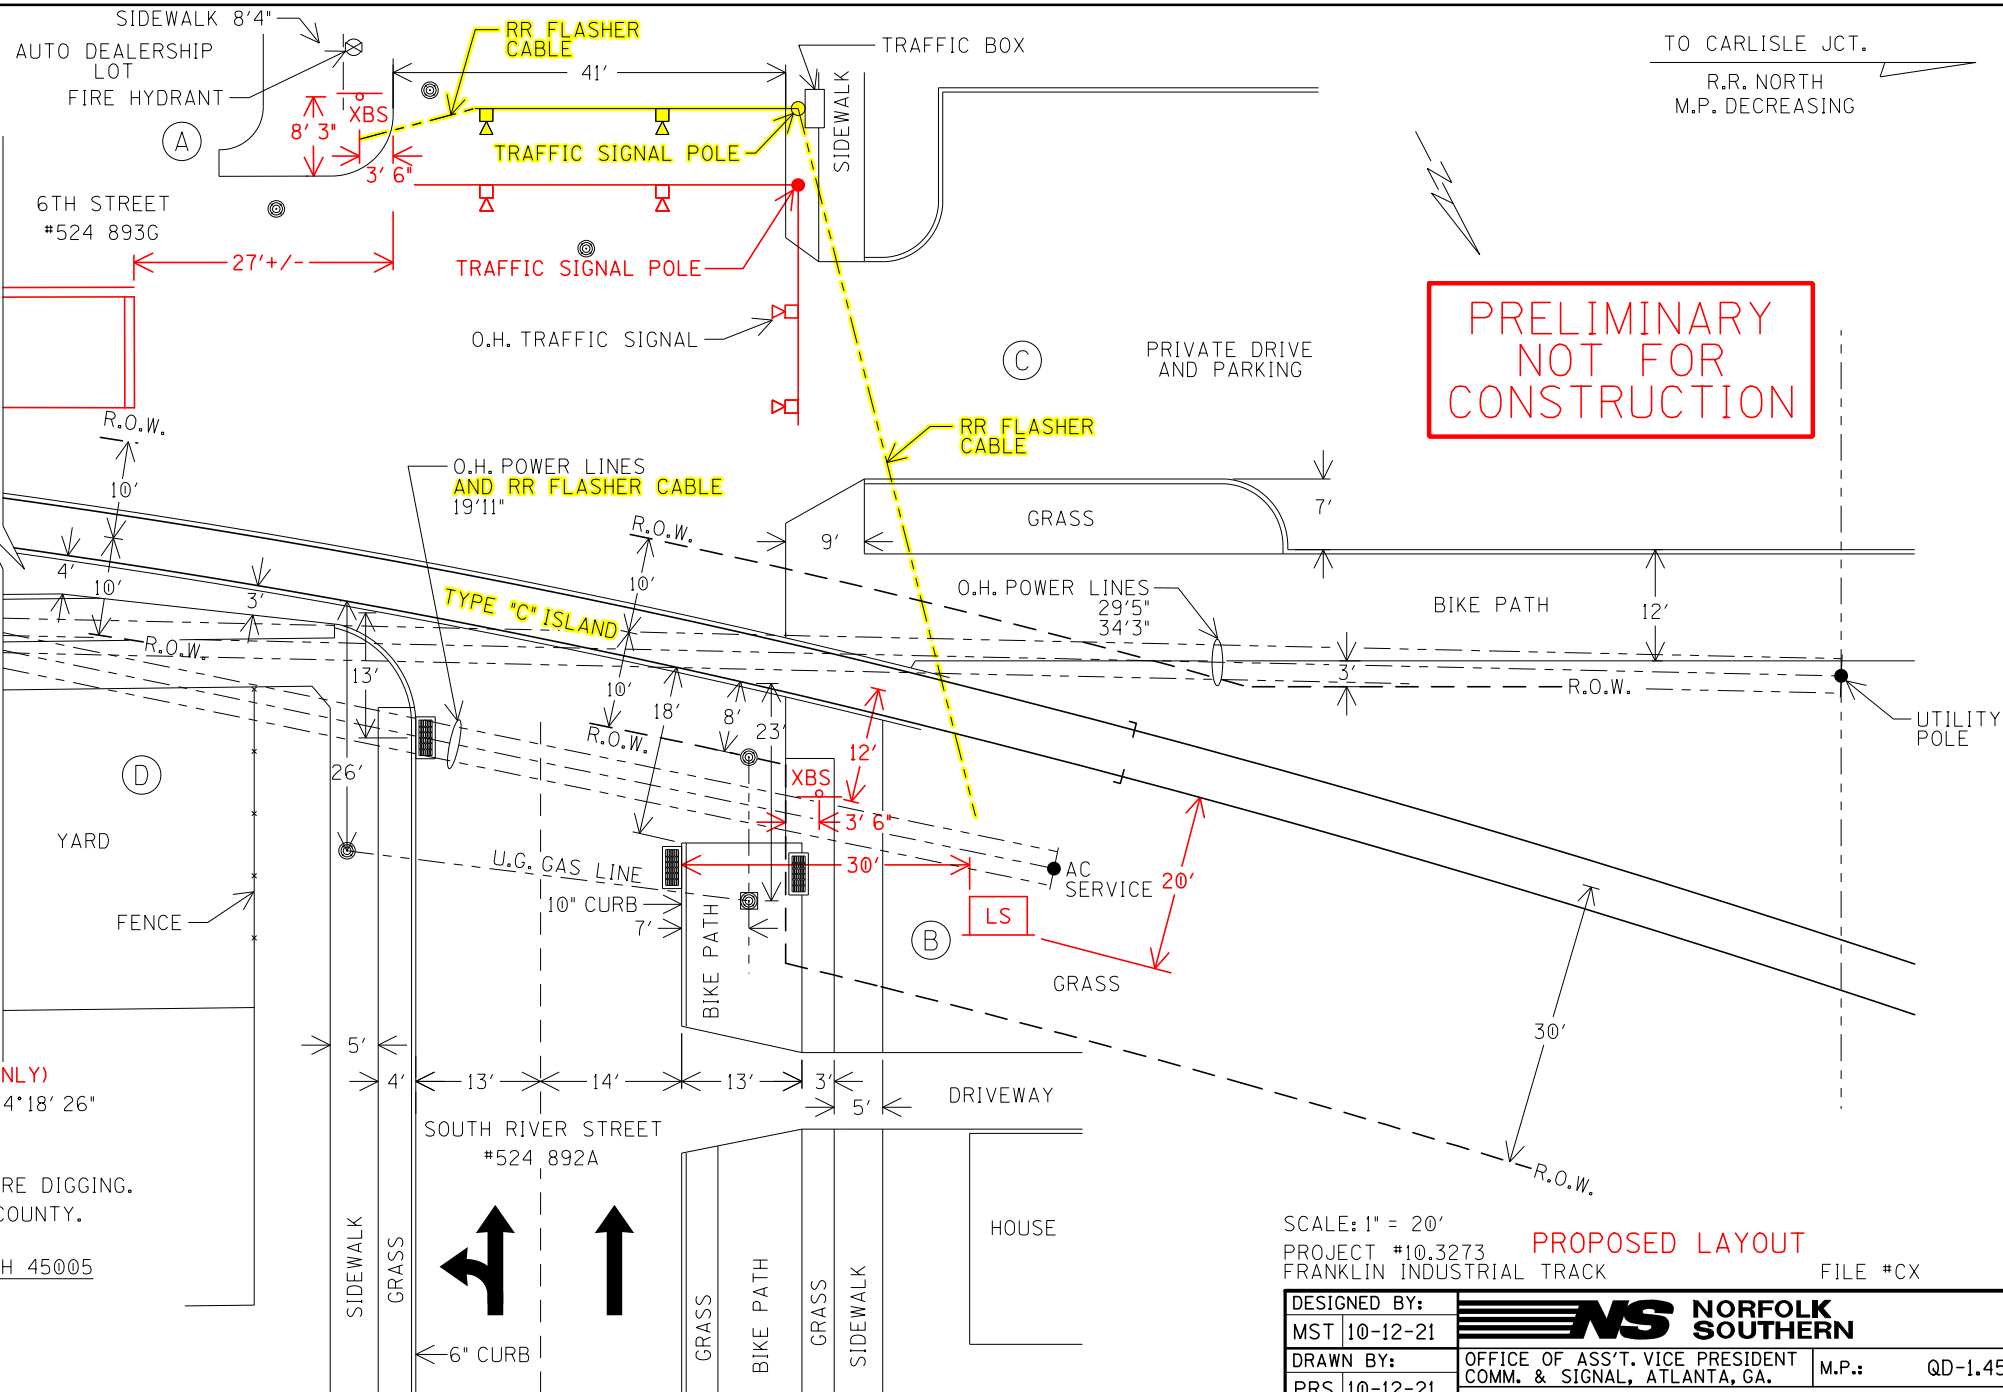

**PRELIMINARY  
NOT FOR  
CONSTRUCTION**

**PROJECT:**  
#10.3273  
**RED = IN**  
**YELLOW = OUT**  
DESIGN: 10-12-21  
PROGRESS RAIL  
CHECK: XX-XX-XX  
JMW

- NOTES:
1. MAX. TRAIN SPEED 10 M.P.H. (ISLAND ONLY)
  2. LATITUDE N 39°33'30" LONGITUDE W 84°18'26" ELEVATION 675'
  3. NO BELLS AT CROSSING.
  4. LOCATE U/G UTILITIES & CABLE BEFORE DIGGING.
  5. CROSSING LOCATED IN WARREN COUNTY.
  6. NEAREST STREET ADDRESS IS 528 SOUTH RIVER STREET, FRANKLIN, OH 45005
  7. NEAREST INTERSECTING STREET IS 6TH STREET
  8. DISTANCE TO NEAREST INTERSECTING STREET IS 0 FT.
  9. THIS CROSSING WILL BE PROTECTED BY TRAFFIC LIGHTS AND USE SIMULTANEOUS PREEMPTION.

(A) (B) (C) (D) = QUADRANT MARKERS


SCALE: 1" = 20'  
PROJECT #10.3273  
FRANKLIN INDUSTRIAL TRACK  
**PROPOSED LAYOUT**  
FILE #CX

DESIGNED BY:	<b>NS NORFOLK SOUTHERN</b>	
MST 10-12-21	OFFICE OF ASS'T. VICE PRESIDENT COMM. & SIGNAL, ATLANTA, GA.	M.P.: QD-1.45
DRAWN BY:	FRANKLIN, OH	
PRS 10-12-21	XBS AT SOUTH RIVER STREET	
CHECKED BY:	DAYTON DISTRICT	REV. 1
JMW - -	CADD or DWG. No. 82580016.001	SHEET 1
IN SERVICE:		

PROPERTY  
PENNSYLVANIA R.R.

TO FRANKLIN  
R.R. SOUTH  
M.P. INCREASING

TO CARLISLE JCT.  
R.R. NORTH  
M.P. DECREASING

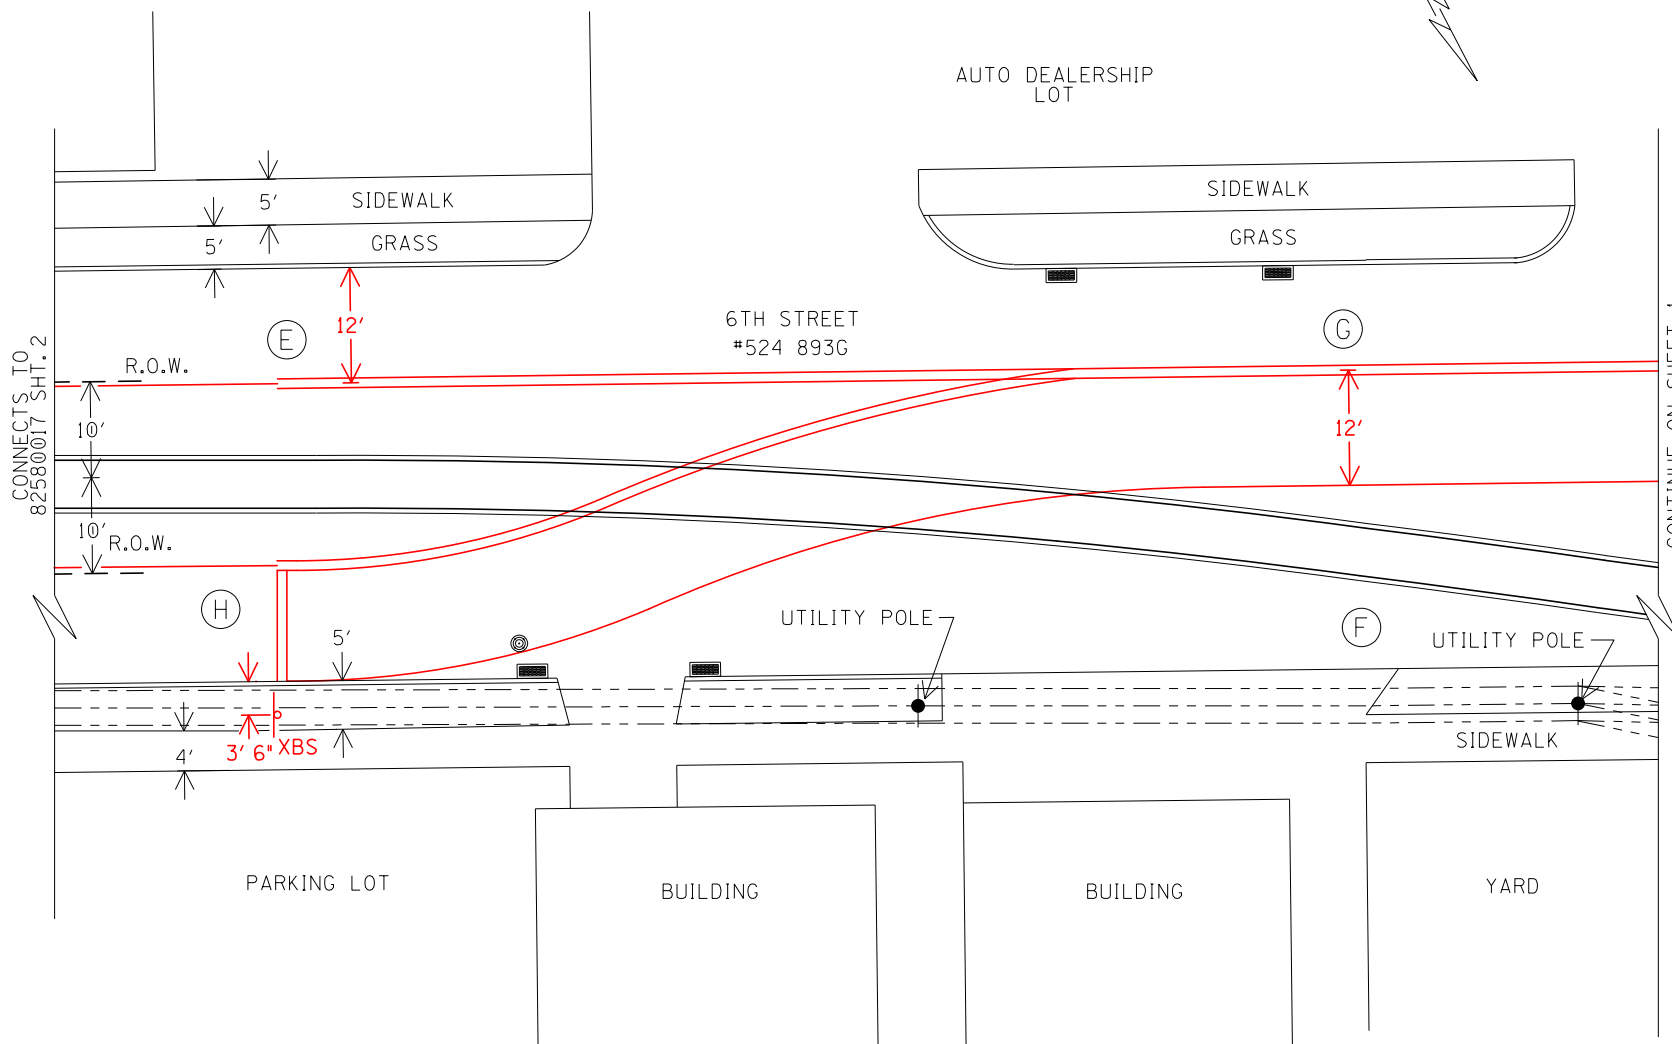

CONNECTS TO  
82580017 SHT. 2

CONTINUE ON SHEET 1

NOTE:

(E) (F) (G) (H) = QUADRANT MARKERS

PROJECT:  
#10.3273  
RED = IN  
YELLOW = OUT  
DESIGN: 10-12-21  
PROGRESS RAIL  
CHECK: XX-XX-XX  
JMW


PRELIMINARY  
NOT FOR  
CONSTRUCTION

SCALE: 1" = 20'  
PROJECT #10.3273 **PROPOSED LAYOUT**  
FRANKLIN INDUSTRIAL TRACK FILE #CX

DESIGNED BY: MST 10-12-21	<b>NS NORFOLK SOUTHERN</b>	
DRAWN BY: PRS 10-12-21	OFFICE OF ASS'T. VICE PRESIDENT COMM. & SIGNAL, ATLANTA, GA.	M.P.: QD-1.45
CHECKED BY: JMW - -	FRANKLIN, OH XBS AT SOUTH RIVER STREET	
IN SERVICE: - -	DAYTON DISTRICT	REV. 1
PROPERTY PENNSYLVANIA R.R.	CADD or DWG. No. 82580016.002	SHEET 2

TO FRANKLIN  
R.R. SOUTH  
M.P. INCREASING

TO CARLISLE JCT.  
R.R. NORTH  
M.P. DECREASING

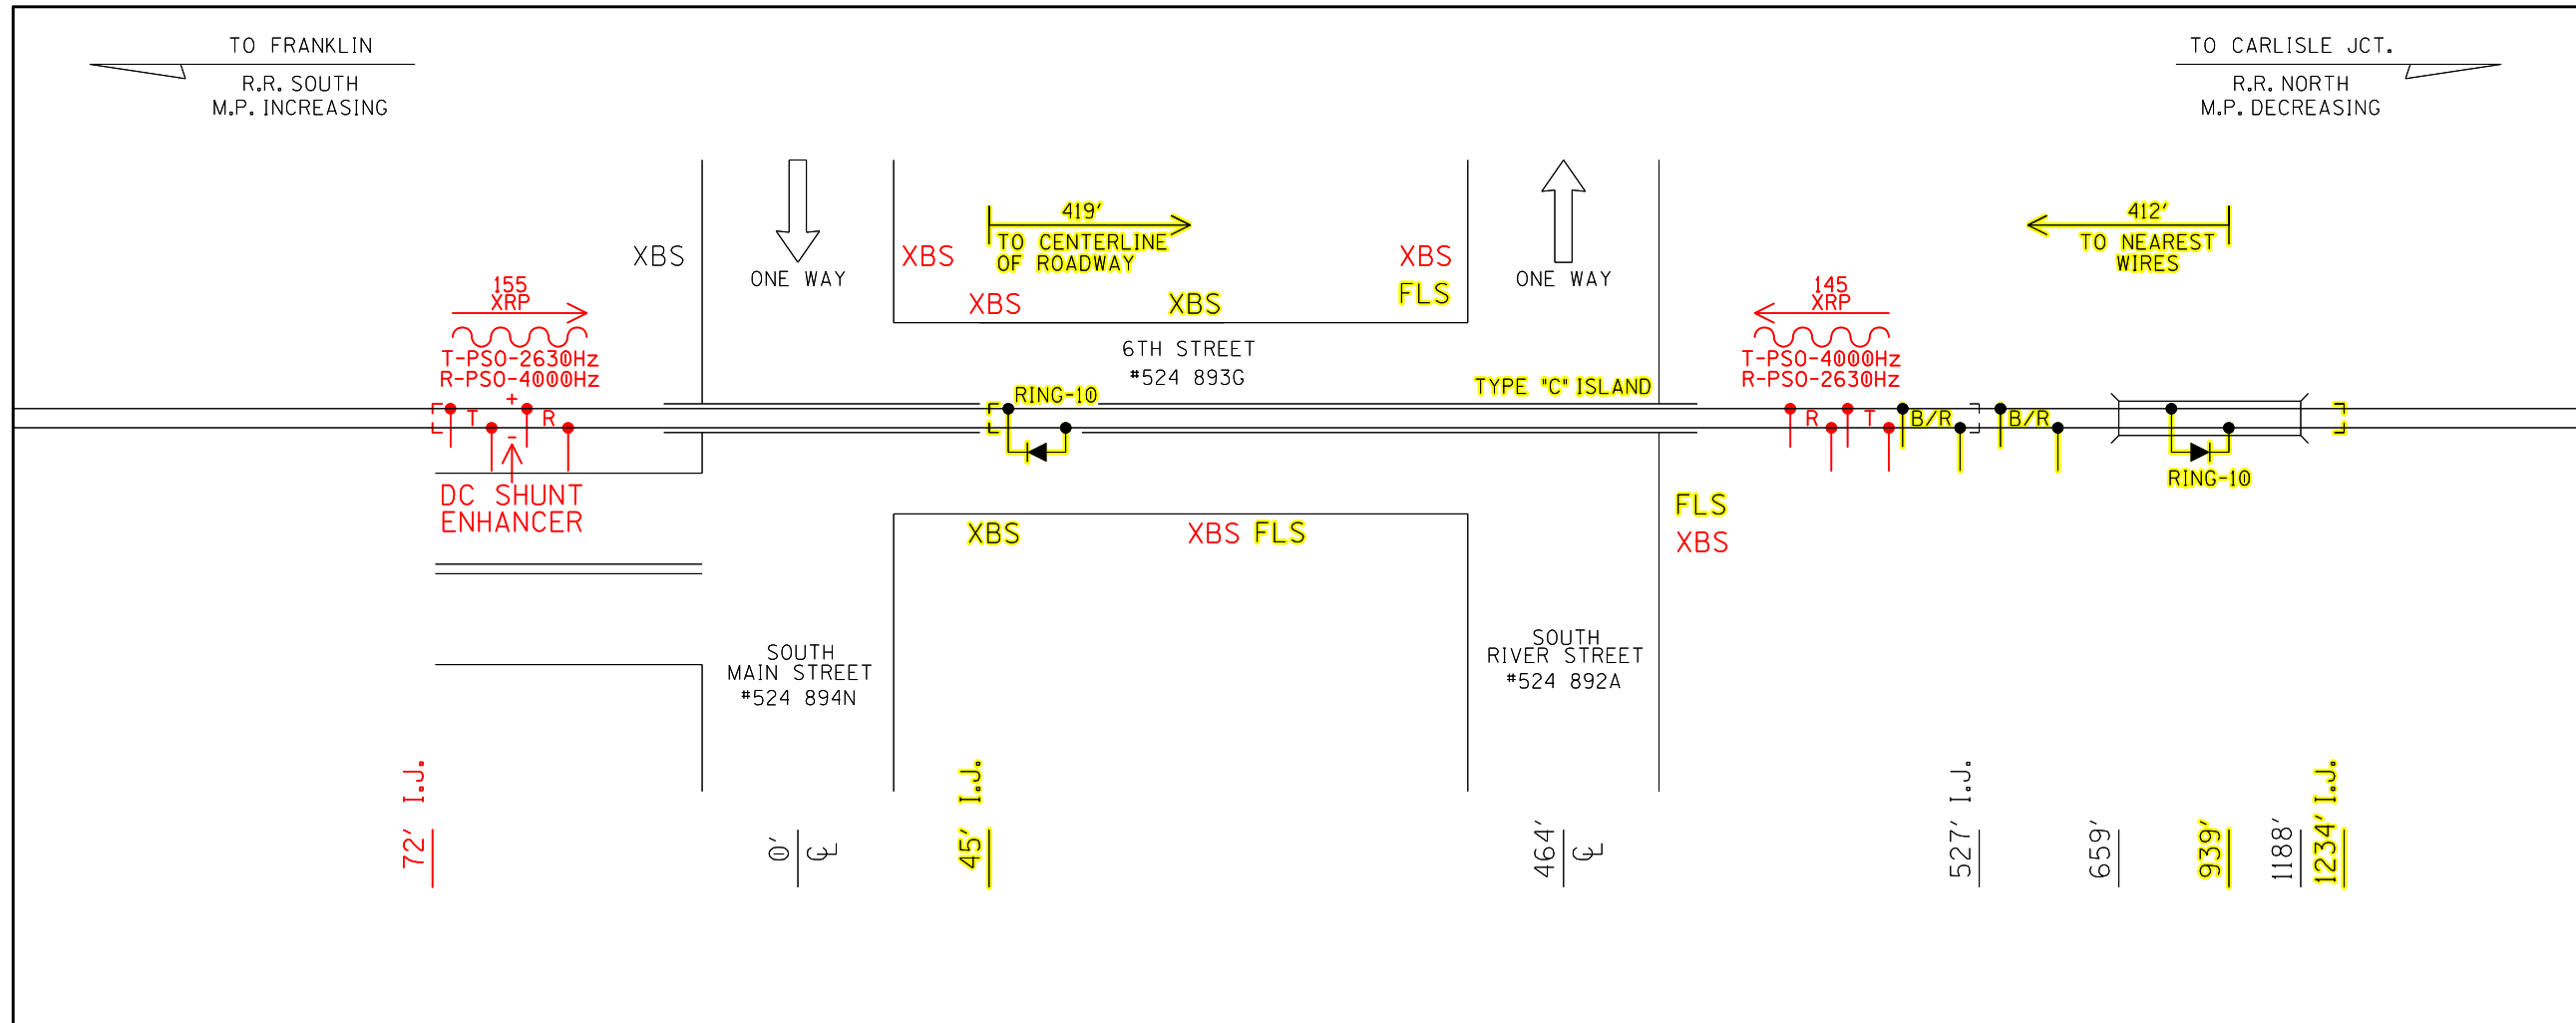

72' I.J.

0' | 9

45' I.J.

464' | 9

527' I.J.

659'

939'

1188'

1234' I.J.


PROJECT:  
#10.3274  
RED = IN  
YELLOW = OUT  
DESIGN: 10-12-21  
PROGRESS RAIL  
CHECK: XX-XX-XX  
JMW

PRELIMINARY  
NOT FOR  
CONSTRUCTION

PROPOSED PROFILE

PROPERTY  
PENNSYLVANIA R.R.

DESIGNED BY:	MST 10-12-21		M.P.: QD-1.55
DRAWN BY:	PRS 10-12-21		
CHECKED BY:	JMW - -	FRANKLIN, OH XBS AT SOUTH MAIN STREET	
IN SERVICE:	- -	DAYTON DISTRICT	REV. 1
		CADD or DWG. No. 82580017.003	SHEET No. 3

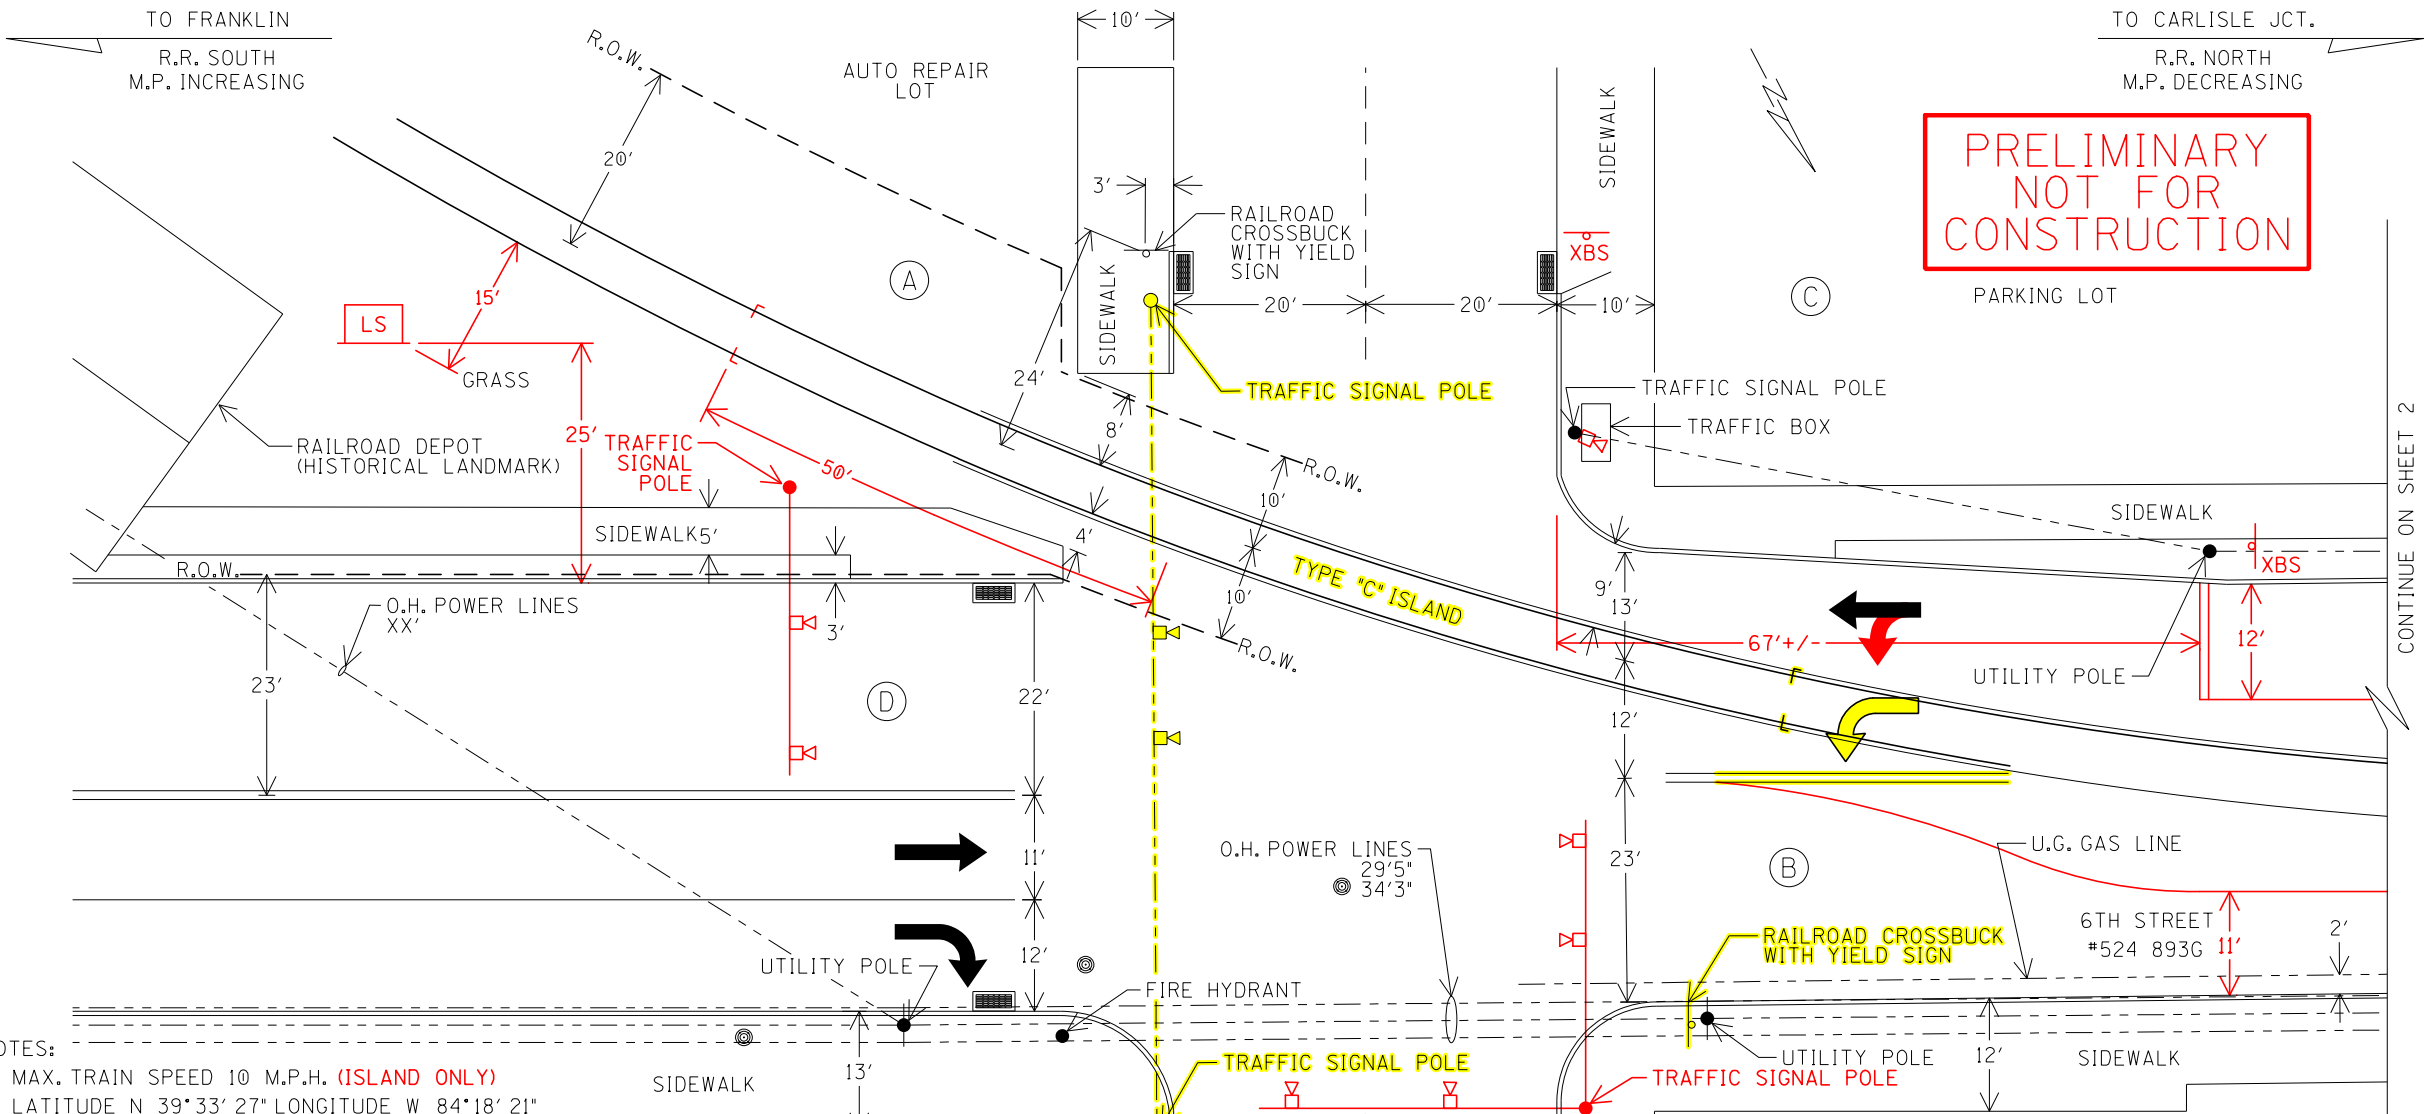

PRELIMINARY  
NOT FOR  
CONSTRUCTION

- NOTES:
1. MAX. TRAIN SPEED 10 M.P.H. (ISLAND ONLY)
  2. LATITUDE N 39°33' 27" LONGITUDE W 84°18' 21" ELEVATION 675'
  3. INTERSECTION HAS CROSSBUCKS WITH YIELD SIGNS.
  4. LOCATE U/G UTILITIES & CABLE BEFORE DIGGING.
  5. CROSSING LOCATED IN WARREN COUNTY.
  6. NEAREST STREET ADDRESS IS 550 SOUTH MAIN STREET, FRANKLIN, OH 45005
  7. NEAREST INTERSECTING STREET IS 6TH STREET
  8. DISTANCE TO NEAREST INTERSECTING STREET IS 0 FT.
  9. THIS CROSSING WILL BE PROTECTED BY TRAFFIC LIGHTS AND USE SIMULTANEOUS PREEMPTION.

(A) (B) (C) (D) = QUADRANT MARKERS

**PROJECT:**  
 #10.3274  
 RED = IN  
 YELLOW = OUT  
 DESIGN: 10-12-21  
 PROGRESS RAIL  
 CHECK: XX-XX-XX  
 JMW

SCALE: 1" = 20'  
 PROJECT #10.3274 **PROPOSED LAYOUT**  
 FRANKLIN INDUSTRIAL TRACK FILE #CX


DESIGNED BY:	<b>NS NORFOLK SOUTHERN</b>	
MST 10-12-21	OFFICE OF ASS'T. VICE PRESIDENT COMM. & SIGNAL, ATLANTA, GA.	M.P.: QD-1.55
DRAWN BY:	FRANKLIN, OH	
PRS 10-12-21	XBS AT SOUTH MAIN STREET	
CHECKED BY:	DAYTON DISTRICT	
JMW - -	REV. 1	
IN SERVICE:	SHEET 1	
- -	CADD or DWG. No. 82580017.001	

PROPERTY  
PENNSYLVANIA R.R.

CONTINUE ON SHEET 2

TO FRANKLIN  
R.R. SOUTH  
M.P. INCREASING

TO CARLISLE JCT.  
R.R. NORTH  
M.P. DECREASING

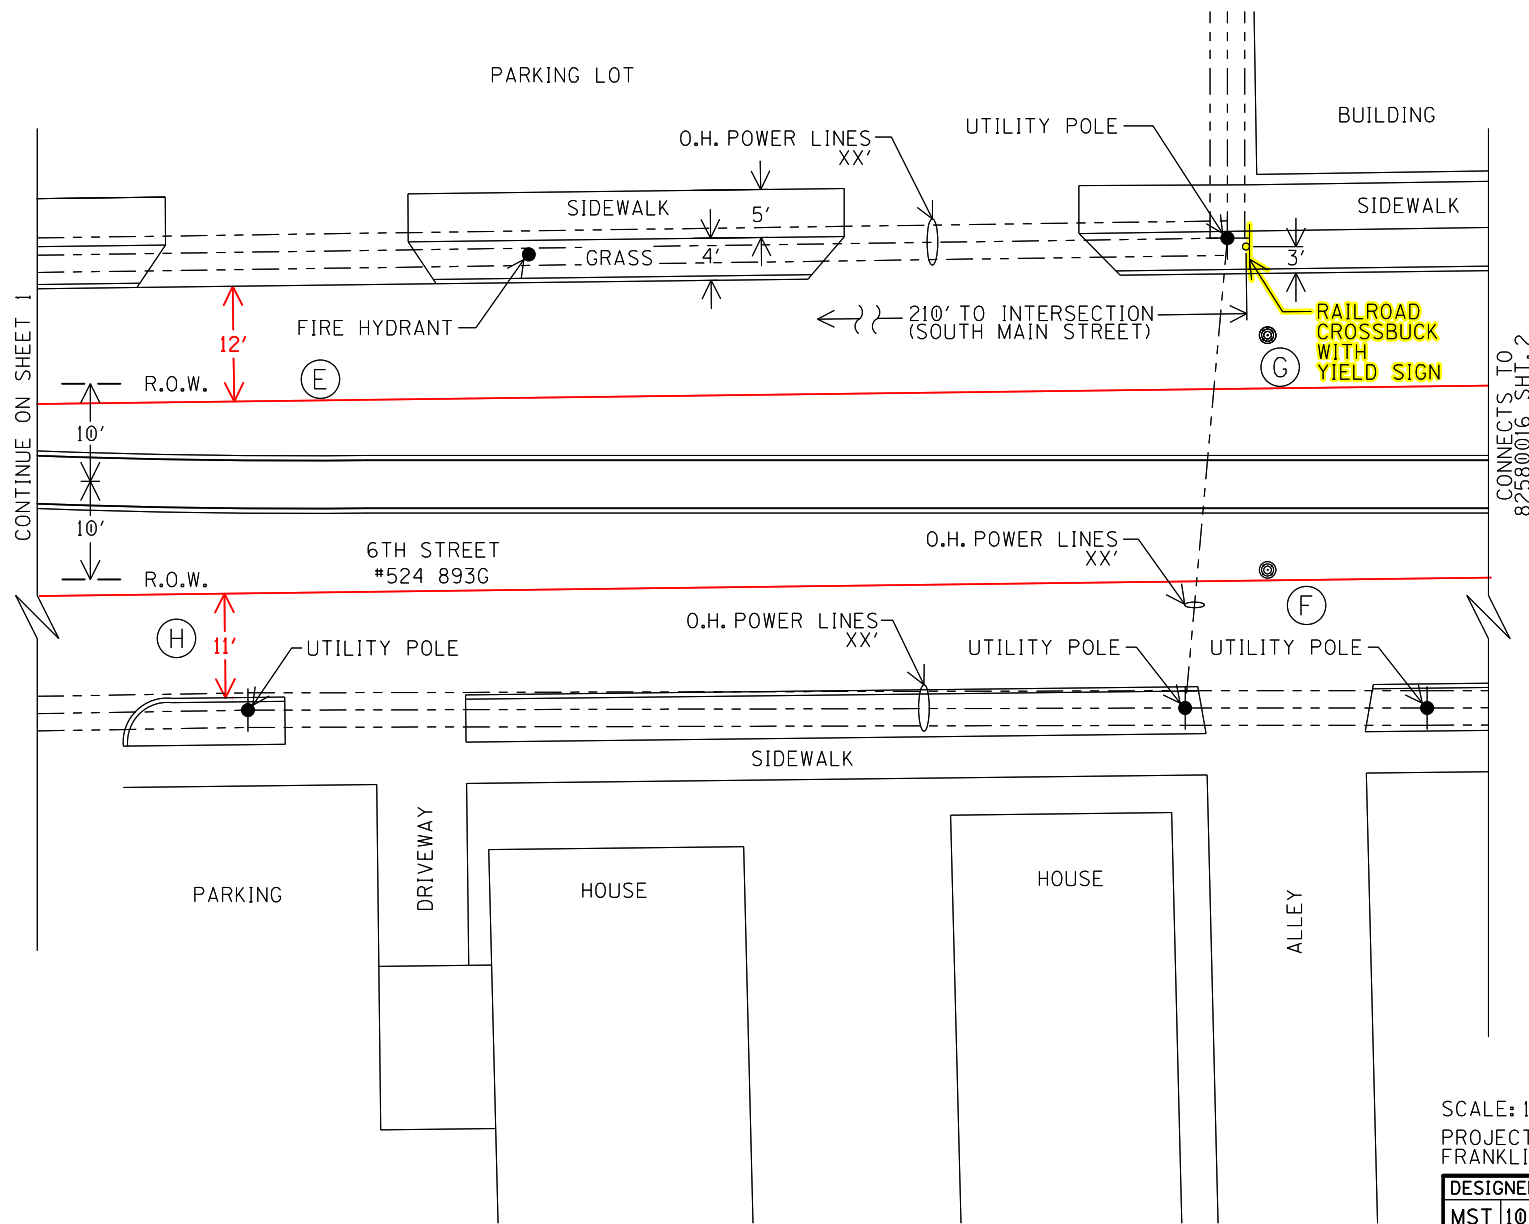

PRELIMINARY  
NOT FOR  
CONSTRUCTION

PROJECT:  
#10.3274  
RED = IN  
YELLOW = OUT  
DESIGN: 10-12-21  
PROGRESS RAIL  
CHECK: XX-XX-XX  
JMW

SCALE: 1" = 20'  
PROJECT #10.3274  
FRANKLIN INDUSTRIAL TRACK  
PROPOSED LAYOUT  
FILE #CX

NOTE:  
ⓔ ⓕ ⓖ ⓓ = QUADRANT MARKERS

PROPERTY  
PENNSYLVANIA R.R.

DESIGNED BY: MST 10-12-21	<b>NS NORFOLK SOUTHERN</b>	
DRAWN BY: PRS 10-12-21		
CHECKED BY: JMW - -	OFFICE OF ASS'T. VICE PRESIDENT COMM. & SIGNAL, ATLANTA, GA.	M.P.: QD-1.55
IN SERVICE: - -	FRANKLIN, OH XBS AT SOUTH MAIN STREET	
	DAYTON DISTRICT	REV. 1
	CADD or DWG. No. 82580017.002	SHEET No. 2