SHEET NO.

PERSONNEL	TITLE	PERSONNEL	TITLE
Lewis			
Erikson			
Ray			
Stickney			

COUNTY Wi DATE 12-9-69

S. R. #34 E 2 WEATHER Fair

SEC. 16 Pulaski Twp TEMP. 40°

DESCRIPTION Monumenting JOB NO.

LEFT CENTER LINE RIGHT

SEC 16

CR 15.75

SEC16CTRAC FD STONE w/ IPIN NEAR. SHOT HIGH POINT ON STONE

Note = P.I. was established from other ties but seems to be 0.50' N. of ℄ of Rd.

FD MONBOX w/ NO IPIN. DUG DOWN 3' TO SEE IF THERE WAS A STONE. D.N.F

FD
D.N.F. → N. to Duplex nail E. side 16" Maple = 60.63
D.N.F. → NW " " " " " 32" Mulberry = 41.65

Found Stone
ENE to shiner in PP = 34.25

Orig. Qtr. Cor.
Found Nail in Pav't
S.W. to ctr. M.H. = 23.04
N.W to shiner in B.P = 29.16
NE to near side N. Sprinkler Pipe = 52.62
East to shiner in PP = 31.34

CR 15/UNION

P.I. Sta 20+26.05 Est. I. Pipe
Δ = 29° 26' Rt.
NE to shiner in TP = 36.20
NW to SE Cor. Main Bldg. = 60.15
NW to W. Cor. 3 car door = 76.74

FD MONBOX
Found Stone (Placed I. Pipe)
NW. to shiner in P.P = 0.98
NE. " " " T.P = 36.06
South " " " B.P. = 52.25
SSW to nail NW side 6" apple = 91.76

Est. RR. Spk on S. P/L (No angle)

D.N.F.
Est. RR per Co Engr.
33.43 S of Nail
℄ Rd.

FD LG RSPK (CL1)
Est. RR Spk
21.4± S of Stone
No angle. = ℄ Rd.

REF29 REF30 FD MAG REF31 FD MAG

Found RR Spk
SW to shiner in TP = 40.29
NW to shiner in PP = 38.45
NE to x NW. Cor. CB = 31.23
SE to x S.W. Cor. CB. = 30.73

180°-00'

600-00 120°

P.I. Sta 44+89.02 Est. I. pipe Δ = 29°-02'-14"
E.S.E to NE. Cor. Bldg. found. = 25.00
SE to N Cor. Conc. Door Riser. = 37.56
NNE to x-NW. Cor. of CB. = 59.85

CR 16

REF28K

Found RR Spk
SSE to shiner in P.P = 93.78
SW to NE Cor. House Found. = 109.38
NW to shiner in P.P. = 82.07
NNE to ctr. S.W. bolt in sign base = 62.53

Found Stone (Placed I. Pipe) Δ = 0°-16'
ENE to Nail S. side P.P. = 29.11
N.W. to SE Cor. Conc. Found = 117.88
West to Nail N. side P.P. = 48.40

Found Iron Rod (Bent) (Placed I. Pipe)
NE. to near edge conc. CB = 17.90'
NW. " " " " " = 35.00
SW to Spk NW side P.P. = 34.80
SE to NW Cor. House Found = 90.74

Found Nail over Stone (Placed I pipe)
East to shiner in PP = 46.68
SE to ctr. I. Rod in Conc. N.W. Mon = 84.68
S.S.W. to NE Cor. Conc. found = 94.23
SW to Nail N.W. side PP = 48.53

Found Stone (Placed I. Pipe)
S. to I. Pin (2' deep) = 14.5'
NW to NE. Cor. Tool shed found = 47.26'
NW. to SE. " " " " = 17.41
South to RR Spk in ℄ Rd. = 29.57
Note from RR Spk South to Mon = 40.0'

PERSONNEL	TITLE	PERSONNEL	TITLE


COUNTY Wi. DATE

S. R. 34 & 2 WEATHER

SEC. 15 Pulaski TWP TEMP.

DESCRIPTION JOB NO.

LEFT CENTER LINE RIGHT

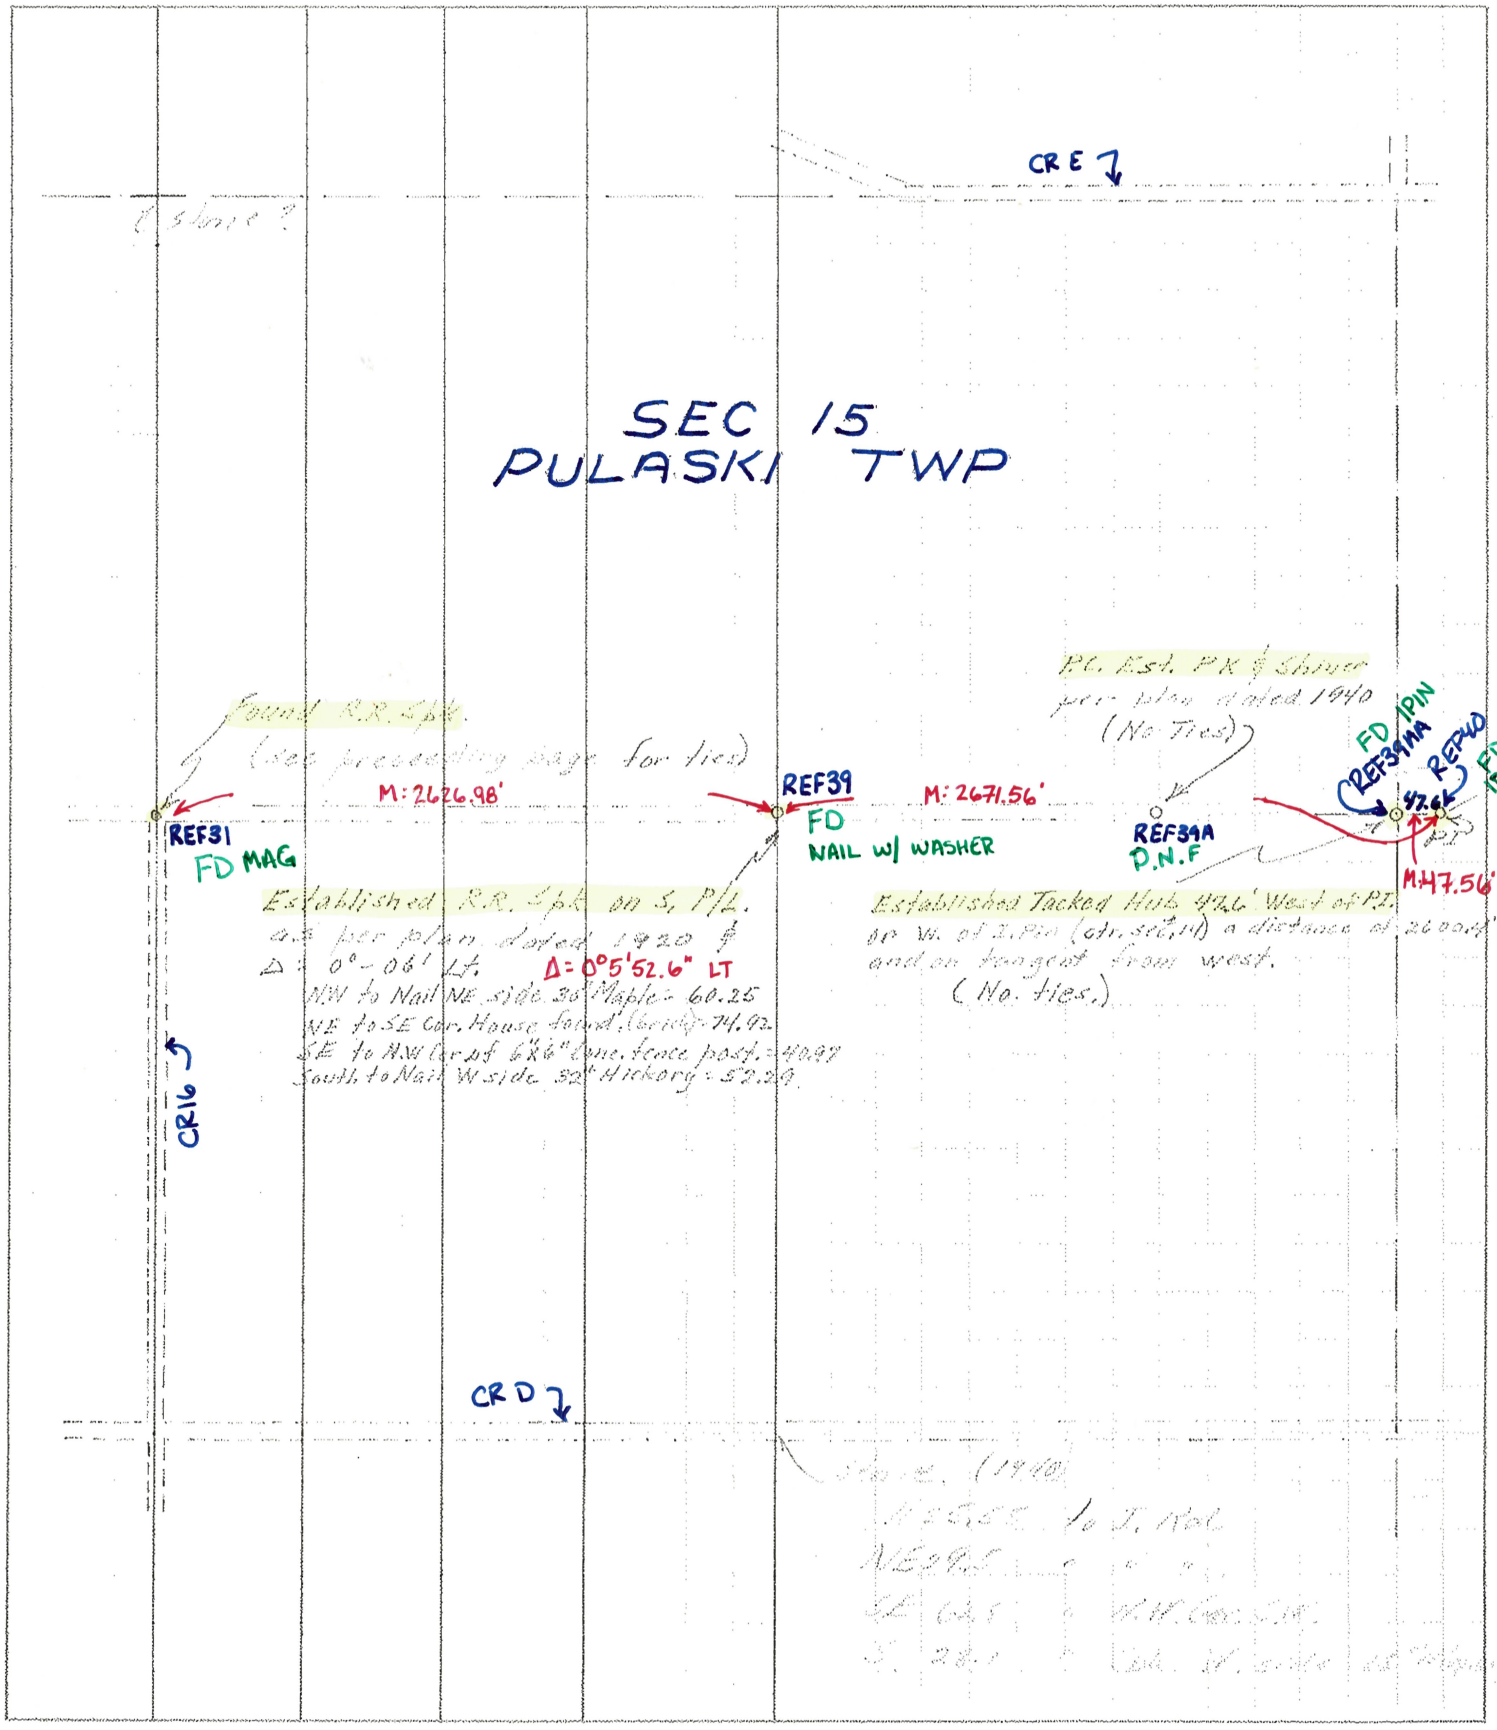

SHEET NO. 1480

PERSONNEL	TITLE	PERSONNEL	TITLE


COUNTY Wil DATE 3--

S. R. 34 & 2 WEATHER

SEC. 14 Pulaski TWP. TEMP.

DESCRIPTION JOB NO.

LEFT CENTER LINE RIGHT

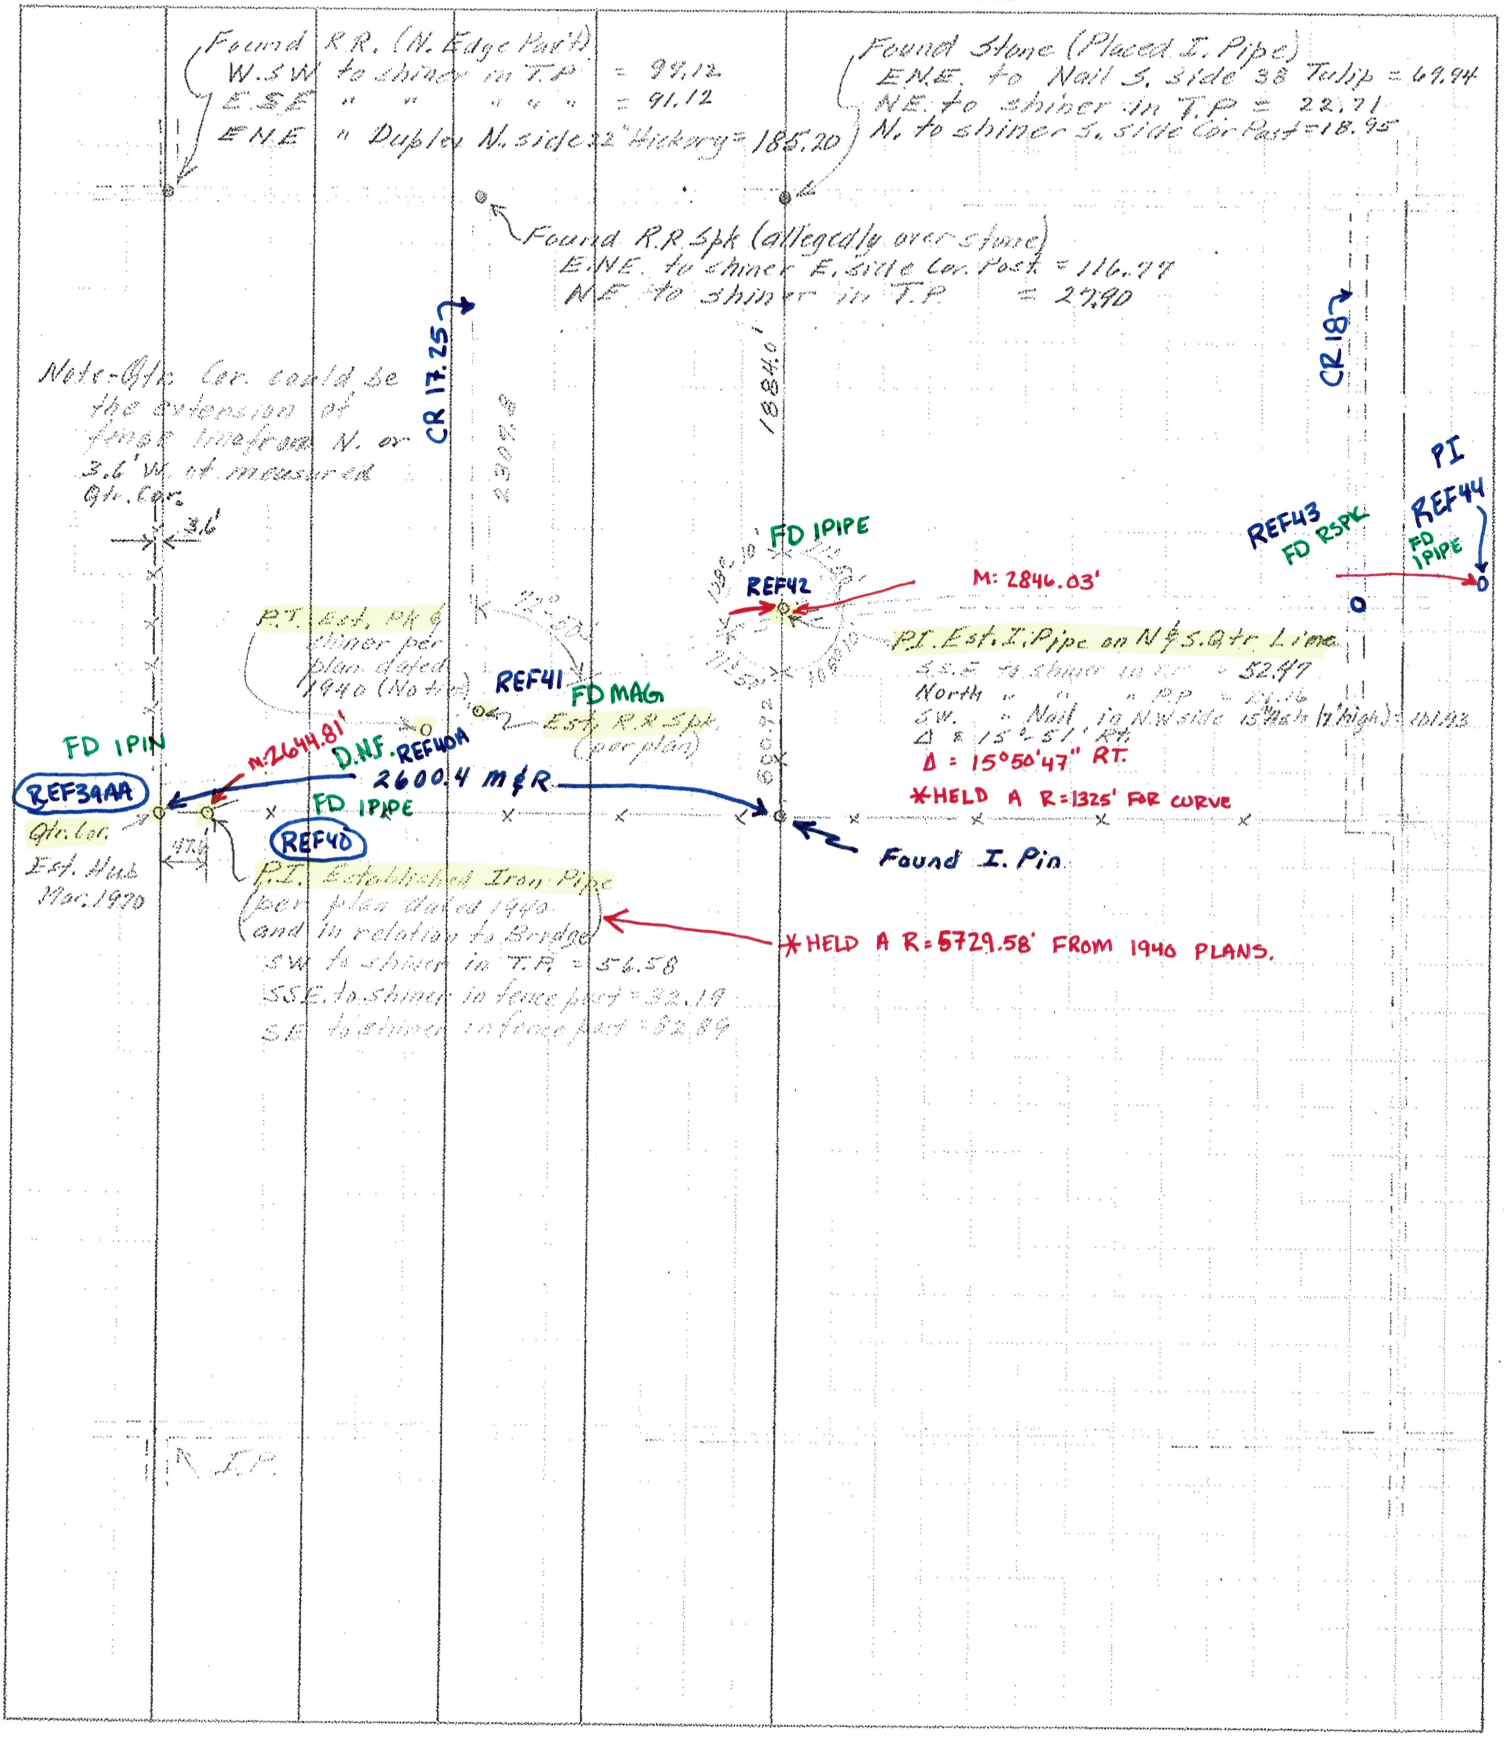

PERSONNEL | TITLE | PERSONNEL | TITLE

SHEET NO.


COUNTY Wi | DATE

S. R. 34 E 2 | WEATHER

SEC. 13 (Polaski Twp) | TEMP.

DESCRIPTION | JOB NO.

LEFT | CENTER LINE | RIGHT

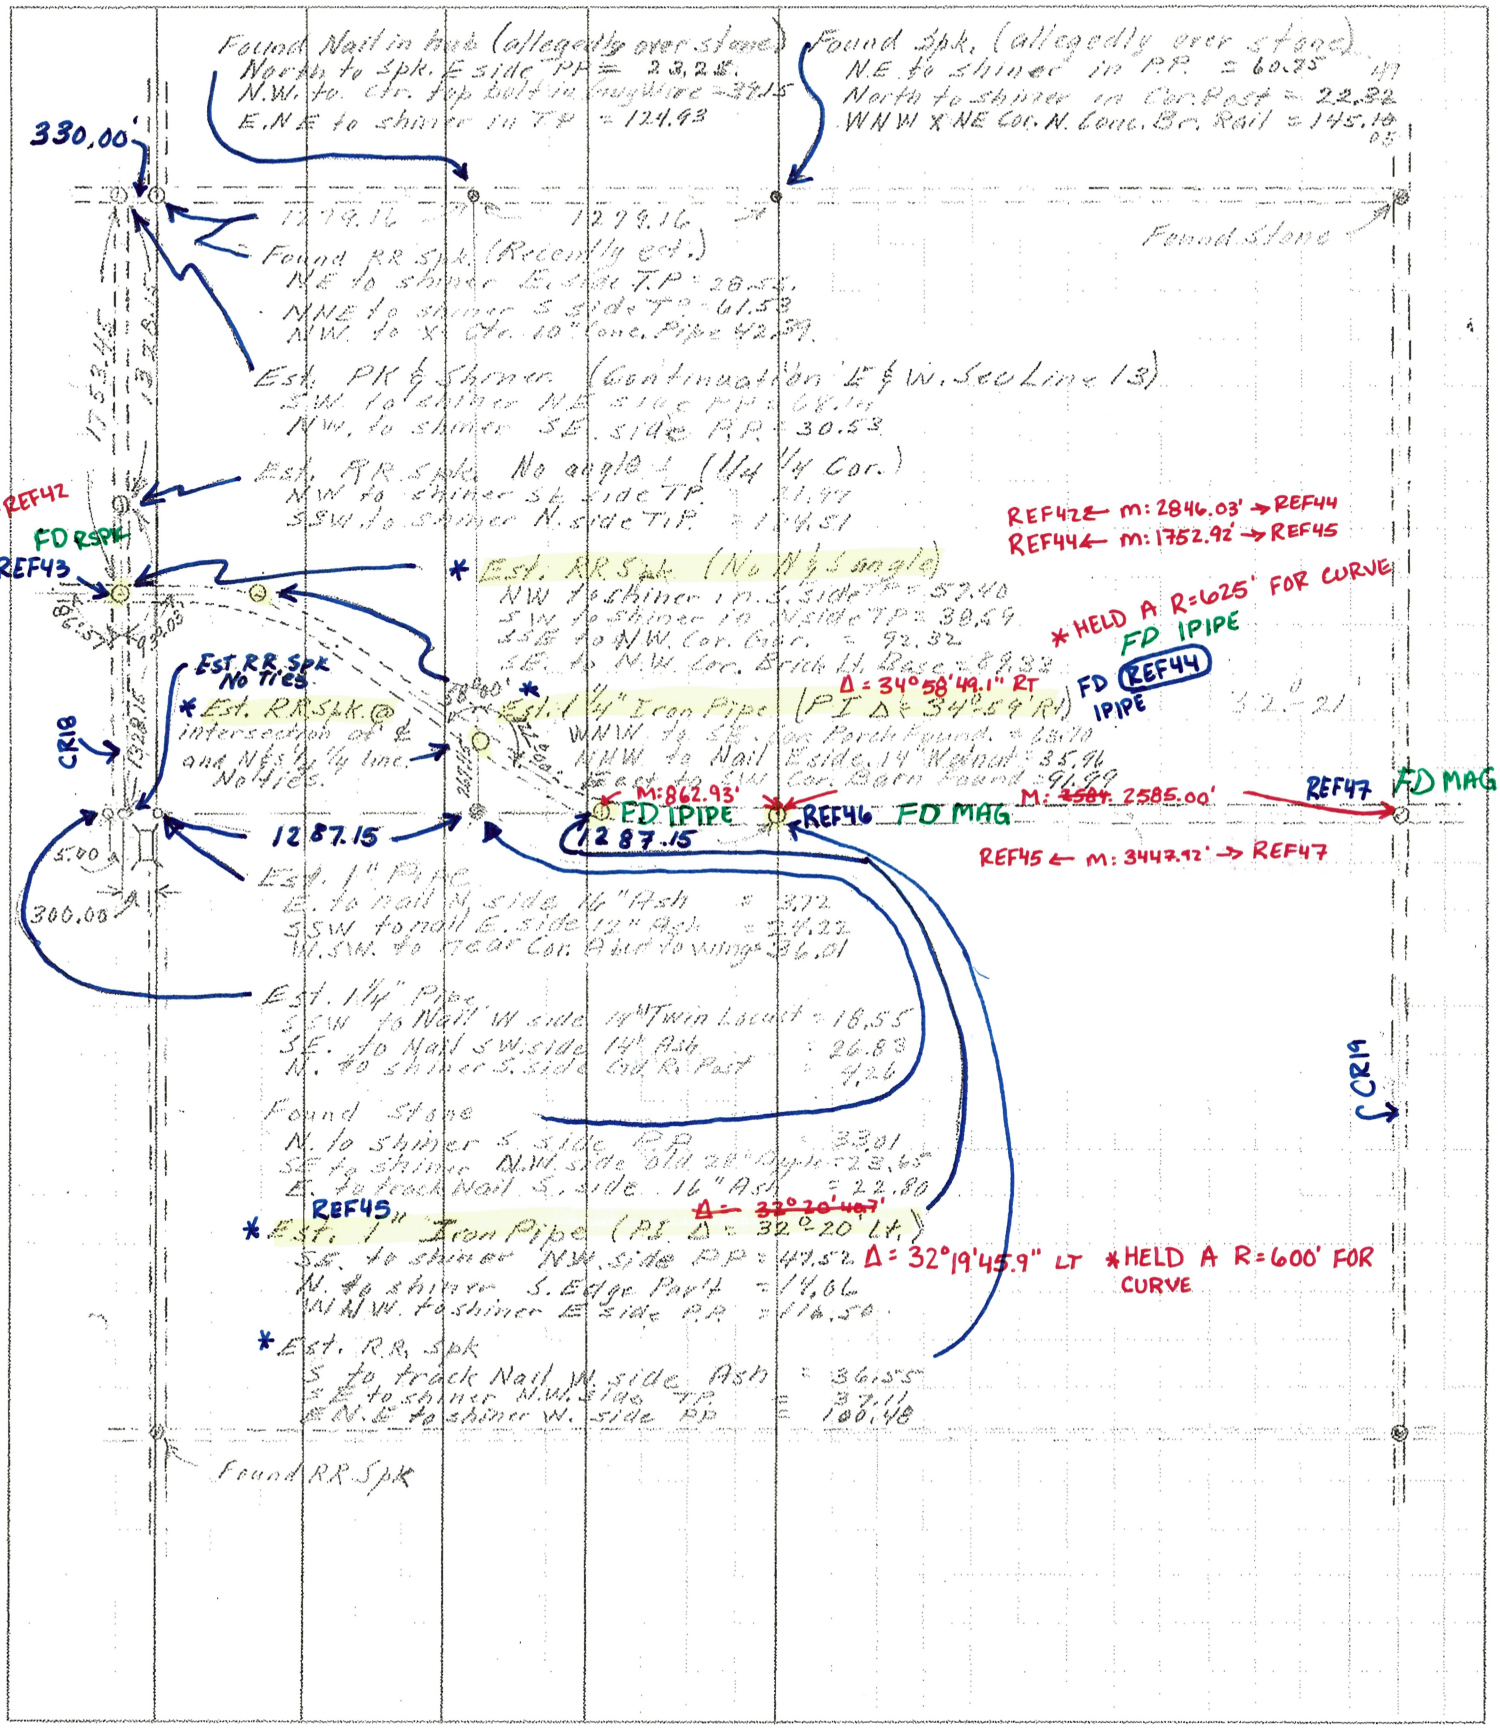

SHEET NO.

PERSONNEL	TITLE	PERSONNEL	TITLE


COUNTY Wil DATE

S. R. 34 & 2 WEATHER

SEC. 18 Springfield TWP TEMP

DESCRIPTION JOB NO.

LEFT CENTER LINE RIGHT

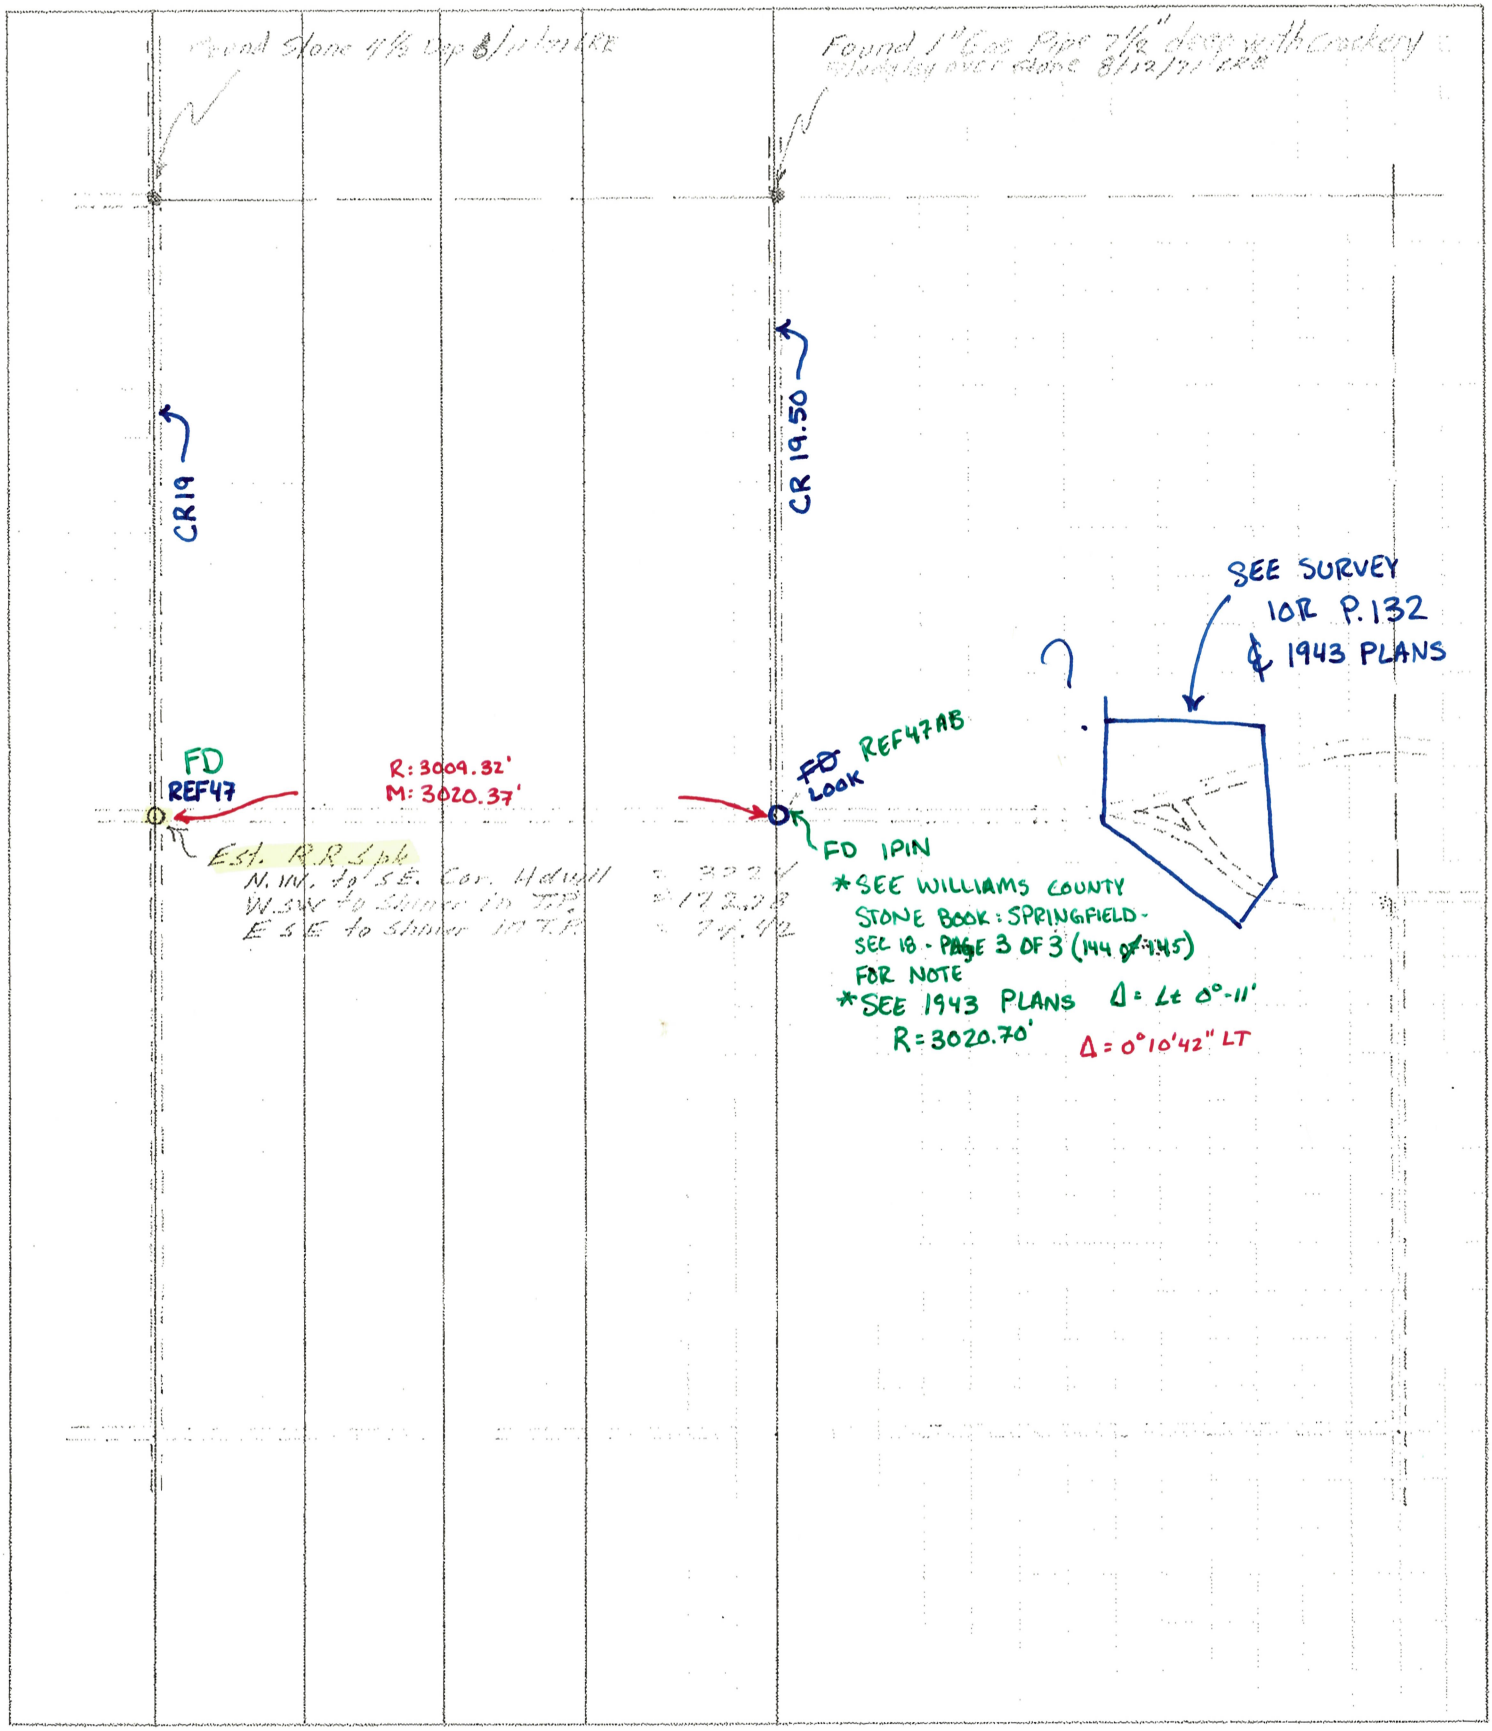

SHEET NO.

PERSONNEL	TITLE	PERSONNEL	TITLE


COUNTY Wil DATE

S. R. 34 & 2 WEATHER

SEC. 17 Springfield TWP TEMP.

DESCRIPTION JOB NO.

LEFT CENTER LINE RIGHT

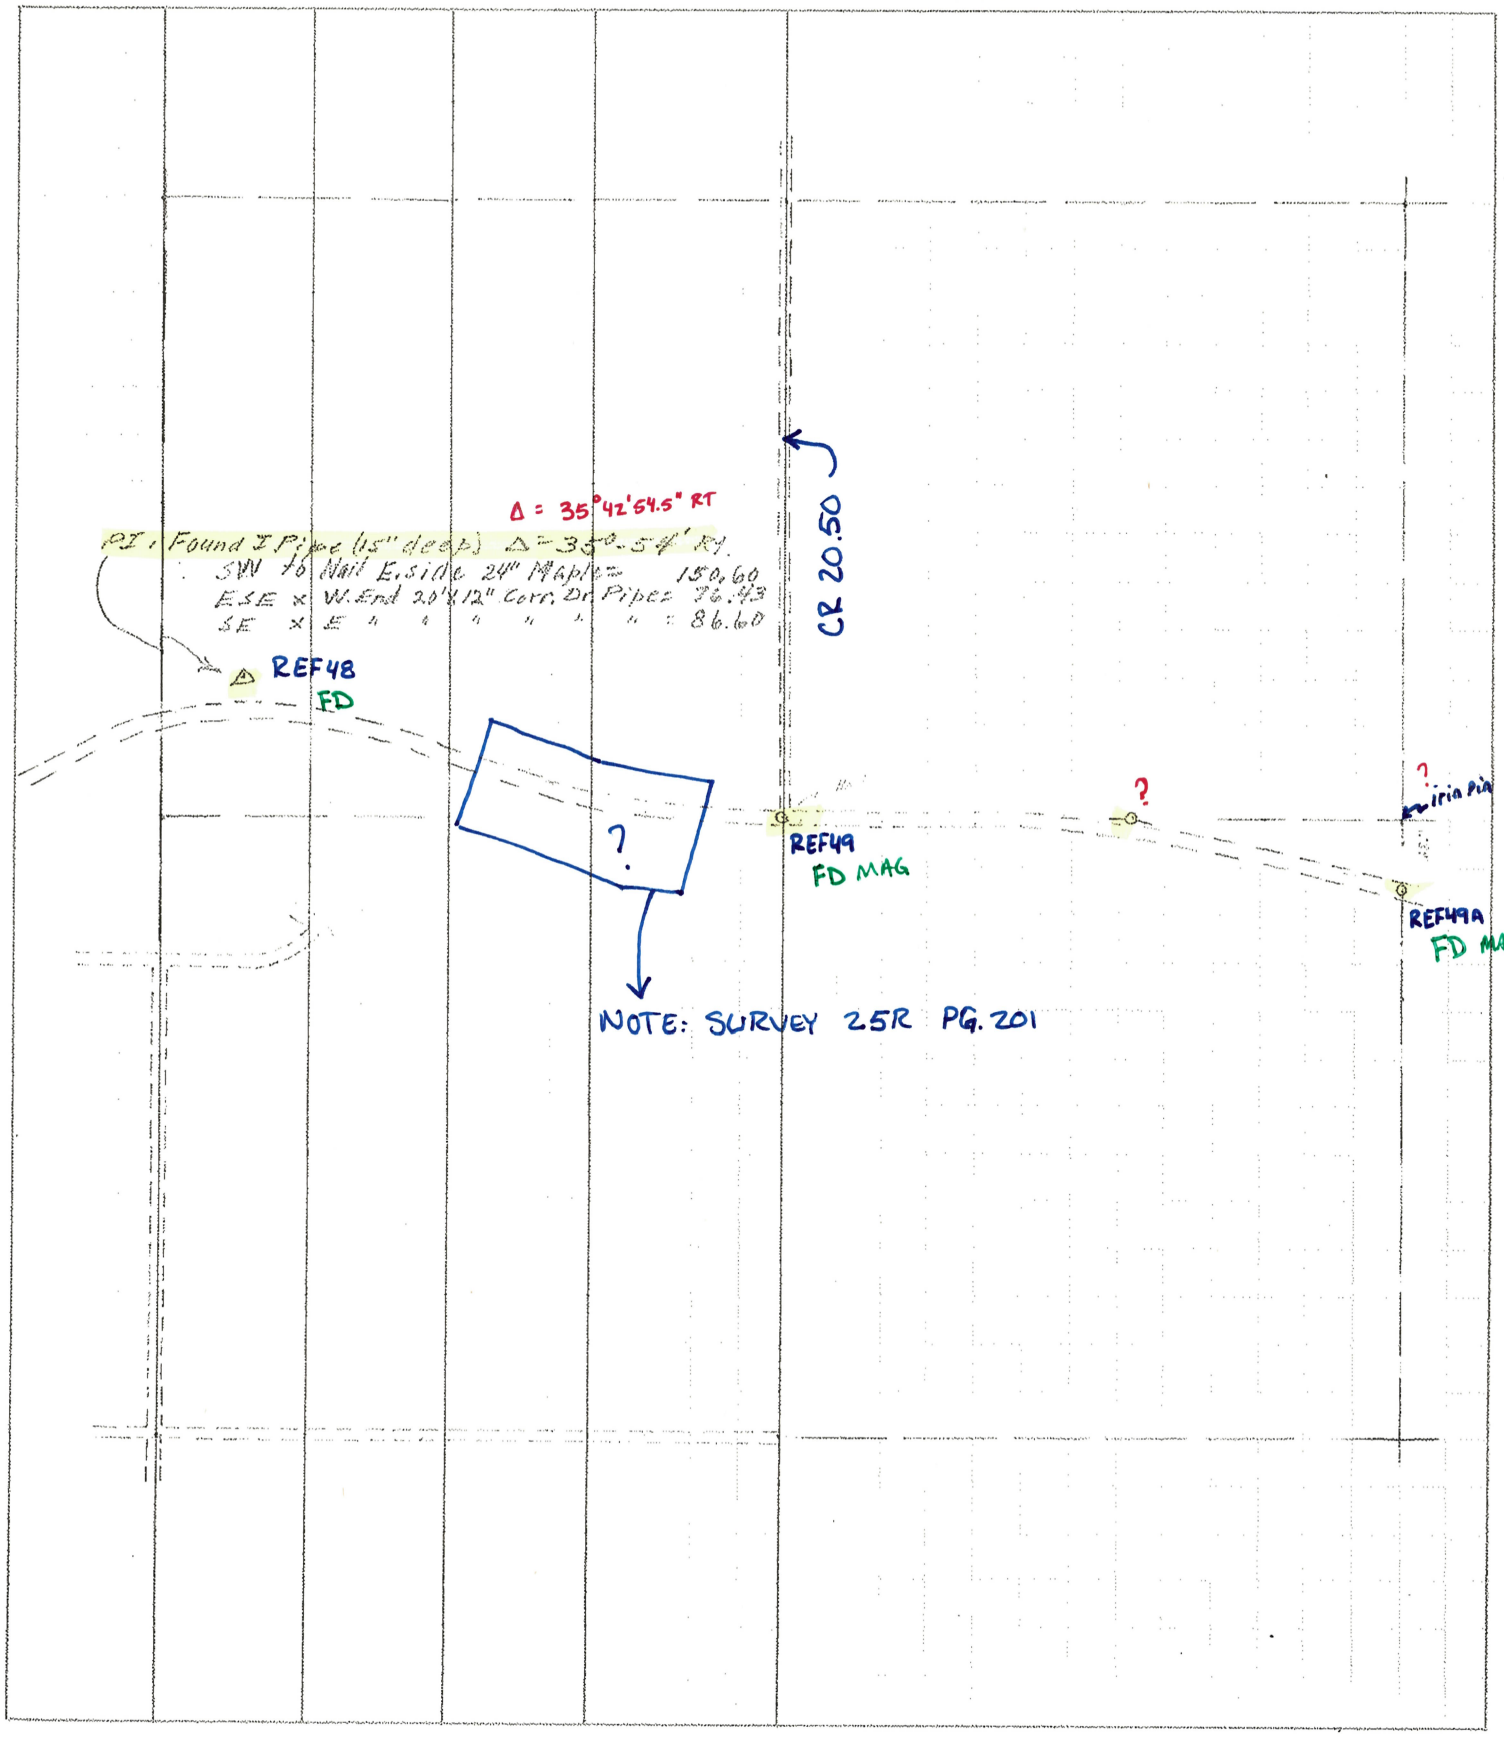

SHEET NO.

PERSONNEL	TITLE	PERSONNEL	TITLE
Lougs			
Erikson			
Ray			
Stickney			

COUNTY Wil DATE 4-1-70

S. R. 34 WEATHER Cloudy

SEC. 16 Springfield Twp. TEMP. 25°

DESCRIPTION JOB NO.

LEFT CENTER LINE RIGHT

