
107. TIF

# PLAT & SURVEY

Survey made for Ford - Day, Realtors of a parcel of land in the South ½ of Section 16 Town 6 North Range 3 East, Pulaski Township, Williams County, Ohio June 16th to July 9th inclusive 1964

Scale 1" = 50'

Note:
Quarter and Quarter Quarter stones found from previous Survey made by John Grim May 5th 1893

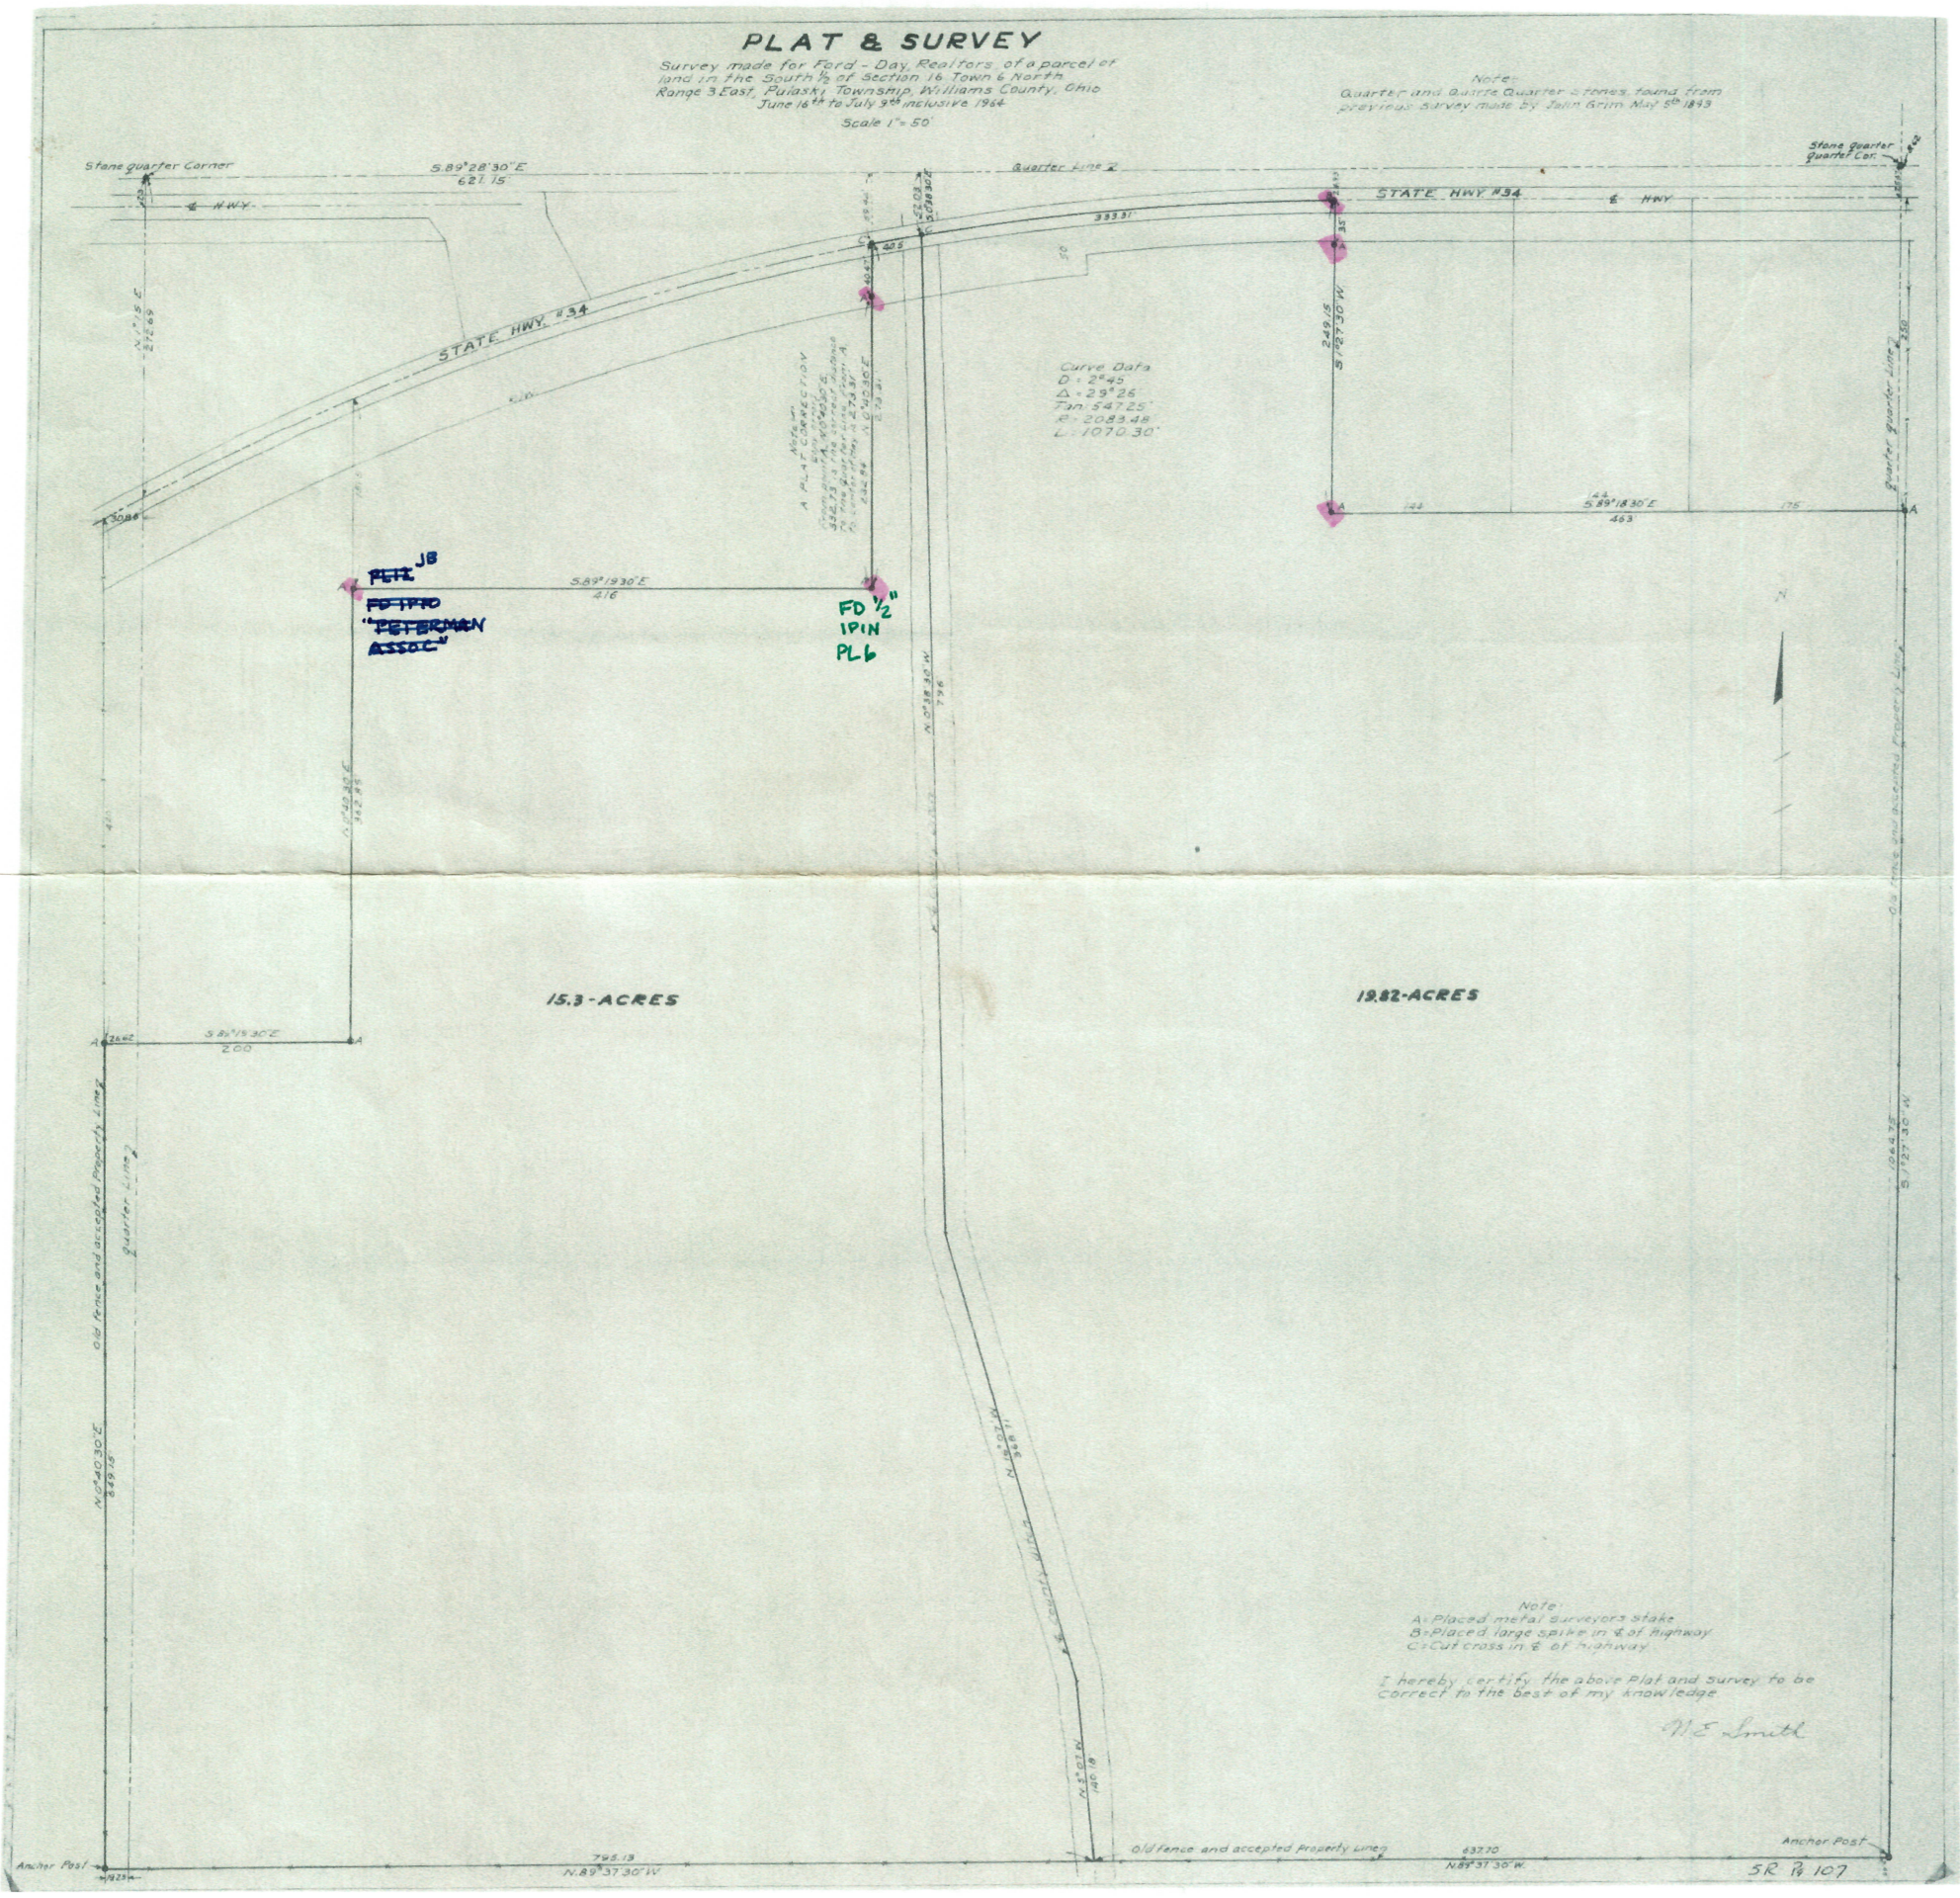


Note:
A = Placed metal surveyors stake
B = Placed large spike in ℄ of highway
C = Cut cross in ℄ of highway

I hereby certify the above Plat and survey to be correct to the best of my knowledge.

W E Smith

SR Pg 107