
WAYNE CARLIN

Located in the SE¼ of Section 18,
T6N, R4E, Springfield Township,
Williams County, Ohio

July 13, 1985

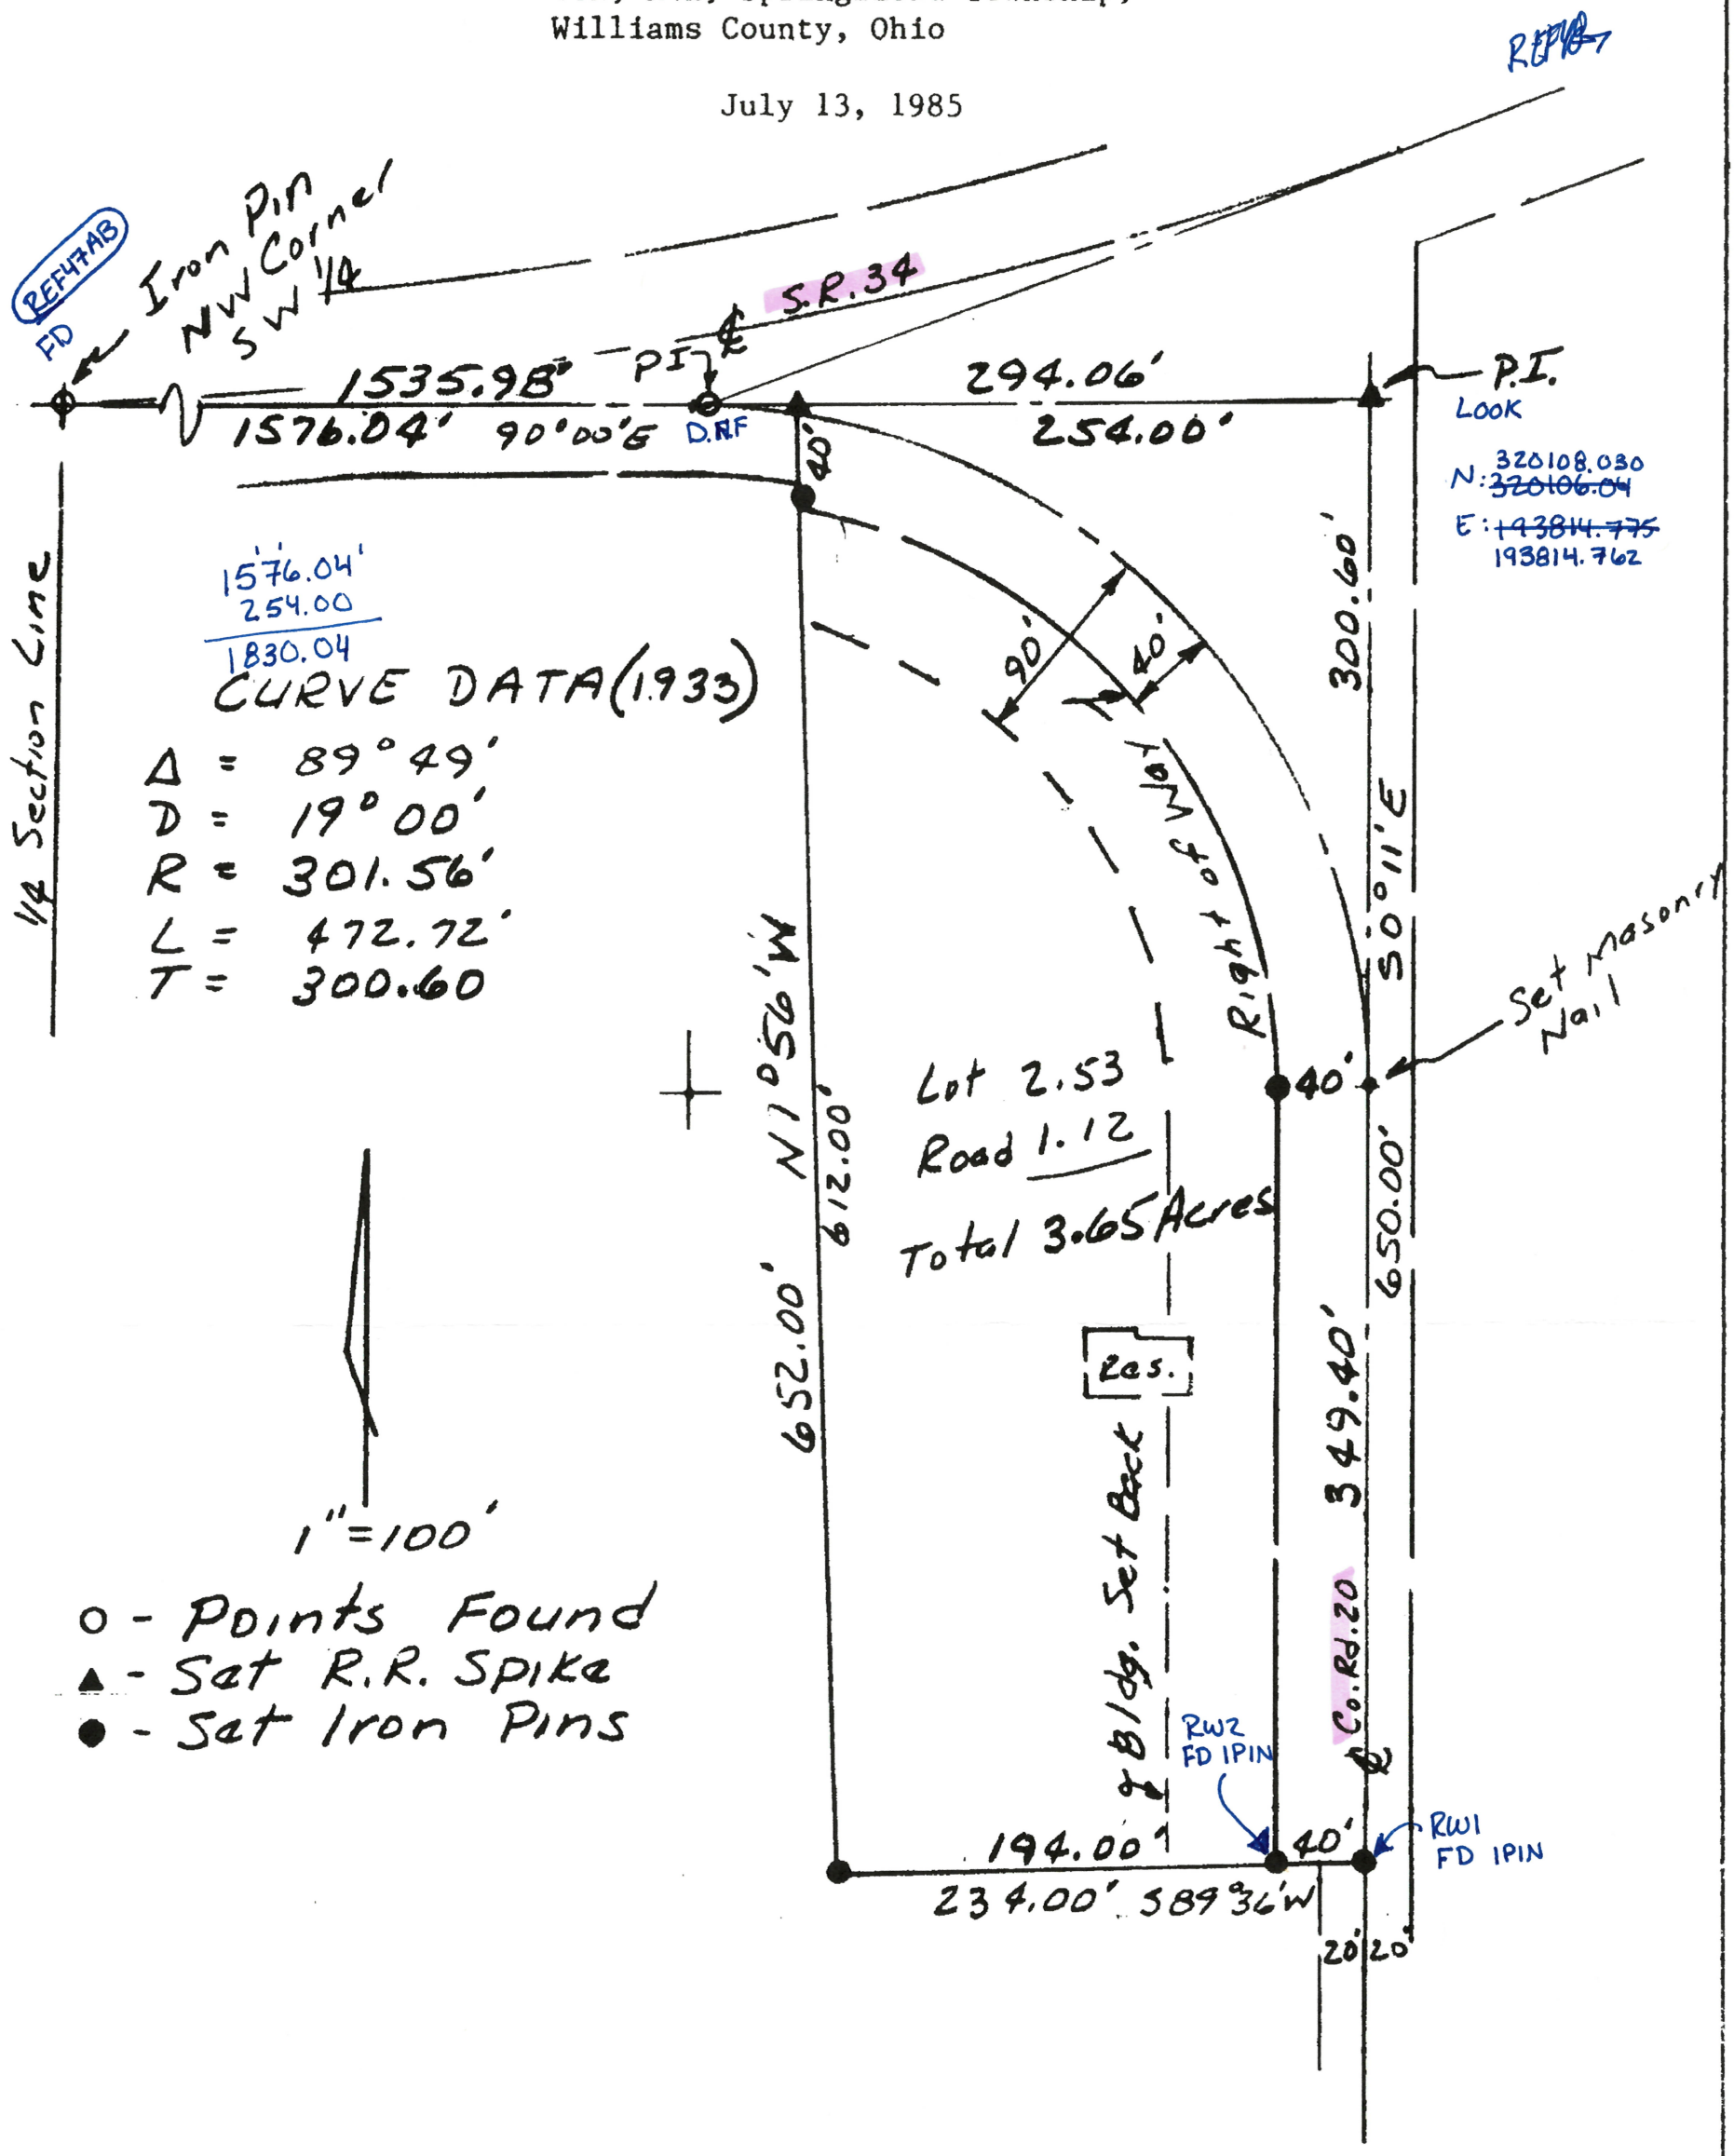

I hereby certify that this plat represents a survey made by me and that it is correct to the best of my knowledge and belief. All dimensions are shown in feet and decimal parts thereof.

Walter Schelling
Walter Schelling
Registered Surveyor #5570

A copy of the above plat is recorded in volume 10R, page 132, of the Williams County Survey Records.