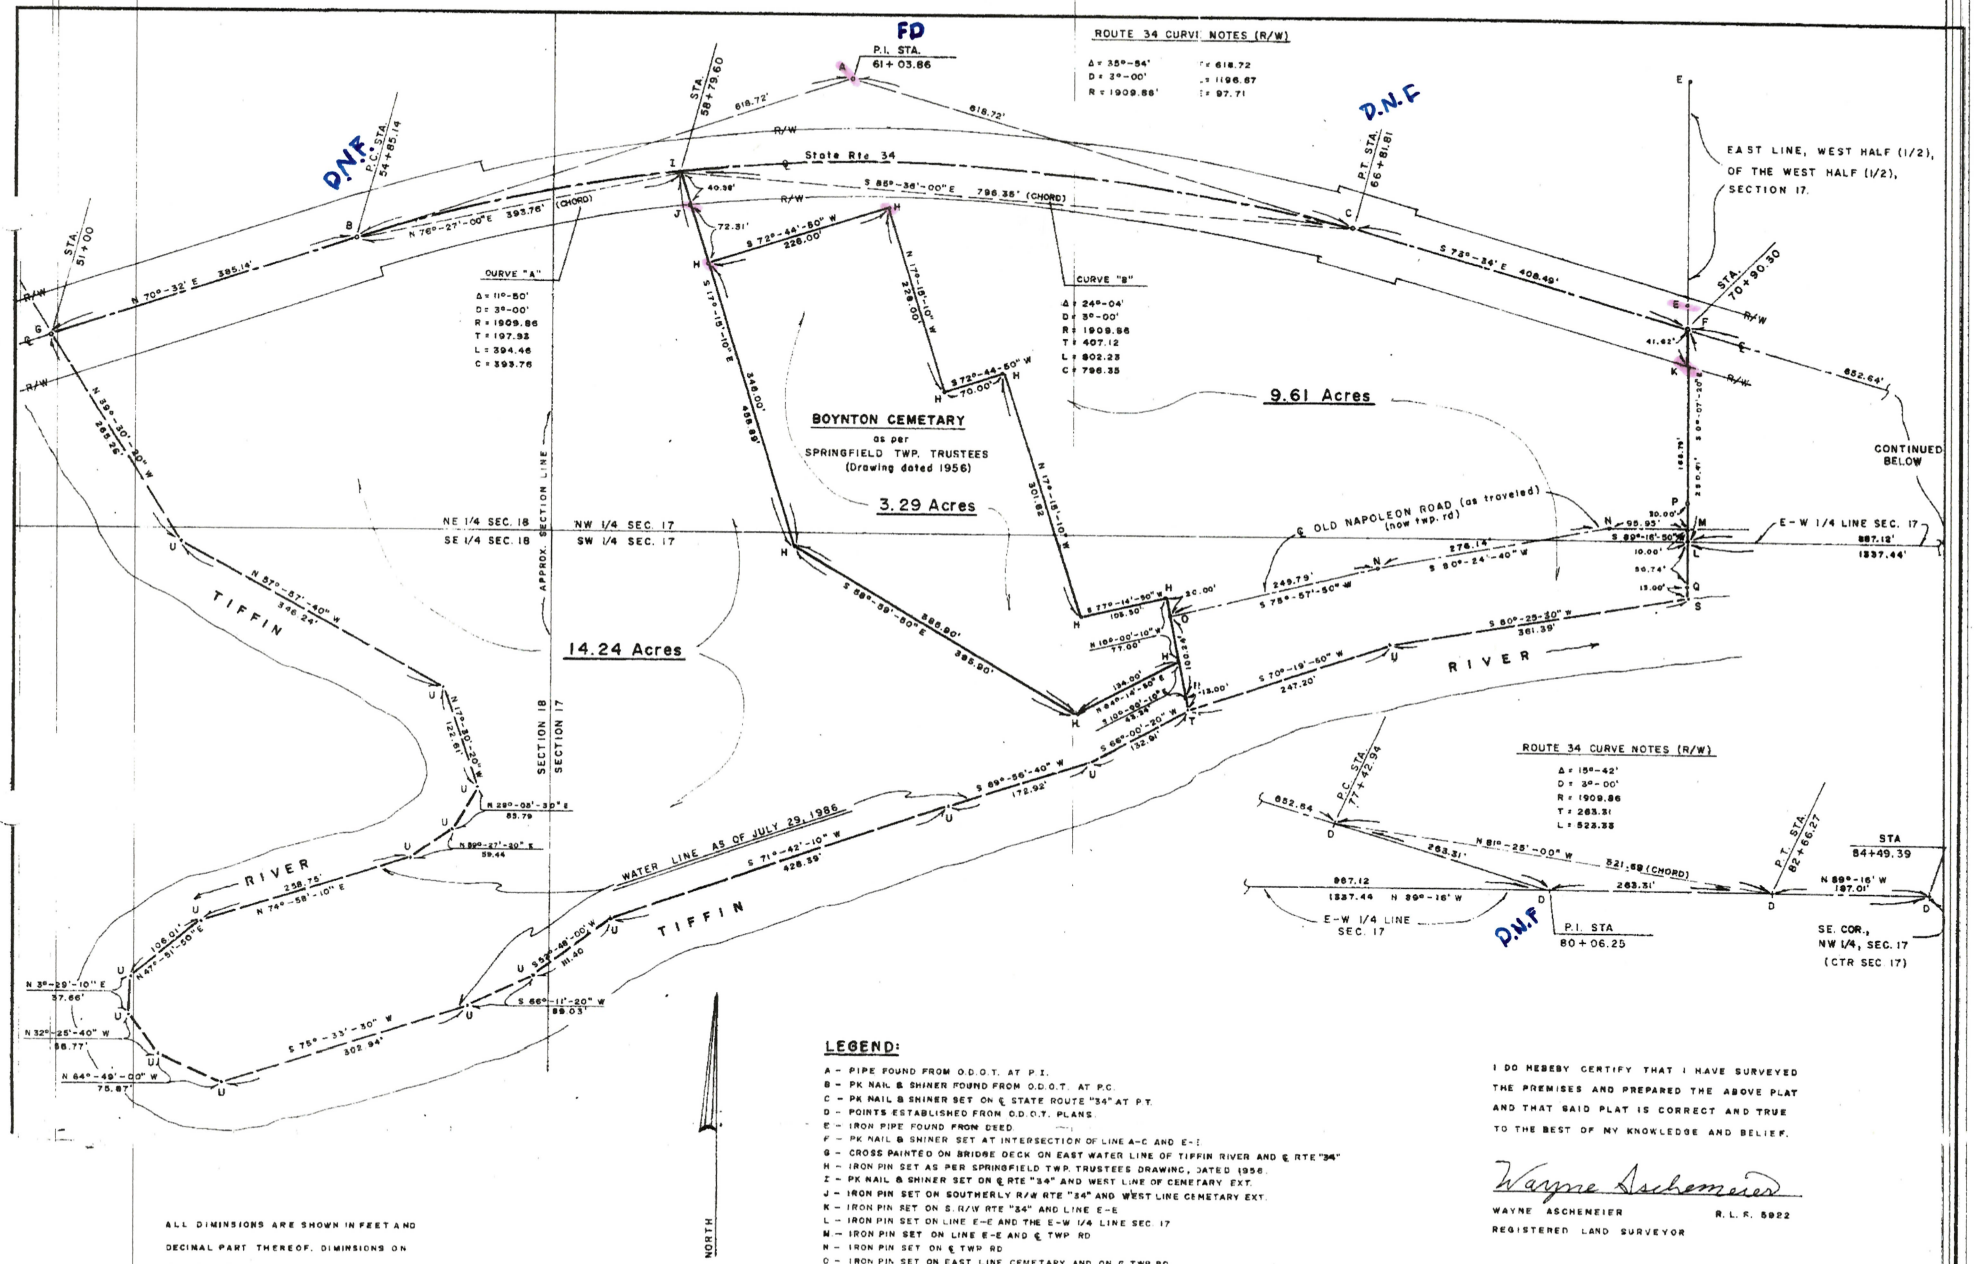


LEGEND:

A – PIPE FOUND FROM O.D.O.T. AT P.I.
B – PK NAIL & SHINER FOUND FROM O.D.O.T. AT P.C.
C – PK NAIL & SHINER SET ON ℄ STATE ROUTE "34" AT P.T.
D – POINTS ESTABLISHED FROM O.D.O.T. PLANS.
E – IRON PIPE FOUND FROM DEED.
F – PK NAIL & SHINER SET AT INTERSECTION OF LINE A-C AND E-E
G – CROSS PAINTED ON BRIDGE DECK ON EAST WATER LINE OF TIFFIN RIVER AND ℄ RTE "34"
H – IRON PIN SET AS PER SPRINGFIELD TWP. TRUSTEES DRAWING, DATED 1956.
I – PK NAIL & SHINER SET ON ℄ RTE "34" AND WEST LINE OF CEMETARY EXT.
J – IRON PIN SET ON SOUTHERLY R/W RTE "34" AND WEST LINE CEMETARY EXT.
K – IRON PIN SET ON S. R/W RTE "34" AND LINE E-E
L – IRON PIN SET ON LINE E-E AND THE E-W 1/4 LINE SEC. 17
M – IRON PIN SET ON LINE E-E AND ℄ TWP. RD
N – IRON PIN SET ON ℄ TWP. RD
O – IRON PIN SET ON EAST LINE CEMETARY AND ON ℄ TWP RD
P – IRON PIN SET ON LINE E-E AND ON NORTHLY R/W TWP RD
Q – IRON PIN SET ON LINE E-E AND ON BANK OF TIFFIN RIVER
R – IRON PIN SET ON EAST LINE CEMETARY EXT. AND BANK OF TIFFIN RIVER
S – POINT ESTABLISHED ON NORTHERLY WATER LINE OF TIFFIN RIVER AND LINE E-E
T – POINT ESTABLISHED ON NORTHERLY WATER LINE OF TIFFIN RIVER AND EAST LINE OF CEMETARY EXT.
U – POINT ESTABLISHED ON NORTHERLY AND EASTERLY WATERLINE OF TIFFIN RIVER THIS DATE

ALL DIMINSIONS ARE SHOWN IN FEET AND DECIMAL PART THEREOF. DIMINSIONS ON CURVES ARE CHORD MEASURMENTS. THIS SURVEY HAS BEEN FILED IN VOLUME 10R PAGE 316 OF THE WILLIAMS COUNTY RECORD OF SURVEYS IN THE WILLIAMS COUNTY ENGINEERS OFFICE, COURTHOUSE, BRYAN, OHIO.

I DO HEREBY CERTIFY THAT I HAVE SURVEYED THE PREMISES AND PREPARED THE ABOVE PLAT AND THAT SAID PLAT IS CORRECT AND TRUE TO THE BEST OF MY KNOWLEDGE AND BELIEF.

Wayne Aschemeier

WAYNE ASCHEMEIER R.L.R. 5922
REGISTERED LAND SURVEYOR

WAYNE ASCHEMEIER SURVEYING
P.O. Box 91
RIDGEVILLE CORNERS, OHIO 43555
(419) 267-5215

PLAT OF SURVEY
FOR ERIC DOEHRMANN

SCALE: 1" = 100'	APPROVED BY:	DRAWN BY
DATE: 7-30-86		REVISED

LOCATED IN THE WEST HALF (1/2) OF SECTION 17 AND THE EAST HALF (1/2) OF SECTION 18, SPRINGFIELD TWP., T-6-N, R-4-E
WILLIAMS COUNTY, OHIO.

DRAWING NUMBER B-86406-1

ON NO. 1000M CLEARPRINT