
PLAT & SURVEY

LOCATED IN THE NORTHEAST QUARTER, SECTION 16, TOWN 6–NORTH,
RANGE 3 EAST, PULASKI TOWNSHIP, WILLIAMS COUNTY, OHIO

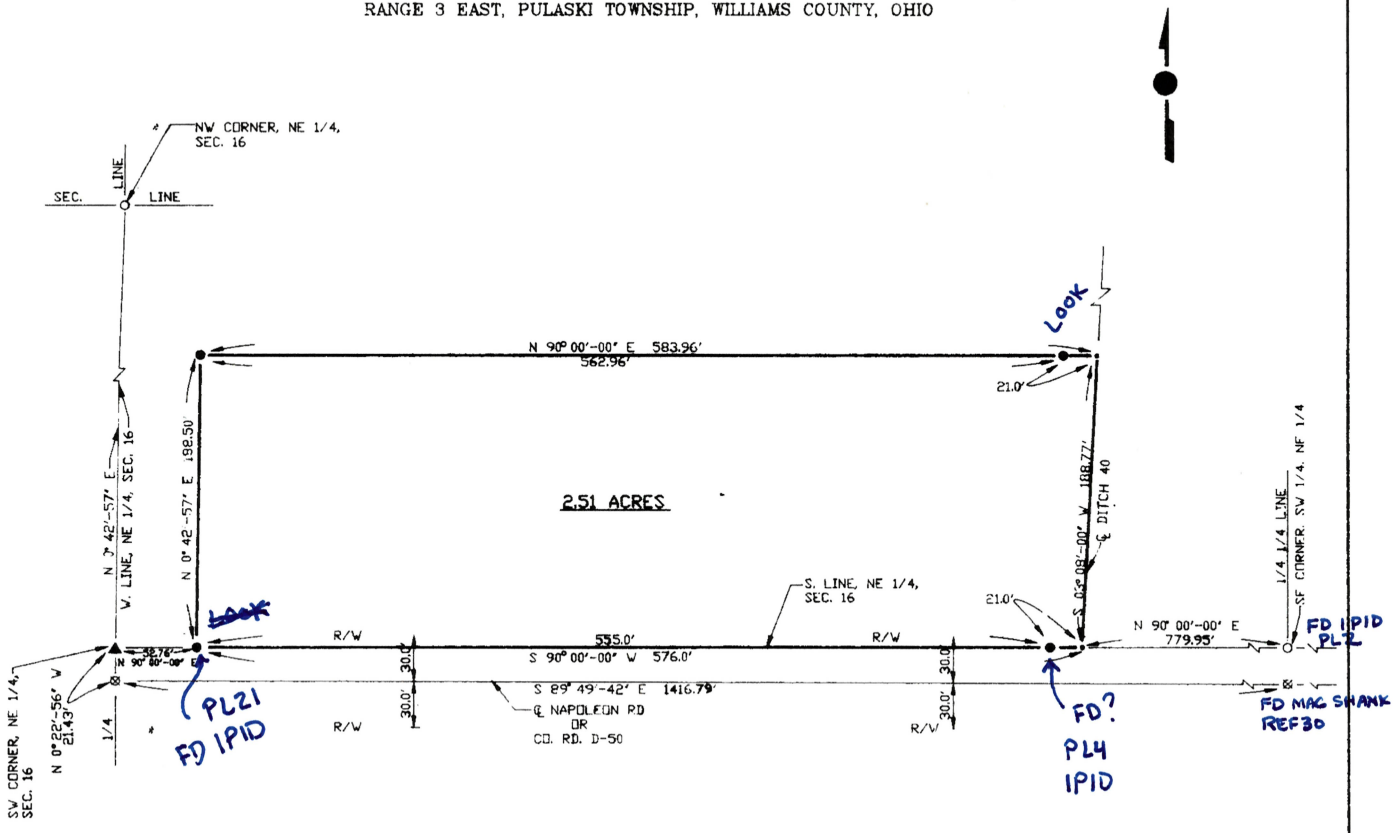

LEGEND

- ● PLACED 5/8" REBAR W/ CAP
- —•— POINT ESTABLISHED THIS SURVEY
- ▣ FOUND RAILROAD SPIKE
- ○ FOUND IRON PIN OR PIPE
- ▲ FOUND STONE

I hereby certify that I have surveyed the premises and prepared the above plat and that said plat is correct to the best of my knowledge and belief. All dimensions are shown in feet and decimal parts thereof. This survey has been recorded in Vol. 12R Page 70 of the Williams County Record of Surveys.

Dennis M. Bell
Registered Surveyor #6717

STATE OF OHIO · DENNIS M. BELL · 6717 · REGISTERED · SURVEYOR

SCALE : 1"=60.0'
DATE : 5/24/89
JOB NO : OS-64-89

BELL ENGINEERING LIMITED, INC.
CONSULTING ENGINEERS & SURVEYORS
05691A ST. RT. 15 – P.O. BOX 565
BRYAN, OHIO 43506