
PLAT OF SURVEY

BEING A PARCEL OF LAND SITUATED IN THE NORTHWEST QUARTER AND THE NORTHEAST QUARTER, SECTION 16, TOWN 6 NORTH, RANGE 3 EAST, PULASKI TOWNSHIP, WILLIAMS COUNTY, OHIO.

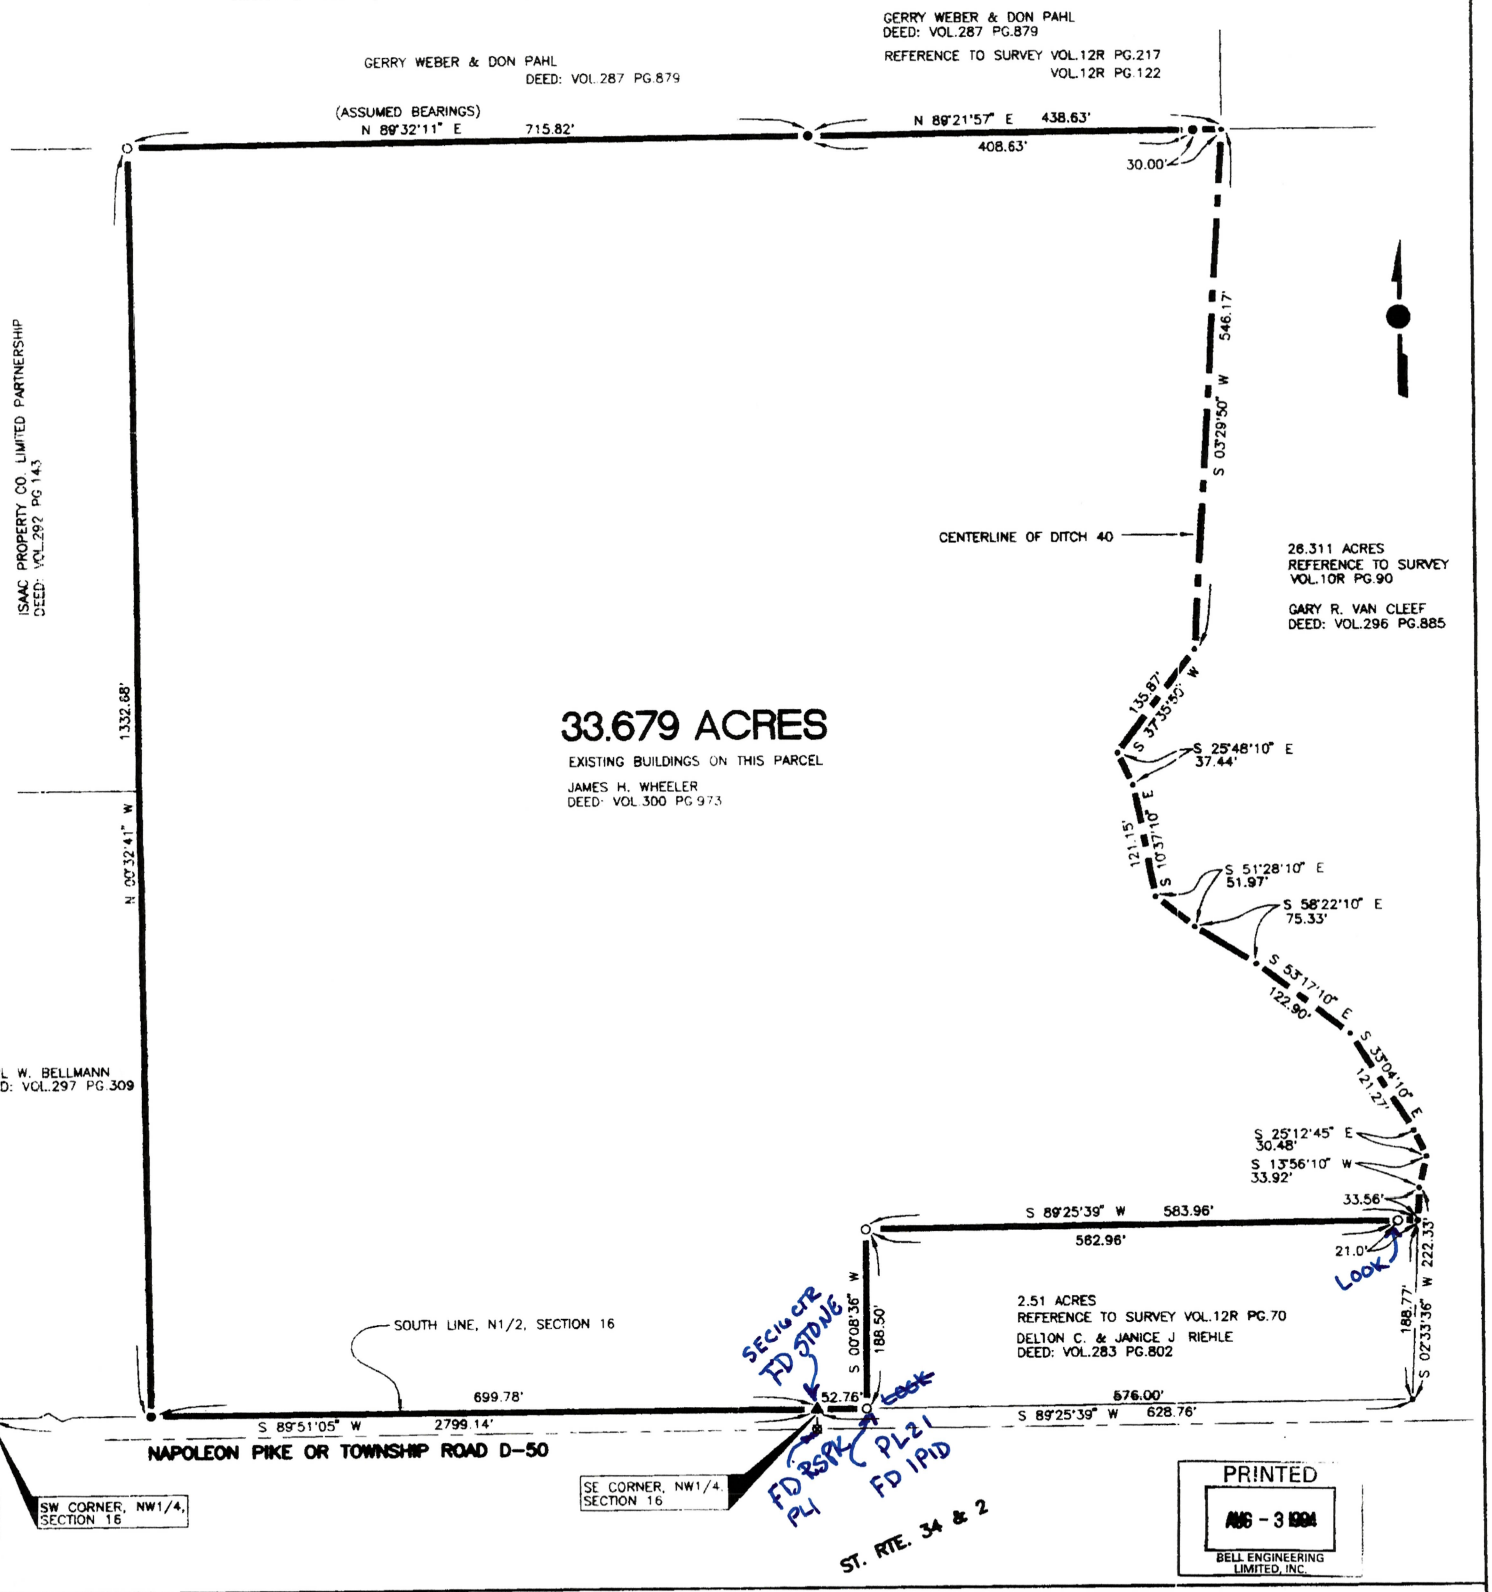

PRINTED
AUG - 3 1994
BELL ENGINEERING LIMITED, INC.

LEGEND

- ● PLACED 5/8" REBAR W/ CAP
- —•— POINT ESTABLISHED THIS SURVEY
- ▲ FOUND STONE
- ■ FOUND RAILROAD SPIKE
- O FOUND IRON PIN OR PIPE

I HEREBY CERTIFY THAT I HAVE SURVEYED THE PREMISES SHOWN ON THE PLAT ABOVE. ALL DIMENSIONS ARE SHOWN IN FEET AND DECIMALS THEREOF. SINCE THIS SURVEY WORK DOES NOT INCLUDE A TITLE SEARCH, THERE COULD BE EASEMENTS OR OTHER ENCUMBRANCES UPON THE LAND WHICH ARE NOT SHOWN ON THIS SURVEY PLAT. IF THESE ARE REQUIRED, PLEASE FURNISH THE NECESSARY INFORMATION. THIS SURVEY HAS BEEN RECORDED IN VOL 15R PAGE 29 OF THE WILLIAMS COUNTY RECORD OF SURVEYS.

STATE OF OHIO
DENNIS M. BELL
6717
REGISTERED SURVEYOR

DENNIS M. BELL
REGISTERED SURVEYOR NO. 6717

DRAWING NO. OS18694

JOB NO: OS-186-94 DATE: 07/28/94 SCALE: 1" = 100.0'

BELL ENGINEERING LIMITED, INC.
CONSULTING ENGINEERS + SURVEYORS
0589A ST. RT. 15 - P.O. BOX 565
BRYAN, OHIO 43506