
PLAT OF SURVEY

KNOWN AS AND BEING LOTS 3, 4 AND PART OF LOTS 5 ,6 AND 7 IN BLOCK E OF GINGERICH SUBDIVISION NUMBER 1. LOCATED IN THE SOUTHWEST QUARTER, SECTION 16, TOWN 6 NORTH, RANGE 3 EAST, PULASKI TOWNSHIP, WILLIAMS COUNTY, OHIO.

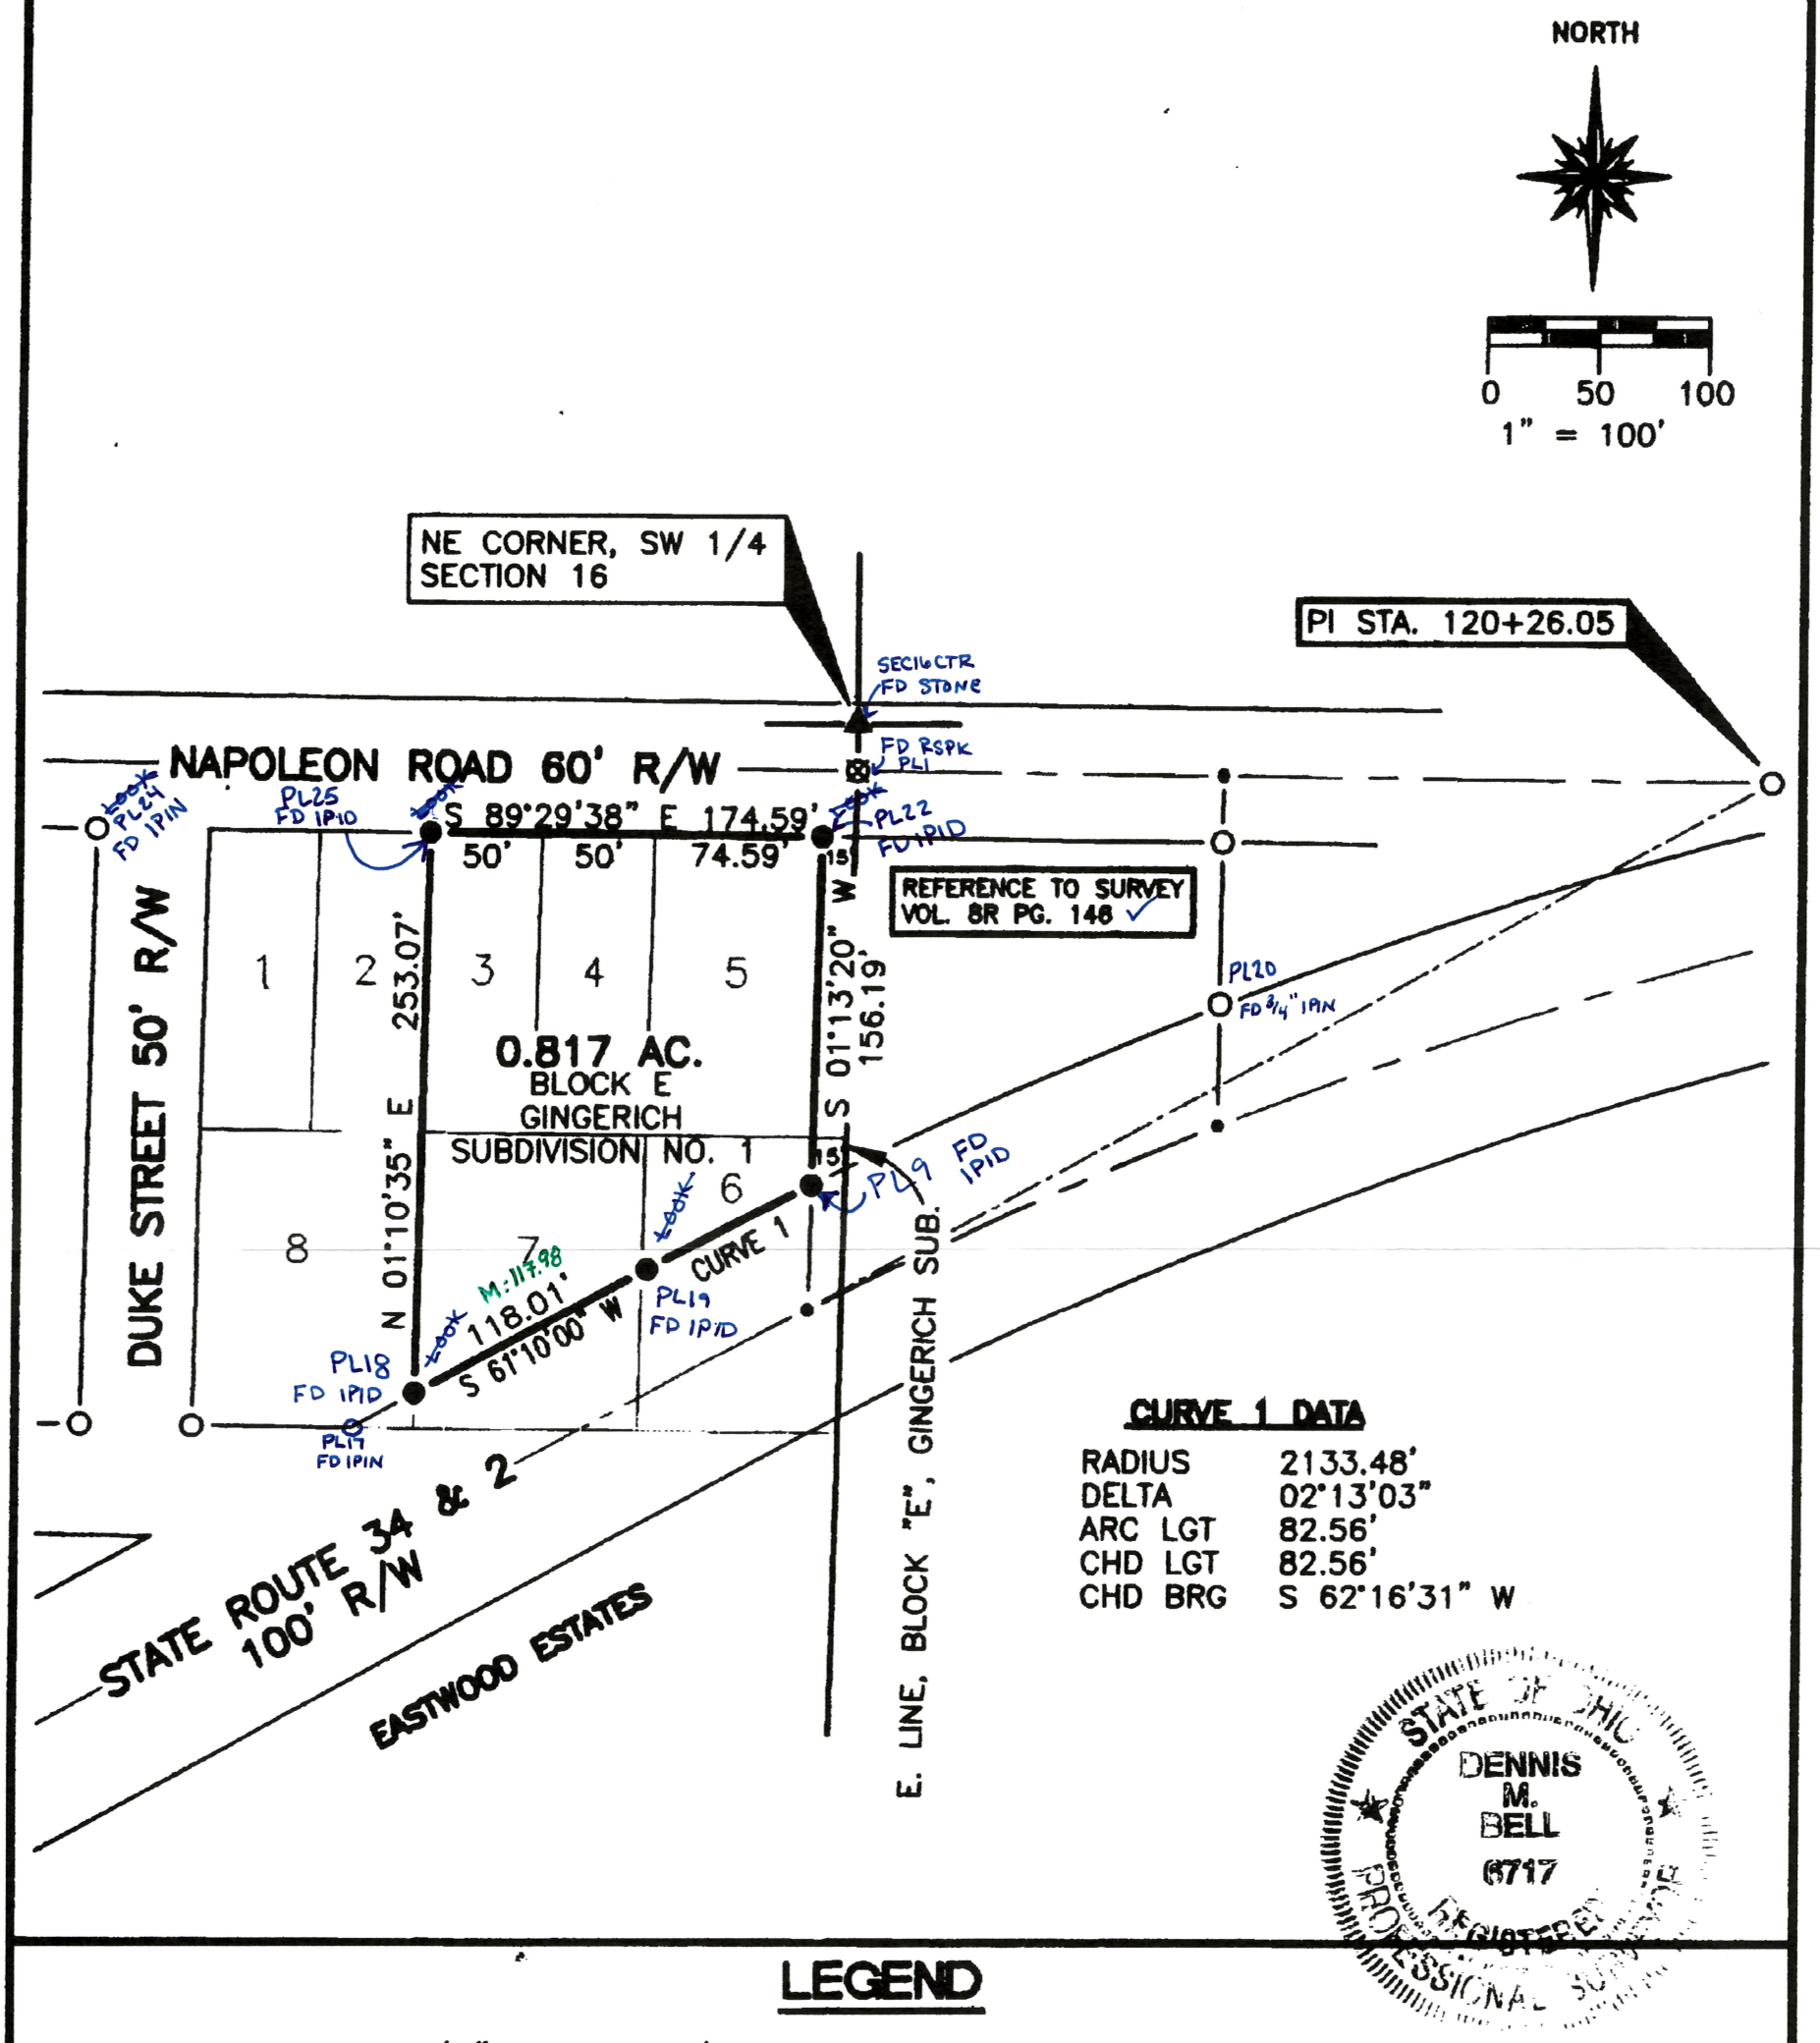

CURVE 1 DATA

RADIUS	2133.48'
DELTA	02°13'03"
ARC LGT	82.56'
CHD LGT	82.56'
CHD BRG	S 62°16'31" W

STATE OF OHIO
DENNIS M. BELL
6717
REGISTERED PROFESSIONAL SURVEYOR

LEGEND

- ● PLACED 1/2" REBAR W/ CAP
- —•— POINT ESTABLISHED THIS SURVEY
- ⊠ FOUND RAILROAD SPIKE
- O FOUND IRON PIN OR PIPE
- ▲ FOUND STONE

I HEREBY CERTIFY THAT I HAVE SURVEYED THE PREMISES SHOWN ON THE PLAT ABOVE. ALL DIMENSIONS ARE SHOWN IN FEET AND DECIMALS THEREOF. SINCE THIS SURVEY WORK DOES NOT INCLUDE A TITLE SEARCH, THERE COULD BE EASEMENTS OR OTHER ENCUMBRANCES UPON THE LAND WHICH ARE NOT SHOWN ON THIS SURVEY PLAT. IF THESE ARE REQUIRED, PLEASE FURNISH THE NECESSARY INFORMATION. THIS SURVEY HAS BEEN RECORDED IN VOL 18R PAGE 72 OF THE WILLIAMS COUNTY RECORD OF SURVEYS.

DENNIS M. BELL
REGISTERED SURVEYOR NO. 6717

JOB NO : 99-086 | DATE : 04/08/99

Bell Engineering United Inc.
5691 State Route 15
P.O. Box 585
Bryan, Ohio 43506
419•636•2585
fax 419•636•8434