
PLAT OF SURVEY

BEING LOTS 5, 6, AND PART OF 4,7, & 8 IN BLOCK D OF GINGERICH SUBDIVISION NUMBER ONE, SITUATED IN THE SOUTHWEST QUARTER OF SECTION 16, TOWN 6N, RANGE 3E, PULASKI TOWNSHIP, WILLIAMS COUNTY, OHIO

OWNER:
BEVER
DEED:
Vol 319 PG 1004

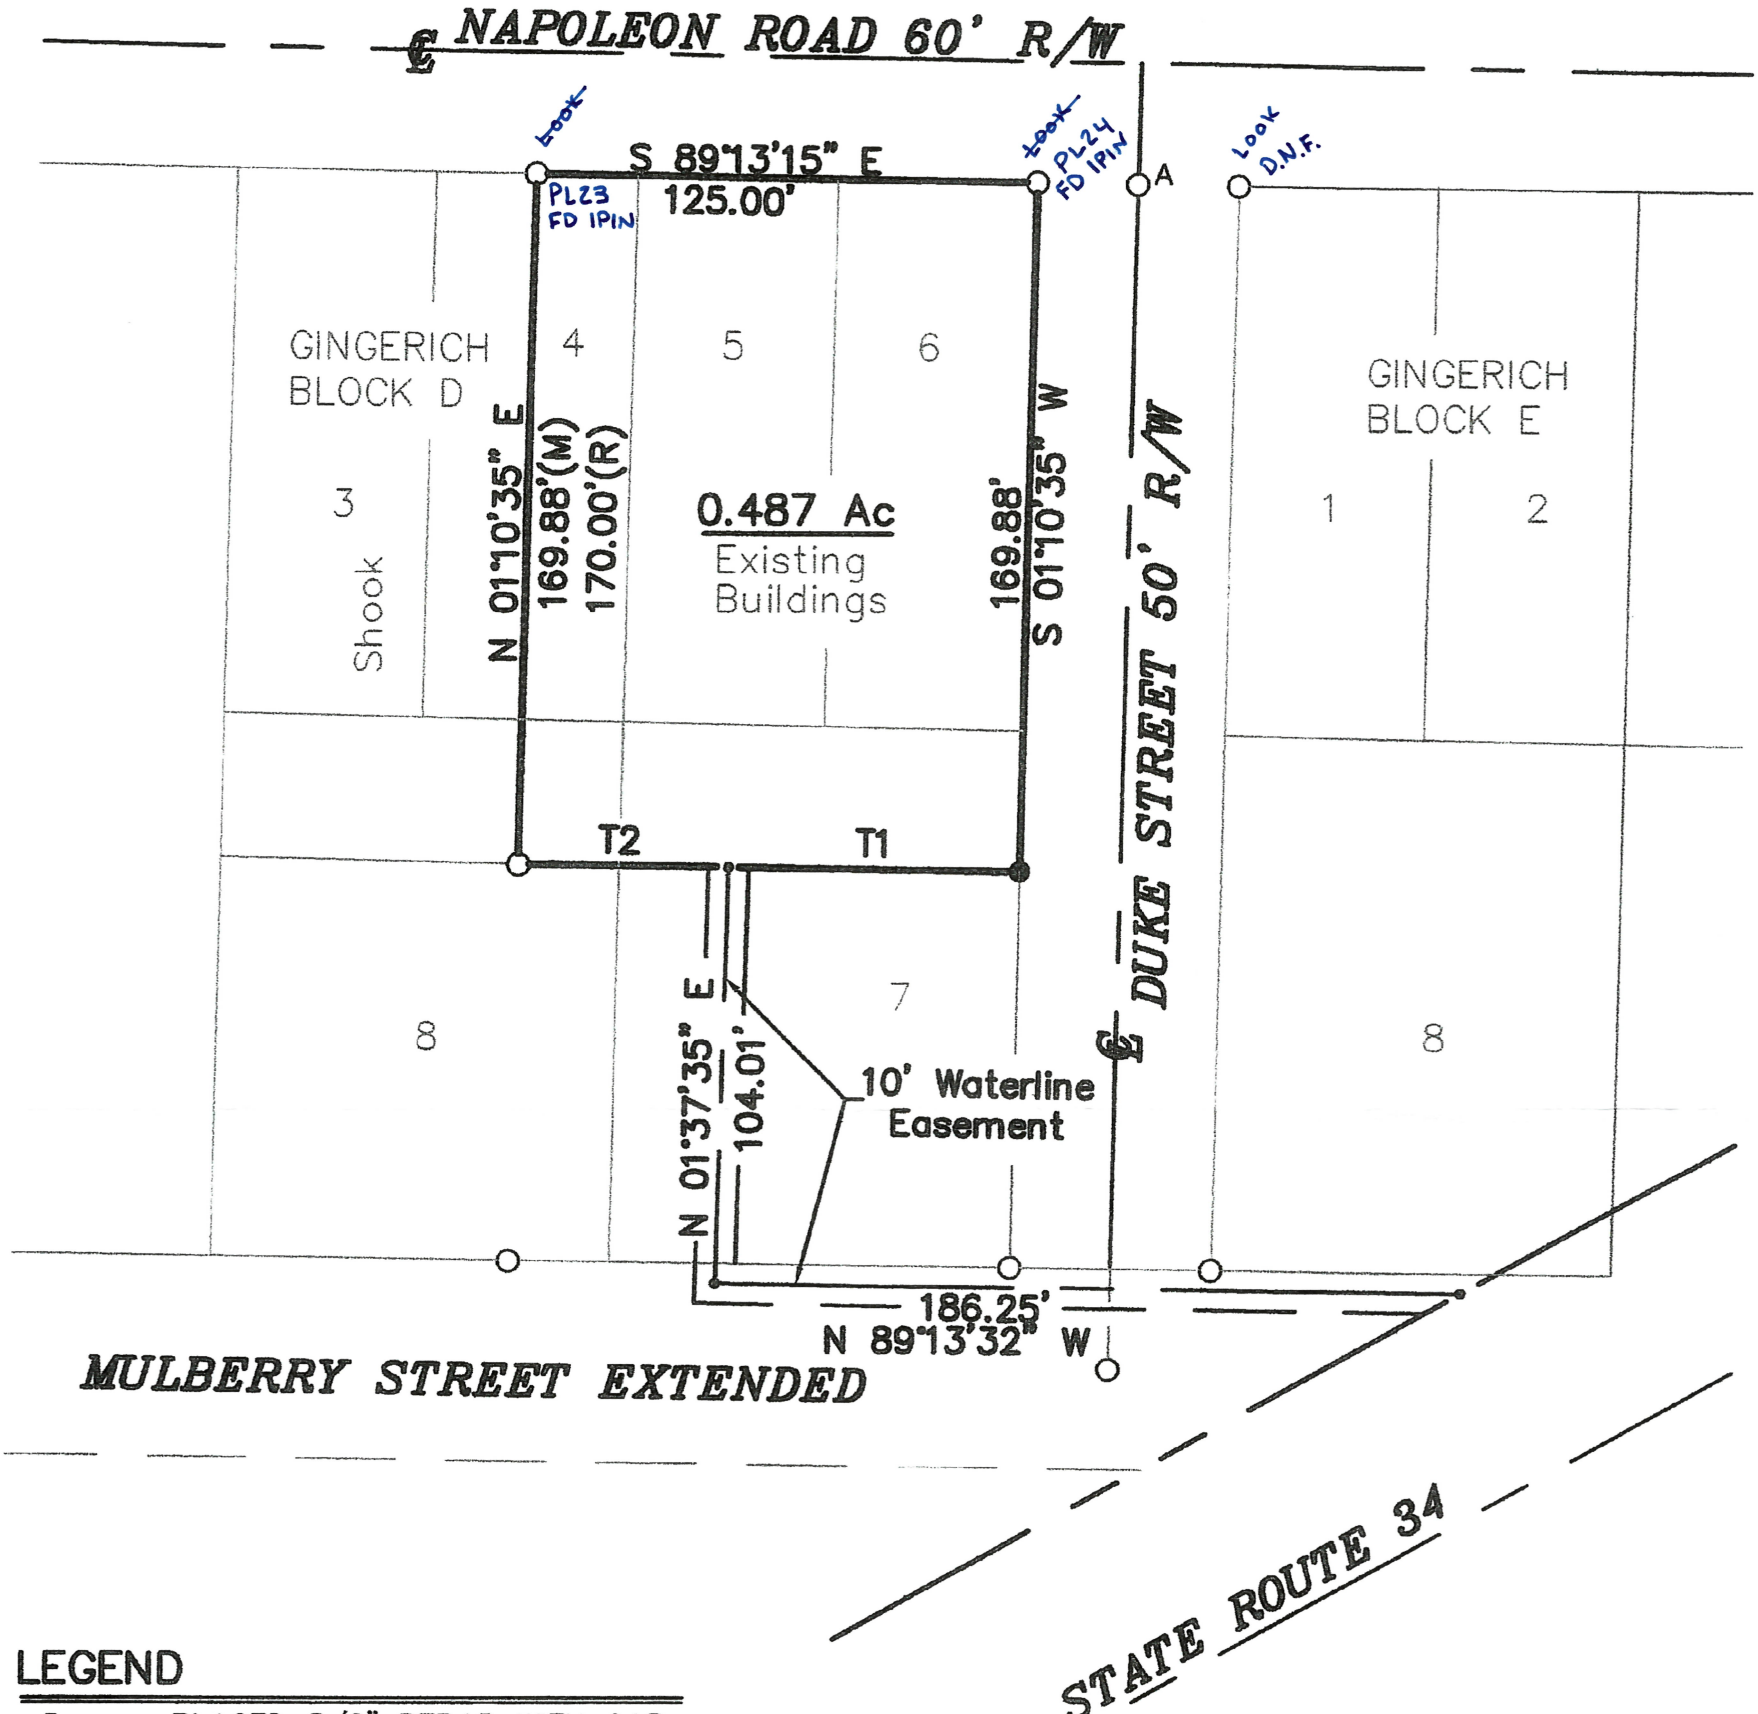

LEGEND

●	PLACED 5/8" REBAR WITH CAP
X	PLACED NAIL
⊠	FOUND MONUMENT BOX
—•—	POINT ESTABLISHED
X	FOUND P.K. NAIL & SHINER
O	FOUND IRON PIN OR PIPE
⊠	FOUND RR SPIKE
O^A	FOUND IRON PIN OR PIPE DAMAGED

STATE OF OHIO
TODD J. ROTH 8287
REGISTERED PROFESSIONAL SURVEYOR

TANGENT TABLE

T1	72.74'	N89°13'15"W
T2	52.26'	N89°13'15"W

REFERENCE SURVEYS

VOLUME 6R PAGE 249 ✓
~~VOLUME 6R PAGE 196~~
GINGERICH SUBDIVISION NO. 1
VOLUME 3 PAGE 138
VOLUME 18R PAGE 72 ✓
VOLUME 10R PAGE 251 ✓

I DO HEREBY CERTIFY THAT I HAVE SURVEYED SAID PARCEL OF LAND AND THAT SAID PLAT OF SURVEY IS CORRECT TO THE BEST OF MY KNOWLEDGE AND BELIEF. DIMENSIONS ARE SHOWN IN FEET AND DECIMAL PARTS THEREOF. THIS PLAT OF SURVEY IS RECORDED IN VOLUME 23R PAGE 121 OF THE WILLIAMS COUNTY RECORD ~~OF~~ SURVEYS.

Todd J. Roth

TODD J. ROTH – REGISTERED SURVEYOR 8287

JOB NO. 07–348
DATE: 04JUNE07
SCALE: 1" = 60'

HOEFFEL ENGINEERING & SURVEYING, LLC
128 South Lynn Street, Bryan, Ohio 43506 Office: 419–636–2060 Fax: 419–636–7488