
Plat of Survey

Being known as Lot No. 7 and a part of Lot No. 8 of Gingerich Subdivision No. 1, Block D; also a part of the North half (1/2) of the Southwest quarter (1/4) Section 16, Township 6 North, Range 3 East, Pulaski Township, Williams County, Ohio.

For... Mark C. Bever & Cindy D. Bever

Vol. 257 pg. 839

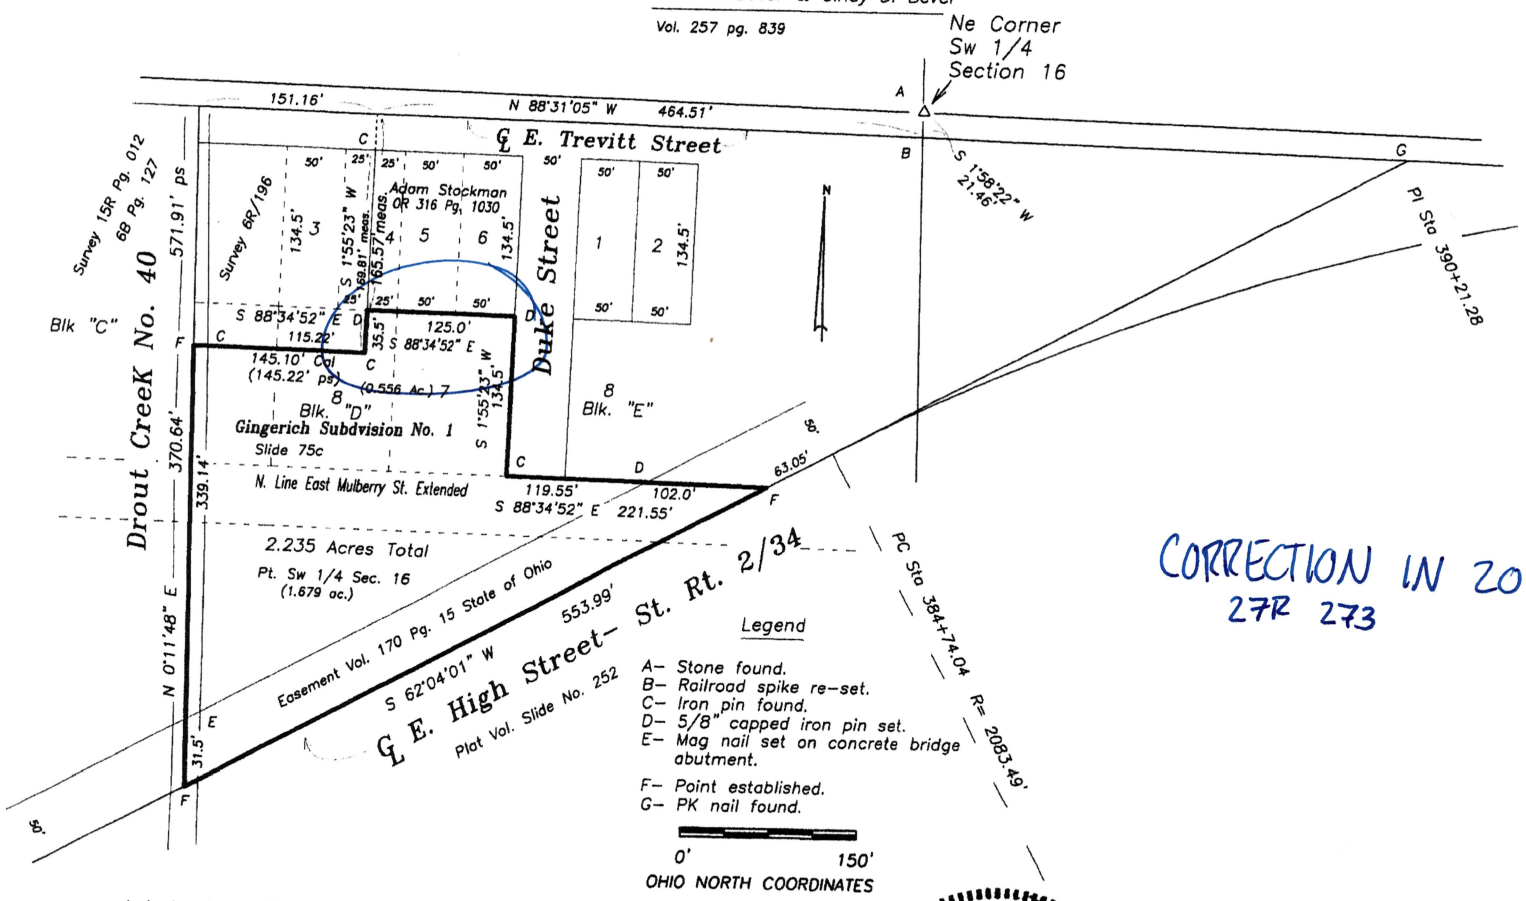

CORRECTION IN 2019
27R 273

Legend

A– Stone found.
B– Railroad spike re-set.
C– Iron pin found.
D– 5/8" capped iron pin set.
E– Mag nail set on concrete bridge abutment.
F– Point established.
G– PK nail found.

I do hereby certify that I surveyed the premises and prepared the above plat and that said plat is correct to the best of my knowledge and belief.

All dimensions are shown in feet and decimal parts thereof. This survey has been recorded in Volume 27R Page 153 of the Williams County Record of Surveys.

8-24-18

Thomas J Henry, Registered Surveyor No. 6787

STATE OF OHIO
THOMAS
HENRY
S-6787
REGISTERED
PROFESSIONAL SURVEYOR