
Plat of Survey

Being known as a Pt. of Lot No. 7 and a part of Lot No. 8 of Gingerich Subdivision No. 1, Block D; also a part of the North half (1/2) of the Southwest quarter (1/4) Section 16, Township 6 North, Range 3 East, Pulaski Township, Williams County, Ohio.

For... Mark C. Bever & Cindy D. Bever

OR 319 Pg. 1004
Vol. 257 Pg. 839

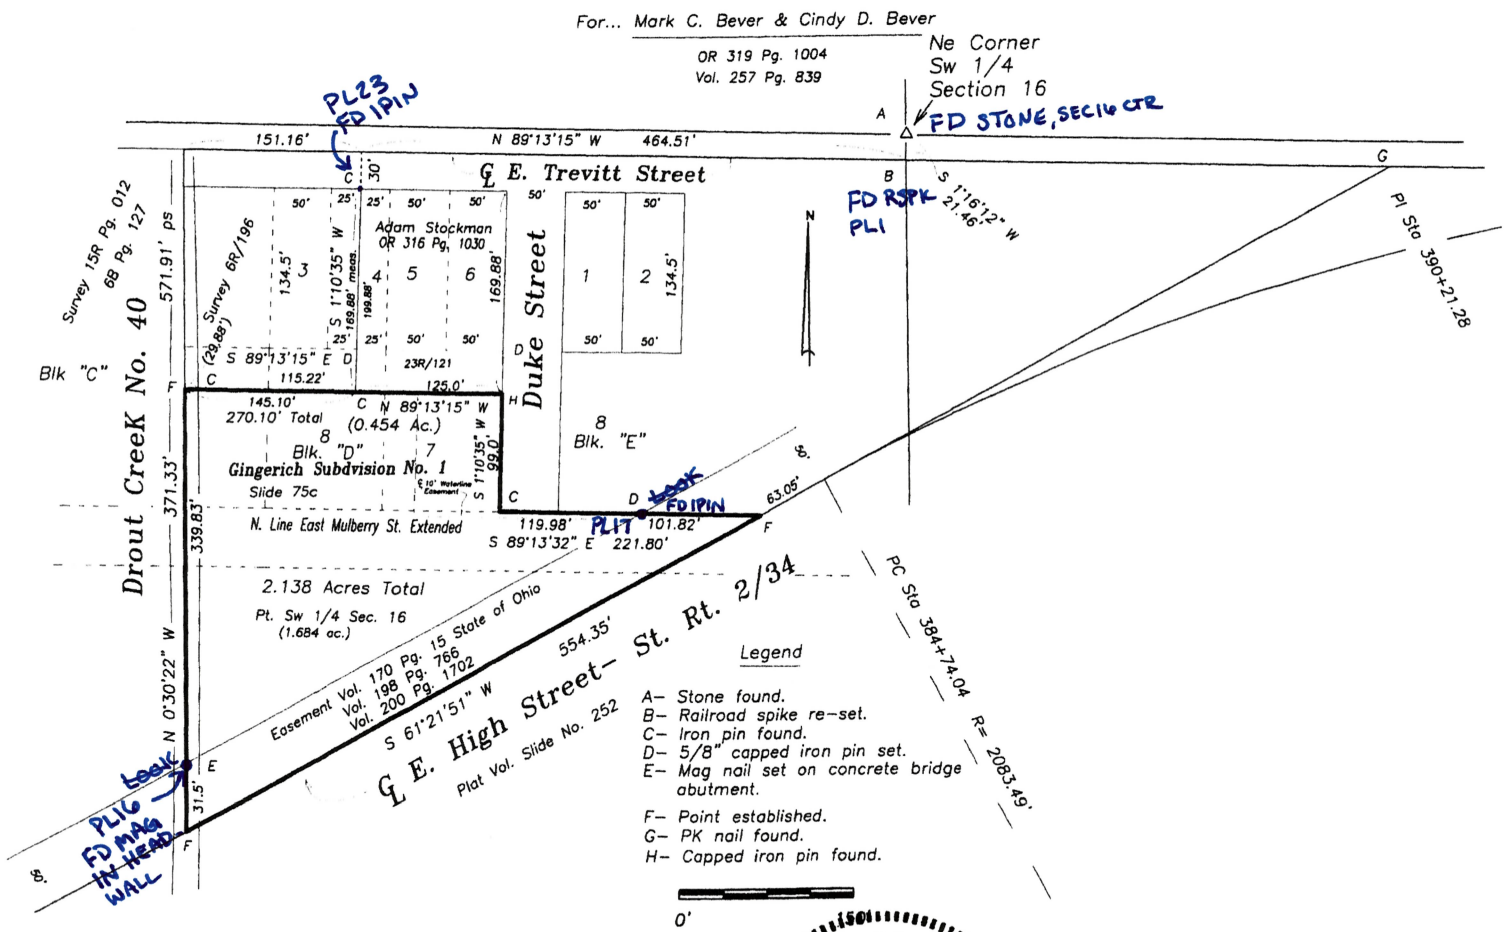

Legend

- A– Stone found.
- B– Railroad spike re-set.
- C– Iron pin found.
- D– 5/8" capped iron pin set.
- E– Mag nail set on concrete bridge abutment.
- F– Point established.
- G– PK nail found.
- H– Capped iron pin found.

I do hereby certify that I surveyed the premises and prepared the above plat and that said plat is correct to the best of my knowledge and belief.

All dimensions are shown in feet and decimal parts thereof. This survey has been recorded in Volume 27R Page 273 of the Williams County Record of Surveys.

8-23-19

Thomas J Henry, Registered Surveyor No. 6787

STATE OF OHIO
THOMAS
HENRY
S-6787
REGISTERED
PROFESSIONAL SURVEYOR