



## VICINITY MAP

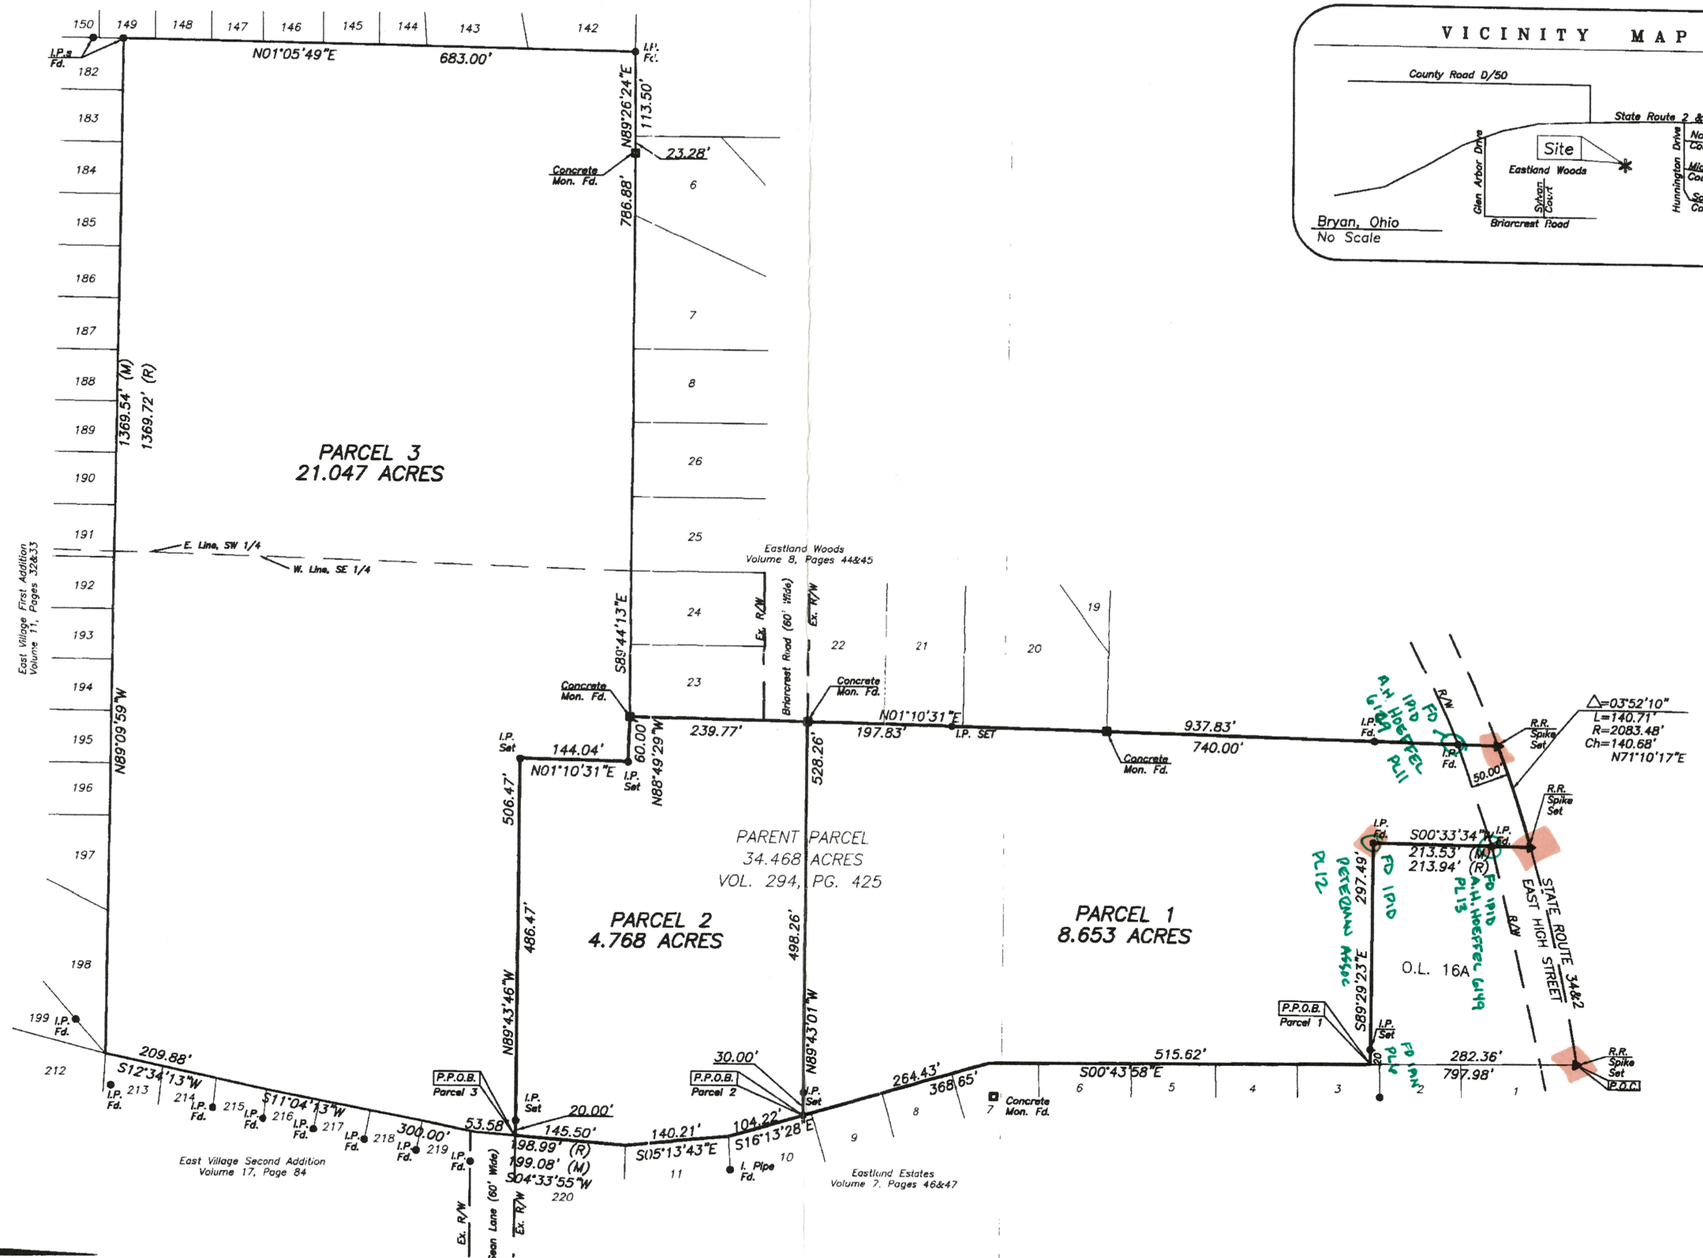


## LEGEND

℄ = Centerline
℄ = Property Line
POB = Point of Beginning
IP Set = Iron Pin Set
IP Fd. = Iron Pin Found
RR Fd. = Railroad Spike Found
PK Fd. = P.K. Nail Found

N

GRAPHIC SCALE

100 0 50 100 200
( IN FEET )
1 inch = 100 ft.

Thomas E. Silva, P.S.
Professional Surveyor #7805
Peterman Associates, Inc.

Vo 6B Pg 174

## PETERMAN ASSOCIATES, INC.

ENGINEERS – PLANNERS – SURVEYORS
3180 North Main Street (419) 422-6672 Findlay, O

Seal: STATE OF OHIO · THOMAS E. SILVA · 7805 · REGISTERED PROFESSIONAL SURVEYOR

| | |
|---|---|
| Scale | 1"=100' |
| Date | 9-14-99 |
| Drawn By | RKT |
| Approved By | TES |

Revisions

LOT SPLIT

Associated Land Group, Inc.

SITUATED IN THE CITY OF BRYAN, COUNTY OF WILLIAMS, STATE OF OHIO, AND BEING PART OF THE SE 1/4 & SW 1/4 of Section 15, T 6 N, R 3