
SURVEY & PLAT

For William Coleman and Darwin Wheeler

Known as Lots 5,6 and 7 and the East 1/2 of Lot 4 and East 1/4 of Lot 8 Block "D" and Lots 1,2,3 and 8 and West 1/2 of Lot 7 Block "E" Gingerich Sub.

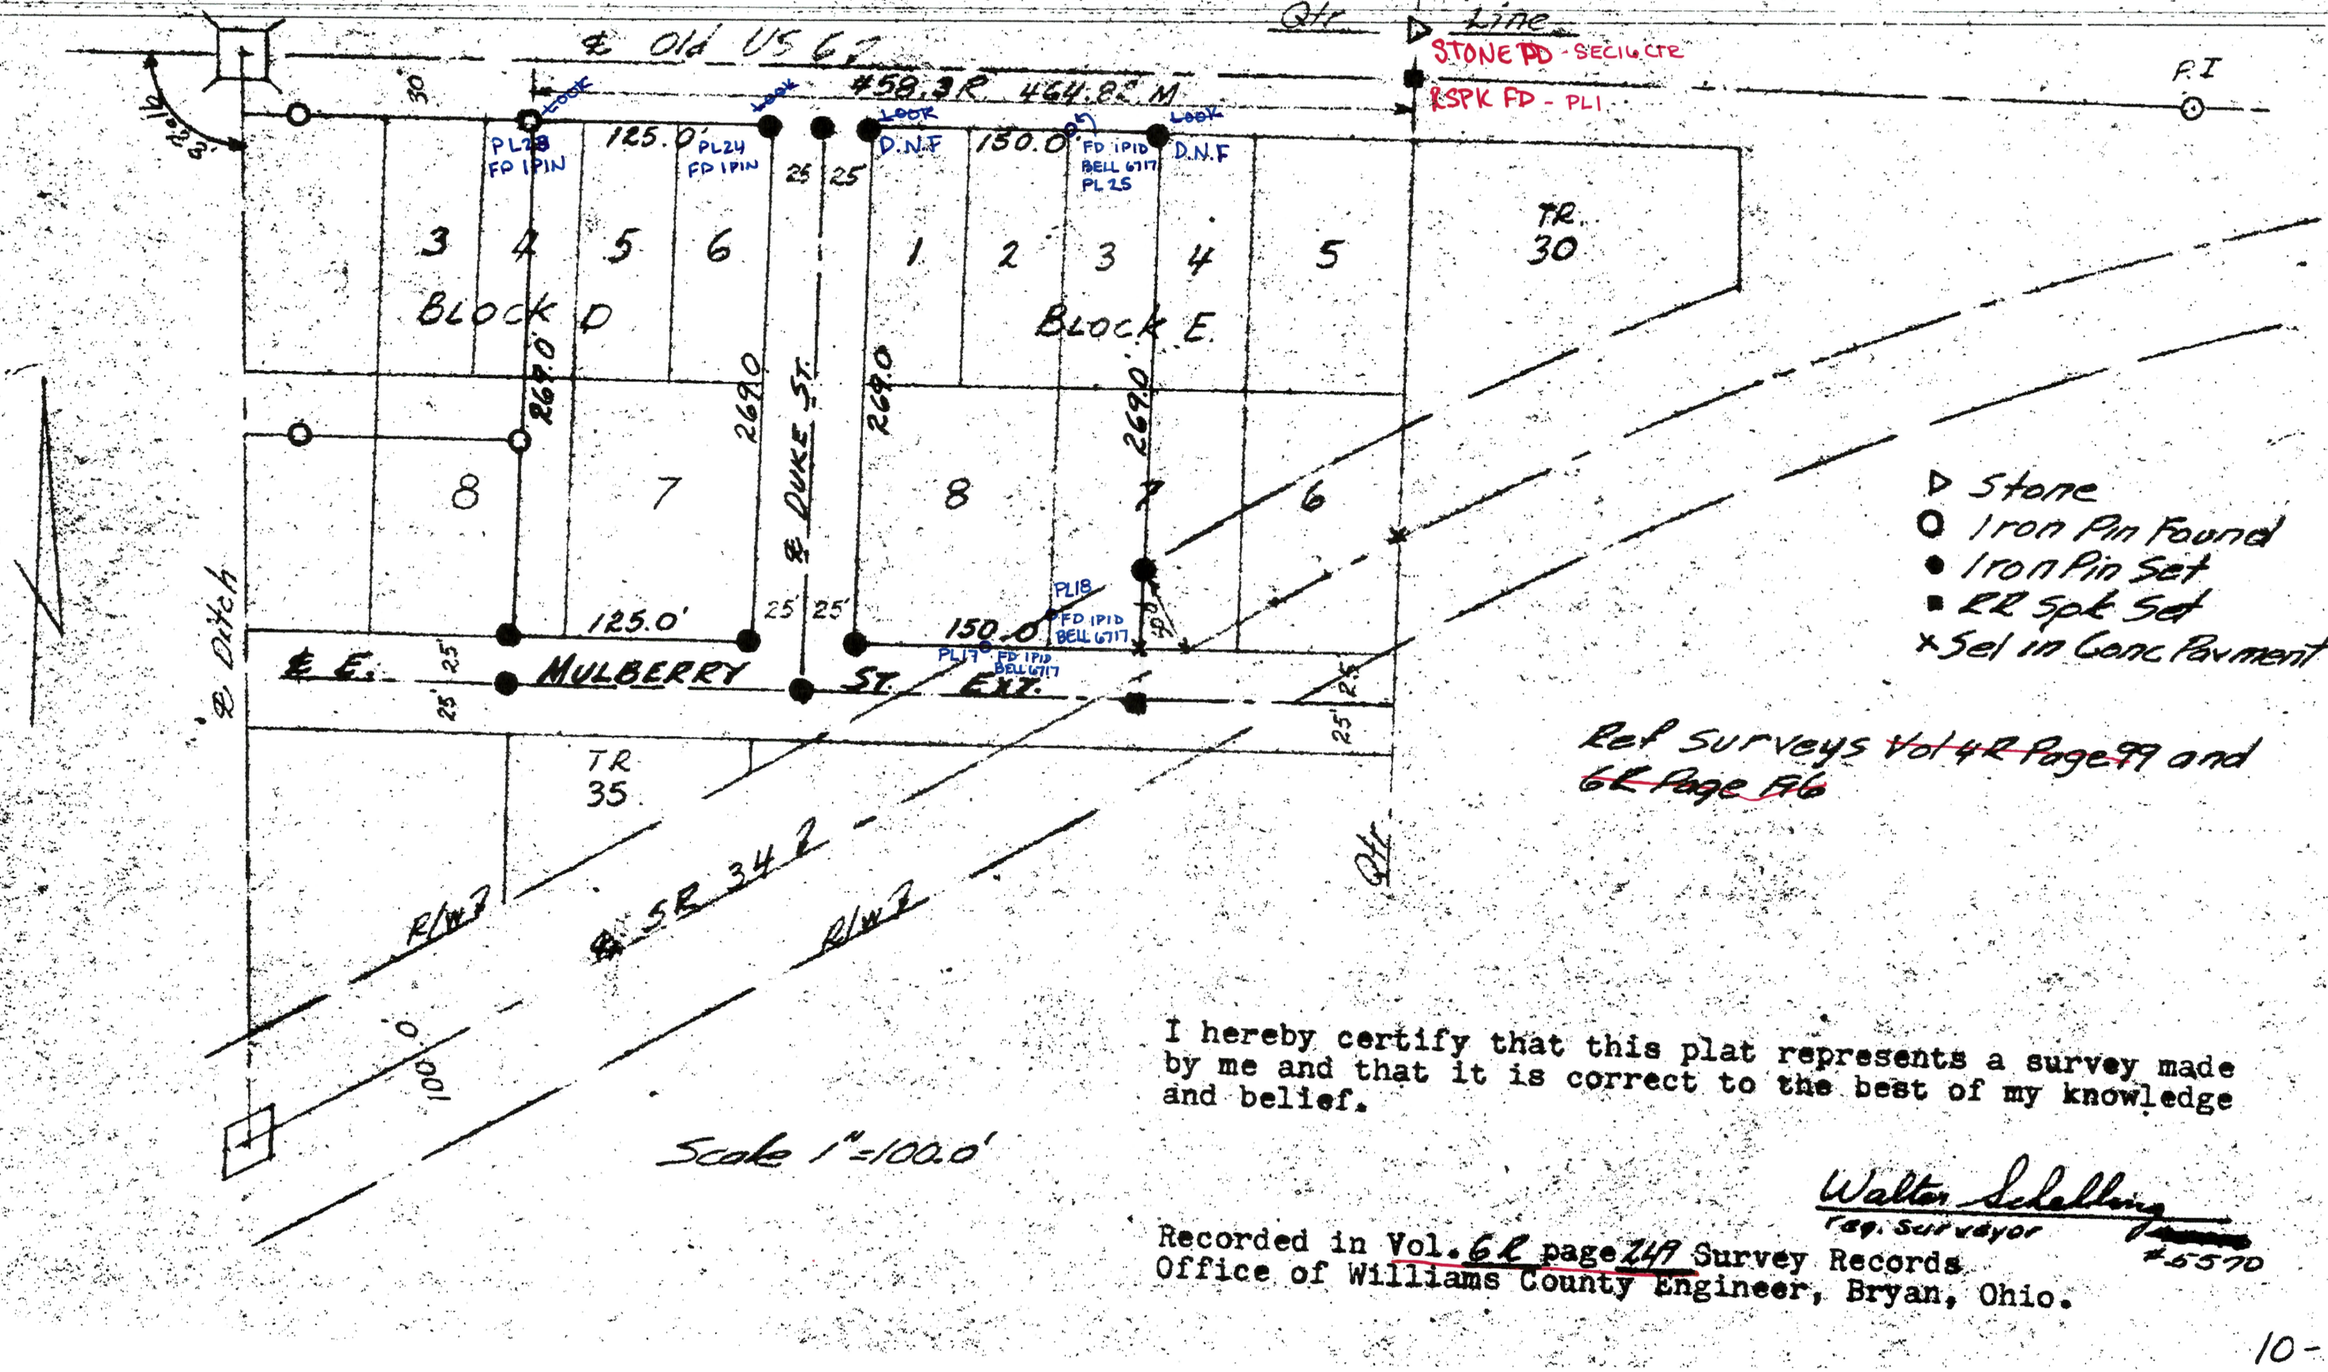

Scale 1"=100.0'

Ref Surveys ~~Vol 4R Page 99~~ and ~~6R Page 86~~

I hereby certify that this plat represents a survey made by me and that it is correct to the best of my knowledge and belief.

Walter Schelling
Reg. Surveyor #5570

Recorded in Vol. 6R page 249 Survey Records
Office of Williams County Engineer, Bryan, Ohio.

10-7