
# PLAT & Survey
For Marshall B McNutt
Located in the SE 1/4 Sec 16 T-6-N
R-3-E PULASKI TWP. Wms Co., Ohio

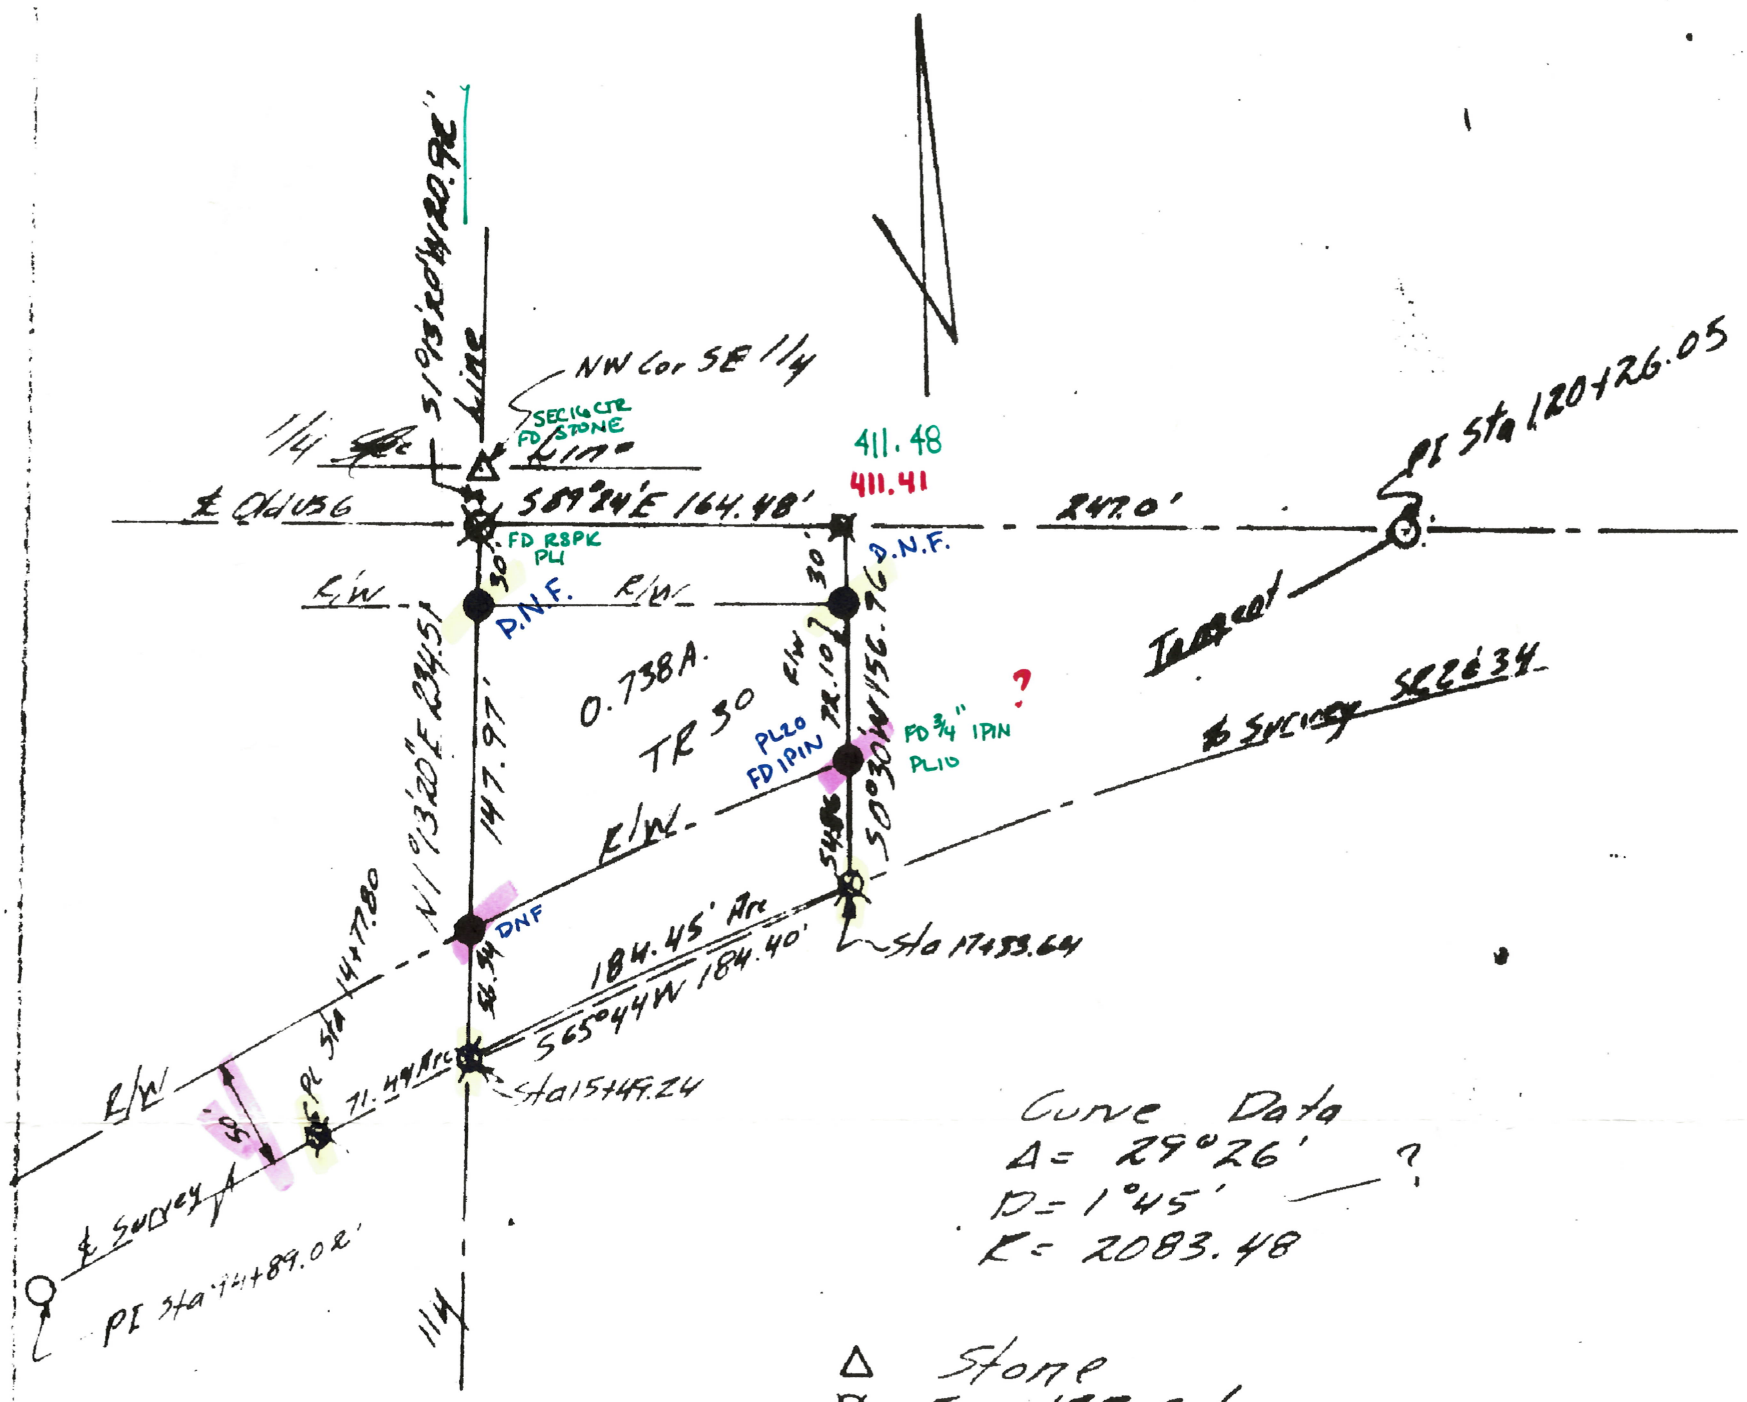


The improvements in the above described real estate are not in the 100 year flood plain as shown on the flood maps prepared by the Department of Housing and Urban Development; therefore flood insurance shall not be required by federally insured lending institutions.

I hereby certify that I have surveyed the premises and prepared the above plat and that said plat is correct to the best my knowledge and belief. All dimensions are shown in feet and decimal parts thereof. This survey has been recorded in Vol. BK page 146 of the Williams County Record of Surveys.

Lawrence K Eriksen
Reg. Surveyor #6391

131-78 Sep 6 Oct 23 1978 Scale 1" = 100.0'