
Section 18 Town 6 N. Range 4 E.

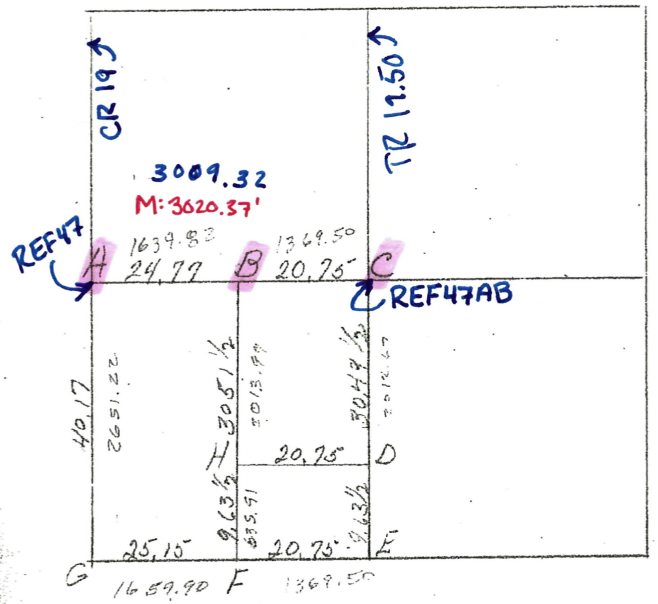

REF47 FD MAG NAIL

A - Found stone - 1918(?) Book II 208

Ref. - NW to nail E. side Br Post to N. on N & S Fence 38.3'

S60E " " W " N. Apple - 2nd row from west 79.5'

S30E " " W " N. Apple in west row 81.2'

B - stone - 1918 - Book II 208

Ref:- NE to witness stake 33.2'

NW " " " 28.6'

S to nail - W. side Br. Post to S. on N & S Fence 33.3'

1874 E.B. Opdycke Co. Surv.

Var E - AC 1°30', CE 2°31', GE 1°51', AG 1°44'

A - Qr. stone on town line

G - Sec cor stone placed from orig W Ash,

B - Stone in road.

C - Center qr. cor. stone,

H - Stake and stone.

F - " " "

W Oak 30 S 14 E 68

D - Stone

E - " orig W.

REF47AB FD

C - Found Iron Pin 1918(?) Book II 208

Ref. - N.E. to nail W. side Br Post to N. on E side N & S Fence 35.1'

NW " " E " " " " N " W " " " " 35.7'

S " " E " " " " S - 3' above ground 29.55'