



CUY-90-14.90

PID 77332/85531

APPENDIX UT-16

**Potential Utility Conflicts – CCG2
(Reference Document)**

State of Ohio
Department of Transportation
Jolene M. Molitoris, Director

**Innerbelt Bridge
Construction Contract Group 1 (CCG1)**

Revision Date: July 21, 2010




9 - Addendum No. 9 - Updated for Abbey Road Parking
Elimination and NS Access Road Addition

PUBLIC UTILITY CONFLICTS - CONTRACT GROUP 2


* CONFLICTS WITH BRIDGE PIERS WILL BE DETERMINED DURING BRIDGE DESIGN

CONFLICTS WITH U.G. ELECTRIC FOR ROADWAY LIGHTING IS NOT SHOWN


| CONFLICT I.D. | ALIGNMENT | ROADWAY | STATIONING | | AFFECTED UTILITY | | | | | PROPOSED CONSTRUCTION | | | | |
|---------------|-----------|----------------------------------|------------|---------|------------------|-------|----------------------------------|-------|----------|-------------------------------|-------------------|----------------------|-----------------------|------------------|
| | | | Begin | End | GAS | WATER | TELE | STEAM | ELECTRIC | COVER REDUCTION/ DEEP FILL | RETAINING WALL | PAVEMENT WIDENING | BRIDGE REPLACEMENT | BRIDGE PIERS* |
| 2-1 | NEVW14E90 | W. 14TH ST. TO I-90 EB (RAMP B2) | 1205+86 | | | 16" | | | | | | X | | |
| 2-2 | NEV90ONT | I-90 EB TO ONTARIO ST. (RAMP B3) | 1315+50 | 1316+30 | | | (15) SP 4" (6) SP 4" | | | | 14' CUT | | | |
| 2-3 | NEV90ONT | I-90 EB TO ONTARIO ST. (RAMP B3) | 1317+93 | | | | (24) MTD (4) STD T-DUCT FO | | | | 10' CUT | X X X | | |
| 2-4 | NEV90ONT | I-90 EB TO ONTARIO ST. (RAMP B3) | 1318+76 | | | | (12) SP 4" (6) SP 4" | | | | 9' CUT | X X | | |
| 2-5 | NEV90ONT | I-90 EB TO ONTARIO ST. (RAMP B3) | 1322+12 | 1322+62 | | | (24) MTD (4) STD T-DUCT FO | | | | 4' CUT | | | |

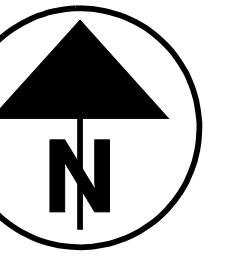


CONTRACT GROUP 2 POTENTIAL UTILITY CONFLICTS SHEET 1

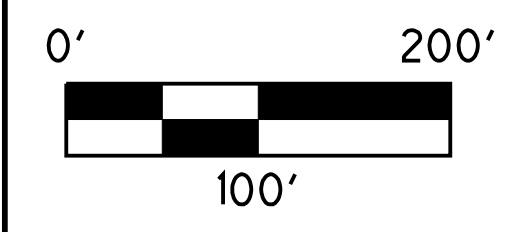


JULY 20, 2010
DRAFT

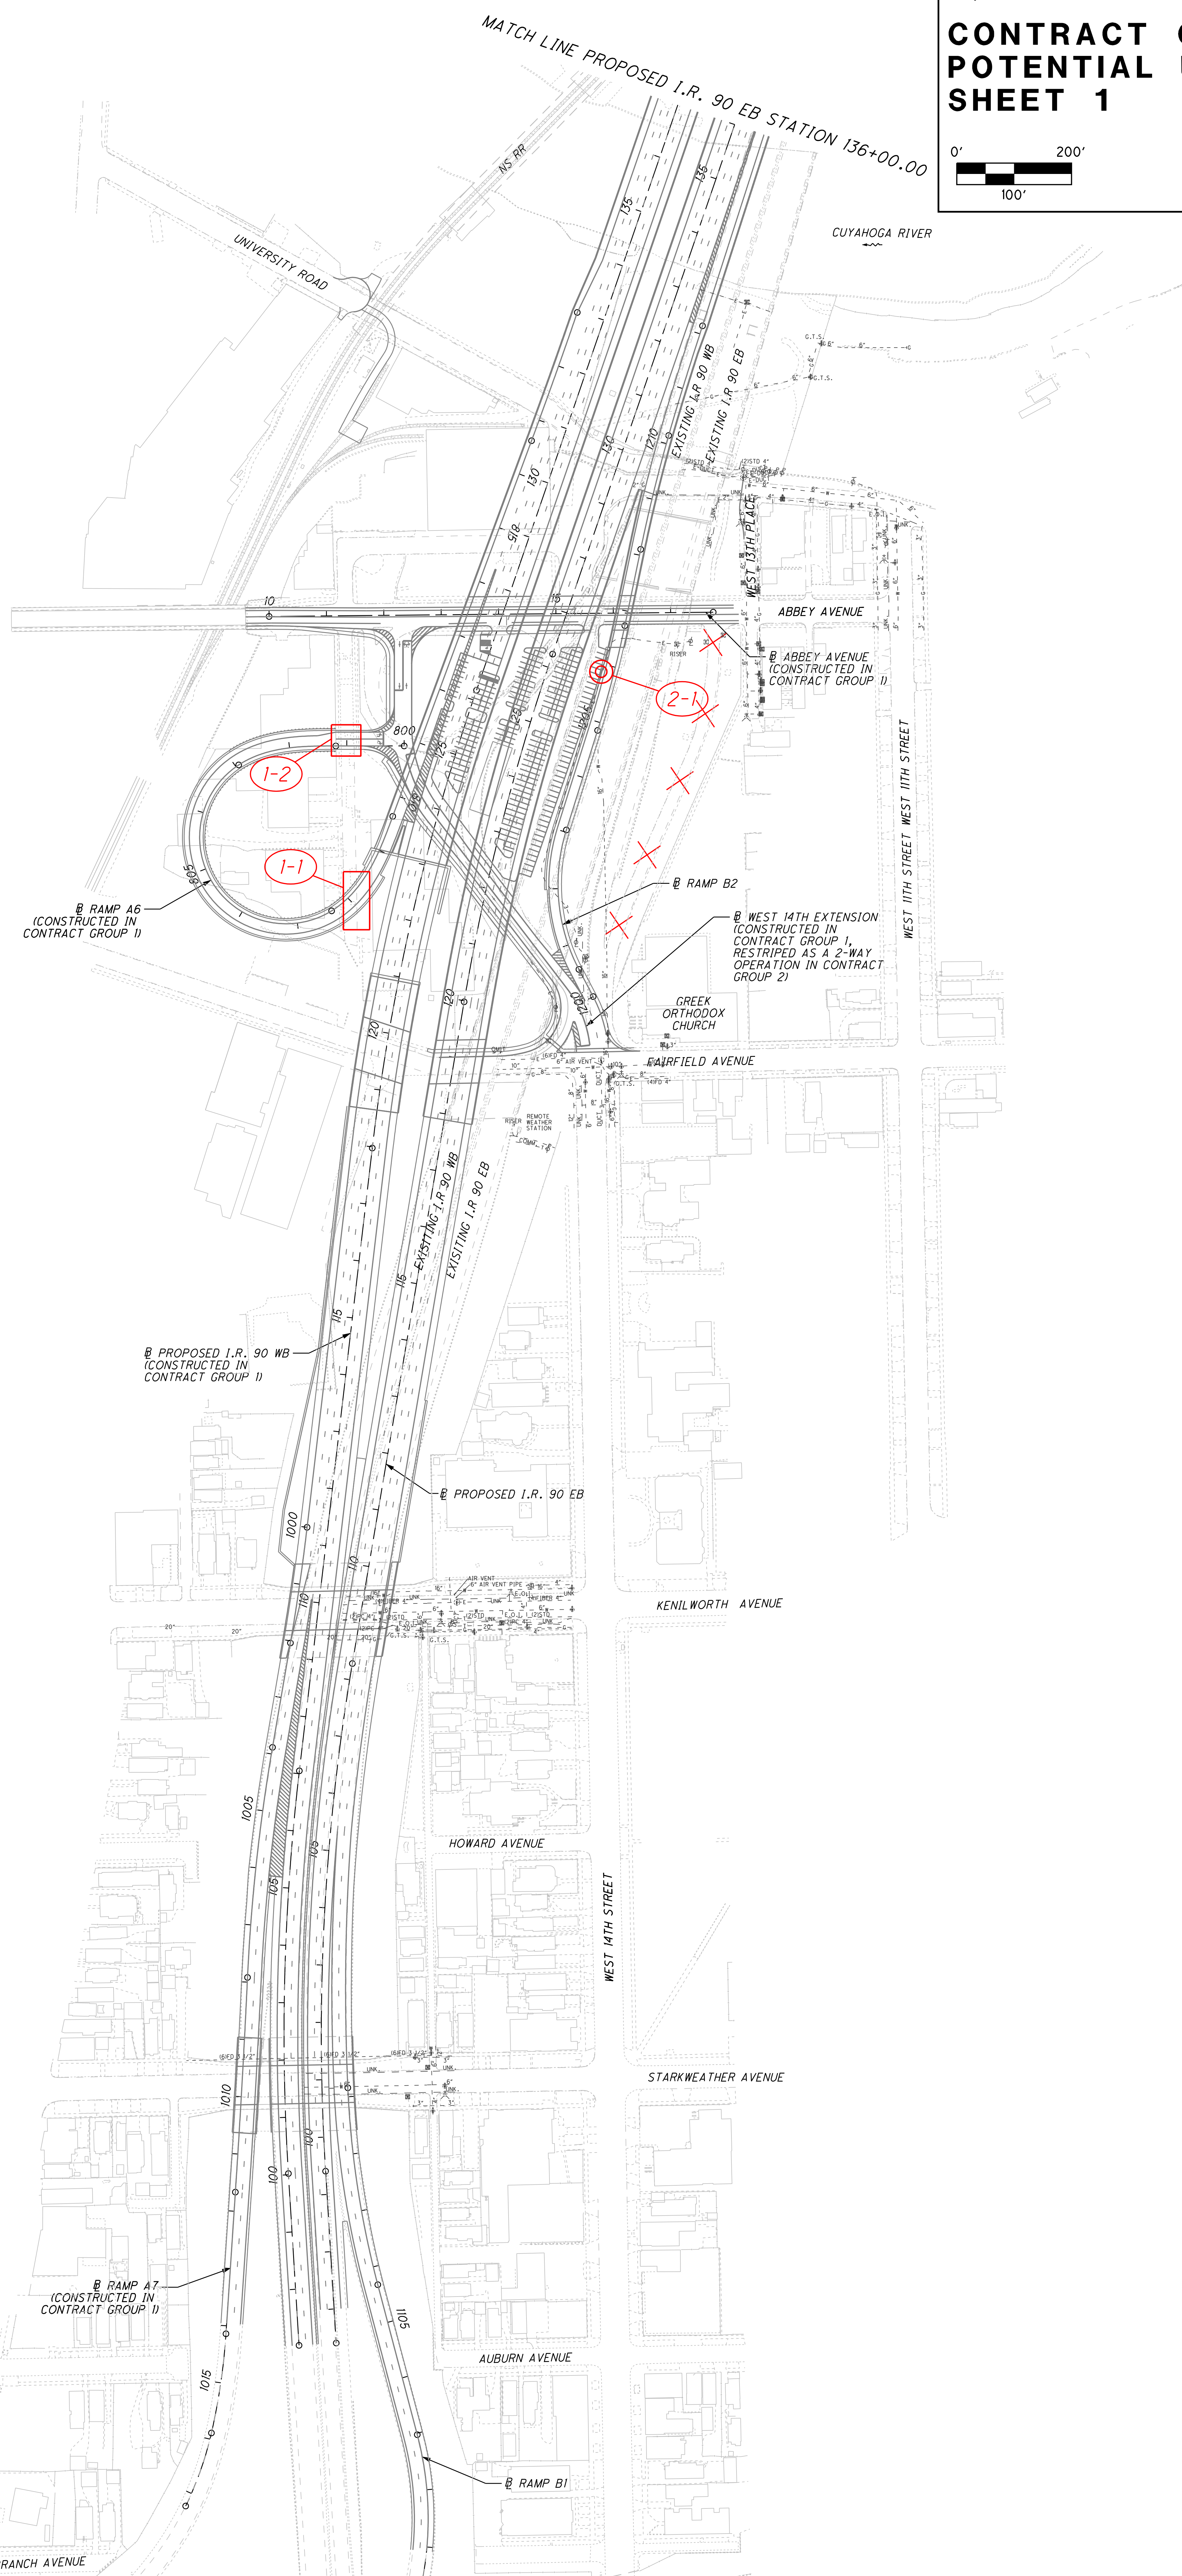

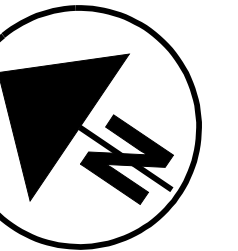

CONTRACT GROUP 2
POTENTIAL UTILITY CONFLICTS
SHEET 2

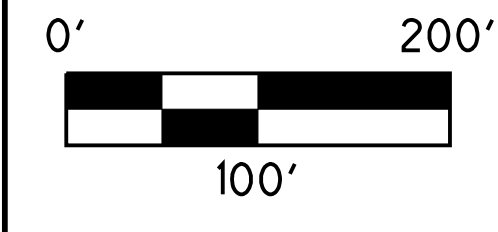

DECEMBER 23, 2009
DRAFT

MATCH LINE PROPOSED I.R. 90 EB STA 168+00.00

PROGRESSIVE FIELD

RAMP A4
 (CONSTRUCTED IN CONTRACT GROUP 1)
 ONTARIO STREET
 (CONSTRUCTED IN CONTRACT GROUP 1)

1-4

TEMPORARY I.R. 90 WB
 (CONSTRUCTED IN CONTRACT GROUP 1)

RAMP B3

1-3

CARNEGIE AVENUE
 (CONSTRUCTED IN CONTRACT GROUP 1)

COMMERCIAL ROAD
 (CONSTRUCTED IN CONTRACT GROUP 1)

EAST 9TH STREET
 (CONSTRUCTED IN CONTRACT GROUP 1)

CENTRAL VIADUCT WAY
 (CONSTRUCTED IN CONTRACT GROUP 1)

RAMP A5
 (CONSTRUCTED IN CONTRACT GROUP 1)

EXISTING I.R. 90 WB
 EXISTING I.R. 90 EB


WEST 3RD STREET

PROPOSED I.R. 90 WB
 (CONSTRUCTED IN CONTRACT GROUP 1)

PROPOSED I.R. 90 EB

CUYAHOGA RIVER

MATCH LINE PROPOSED I.R. 90 EB
 STA 136+00.00

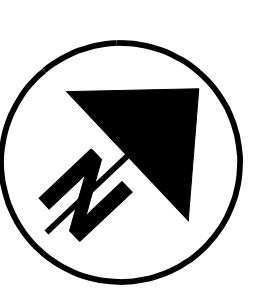

CONTRACT GROUP 2 POTENTIAL UTILITY CONFLICTS SHEET 3



JULY 20, 2010
DRAFT

