LD-6—(25M—2-59)

SHEET NO.

| PERSONNEL | TITLE | PERSONNEL | TITLE |
|---|---|---|---|
| Red Beach | | | |
| W. Knapp | | | |

COUNTY Fulton DATE July 1974

S. R. Gorham Twp R-1-E WEATHER

SEC. South ½, Fr. Sec. 19 TEMP.
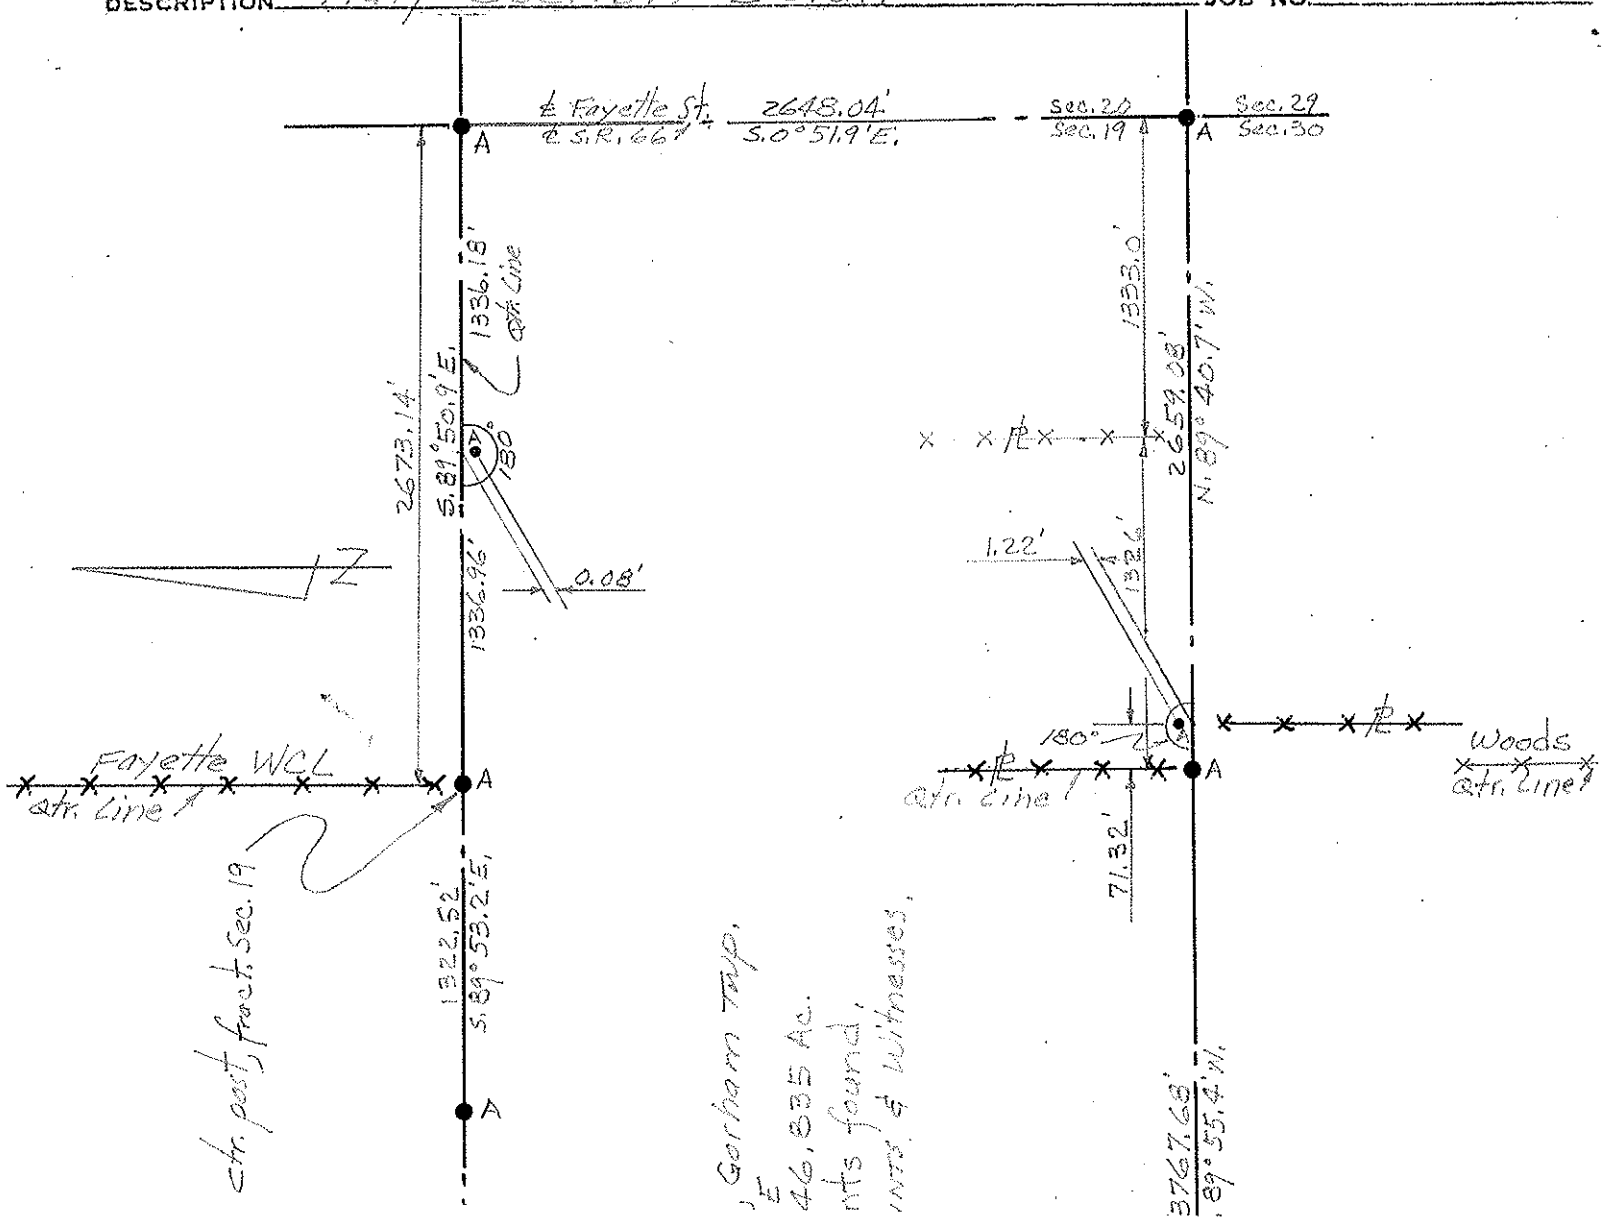
DESCRIPTION Half Section Detail JOB NO.