LD-5—(25M—8-60)

SHEET NO. 1

PERSONNEL	TITLE	PERSONNEL	TITLE
BIAS	NOTES	CHAFFOLES	
DEWITT			
BONDROS			
AMBROSE			

COUNTY LUCAS DATE 6/5/62

S. R. WEATHER CLEAR

SEC. TEMP. 75°
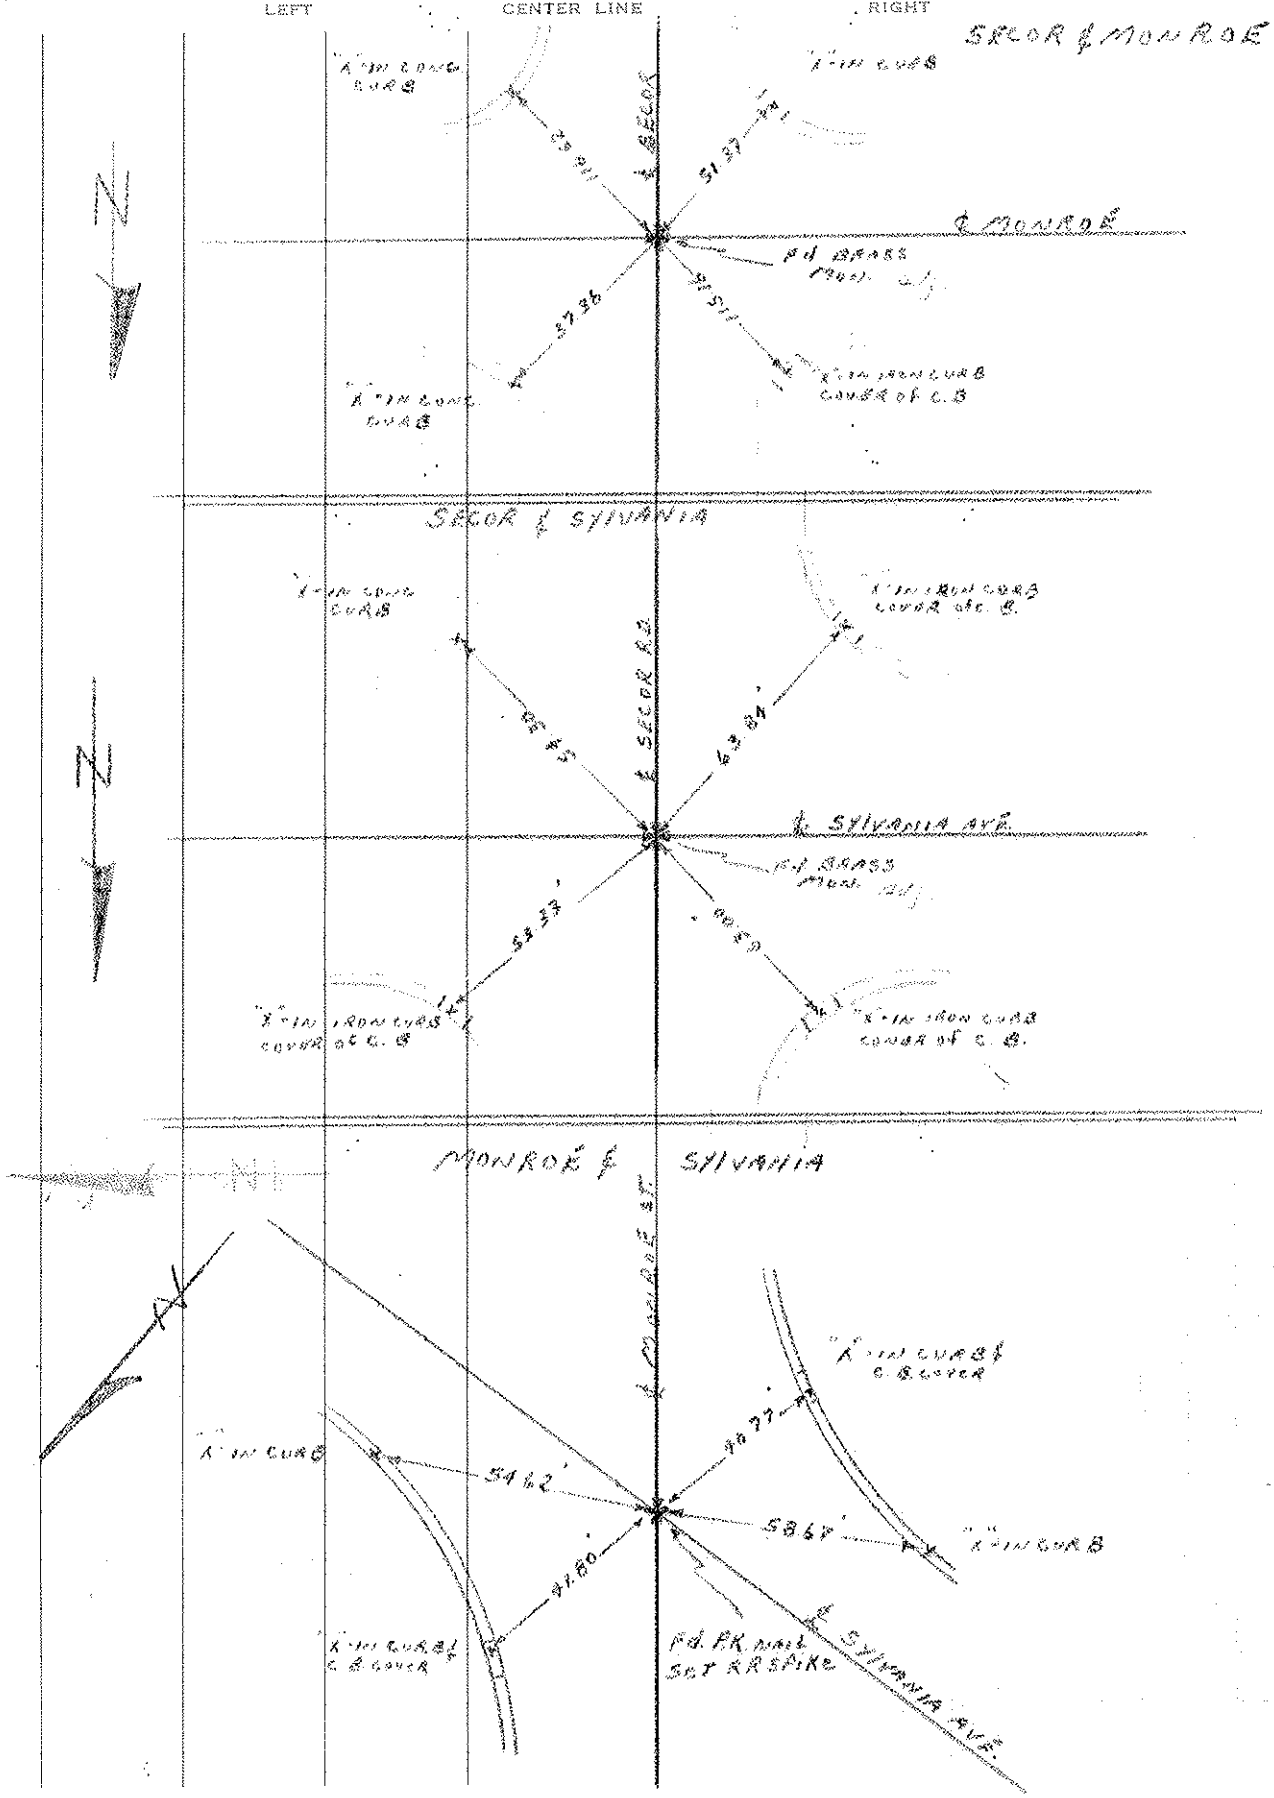
DESCRIPTION TIES TO MON. - MONROE & SECOR RD JOB NO.