O.D.O.T. DISTRICT 2 SURVEY OFFICE (USE ONLY)

PERSONNEL

NOTES ASTON
H.C. MILLER
R.C. NIESE

DWG BY

REFERENCE NO. 7

DATE 4/22/2024
WEATHER BREEZY
TEMP. 30°

PID NO PID

SHEET 16 OF 28

ROUTE SR 105
COUNTY WOOD
TOWNSHIP CENTER
SECTION 22
T 5 N R 11 E

TYPE MONUMENT MAG/ WASHER
ON SURFACE - BELOW ON
OFFSET ℄ PAVEMENT 0.5' LT : ~~RT~~
10.2' TO EDGE PAVEMENT
STATION: 120+91

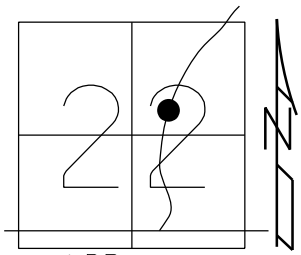

HORZ.DATUM: LDP:WOOD
GEOID: 18
GRID: NORTHING: 625820.226
EASTING: 1672869.668

LDP
N: 447932.2
E: 184002.0

RECORD: P.I.
STA. 128+20.28
Δ = 0° 38' LT
FD P.K./WASHER
4/15/02, MB
SET P.K./WASHER
6/12/02, DCH
FD P.K.SHANK
SET MAG/WASHER
REF7
6/2/16, JFO
SET 1" MAG/WASHER
6/20/17, JFO
FD 1" MAG/ W
REF8
4-22-24, TDN

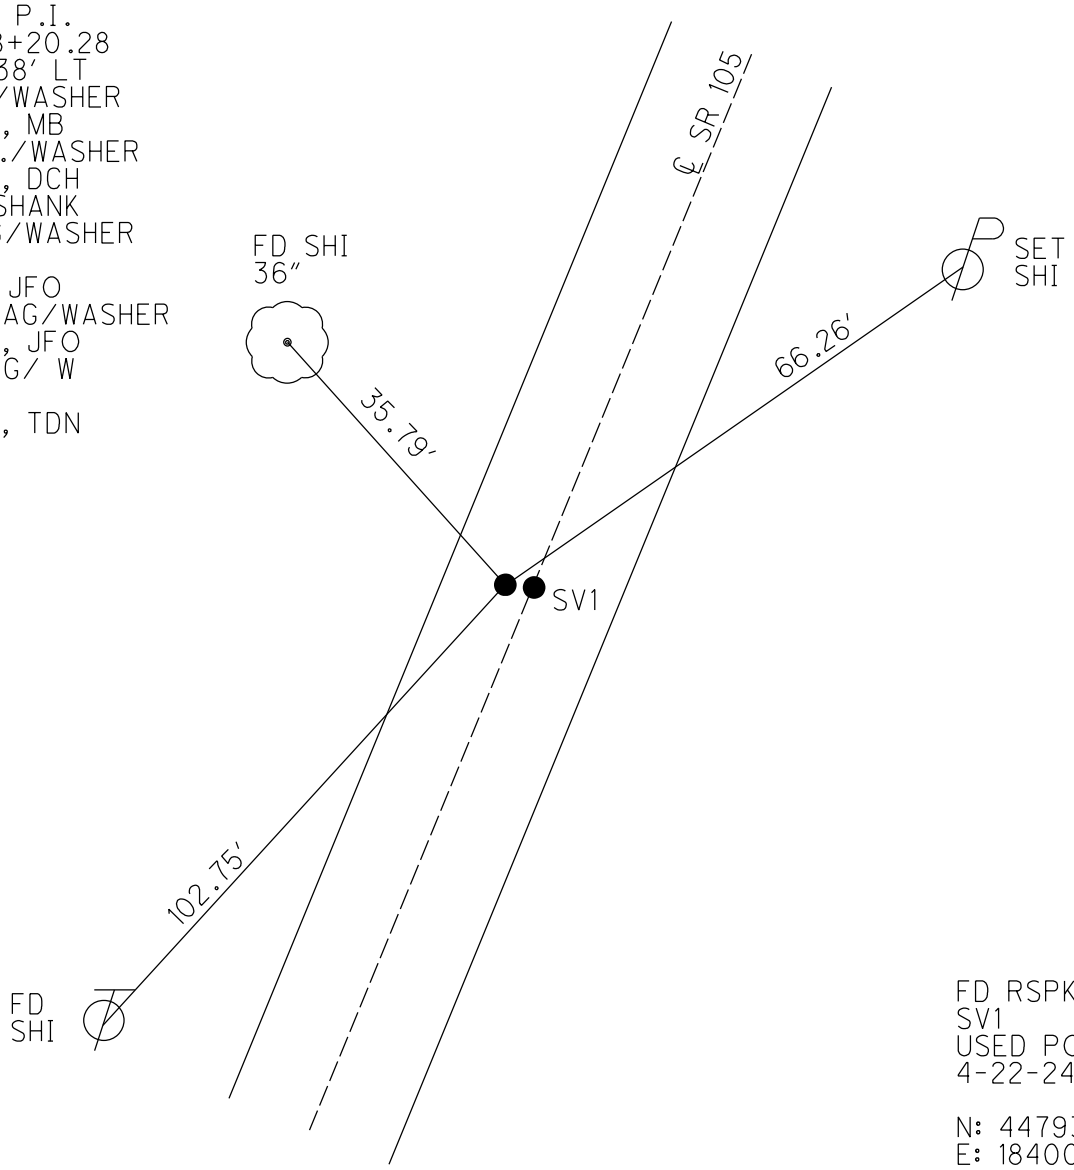

FD RSPK ON ℄
SV1
USED POINT FOR ℄
4-22-24, JAM

N: 447931.477
E: 184002.443

O.D.O.T. DISTRICT 2 SURVEY OFFICE (USE ONLY)

PERSONNEL

NOTES RHOADES
H.C. O'DONNELL
R.C. RHOADES

REFERENCE NO. 7
DATE 9/9/16
WEATHER SUNNY
TEMP. 82°

SHEET 15 OF 28
ROUTE SR 105
COUNTY WOOD
TOWNSHIP CENTER
SECTION 22
T 5 N R 11 E

TYPE MONUMENT P.K./WASHER
ON SURFACE - ~~BELOW~~ ON
LEFT - ℄ PAV'T - ~~RIGHT~~ 0.5'
10.2' TO E EDGE PAVEMENT
S.L.M. 127+75

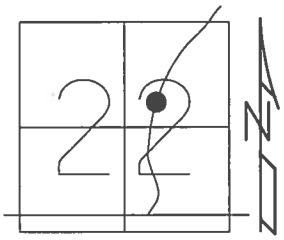

GRID: NORTHING: 625820.226 EASTING: 1672869.668

RECORD: P.I.
STA. 128+20.28
Δ = 0° 38' LT
FD P.K./WASHER
4/15/02, MB
SET P.K./WASHER
6/12/02, DCH
FD P.K.SHANK
SET MAG/WASHER
REF7
6/2/16, JFO
SET 1" MAG/WASHER
6/20/17, JFO

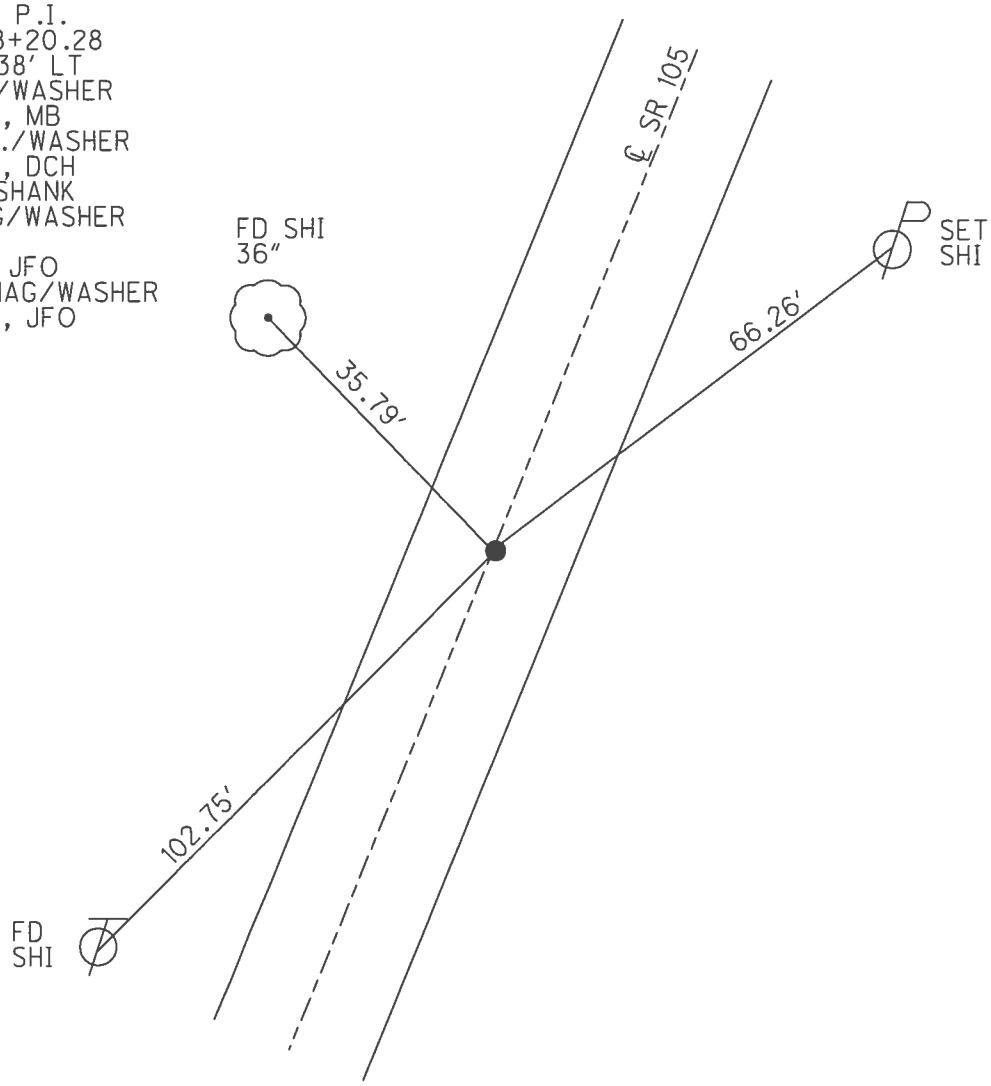

O.D.O.T. DISTRICT 2 SURVEY OFFICE (USE ONLY)

PERSONNEL

NOTES MOSER
H.C. CANTERBURY
R.C. BARNHISEL

REFERENCE NO. 7 SHEET 15 OF 21

DATE 4/15/02
WEATHER SUNNY
TEMP. 70°

ROUTE SR 105
COUNTY WOOD
TOWNSHIP CENTER
SECTION 22
T 5 N R 11 E

TYPE MONUMENT P.K./WASHER
ON SURFACE - ~~BELOW~~ ON
~~LEFT~~ - ℄ PAV'T - RIGHT 0.5'
10.2' TO E EDGE PAVEMENT
S.L.M. 127+75
GRID: NORTHING: EASTING:

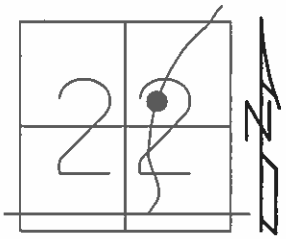

RECORD: P.I.
STA. 128+20.28
Δ = 0° 38' LT
SET P.K./WASHER
6/12/02, DCH

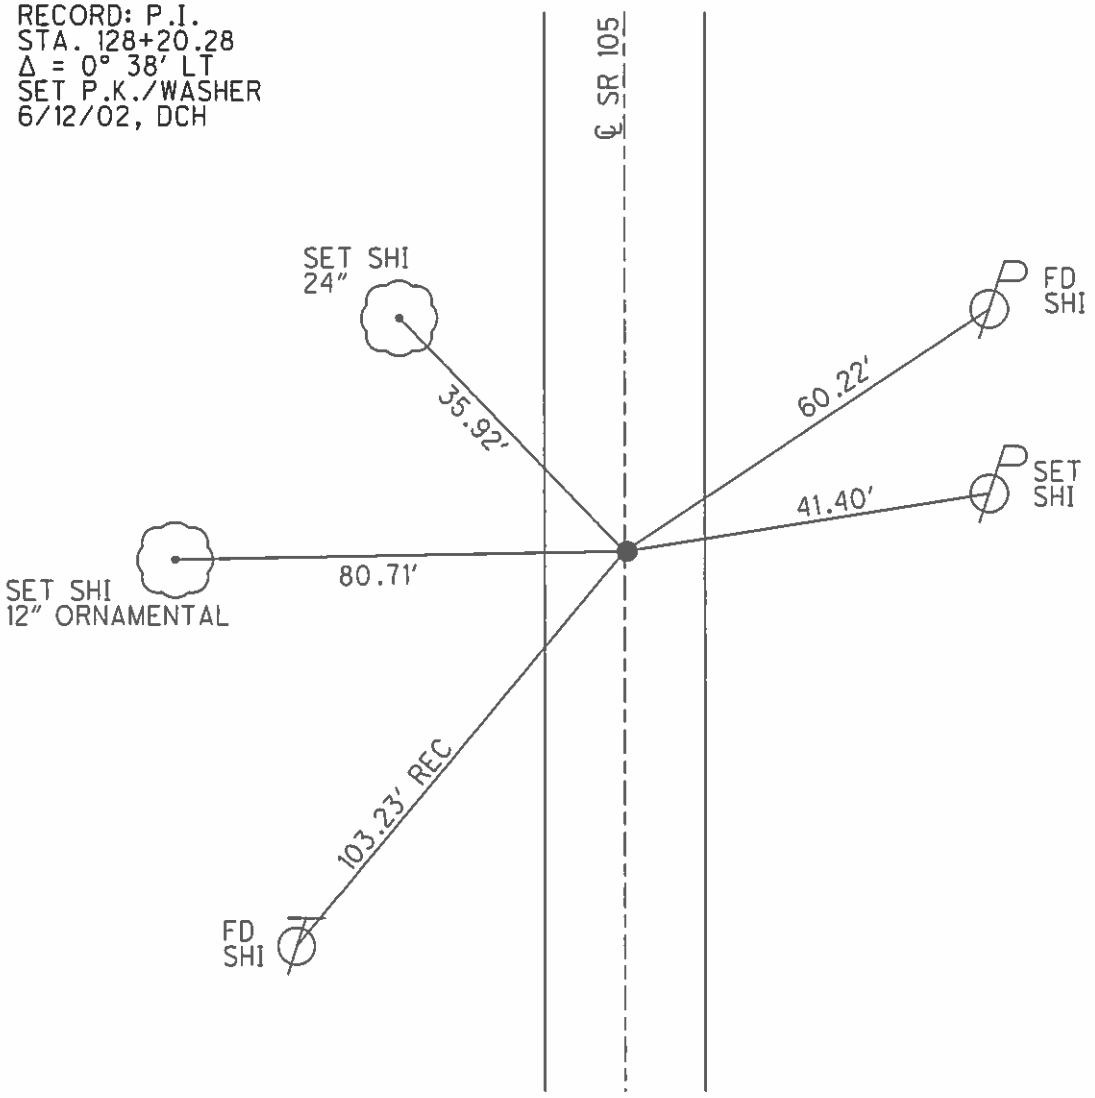

O.D.O.T. DISTRICT 2 SURVEY OFFICE

PERSONNEL

NOTES LONG
H.C. VAN DUSEN
R.C.

REFERENCE NO. 7

DATE 8-19-91
WEATHER Cloudy
TEMP. 65°

SHEET 12 OF 57

ROUTE 105
COUNTY WOOD
TOWNSHIP CENTER
SECTION 22
T 5 N R 11 E

TYPE MONUMENT PK & WASHER
ON SURFACE - ~~BELOW~~ YES
LEFT - ℄ PAV'T. - RIGHT 0.5
10.3' TO E EDGE PAVEMENT
S.L.M. 127+75

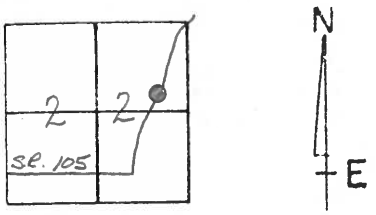

SET PK & WASHER
4-8-92
BVD

RECORD
P.I. # 6
STA. 128+20.28
Δ = 0°-38'-LT

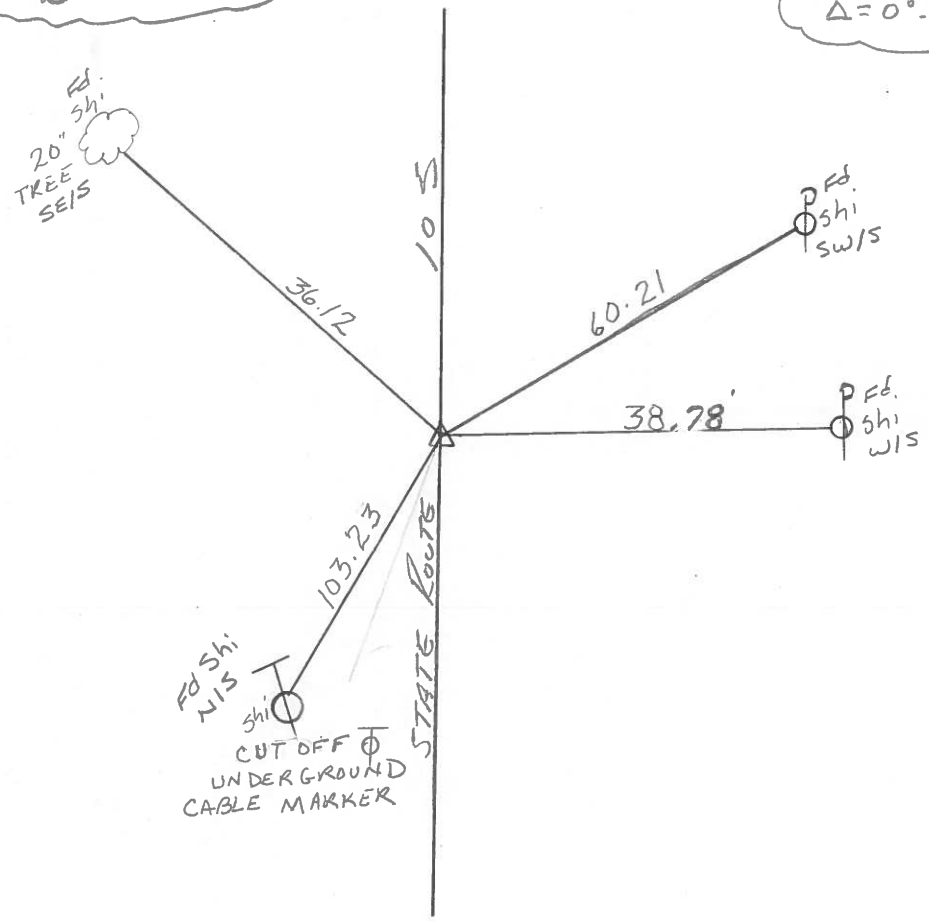

O.D.O.T. DISTRICT 2 SURVEY OFFICE

SHEET____ OF____

County WOOD S.R. 105

Township CENTER

Section 22

T_N, R_E

Personnel HOFFMAN
HOUSEHOLDER
LOEHRKE

#7

Date 4-19-82

Weather CLEAR

Temp. +65°

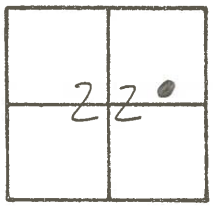

P.I. # 6
STA. 128+20.28
Δ = 0°-38'-LT.

SET P.K./WASHER
5-24-82 S.W.H.

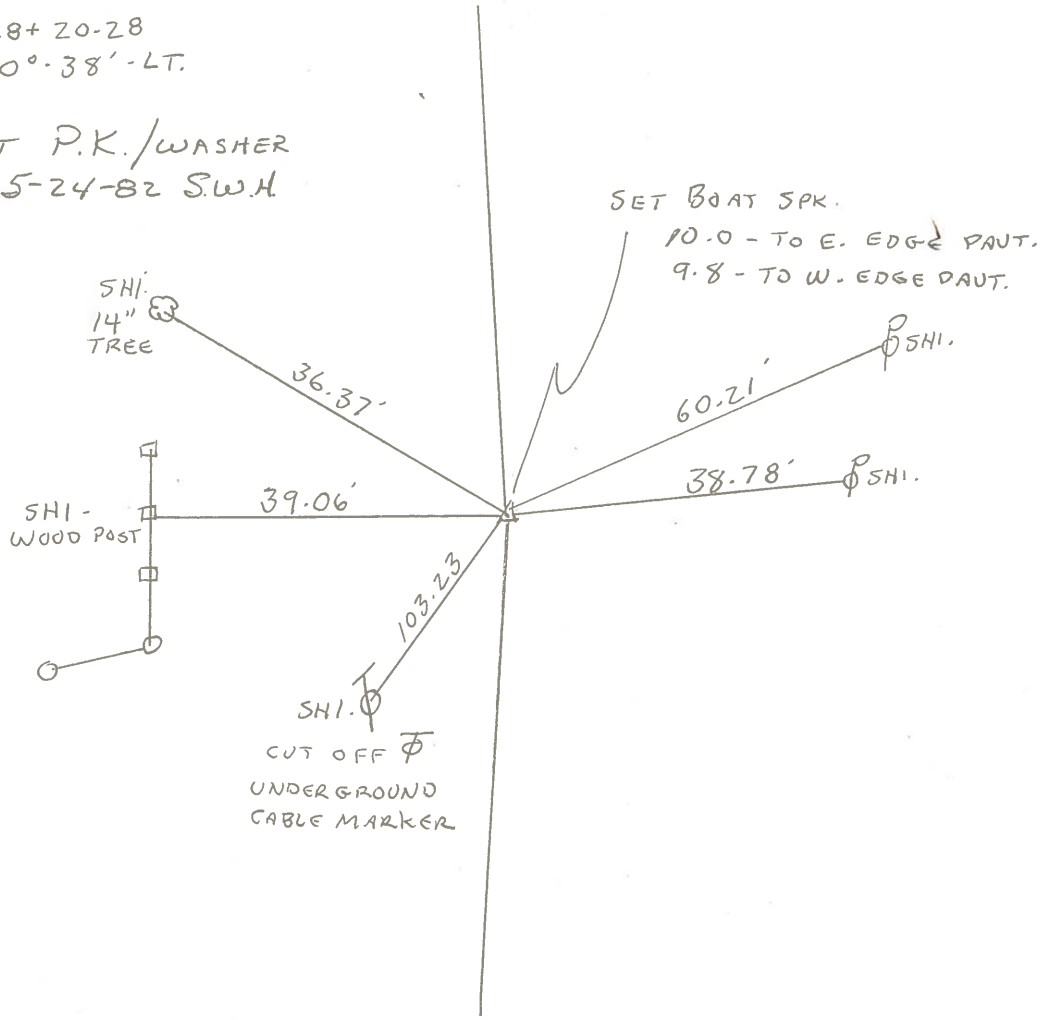

LD-5—(25M—2-59)

SHEET NO. 4-R

PERSONNEL	TITLE	PERSONNEL	TITLE
Stone	Notes		
Dennis	H.C.		
Curtis	R.C.		
Brannan	RY		

COUNTY Wood DATE 28 Aug. 72

S. R. #105 WEATHER Warm

SEC. 22 TEMP. 78°

DESCRIPTION References to Control Points JOB NO.

LEFT CENTER LINE RIGHT

COPIED

9.2' - to E. Edge Pvt.
10.1' - to W. Edge Pvt.

133+05.10
P.I. #7

Shiner

133.78'

Set Boat Spk.
Sta. 133+05.10
Δ = 0°50' Rt.

73.80'

64.47'

Shiner

Shiner in Wood Fence Post

℄ SR 105 #7

8

COPIED

Shiner in 24" Tree

Shiner in 14" Tree

36.66'

70.94'

38.72'

Shiner

128+20.28
P.I. #6

Set Boat Spk.
Sta. 128+20.28
Δ = 0°38' Lt.

9.6' - to E. Edge Pvt.
10.0' - to W. Edge Pvt.

℄ SR #105 #7

7