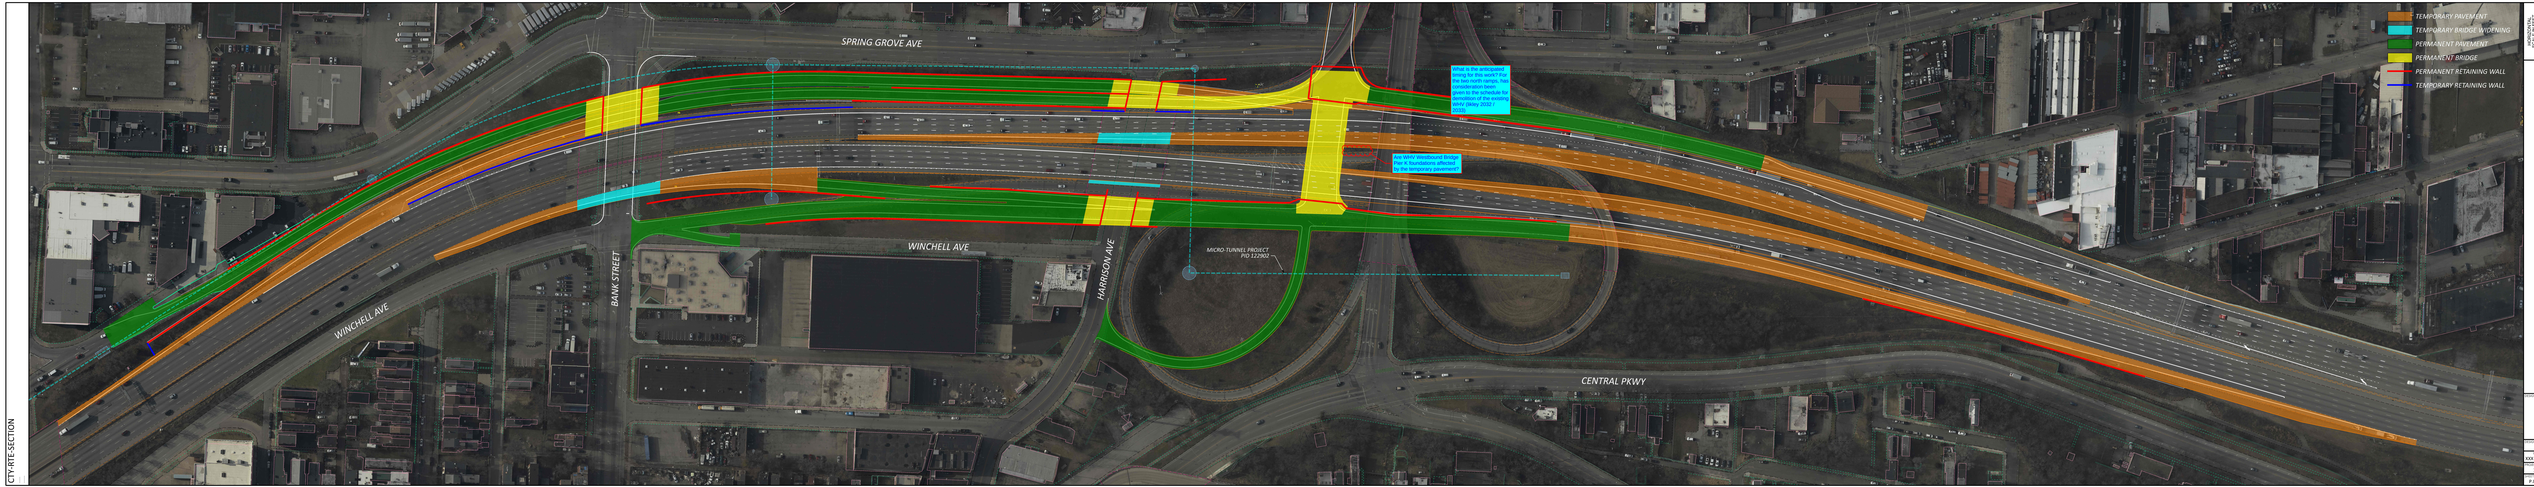
SPRING GROVE AVE
WINCHELL AVE
BANK STREET
HARRISON AVE
CENTRAL PKWY
MICRO-TUNNEL PROJECT
PID 122902
TEMPORARY PAVEMENT
TEMPORARY BRIDGE WIDENING
PERMANENT PAVEMENT
PERMANENT BRIDGE
PERMANENT RETAINING WALL
TEMPORARY RETAINING WALL
SCALE IN FEET
0
100
200
300
400
HAM-75-1.95 INTERCHANGE PROJECT
EX-4.1
XXX
XXX MM-CO-11
134161
P.O.
0
CTY-RTE-SECTION