



PROJECT NO. P410070010
 DATE 10/10/03
 CREW BRC

BRIDGE NO. HAM-50-3.76
 SHEET

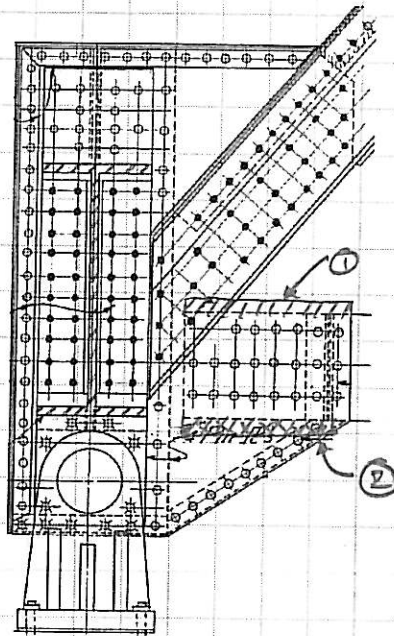


Span: 1 2 3 4
 North Truss South Truss

- ① 1/16" PITTING 1" HIGH FL L.C. INT. N.GUS
- ② 1/8" PITTING 1" HIGH FL L.C. INT. N.GUS
- 1/16" GUSP

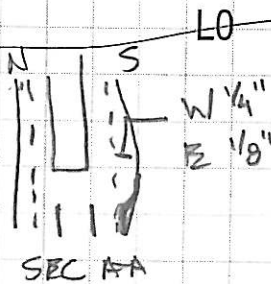

- ① 1" LONG TACK WELDS BTWN GUS PL / L.C. (1 EACH GUS)
- ② 1" T. WELDS FIL/VERT

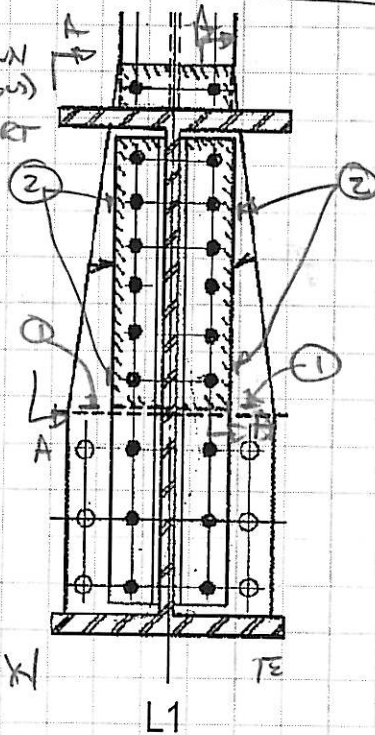

1/2" GUS PL CALPERS

REVISION 1	DATE	CREW	REVISION 2	DATE	CREW
REVISION 3	DATE	CREW	REVISION 4	DATE	CREW

PROJECT NO. P410070010

BRIDGE NO. HAM-50-3.76

DATE 10/10/08

SHEET

CREW BAC



- ① 18Lx1"T x 1/16" PITT INT S.GUS
- ② 12"Lx1"T x 1/16" PITT. N.GUS
- ③ 12"Lx2"T x 1/8" PITT N.GUS
- ④ 2x1"T x 1/4" PITT S.GUS

⑤ T. WELDS FIL/VKAT

Span: ① 2 3 4

North Truss


South Truss

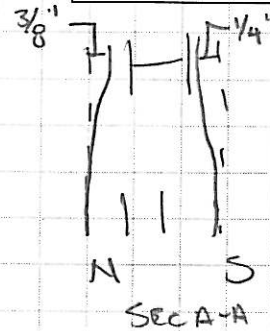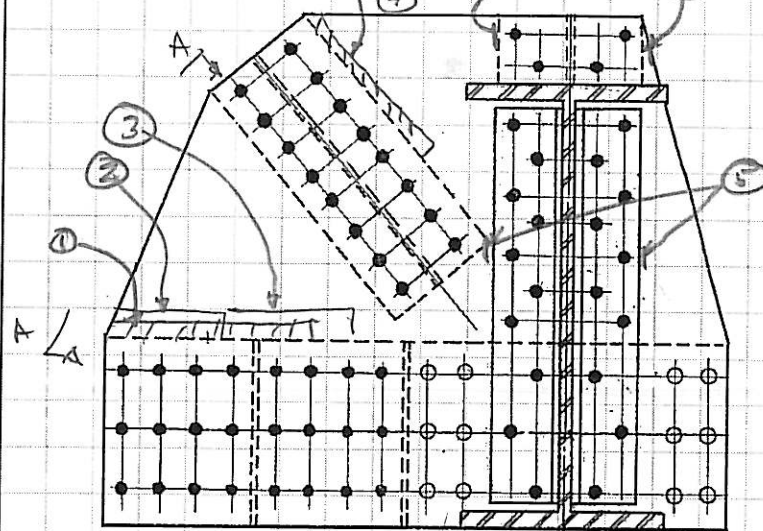


GUS PL 1/2" CALIPERS

L2

① 1/16" PITTING 1"T, FIL. N.GUS

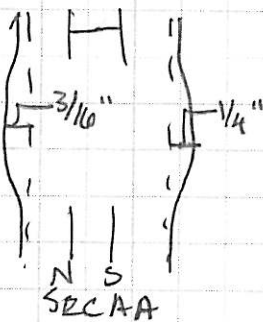

1/2" GUS PL CALIPERS

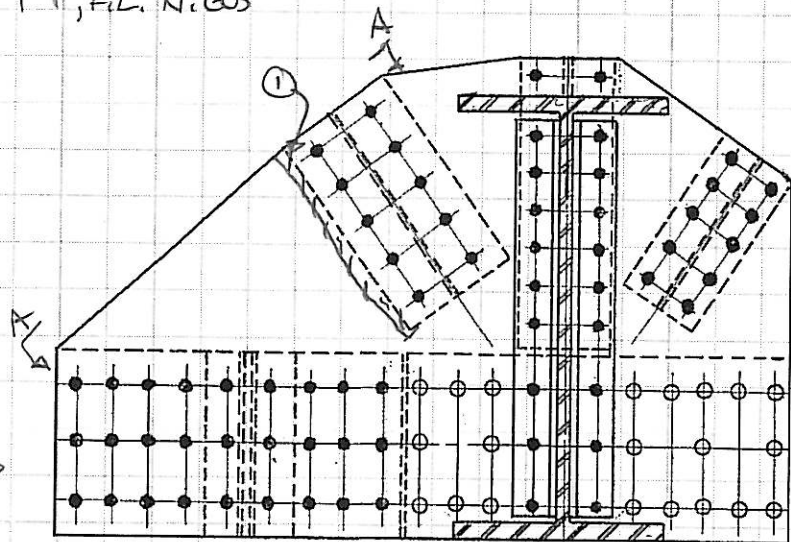

L3

Calculations for 1/4 US Grid

REVISION ①	DATE	CREW	REVISION ②	DATE	CREW
REVISION ③	DATE	CREW	REVISION ④	DATE	CREW


PROJECT NO P410070010

DATE 10/10/03

CREW BCC

BRIDGE NO HAM-50-3.76

SHEET

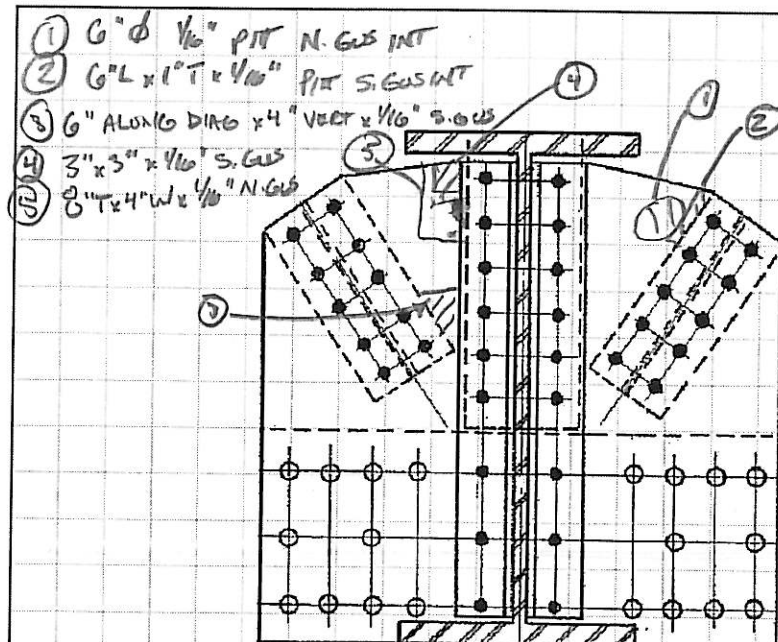

Span: 1 2 3 4
North Truss South Truss

E


L4

W1

$\frac{1}{2}$ " GUS PL (CALPERS)


- ① N. GUS. $\frac{1}{8}$ " PL 10" L (6"x1", 4"x4")
- ② S. GUS 2" ϕ $\frac{1}{8}$ " PL

$\frac{1}{2}$ " GUS PL (CALPERS)

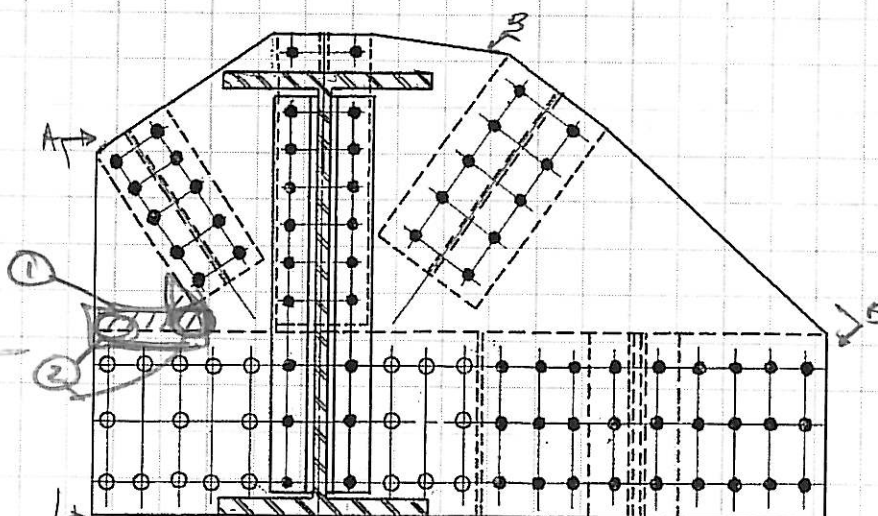

L5

Calculations for 1/4 US Grid

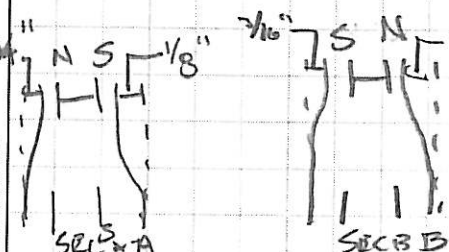


REVISION <u>1</u>	DATE	CREW	REVISION <u>2</u>	DATE	CREW
REVISION <u>3</u>	DATE	CREW	REVISION <u>4</u>	DATE	CREW

- ① 1/8" LBS 1" T APPROX 6" L S. GUS
- ② 1/8" 1" T N GUS X 24" L
- ③ 1/8" 1" T X 18" L S. GUS


1/2" GUS PL (CALPERS)

Span: ① 2 3 4
North Truss South Truss

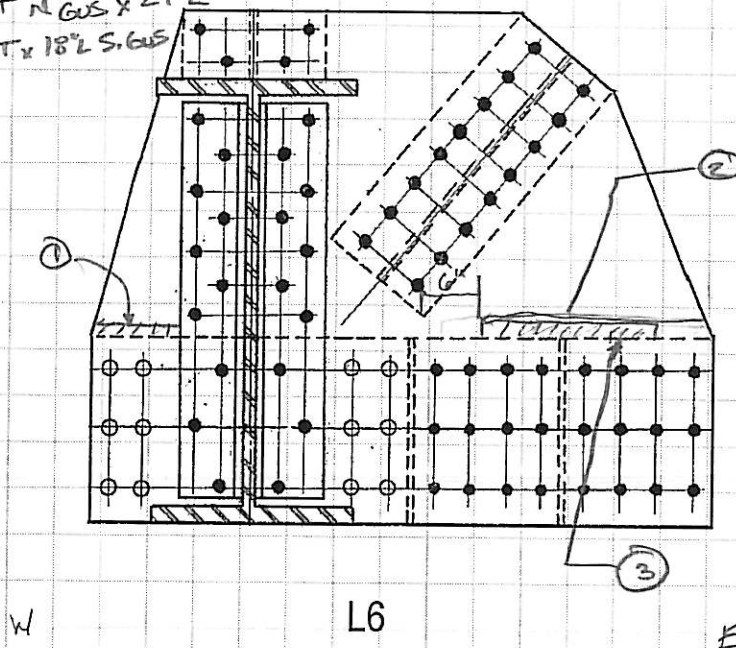


- ① 1/3" X 1" T 1/16" LBS

1/2" GUS PL (CALPERS)

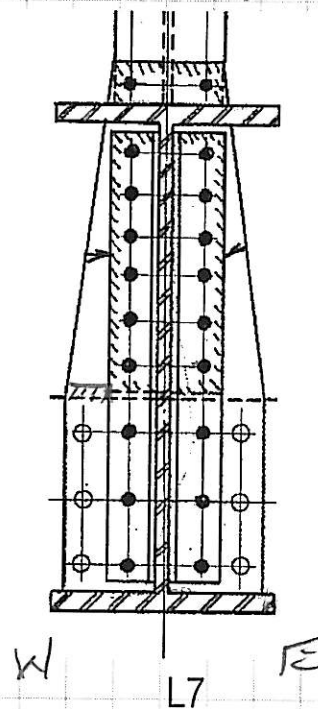

REVISION ①	DATE	CREW	REVISION ②	DATE	CREW
REVISION ③	DATE	CREW	REVISION ④	DATE	CREW

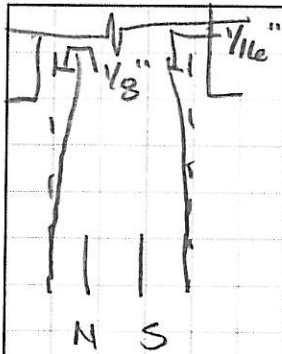


① $\frac{1}{16}" \times 1" T \times 12" L$ N. GUS

Span: 1 2 3 4

North Truss South Truss

$\frac{9}{16}"$ GUSIP
 SIGNS OF PIN NUT ROWS

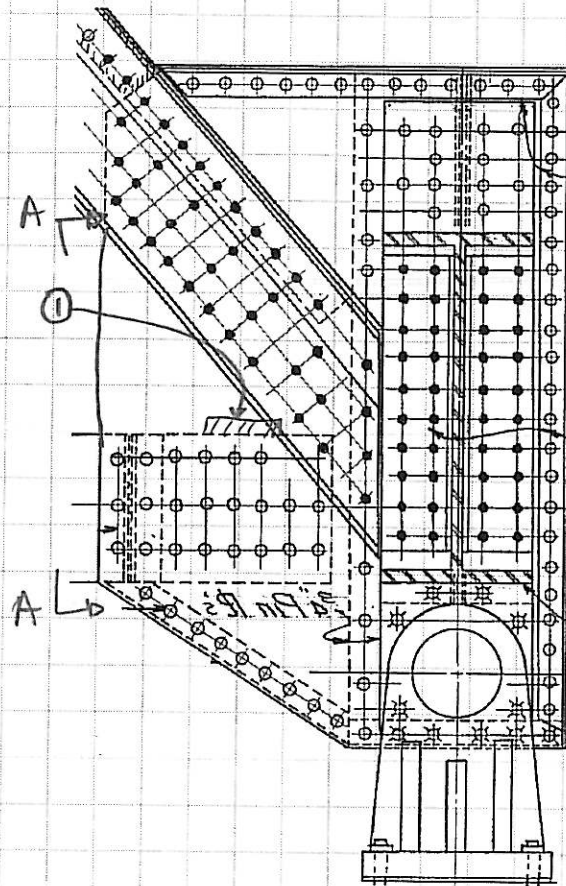

L8

Calculations for 1/4 US Grid

REVISION <u>1</u>	DATE	CREW	REVISION <u>2</u>	DATE	CREW
REVISION <u>3</u>	DATE	CREW	REVISION <u>4</u>	DATE	CREW


① 1/8" x 6" L x 2" T PLATING N.GUS, 1/16" x 6" L x 2" T S.GUS

Span: 1 2 3 4

North Truss

South Truss

3/4" GUS PL CALIPERS

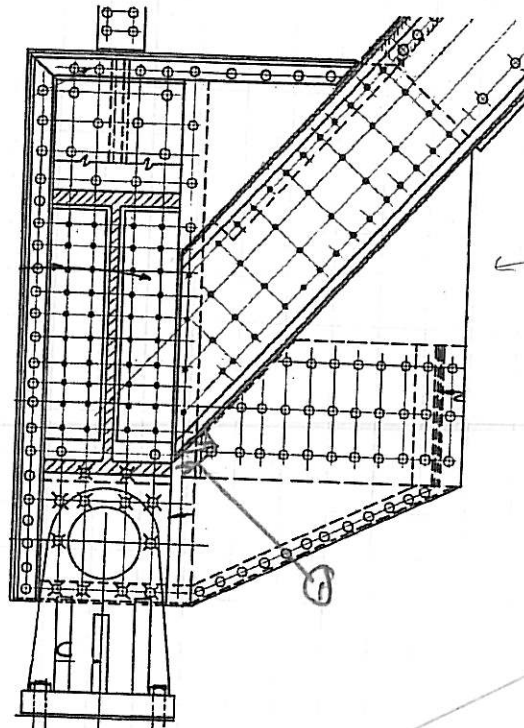


L0

① 1/8" Lx 4" Lx 1" T N.G.S.GUS

② TACK WELDS TO FL

1/2" GUS PL (CALIPERS)

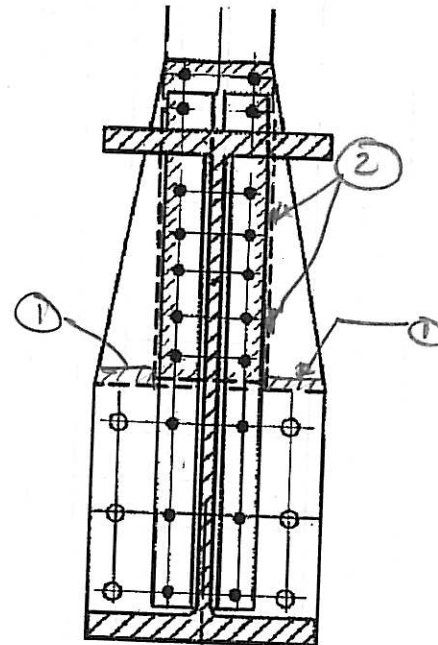

E

L1

W

REVISION 1	DATE	CREW	REVISION 2	DATE	CREW
REVISION 3	DATE	CREW	REVISION 4	DATE	CREW


- ① N. GUS PL $\frac{1}{8}$ " HT x 18" x 3"
- ② S. GUS PL $\frac{1}{8}$ " HT x 1" T

 Span: 1 2 3 4


North Truss

South Truss


$\frac{1}{2}$ " BUS PL (CALIFORNIA)

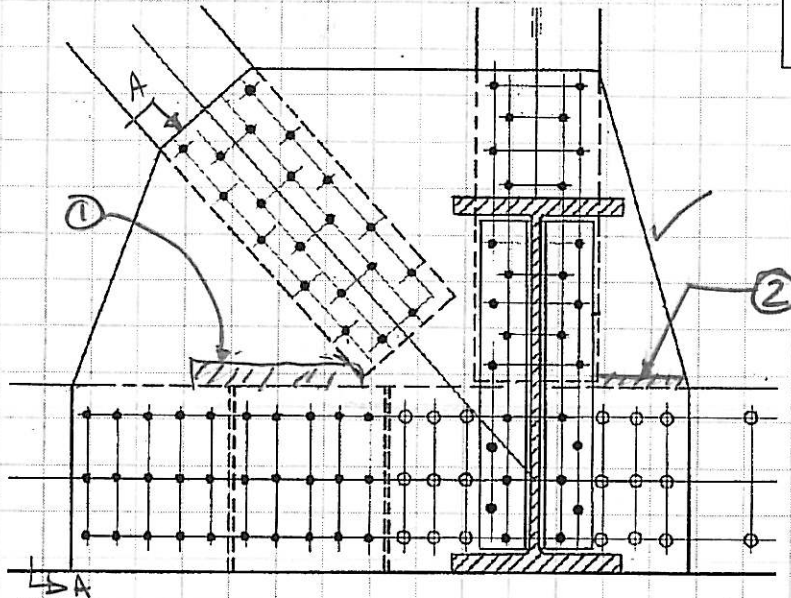


L2

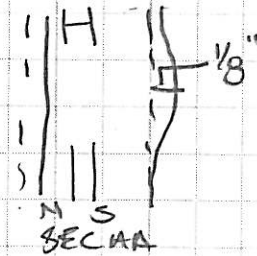

- ① N. GUS PL 4x4 x $\frac{1}{8}$ " (FROM DIAO)
- ② S. GUS PL 12" L x 1" T x $\frac{1}{16}$ " (FROM DIAO)
- ③ TACK WELDS TO FILL PL
- ④ $\frac{1}{8}$ " L 3. GUS, $\frac{1}{16}$ " N. GUS 1" T, FILL.

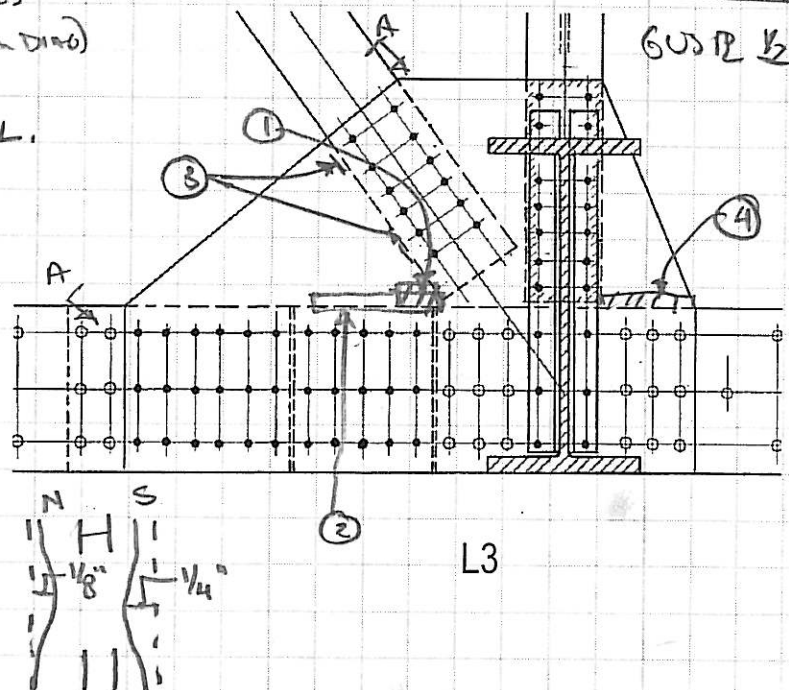

L3

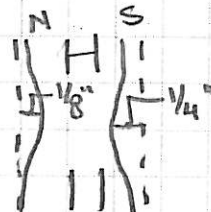

REVISION <u>1</u>	DATE	CREW	REVISION <u>2</u>	DATE	CREW
REVISION <u>3</u>	DATE	CREW	REVISION <u>4</u>	DATE	CREW

① N. GUS 2" T x F.L. x 1/16" P.T.
S. GUS 1" T x F.L. x 1/8" P.T.



② N/S GUS 1/16" P.T. 1" T F.L.

GUS 1/2" CALIPERS

Span: 1 2 3 4



North Truss

South Truss

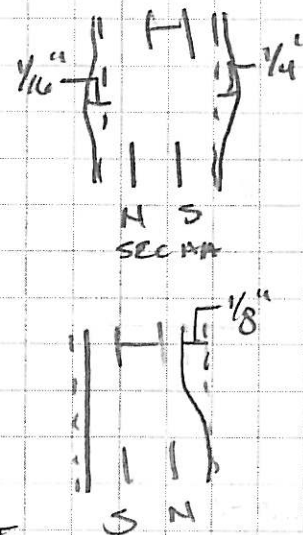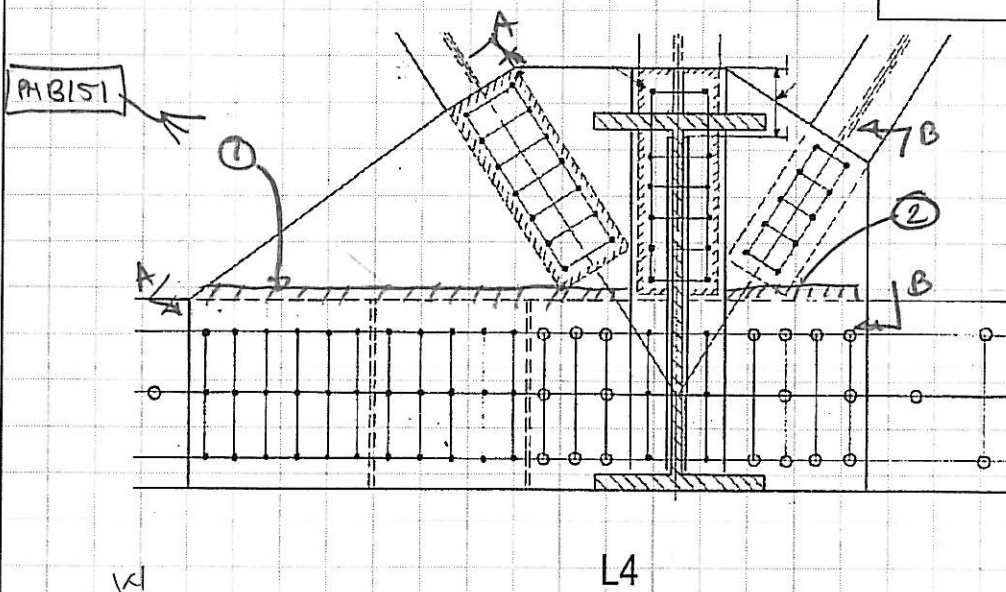

① 1/8" x 6" L x 1" T N-GUS

1/2" GUS 1/2" CALIPERS

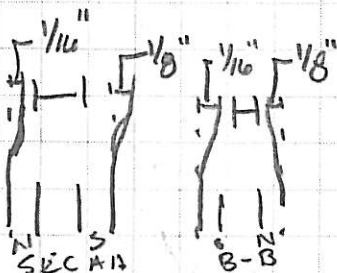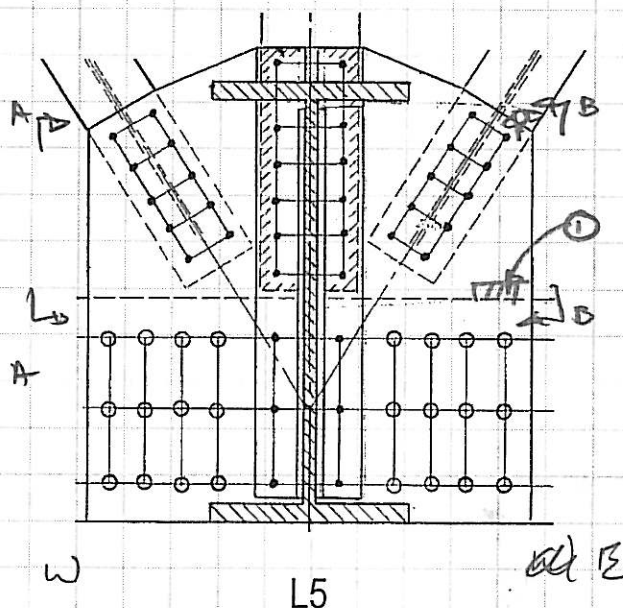

Calculations for 1/4 US Grid

REVISION 1	DATE	CREW	REVISION 2	DATE	CREW
REVISION 3	DATE	CREW	REVISION 4	DATE	CREW

PROJECT NO. P410070010

BRIDGE NO. HAM-50-3.76

DATE 10-10-08

SHEET


CREW PEJ-KMW

$$t_{\text{gusset}} = \frac{1}{2}''$$


Span: 1 2 3 4

North Truss

South Truss

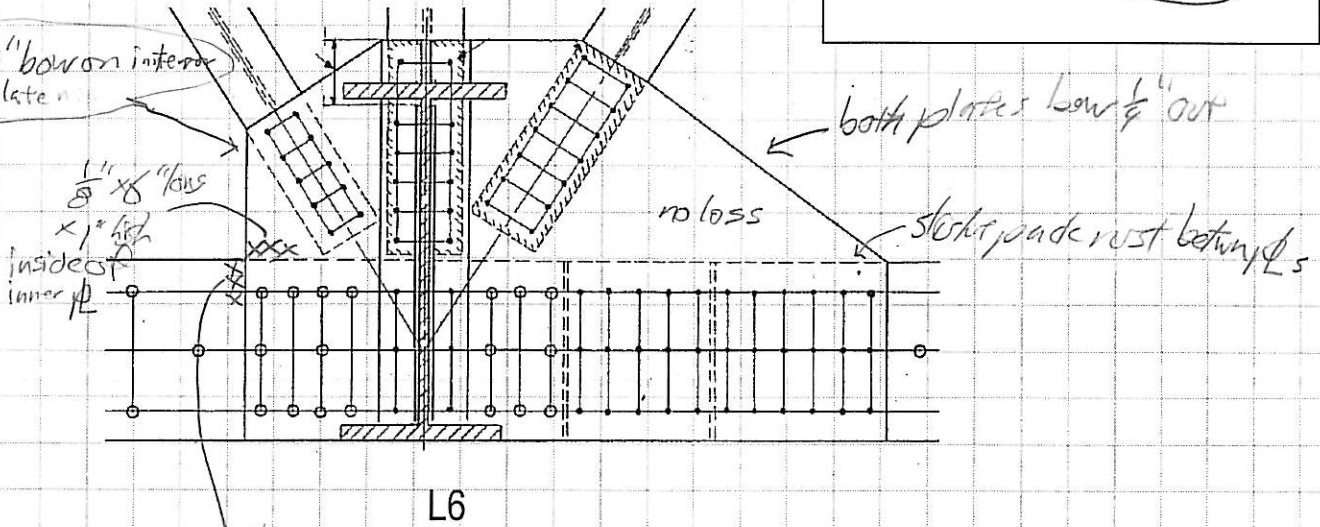

loss of section on lower chord
1/8" max x 3"
slight pade rust betw adjacent pl

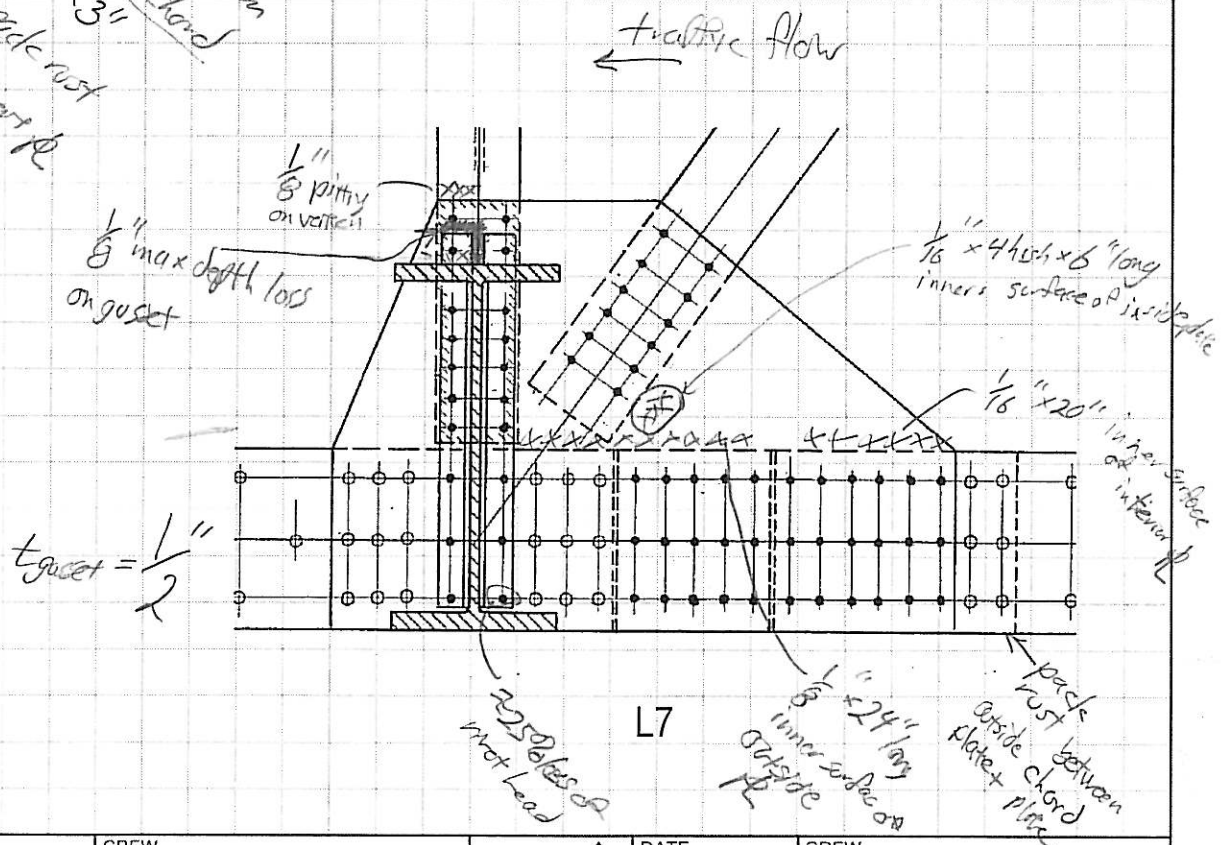

$$t_{\text{gusset}} = \frac{1}{2}''$$

REVISION 1	DATE	CREW	REVISION 2	DATE	CREW
REVISION 3	DATE	CREW	REVISION 4	DATE	CREW

PROJECT NO. P410070010

BRIDGE NO. HAM-50-3.76

DATE 10-10-08


SHEET

CREW PEJ - KAW

Span: 1 2 3 4


North Truss

South Truss

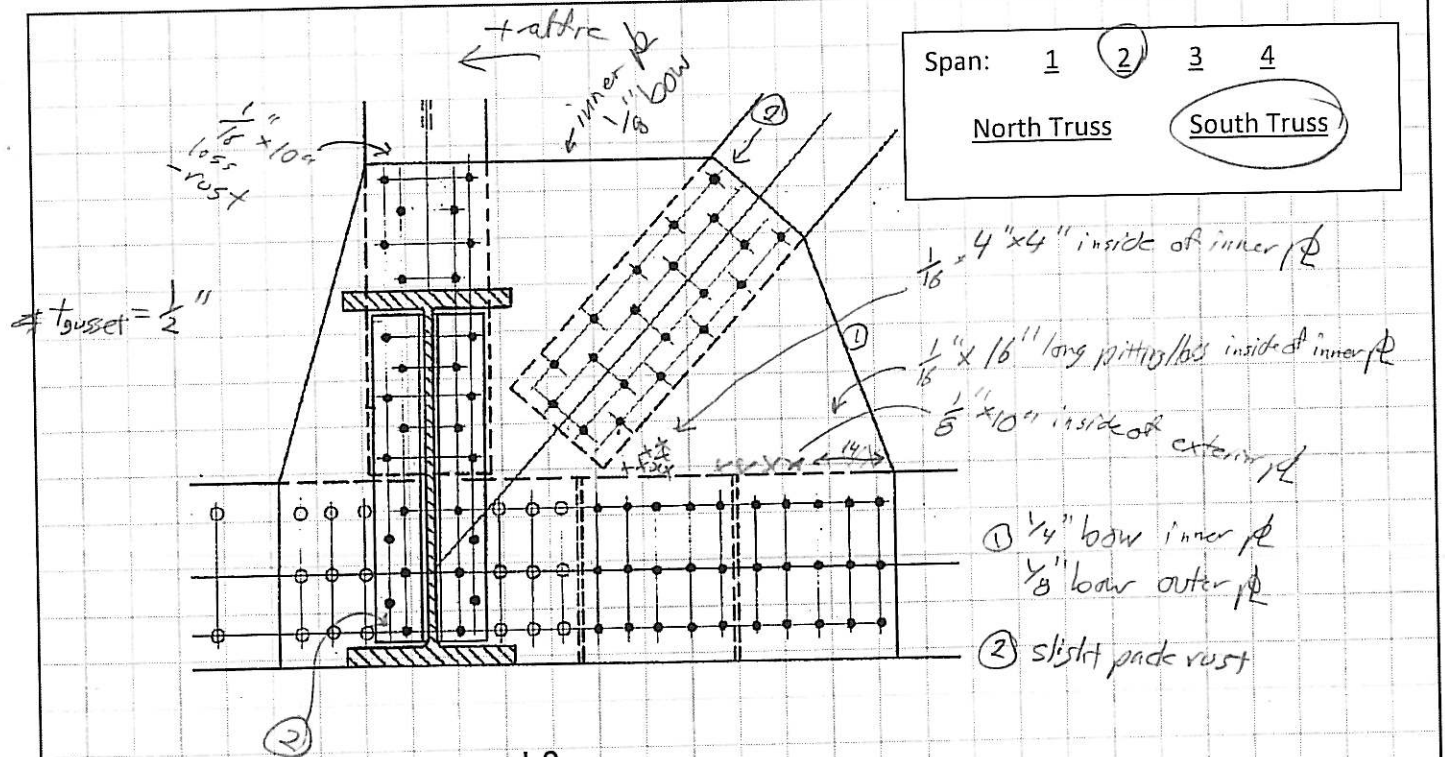

L8

view looking north
from "outside"

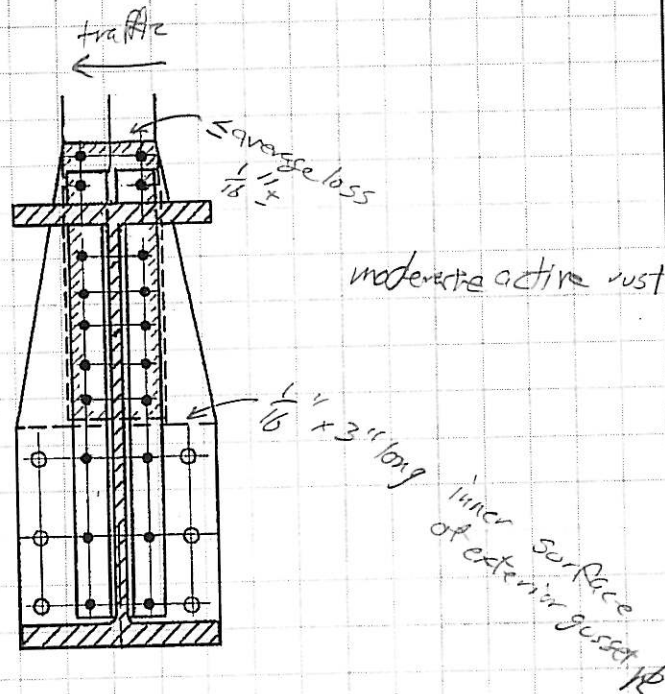

L9

Calculations for 1/4 US Grid

REVISION Δ 1	DATE	CREW	REVISION Δ 2	DATE	CREW
REVISION Δ 3	DATE	CREW	REVISION Δ 4	DATE	CREW


- ① $\frac{1}{8}$ " PIN x 12" L x 1" T NGS GUS
- ② N. PIN 12 EXT $\frac{1}{16}$ " PILING BRN FB/PIN

Span: 1 2 3 4

North Truss

South Truss

GUS PL $\frac{1}{16}$ " CALIPERS

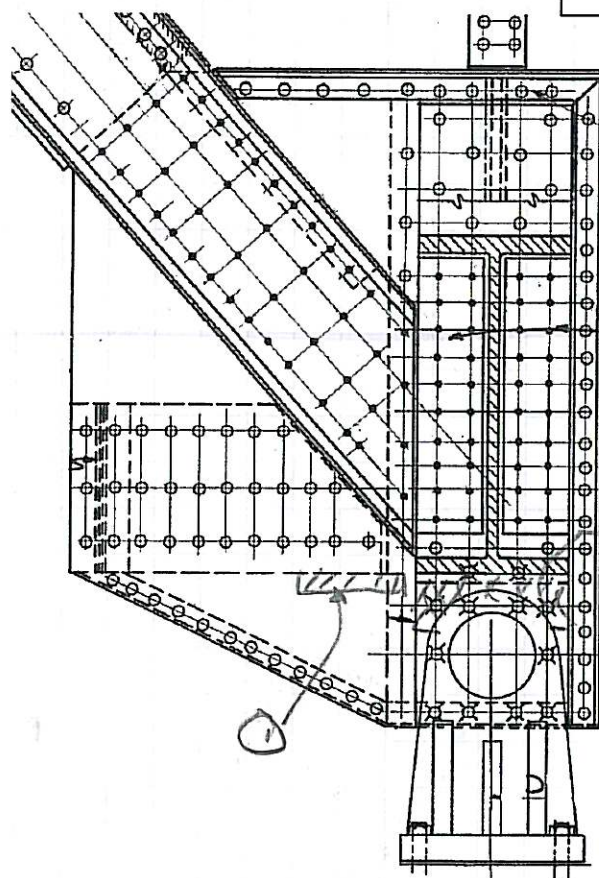

L10

- EVIDENCE OF NOT ROTATION

- ROCKER MEAS @ 90° VERTICAL

REVISION ①	DATE	CREW	REVISION ②	DATE	CREW
REVISION ③	DATE	CREW	REVISION ④	DATE	CREW

PROJECT NO. P410070010

DATE 10-8-08

CREW PEJ KMW


BRIDGE NO. HAM-50-3.76

SHEET

Span: 1 2 3 4

North Truss

South Truss

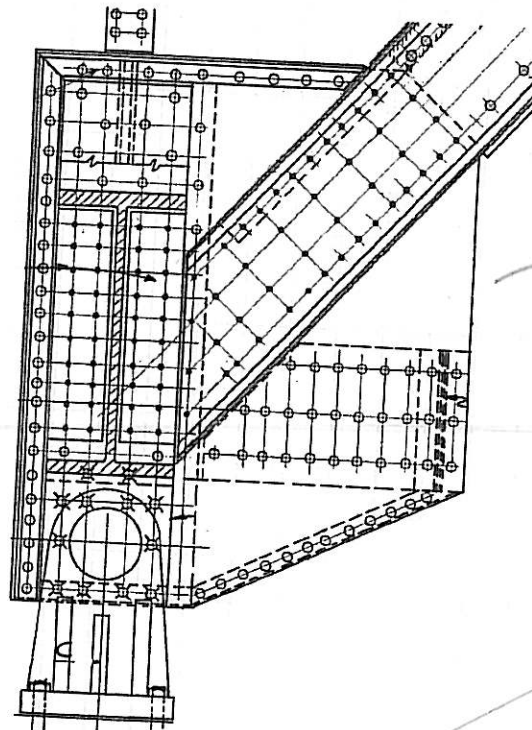


L0

PEJ/KMW

ZERO THREAD COUNT ON INT. FACE

PEJ/KMW
10-10-08

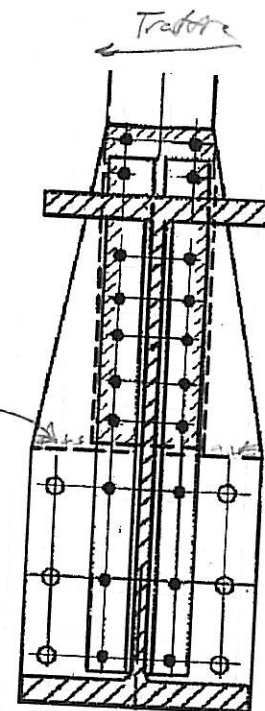

L1

1/8" ribs
to exterior
plate
(inner part face)

1/8" x 3/4" ribs inner face
outer/external plate

REVISION 1	DATE	CREW	REVISION 2	DATE	CREW
REVISION 3	DATE	CREW	REVISION 4	DATE	CREW

PROJECT NO. P410070010

BRIDGE NO. HAM-50-3.76

DATE 10-11-08


SHEET

CREW PEJ-RML


Span: 1 2 3 4

North Truss

South Truss

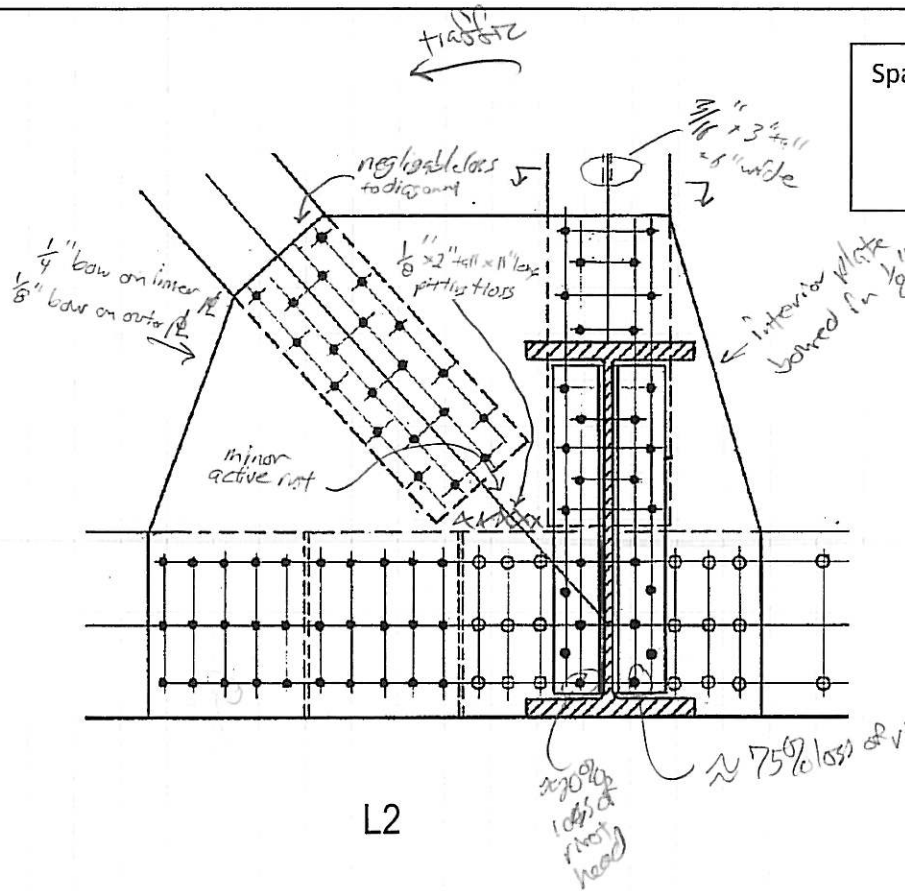

L2

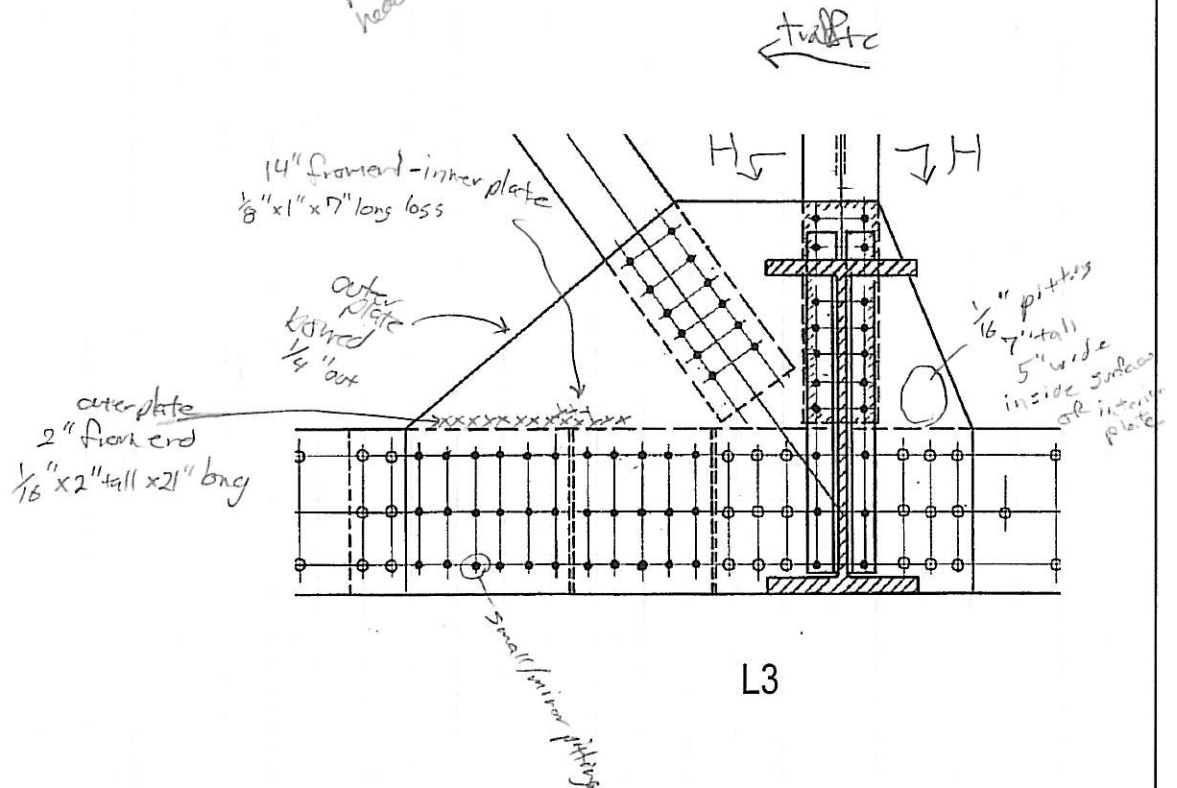

L3

REVISION 1	DATE	CREW	REVISION 2	DATE	CREW
REVISION 3	DATE	CREW	REVISION 4	DATE	CREW

PROJECT NO. P410070010

BRIDGE NO. HAM-50-3.76

DATE 10-10-08


SHEET

CREW PEJ-KMW

Span: 1 2 3 4

North Truss

South Truss

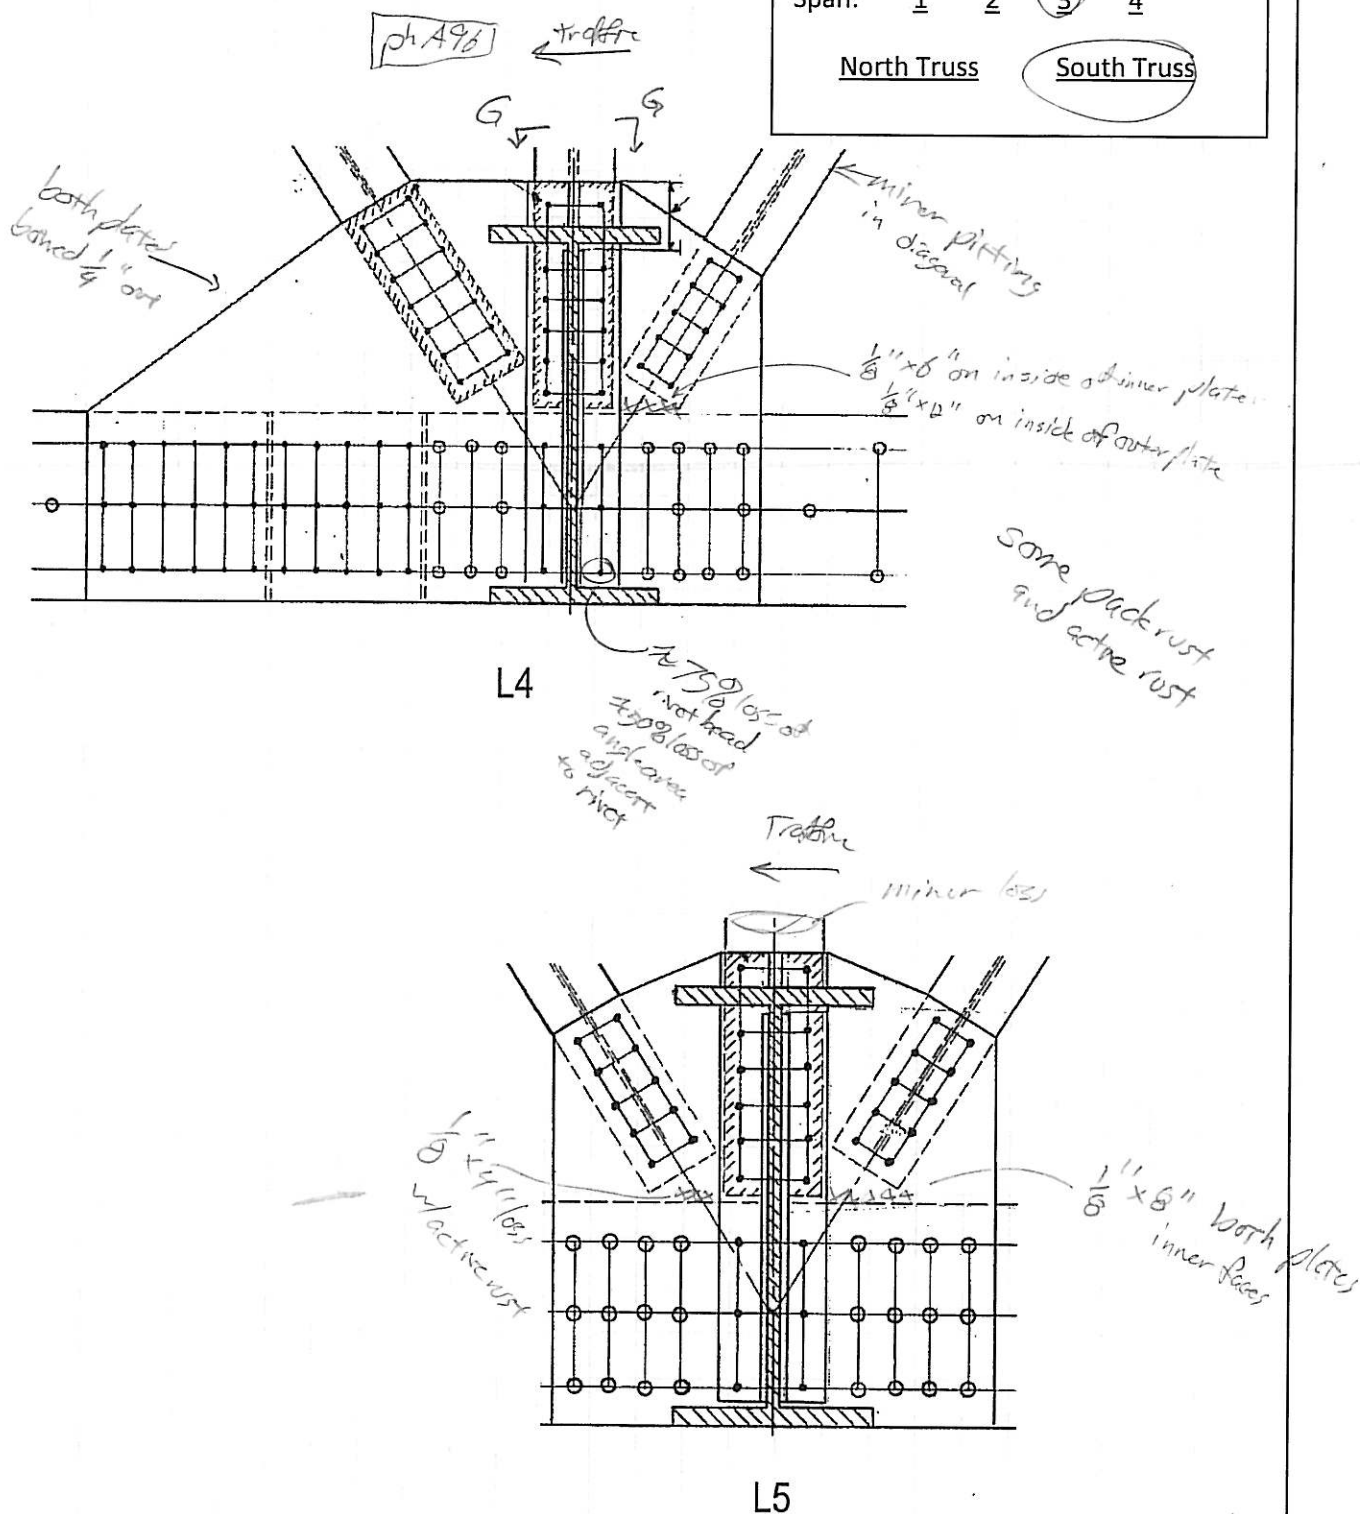

REVISION <u>1</u>	DATE	CREW	REVISION <u>2</u>	DATE	CREW
REVISION <u>3</u>	DATE	CREW	REVISION <u>4</u>	DATE	CREW



PROJECT NO. P410070010

BRIDGE NO. HAM-50-3.76

DATE 10-10-08

SHEET

CREW PET KMV

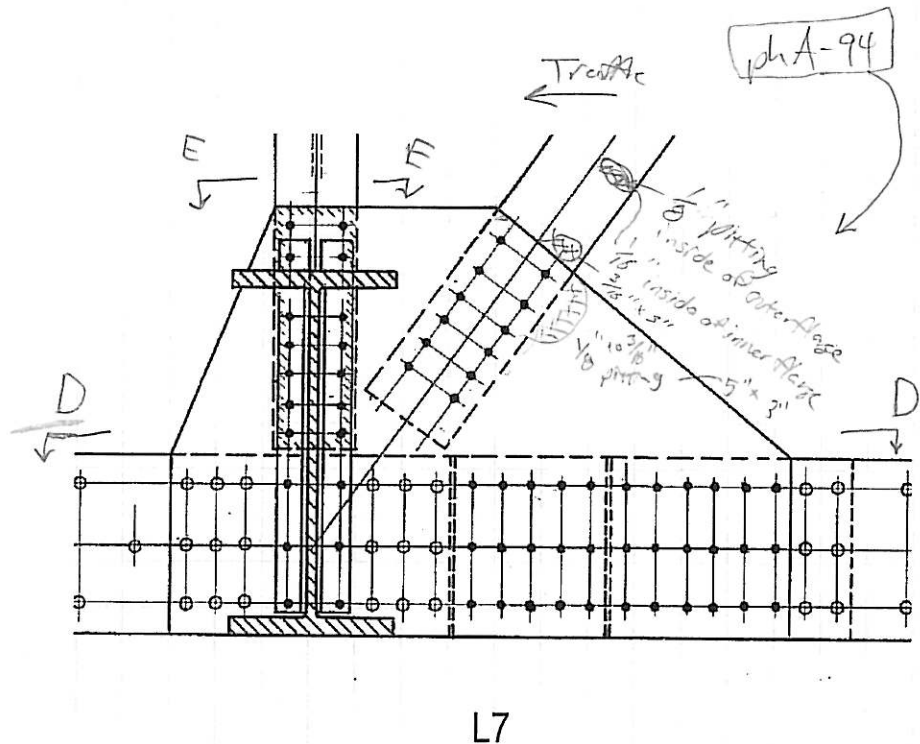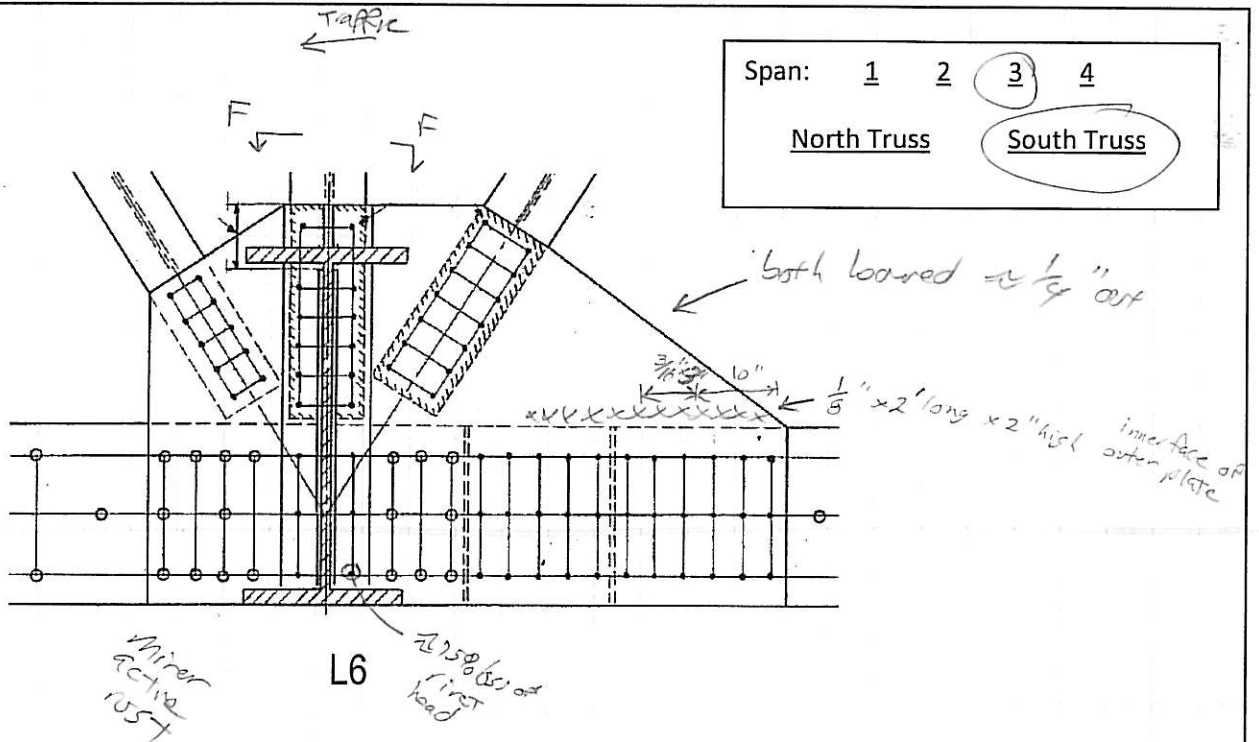

REVISION <u>1</u>	DATE	CREW	REVISION <u>2</u>	DATE	CREW
REVISION <u>3</u>	DATE	CREW	REVISION <u>4</u>	DATE	CREW



PROJECT NO. P410070010

BRIDGE NO. HAM-50-3.76

DATE 10-10-08

SHEET


CREW PEJ-KMW

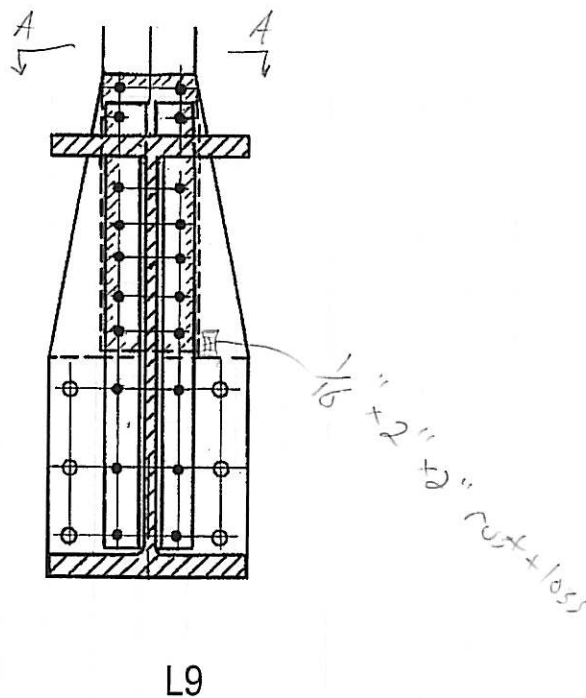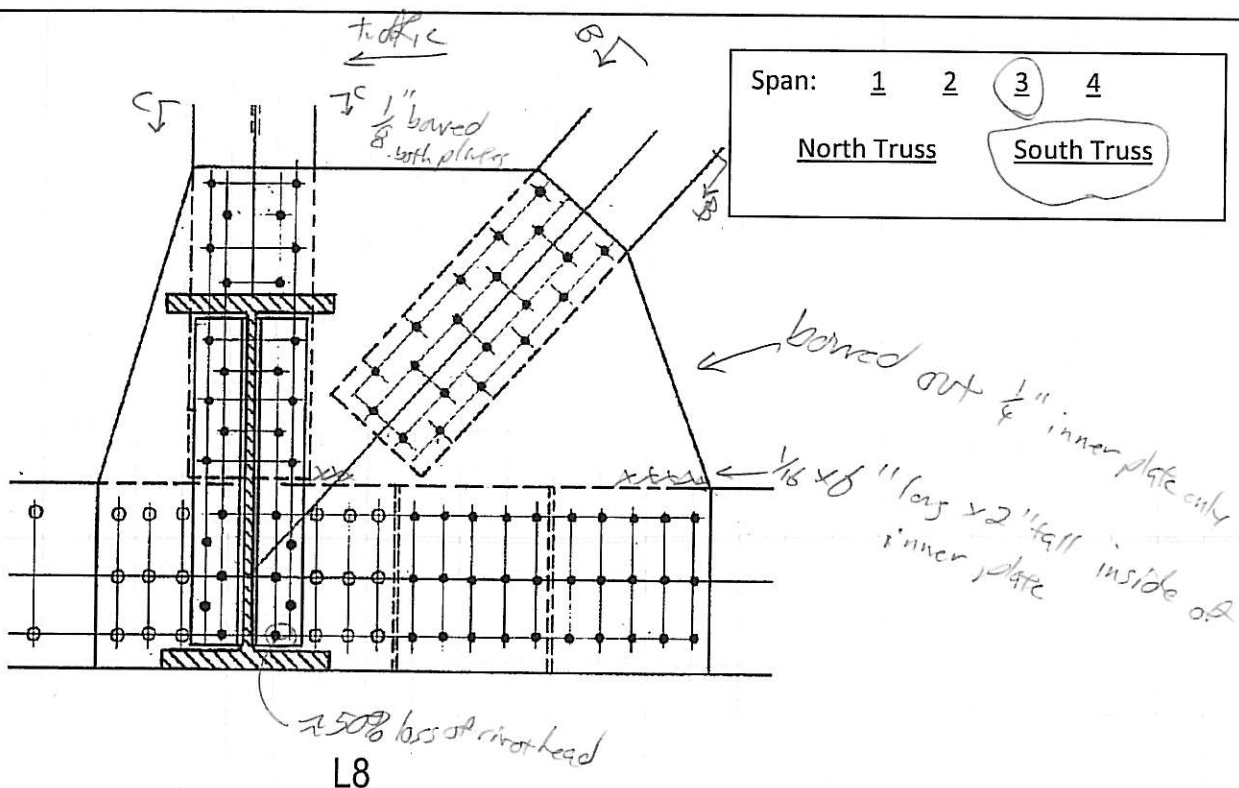

REVISION <u>1</u>	DATE	CREW	REVISION <u>2</u>	DATE	CREW
REVISION <u>3</u>	DATE	CREW	REVISION <u>4</u>	DATE	CREW

PROJECT NO. P410070010 BRIDGE NO. HAM-50-3.76
 DATE _____ SHEET _____
 CREW _____

Span: 1 2 3 4
North Truss South Truss

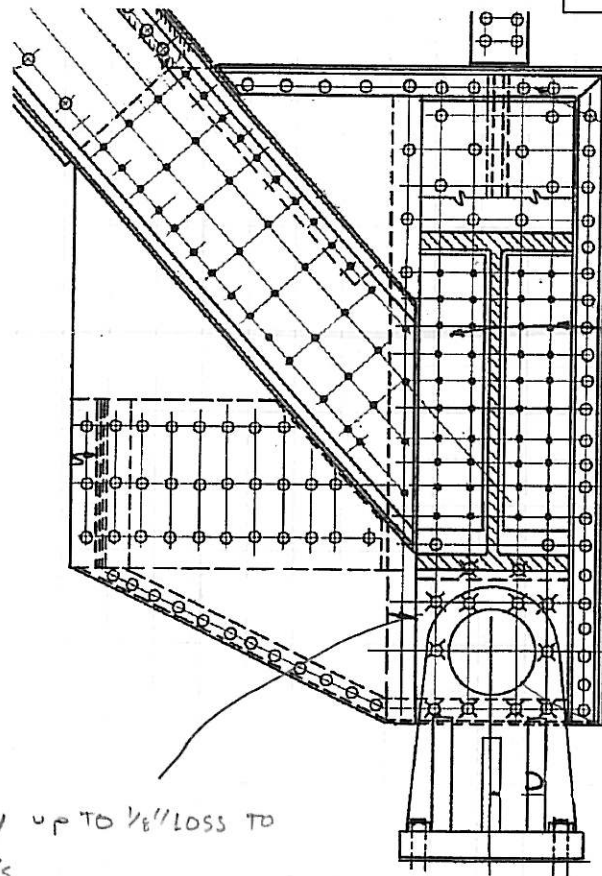

- SIGN OF PIN ROT. S. SIDE
 - SE ANCHOR NLT COMPLETELY
 BACKED OFF PHB 113
 - NE " " BACKED OFF
 ~ 1"

- @ 60°, Exp Brn is LEVEL AND
 FLUSH w/ KEY IN CONTRACTION

- MINIMAL PITTING

PNT COMPLETELY FAILED
 ON PIN, MINOR SURF
 RUST w/ NEAR. LOSS

- INT PIN R w/ up to 1/8" LOSS TO
 ALL EXP. SURF'S

- EVIDENCE OF PIN ROTATION
PHB 112

L10

N. ELEV: PHB 114

REVISION <u>1</u>	DATE	CREW	REVISION <u>2</u>	DATE	CREW
REVISION <u>3</u>	DATE	CREW	REVISION <u>4</u>	DATE	CREW

Span: 1 2 3 4

North Truss

South Truss


SLIGHT

PIN NUT SHOWS SIGNS OF ROTATION


Ø THREAD COUNT BOTH SIDES OF PIN

① BE NE NUT BACKED OFF ~1/16"

② N. PIN R (EXT) EXHIBITS Pitting 1/16"

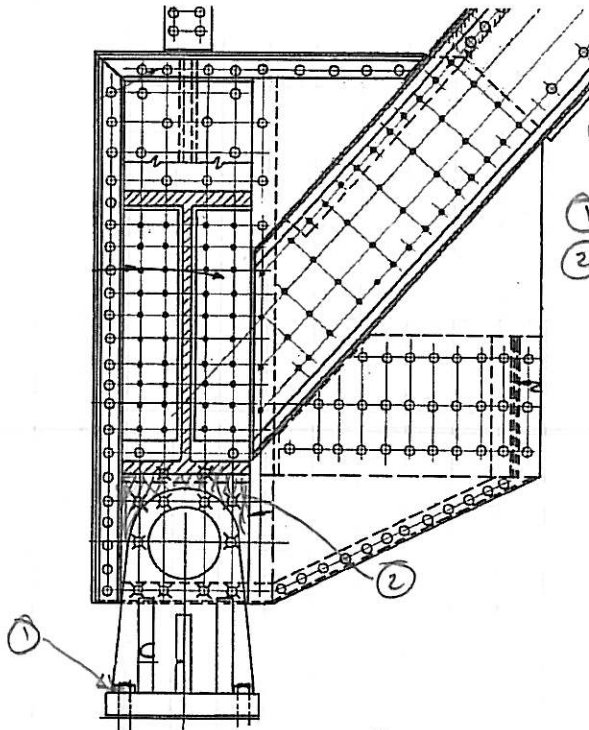

L0 - GTHAR MISLABELED SHOULD BE L8

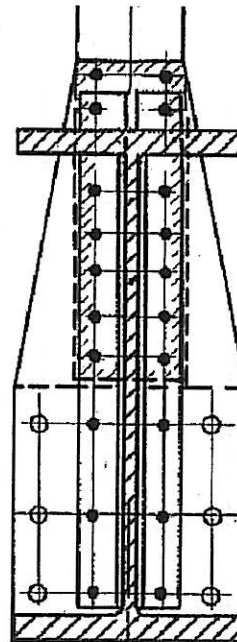


L1

REVISION 1	DATE	CREW	REVISION 2	DATE	CREW
REVISION 3	DATE	CREW	REVISION 4	DATE	CREW

PROJECT NO P410070010
 DATE 10/8/08
 CREW BSC

BRIDGE NO HAM-50-3.76
 SHEET _____

Span: 1 2 3 4
North Truss South Truss

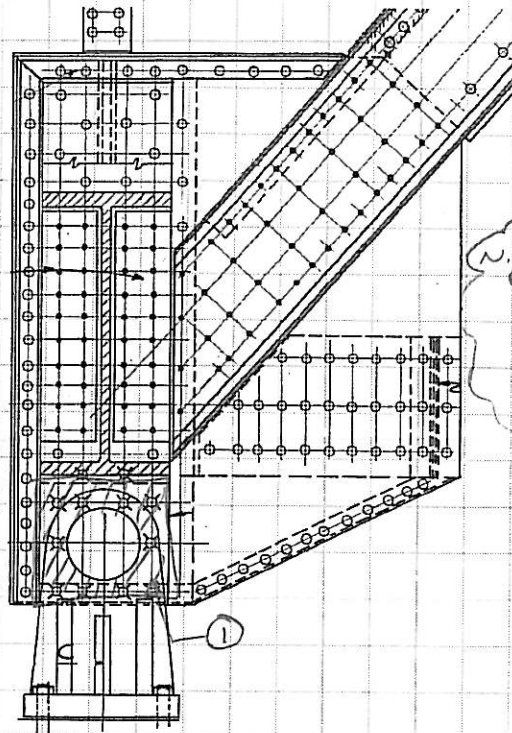

LO-L8

① INT. PIN R $\frac{1}{8}$ " PITCH & N. GUS R


N. ELEV. = PHB 111

S. TRUSS
 L3 NOTES

② INDICATION OF PIN ROTATION ON N. SIDE

③ ZERO THREAD COUNT

TRAFFIC

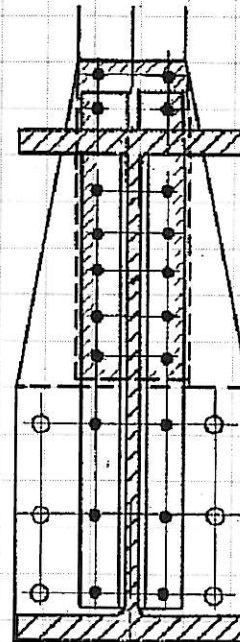

PEJ KML
 10-10-08

$\frac{1}{4}$ bar outer R

negligible loss

L1

REVISION <u>1</u>	DATE	CREW	REVISION <u>2</u>	DATE	CREW
REVISION <u>3</u>	DATE	CREW	REVISION <u>4</u>	DATE	CREW

PROJECT NO. P410070010

BRIDGE NO. HAM-50-3.76

DATE 10/10/23

SHEET

CREW BKL

Span: 1 2 3 4

North Truss

South Truss


SLIGHT

PIN NUT SHOWS SIGNS OF ROTATION


Ø THREAD COUNT BOTH SIDES OF PIN

① BE NE NUT ISACKED OFF ~1/16"

② N. PIN R (EXT) EXHIBIT PITTING 1/16"

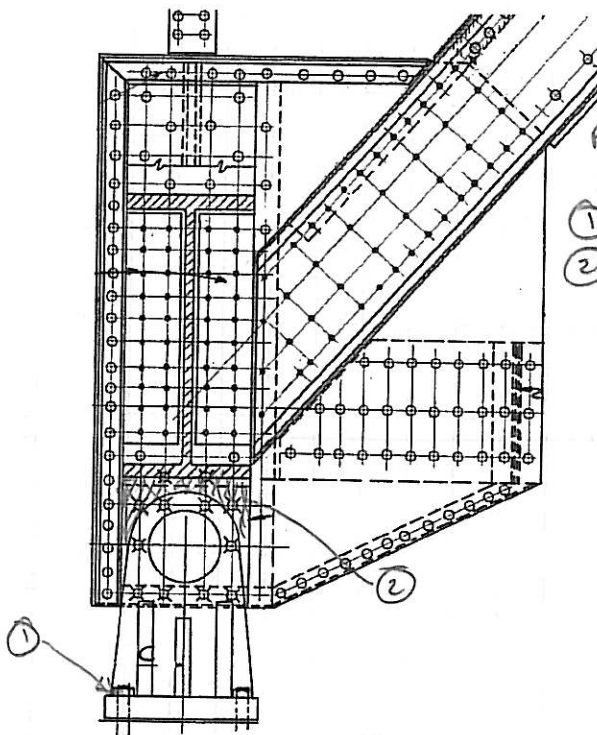

LO - OTHER MISLABLET SHOULD BE LB

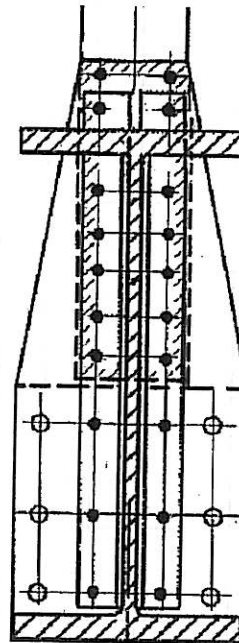

L1

REVISION 1	DATE	CREW	REVISION 2	DATE	CREW
REVISION 3	DATE	CREW	REVISION 4	DATE	CREW

PROJECT NO. P410070010


BRIDGE NO. HAM-50-3.76

DATE 10/8/08

SHEET

CREW BSC

Span: 1 2 3 4
North Truss South Truss

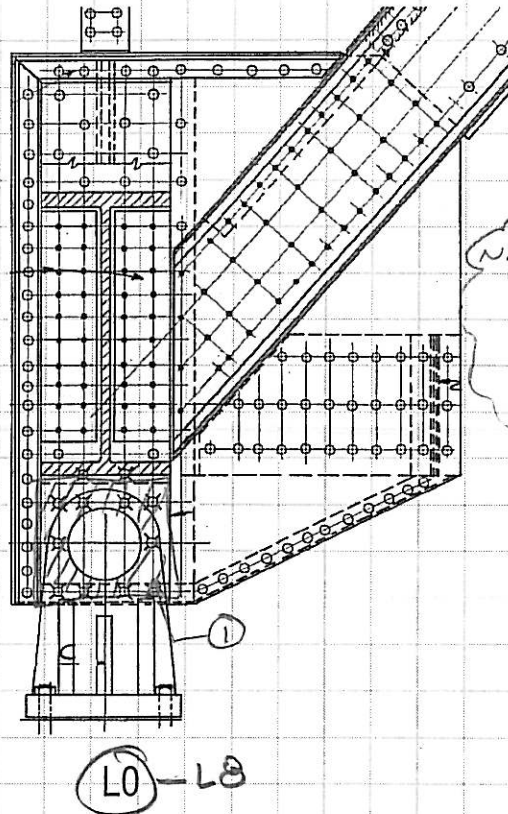

① INT. PIN R $\frac{1}{8}$ " PILING W. 60S R


N. ELEV. = PHB 111

S. TRUSS
 LB NOTES

② INDICATION OF PIN ROTATION ON N. SIDE

③ ZERO THREAD COUNT

TRAFFIC
 ←

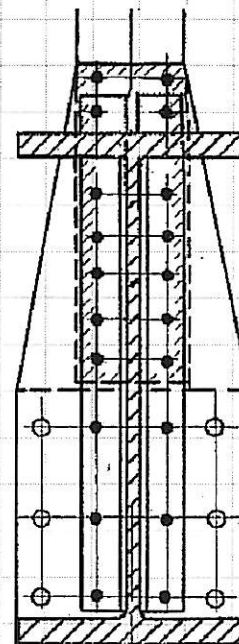

PET KWH
 10-10-08

← $\frac{1}{4}$ bar outer R

negligible
 loss

L1

REVISION 1	DATE	CREW	REVISION 2	DATE	CREW
REVISION 3	DATE	CREW	REVISION 4	DATE	CREW

PROJECT NO. P410070010

BRIDGE NO. HAM-50-3.76

DATE 10/10/23

SHEET

CREW BKL

Span: 1 2 3 4

North Truss

South Truss


SLIGHT

PIN NUT SHOWS SIGNS OF ROTATION


Ø THREAD COUNT BOTH SIDES OF PIN

① NUT NOT BACKED OFF ~1/16"

② N. PIN R (EXT) EXHIBIT PITTING 1/16"

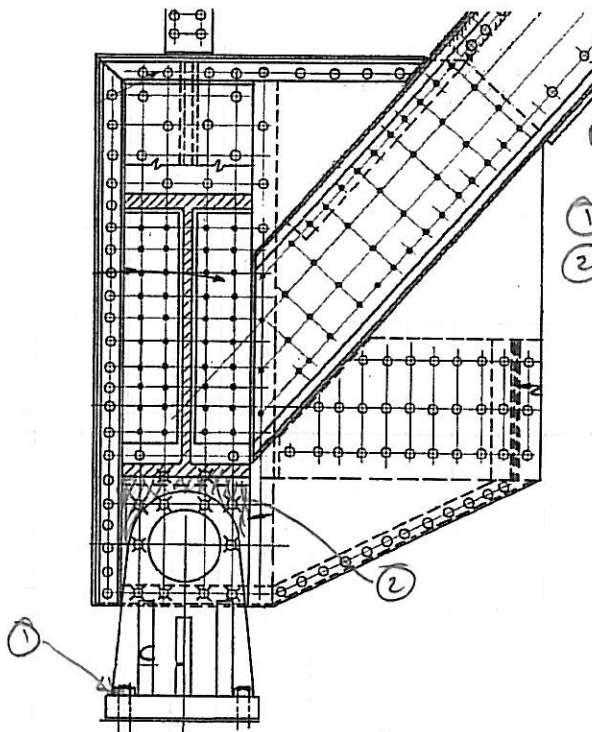

L0 - GTHAR MISLABELED SHOULD BE L8

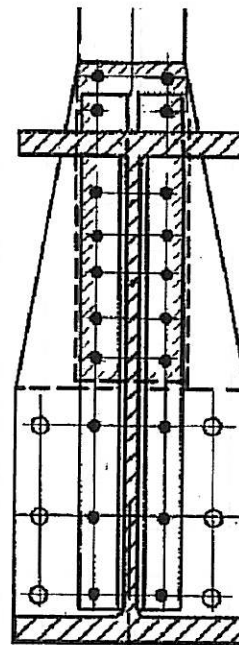

L1

REVISION 1	DATE	CREW	REVISION 2	DATE	CREW
REVISION 3	DATE	CREW	REVISION 4	DATE	CREW

PROJECT NO. P410070010


BRIDGE NO. HAM-50-3.76

DATE 10/8/08

SHEET

CREW BKC

Span: 1 2 3 4
North Truss South Truss

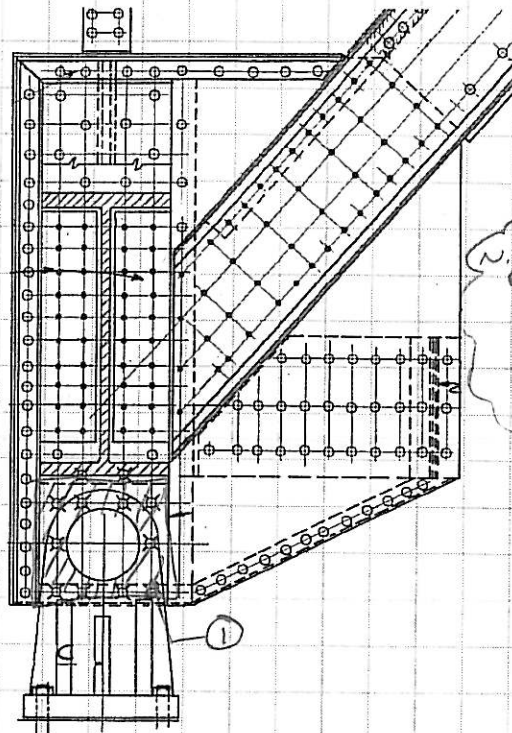

L0-L8

① INT. PIN PL 1/8" PILING N. GUS PL


N. ELEV. = PHB 111

S. TRUSS
L8 NOTES

② INDICATION OF PIN ROTATION ON N. SIDE

③ ZERO THREAD COUNT

TRAFFIC

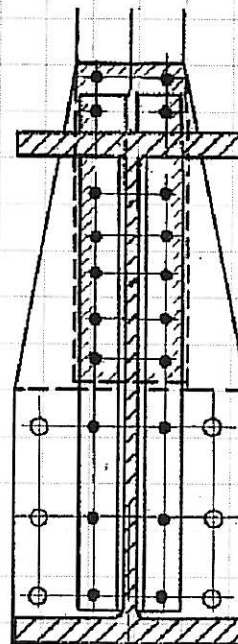

PEJ KMH
10-10-08

1/4 bar outer

negligible loss

L1

REVISION 1	DATE	CREW	REVISION 2	DATE	CREW
REVISION 3	DATE	CREW	REVISION 4	DATE	CREW

PROJECT NO. P410070010

BRIDGE NO. HAM-50-3.76

DATE 10/10/23

SHEET

CREW BKL

Span: 1 2 3 4

North Truss

South Truss


SLIGHT

PIN NUT SHOWS SIGNS OF ROTATION


Ø THREAD COUNT BOTH SIDES OF PIN

① NUT NOT BACKED OFF ~1/16"

② N. PIN R (EXT) EXHIBITS PITTING 1/16"

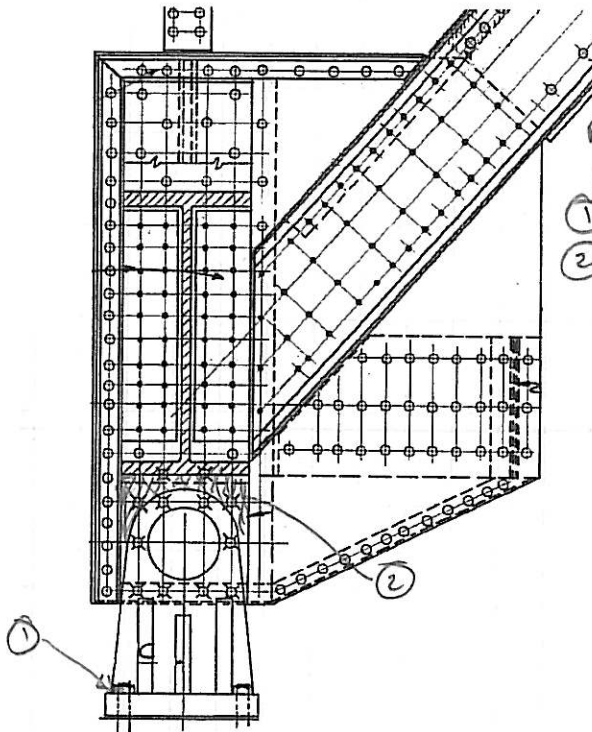

LO - OTHER MISLABELED SHOULD BE LB

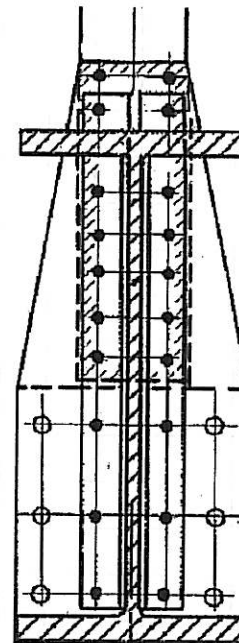

L1

REVISION 1	DATE	CREW	REVISION 2	DATE	CREW
REVISION 3	DATE	CREW	REVISION 4	DATE	CREW

PROJECT NO. P410070010


BRIDGE NO. HAM-50-3.76

DATE 10/8/08

SHEET

CREW BSC

Span: 1 2 3 4
North Truss South Truss

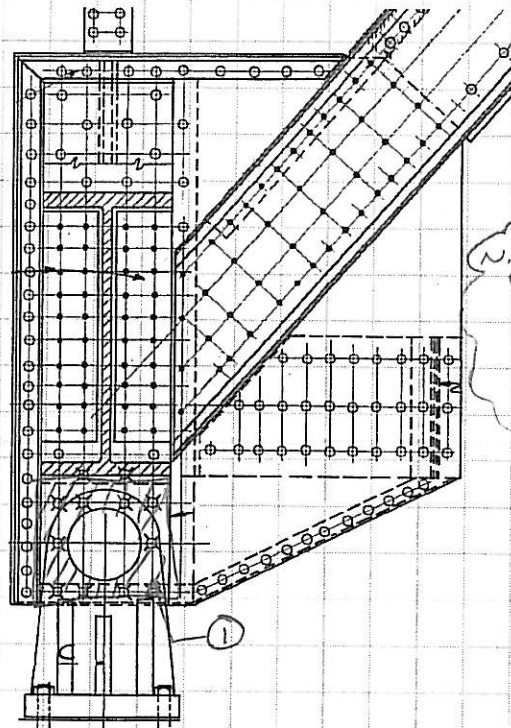

LO-LB

① INT. PIN R 1/8" PITCHING W. 60S R


N. ELEV. = PHB 111

S. TRUSS
LS NOTES

② INDICATION OF PIN ROTATION ON N. SIDE

③ ZERO THREAD COUNT

TRAFFIC

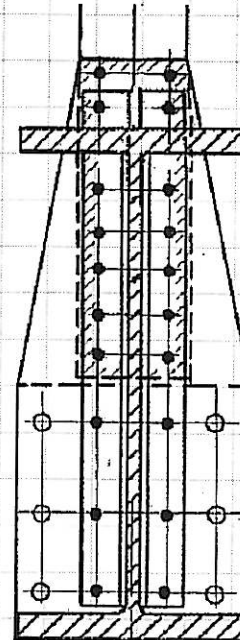

PEJ KMH
10-10-08

1/4 bar after R


negligible loss

L1

REVISION 1	DATE	CREW	REVISION 2	DATE	CREW
REVISION 3	DATE	CREW	REVISION 4	DATE	CREW


REVISION 1	DATE	CREW	REVISION 2	DATE	CREW
REVISION 3	DATE	CREW	REVISION 4	DATE	CREW

L3

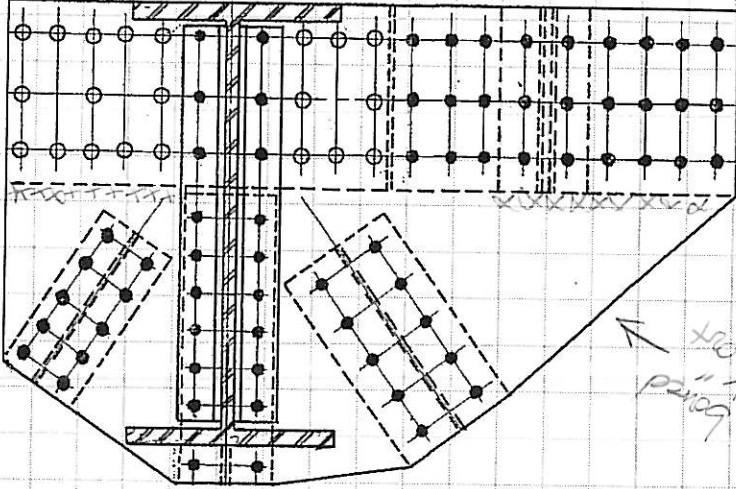

1/2" x 6" pth
1/2" x 6" pth

L2

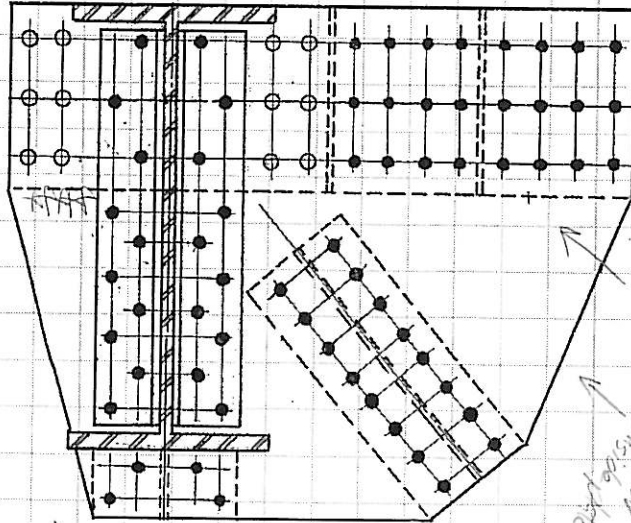

1/2" x 6" pth


1/2" x 6" pth
1/2" x 6" pth

Span:	1	2	3	4
North Truss				
South Truss				

Span: 1 2 3 4


North Truss

South Truss

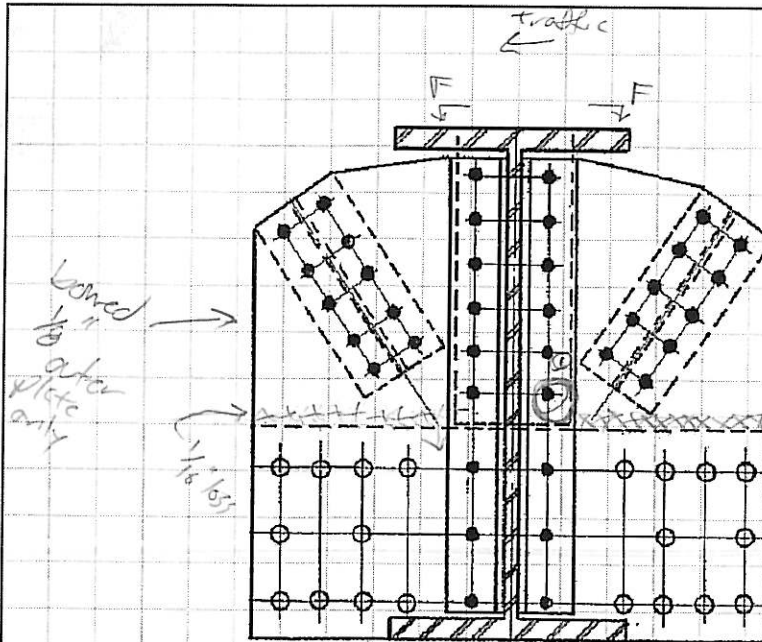

L4


minor pitting
 1/8" x 15" long interior of both plates
 minor loose angle + rivet
 minor active rust

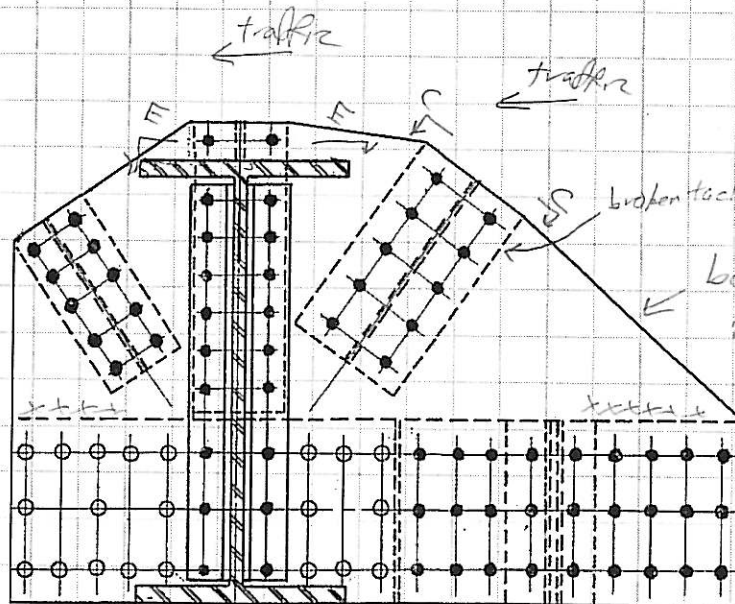

L5

Some active rust

REVISION 1	DATE	CREW	REVISION 2	DATE	CREW
REVISION 3	DATE	CREW	REVISION 4	DATE	CREW

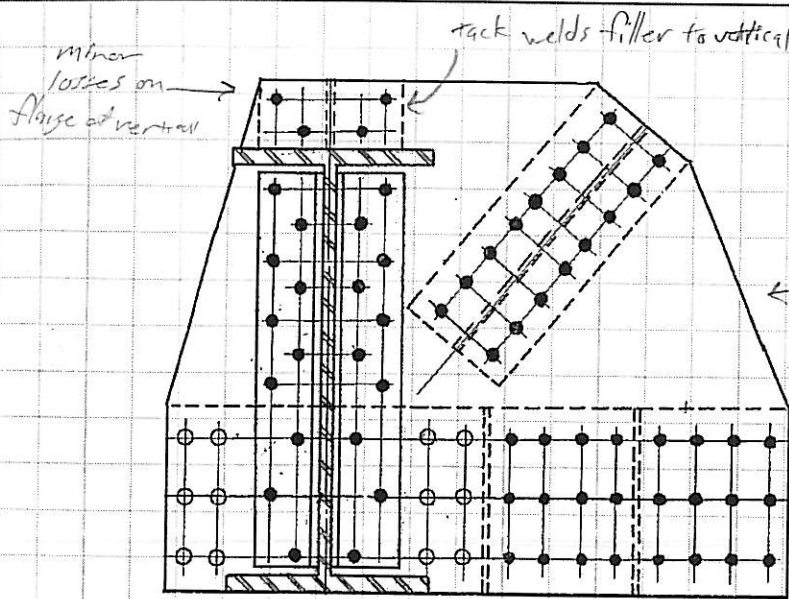


Span: 1 2 3 4

North Truss

South Truss

$\frac{1}{8}$ " bowed out
negligible loss on gusset
slight active rust

L6

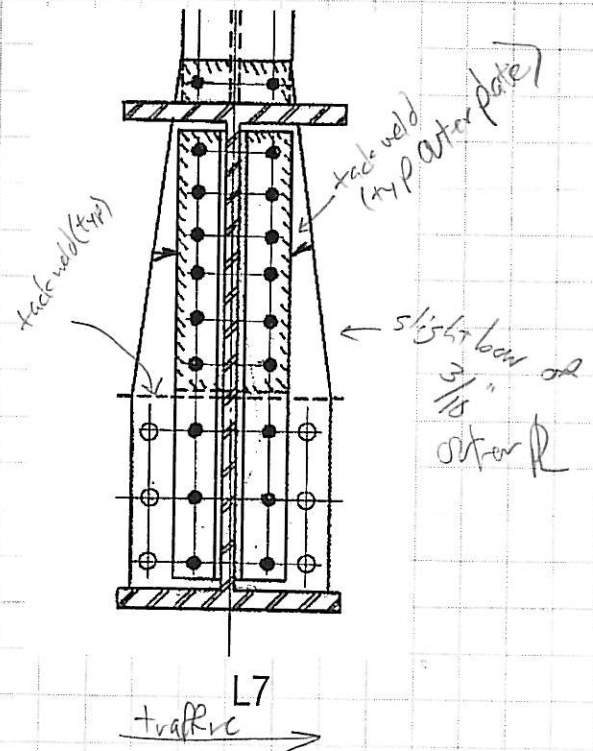

L7

traffic →


REVISION 1	DATE	CREW	REVISION 2	DATE	CREW
REVISION 3	DATE	CREW	REVISION 4	DATE	CREW