

old CFN 430900335  
 new CFN 1849711  
 SLM 3.35, 36"  
 SEE SHEET 21,  
 266 AND 300

SLM 3.49, 21"  
 SEE SHEET 53  
 REPLACED IN 10  
 1993

SEE 1993 CUY/LAK-271/90/271X/90X-14.85/2.76/0.00/2.76  
 PLANS FOR MODIFICATIONS TO STORM SEWERS

BRIDGE

FED. RD. DIVISION	STATE	PROJECT
2	OHIO	I-1103 (19)

LAKE COUNTY  
 LAK-1-2.16

ROADWAY & PAVEMENT					
Ref. No.	Station		Side & E	I-15	I-12
	From	To		Guard Rail Dwg. No. 2A Lin. Ft.	Concrete Curb Special Lin. Ft.
I-R	135+50.08	138+00	RI	250.00	
E-R	132+83	133+05	RI	25.00	
I-P	135+48	138+00	RI		252
Totals:				275.0	252


Ref. No.	Station	Side & E	I-15		I-12	
			Guard Rail Dwg. No. 2A Lin. Ft.	Concrete Curb Special Lin. Ft.	Guard Rail Dwg. No. 2A Lin. Ft.	Concrete Curb Special Lin. Ft.
I-16	L-10					
I-10	L-10					
E-12	E-4					
S-4	S-4					
S-1	S-1					
I-14	I-14					
I-14	I-14					
I-8	I-8					
I-5	I-5					
I-4	I-4					
I-4	I-4					
I-2	I-2					
Totals:						

MICHAEL BAKER JR., CONSULTING ENGINEERS  
 ROCHESTER, PENNSYLVANIA

STATE OF OHIO  
 DEPARTMENT OF HIGHWAYS  
 STATE HIGHWAY NO. 1  
 C-43  
 PLAN AND PROFILE  
 STA. 126+00 TO STA. 138+00

Designed	Drawn	Traced	Checked	Reviewed	Date	Revised
B.P.	A.L.H.	K.A.	R.E.F.			

PLAN & PROFILE STA. 126+00 TO STA. 138+00

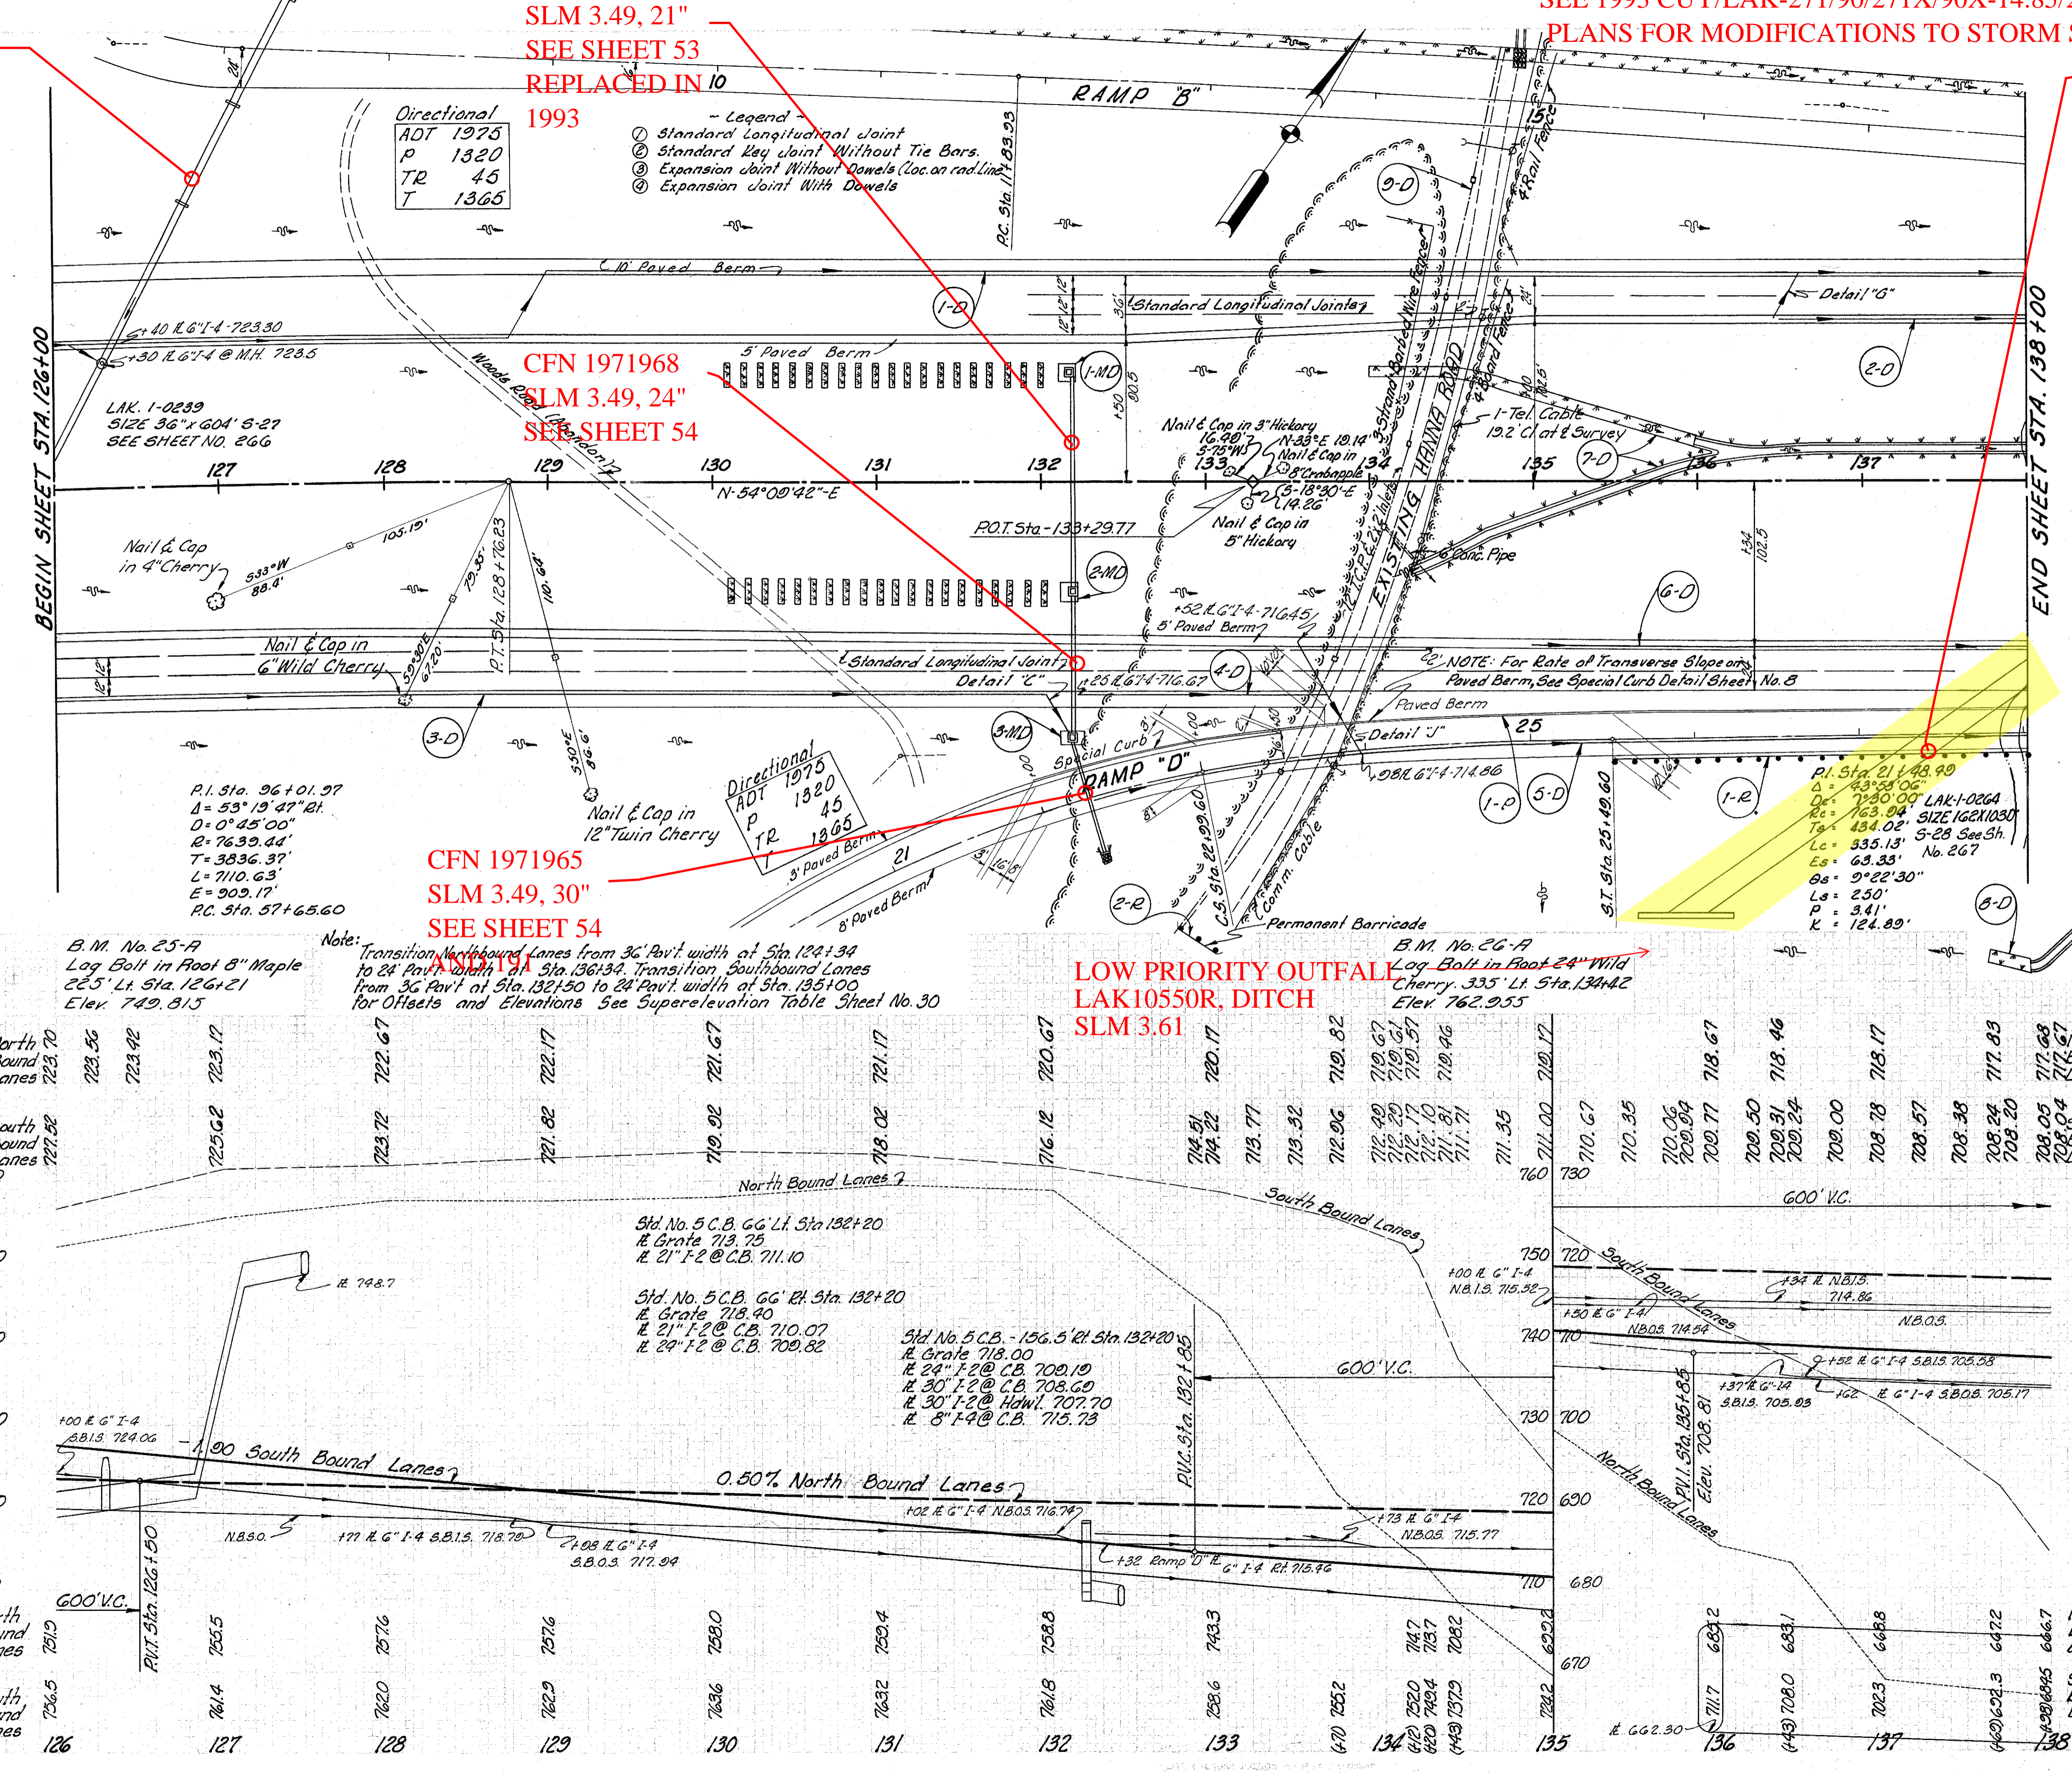

Note: Transition Northbound Lanes from 36' Pav't width at Sta. 124+34 to 24' Pav't width at Sta. 136+34. Transition Southbound Lanes from 36' Pav't at Sta. 132+50 to 24' Pav't width at Sta. 135+00 for Offsets and Elevations See Superelevation Table Sheet No. 30

LOW PRIORITY OUTFALL  
 LAK10550R, DITCH  
 SLM 3.61

CFN 1971965  
 SLM 3.49, 30"  
 SEE SHEET 54

CFN 1971968  
 SLM 3.49, 24"  
 SEE SHEET 54

B.M. No. 25-A  
 Lag Bolt in Foot 8" Maple  
 22.5' Lt. Sta. 126+21  
 Elev. 749.815

B.M. No. 26-A  
 Lag Bolt in Foot 24" Wild  
 Cherry, 33.5' Lt. Sta. 134+42  
 Elev. 762.955

Std. No. 5 C.B. 66' Lt. Sta. 132+20  
 # Grate 719.75  
 # 21" I-2 @ C.B. 711.10

Std. No. 5 C.B. 66' Rt. Sta. 132+20  
 # Grate 718.00  
 # 21" I-2 @ C.B. 710.07  
 # 30" I-2 @ C.B. 708.69  
 # 30" I-2 @ Haul 707.70  
 # 8" I-4 @ C.B. 715.73

North Bound Lanes  
 723.70  
 723.56  
 723.92  
 723.17  
 722.67  
 722.17  
 721.67  
 721.17  
 719.92  
 718.02  
 716.12  
 714.51  
 714.22  
 713.77  
 713.32  
 712.96  
 712.49  
 712.29  
 712.17  
 712.10  
 711.91  
 711.71  
 711.35  
 711.00  
 710.67  
 710.35  
 710.06  
 709.89  
 709.77  
 709.50  
 709.31  
 709.24  
 709.00  
 708.78  
 708.57  
 708.33  
 708.24  
 708.20  
 708.04  
 717.83  
 717.68  
 717.67

South Bound Lanes  
 727.59  
 725.62  
 723.72  
 722.82  
 721.82  

North Bound Lanes  

